

**QUARRY
COMMUNITY DEVELOPMENT DISTRICT**

**June 19, 2023
AGENDA PACKAGE**

Quarry Community Development District

Board of Supervisors

Timothy B. Cantwell, Chairman
Dean Britt, Vice Chairman
William Patrick, Assistant Secretary
Mel Stuckey, Assistant Secretary
Rick Fingeret, Assistant Secretary

District Staff

Justin Faircloth, District Manager
Wes Haber, District Counsel
Albert Lopez, District Engineer

Meeting Agenda
Monday June 19, 2023 at 1:00 p.m.
Quarry Golf Club
8950 Weathered Stone Drive, Naples, FL 34120

Call in meeting number: 1-646-838-1601, Meeting ID: 951-092-195#

- 1. Call to Order**
- 2. Pledge of Allegiance**
- 3. Approval of Agenda**
- 4. Public Comments on Agenda Items**
- 5. Engineer's Report**
 - A. Water Quality Monitoring Report, May 2023
 - B. Phase I & II Shoreline Restoration Update
 - C. Fieldstone Lane Drainage Improvement Update
 - D. Copper Canyon Court Drainage Discussion
 - E. Seaweed Collection Discussion
 - F. Variance Easement Report Update
 - i. 9389 Copper Canyon Court Update
 - ii. 9792 Nickel Ridge Update
 - iii. 9332 Granite Court Update
 - iv. 9262 Marble Stone Drive Update
 - v. 9179 Flint Court Update
 - vi. 9388 Slate Court Dock Lift Installation
- 6. New Business**
- 7. Old Business**
- 8. District Manager's Report**
 - A. Approval of the May 15, 2023 Minutes
 - B. Acceptance of the Financial Report, and Approval of the Check Register and Invoices as of May 2023
 - C. FY 2024 Budget Discussion
 - D. Follow-up Items
- 9. Attorney's Report**
 - A. June 5, 2023 Memo Regarding Sunshine Law and Public Records Law
- 10. Supervisor Requests**
- 11. Audience Comments**
- 12. Adjournment**

Next meeting: Monday August 14, 2023 at 1:00 p.m.

Fifth Order of Business

5A

**THE QUARRY
COMMUNITY DEVELOPMENT DISTRICT
COLLIER COUNTY, FLORIDA**

WATER QUALITY MONITORING REPORT

MAY 2023



*Engineers
Architects
Planners
Surveyors
Landscape Architects
Traffic/Transportation
Environmental Scientists
Construction Management*

CPH, LLC
2216 Altamont Ave.
Fort Myers, FL 33901
(239) 332-5499

WATER QUALITY MONITORING REPORT MAY 2023

THE QUARRY COMMUNITY DEVELOPMENT DISTRICT COLLIER COUNTY, FLORIDA

TABLE OF CONTENTS

	<u>Page</u>
INTRODUCTION	1
DATA COLLECTION	1
RESULTS	2
Temperature	5
pH	5
Dissolved Oxygen	5
Phosphorus	6
Nitrogen	6
Chlorophyll <i>a</i>	7
Salinity	7
Conductivity	8
SUMMARY	8

TABLES

Table 1	April 2023 Water Quality Test Results	3
---------	---	---

APPENDICES

APPENDIX A – FIGURES

FIGURE 1	Location Map
FIGURE 2	Sampling Location Map
FIGURE 3	Temperature Measurements October 2021 – April 2023
FIGURE 4	pH Measurements October 2021 – April 2023
FIGURE 5	Dissolved Oxygen Measurements October 2021 – April 2023
FIGURE 6	Phosphorus Measurements October 2021 – April 2023
FIGURE 7	Total Nitrogen Measurements October 2021 – April 2023
FIGURE 8	Chlorophyll <i>a</i> Measurements October 2021 – April 2023
FIGURE 9	Salinity Measurements October 2021 – April 2023
FIGURE 10	Conductivity Measurements October 2021 – April 2023

APPENDIX B – PHOTOGRAPHS OF SAMPLING LOCATIONS

INTRODUCTION

The Quarry is a residential development in northwestern Collier County (Figure 1, Appendix A). The Community Development District (CDD) maintains a stormwater management system which serves the community and the golf course. The system consists of inlet structures, conveyance pipes, control structures and man-made lakes. The water chemistry parameters measured are intended to assist with the characterization of conditions in the lakes to evaluate the water quality and its effect on the type of plants that grow in the lakes, the rate of growth, and the suitability of the lakes for fish and other wildlife. The South Florida Water Management District (SFWMD) permit authorizing development of the community requires perpetual maintenance of the stormwater management system so that it continues to function as designed. The permit also makes the permittee responsible for ensuring that the system does not cause violations of state water quality standards. This report provides the results of the monitoring event and provides a comparison to the results from the October 2021, April 2022, October 2022 and April 2023 events.

DATA COLLECTION

The field measurements and sample collection were conducted on March 29, 2023. All samples were collected and analyzed per Florida Department of Environmental Protection (FDEP) Standard Operating Procedures (SOP). Samples were collected from the photic zone, the surface layer where sunlight can influence growth of plants and algae. Samples were collected as grab samples at 1-2 feet from the surface as per FDEP aqueous sampling SOP. Disturbing sediments in the immediate area of sample collection was avoided. The locations of sampling points in each lake are depicted in Figure 2, Appendix A. The CDD initially selected 28 lakes for water quality monitoring. At the request of the CDD board, a second sampling location in Lake 30 was added beginning in March 2022. In 2023, the CDD accepted responsibility for three lakes previously under the control of the golf course – Lakes 57, 59 and 64. There are now a total of 32 sampling points in 31 lakes. Temperature, pH, dissolved oxygen, conductivity and salinity are measured in the field using a YSI Model 30, YSI Ecosense DO200A and a ThermoFisher Elite pH meter. Conductivity, salinity and pH are not expected to vary greatly but are measured to establish background levels and monitored so that any significant changes will be detected. Water samples were collected at each location, packed in ice and delivered to the laboratory for measurement of nutrients and chlorophyll *a*.

RESULTS

The results of the field measurements and laboratory testing are presented in Table 1. Photographs of the sample sites are provided in Appendix B. Lake levels appeared moderately low in April 2023, which is normal for the time of year.

Table 1. April 2023 Water Quality Test Results

CDD Lake No.	Sample Date	Sample Time	Sample Depth (ft.)	pH	Temp (°C)	DO (ppm)	Salinity (ppt)	Conductivity (µS/cm)	Chlorophyll a (mg/m ³)	Phosphorus (mg/L)	Kjeldahl N (mg/L)	Nitrate, Nitrite as N (mg/L)	Total Nitrogen (mg/L)	Aquatic Vegetation Observations
30	3/29/23	1610	1.5	7.7	28.5	8.9	0.2	441	5.3	0.027	0.75	U	0.75	Canna, Pondweed, Torpedograss, Hydrilla, Primrose, Spikerush, Arrowhead,
30x	3/29/23	1435	2	8.4	27.4	7.84	0.2	458	3.6	0.045	0.58	U	0.58	Pondweed
31	3/29/23	1635	1.5	7.5	27.9	9.80	0.2	550	16.9	U	0.62	U	0.62	Hydrilla
32	3/29/23	1705	1.5	7.7	29.5	10.2	0.2	439	9.8	U	0.81	U	0.81	Pondweed, Sand Cordgrass, Algae
33	3/29/23	1650	1.5	7.5	30.1	10.4	0.2	409	6.2	U	0.722	U	0.72	Sago Pondweed, Torpedograss, Algae
34	3/29/23	1655	1.5	7.7	29.0	9.40	0.2	374	10.7	0.056	0.91	U	0.91	Torpedograss, Fanwort, Sago Pondweed, Algae
35	3/29/23	1715	1.5	8.7	30.5	12.13	0.2	439	17.8	0.06	0.942	U	0.94	Primrose, Hydrilla, Algae
36	3/29/23	1700	1.5	8.6	31.0	8.63	0.2	385	16.9	U	0.78	U	0.78	Spikerush, Saltmeadow Cordgrass, Hydrilla
37	3/29/23	1725	1.5	8.7	28.2	9.62	0.2	434	14.2	0.02	1.08	U	1.08	Hydrilla
38	3/29/23	1650	1.5	8.6	30.8	13.12	0.2	492	16.9	0.093	0.72	0.04	0.76	Fanwort, Torpedograss, Hydrilla
40	3/29/23	1625	1.5	8.0	29.2	8.9	0.2	342	11.6	0.07	0.82	U	0.82	Arrowhead, Torpedograss, Primrose
41	3/29/23	1145	1.5	8.5	27.4	7.06	0.3	526	5.3	0.038	1.74	0.04	1.78	Pondweed, Spikerush, Torpedograss, Hydrilla, Algae
42	3/29/23	1130	1.5	8.5	27.4	7.34	0.3	560	4.5	0.06	0.98	0.05	1.03	Torpedograss, Hydrilla,
44	3/29/23	1200	1.5	8.5	27.8	8.24	0.2	524	8.9	0.163	1.21	0.02	1.23	Red Ludwigia, Torpedograss, Pickerelweed, Hydrilla, Algae
45	3/29/23	1215	1.5	8.5	28.6	7.27	0.2	491	U	0.159	1.06	U	1.06	Spikerush, Red Ludwigia, Torpedograss, Hydrilla, Algae

Qualifiers

U = The compound was not detected.

Highlighted results exceed or are below desired level

Spikerush = *Eleocharis cellulosa*, Arrowhead = *Sagittaria* sp., Pickerelweed = *Pontederia cordata*, Pondweed = *Potamogeton illinoensis*, Sago Pondweed = *Potamogeton pectinatus*, Fanwort = *Cabomba caroliniana*, Water Lily = *Nymphaea odorata*, Fireflag = *Thalia geniculata*, Red Ludwigia = *Ludwigia repens*, Sand Cordgrass = *Spartina bakeri*, Saltmeadow Cordgrass = *Spartina patens*, Torpedograss = *Panicum repens*, Primrose = *Ludwigia octovalvis*, Canna = *Canna* sp., Alligatorweed = *Alternanthera hydropiperoides*, Hydrilla = *Hydrilla verticillata*, Nitella = *Nitella* sp., Rush = *Juncus* sp., Bladderwort = *Utricularia* sp.

Table 1. April 2023 Water Quality Test Results (Continued)

CDD Lake No.	Sample Date	Sample Time	Sample Depth (ft.)	pH	Temp (°C)	DO (ppm)	Salinity (ppt)	Conductivity (µS/cm)	Chlorophyll a (mg/m ³)	Phosphorus (mg/L)	Kjeldahl N (mg/L)	Nitrate, Nitrite as N (mg/L)	Total Nitrogen (mg/L)	Aquatic Vegetation Observations
47	3/29/23	1300	1.5	8.6	29.0	8.24	0.2	454	6.2	0.303	1.02	U	1.02	Arrowhead, Rush, Canna, Saltmeadow Cordgrass,
48	3/29/23	1245	1.5	8.4	29.6	7.71	0.2	475	4.5	0.226	1.02	U	1.02	Pondweed, Red Ludwigia, Hydrilla
50	3/29/23	1425	1.5	8.2	29.2	7.06	0.3	584	9.8	0.029	1.04	0.02	1.06	Spikerush, Red Ludwigia, Fanwort, Hydrilla, Nitella, Bladderwort
53	3/29/23	1515	1.5	8.4	28.0	8.11	0.2	499	3.6	0.03	0.81	U	0.81	Rush, Algae
54	3/29/23	1415	1.5	8.3	28.6	8.12	0.2	461	18.7	0.082	0.85	0.02	0.87	Spikerush, Red Ludwigia, Fanwort, Hydrilla
55	3/29/23	1345	1.5	8.7	28.5	10.20	0.2	338	7.1	0.09	0.64	U	0.64	Arrowhead, Hydrilla, Torpedograss
56	3/29/23	1320	1.5	8.4	29.3	8.07	0.2	444	8.0	0.363	0.75	U	0.75	Pondweed, Spikerush, Hydrilla
57	3/29/23	1450	1	8.3	26.9	8.41	0.3	672	6.2	0.89	1.08	U	1.08	
58	3/29/23	1505	1.5	8.4	30.7	7.72	0.3	666	3.6	U	0.93	U	0.93	Pondweed, Water Lily
59	3/29/23	1520	1	8.4	28.4	7.68	0.3	671	2.7	0.03	0.97	U	0.97	
61	3/29/23	1545	1.5	8.5	31.2	8.30	0.2	458	3.6	0.027	0.79	0.04	0.83	Pondweed
62	3/29/23	1535	1.5	8.4	28.3	7.74	0.2	458	1.8	0.04	0.71	U	0.71	Pondweed, Water Lily, Torpedograss
63	3/29/23	1640	1.5	8.6	32.1	8.26	0.2	445	4.5	0.072	1.20	U	1.20	Pondweed, Fireflag
63A	3/29/23	1625	1.5	8.6	31.8	7.80	0.2	472	7.1	0.049	1.14	U	1.14	Spikerush, Fireflag, Water Lily, Hydrilla
63B	3/29/23	1630	1.5	8.6	29.1	8.03	0.2	409	3.6	U	1.10	U	1.10	Spikerush, Pondweed, Water Lily
64	3/29/23	1600	1	8.8	32.0	9.01	0.2	365	8.9	0.079	0.93	U	0.93	

Qualifiers

U = The compound was not detected.

Highlighted results exceed or are below desired level

Spikerush = *Eleocharis cellulosa*, Arrowhead = *Sagittaria* sp., Pickerelweed = *Pontederia cordata*, Pondweed = *Potamogeton illinoensis*, Sago Pondweed = *Potamogeton pectinatus*, Fanwort = *Cabomba caroliniana*, Water Lily = *Nymphaea odorata*, Fireflag = *Thalia geniculata*, Red Ludwigia = *Ludwigia repens*, Sand Cordgrass = *Spartina bakeri*, Saltmeadow Cordgrass = *Spartina patens*, Torpedograss = *Panicum repens*, Primrose = *Ludwigia octovalvis*, Canna = *Canna* sp., Alligatorweed = *Alternanthera hydrophiloides*, Hydrilla = *Hydrilla verticillata*, Nitella = *Nitella* sp., Rush = *Juncus* sp., Bladderwort = *Utricularia* sp.

Temperature

Normal temperature for freshwater lakes in Florida ranges from 24° - 30° Celsius (annual average). Temperature is used in analysis of dissolved oxygen values. Extremely high temperature can contribute to low oxygen levels, leading to fish kills. Extremely low temperature could kill aquatic organisms. Lake temperatures in April 2023 ranged from 26.9 – 32.0° C, which is normal for the time of year. The temperature measurements in all lakes for the last four monitoring events are shown in Figure 3, Appendix A.

pH

pH is an expression of the amount of hydrogen ions (H⁺) in the water. Distilled water has a pH of 7, which has equal amounts of hydrogen (H⁺) and hydroxide (OH⁻) ions. In southwest Florida lakes, pH can range between 4.44 and 10.04 with a median value of 7.29 (Romie, 2000).

The pH of the CDD lakes during the April 2023 monitoring event were within the normal range for south Florida lakes, ranging from 7.5 to 8.7. The pH of all lakes for the last four monitoring events are shown in Figure 4, Appendix A.

Dissolved Oxygen

The amount of oxygen that can be dissolved in water depends on several factors, including water temperature, salinity, and atmospheric pressure. On a relative scale, the amount of oxygen dissolved in saturated water will be greater in cooler waters than in warmer ones.

Oxygen enters waterbodies primarily by transfer from the atmosphere across the air-water interface and to a lesser extent by the action of photosynthetic organisms. DO levels typically follow a diurnal cycle – higher at the end of the day and lower at dawn. Fish typically require DO concentrations of approximately 5 parts per million (ppm) for optimum health. Exposure to DO levels below 2 ppm for 1 – 4 days will kill many aquatic organisms (Wilson, 2014).

During the monitoring event in April 2023, DO levels in the lakes ranged from 7.06 – 12.13 parts per million (ppm). The observed DO concentrations were normal and sufficient to sustain fish and other aquatic organisms in all lakes.

The dissolved oxygen levels in all lakes for the last four monitoring events are shown in Figure 5, Appendix A.

Phosphorus

Phosphorus is usually not available in the environment. Although natural phosphorus levels in surface water bodies are very low, human sources or activities such as fertilizer application, sewage spills and soil erosion can overload lakes with available phosphorus. Excess phosphorus introduced to a lake provides food for plants and algae and can increase the vegetation growth within a lake and have a negative impact on water quality.

The April 2023 sampling results show phosphorus levels ranging from 0 to 0.363 mg/L. Only Lakes 44, 47 and 56 were slightly above the maximum desirable level of 0.16 mg/L. The phosphorus levels in all lakes for the last four monitoring events are shown in Figure 6, Appendix A.

Nitrogen

Nitrogen is necessary for many natural biological processes. Excess nitrogen in the lakes can fuel the growth of excess algae or other undesirable plants. Total nitrogen concentration can be used in conjunction with other parameters **including chlorophyll and phosphorus to determine a lake's trophic state** - the degree of biological productivity of a waterbody. Trophic state determinations are based on regular, frequent monitoring for an extended period (typically at least two years). Generally speaking, total nitrogen concentrations of approximately 2 mg/m³ **are indicative of trophic states with "good" water quality** (wateratlas.org, 2021).

In April 2023, the nitrogen levels observed in all lakes were within the normal range for Florida lakes, ranging from 0.58 – 1.78 mg/L. The total nitrogen levels in all lakes for the last four monitoring events are shown in Figure 7, Appendix A.

Phosphorus and Nitrogen are nutrients that support growth of plants including large rooted plants, algae and microscopic phytoplankton. Fertilizers, yard and pet waste and certain soaps and detergents contain nitrogen and phosphorus, and can contribute to nutrient pollution if not properly used or disposed (Fairchild, 2006). Atmospheric nitrogen is transferred to water bodies and deposited on hard surfaces where it can be carried into lakes by stormwater runoff. It is worth noting that the Quarry lakes are constructed for the purpose of detaining stormwater runoff so that pollutants, including nutrients, can be removed from the water through natural physical, chemical and biological processes. Therefore, it is expected that nutrients will be found in the lakes as part of their normal function. However, nutrients can fuel excessive macroalgae and phytoplankton growth. Plants produce oxygen through photosynthesis, but they also consume oxygen by

respiration in the absence of sunlight. In addition, decaying plant matter consumes oxygen. While nutrients enter the lakes by design, the nutrient load can be managed through the efforts and practices of the CDD, landscape workers, golf course groundskeepers and residents. Limiting the addition of nutrients from fertilizers, pet waste, detergents and yard waste will help keep the lakes functioning and more aesthetically pleasing.

Chlorophyll *a*

Chlorophyll *a* is an indicator of the abundance of planktonic algae found in the water column. Elevated chlorophyll *a* levels are directly correlated with reduced water clarity, odor and the potential for algae blooms. Chlorophyll *a* values can be expected to rise during the warmer months. Chlorophyll concentration is also used in conjunction with other parameters including nitrogen and phosphorus **to determine a lake's trophic state** - the degree of biological productivity of a waterbody. Trophic state determinations are based on regular, frequent monitoring for an extended period (typically at least two years). Generally speaking, chlorophyll *a* concentrations less than 20 mg/m³ **are indicative of trophic states with “good” water quality**. Chlorophyll *a* concentrations between 20 and 40 mg/m³ **are indicative of “fair” water quality** (wateratlas.org, 2021). Therefore, 40 mg/m³ is considered the maximum desirable chlorophyll *a* concentration.

During the April 2023 sampling, the chlorophyll *a* levels in all lakes except Lakes 31, 35, 36, 38 and 54 were in the low range of 0 – 15 mg/m³. Lakes 31, 35, 36, 38 and 54 were in the moderate range of 15.1 – 40 mg/m³. During the monitoring event, lake observations appeared normal and healthy. Chlorophyll *a* levels in all lakes for the last four monitoring events are shown in Figure 8, Appendix A.

Salinity

The salt concentration is usually expressed in parts per thousand (ppt) or parts per million (ppm). Water salinity based on dissolved salts classifies a water body into three categories:

- Fresh water < 0.5 ppt
- Brackish water 0.5–30 ppt
- Saline water 30–50 ppt

In April 2023, the salinity in all of the monitored lakes was low, ranging from 0.2 - 0.3 ppt. This is within the normal range for man-made freshwater ponds in this region of Florida. The salinity measurements recorded in all lakes for the last four monitoring events are shown in Figure 9, Appendix A.

Conductivity

Conductivity measures the capacity of water to conduct an electric current and indirectly measures the concentration of ionized substances in water. Approximately 80% of Florida lakes have conductivity between 90 and 1000 $\mu\text{S}/\text{cm}$ (Hand, 2004).

Conductivity values during the April 2023 monitoring event ranged from 338 – 671 $\mu\text{S}/\text{cm}$. These values are in the normal range for man-made lakes in this region of Florida. The conductivity measurements recorded in all lakes for the last four monitoring events are shown in Figure 10, Appendix A.

SUMMARY

In summary, the April 2023 water quality monitoring event shows:

- Lake temperatures were normal for the time of year.
- pH values were within the normal range for Florida lakes in this region. The pH range for the CDD lakes ranged from 7.5 to 8.7.
- The observed DO concentrations in all lakes During the April 2023 water quality sampling were normal and sufficient to sustain fish and other aquatic organisms in all lakes. There was no visible evidence that low dissolved oxygen was affecting aquatic life.
- The April 2023 sampling results show phosphorus levels ranging from 0 to 0.363 mg/L. Only Lakes 44, 47 and 56 were slightly above the maximum desirable level of 0.16 mg/L., therefore no action is recommended at this time.
- Nitrogen levels observed in all lakes were within the normal range for Florida lakes.
- The chlorophyll a level in lakes was low to moderate.
- Salinity and conductivity in all lakes were normal for freshwater lakes in Florida. Salinity values were similar in all lakes with a value of 0.2 - 0.3 ppt. Conductivity values ranged from 338 – 671 $\mu\text{S}/\text{cm}$.
- Based on visual observation, the lakes appear healthy with normal water levels and clarity. Nuisance vegetation management appears effective in the 31 CDD lakes monitored.

CPH has been conducting a similar monitoring program in the adjoining Heritage Bay community for several years. In general, the results of the April 2023 monitoring event indicate The Quarry lakes have similar conditions to the Heritage Bay lakes.

CITATIONS

Romie, Kenneth, *Water Chemistry of Lakes in the Southwest Florida Water Management District*, Resource Management Department, Southwest Florida Water Management District, February 2000.

Wilson, P. Chris, *Water Quality Notes: Dissolved Oxygen*, document SL313, Soil and Water Science Department, UF/IFAS Extension. Original publication date December 2009. Revised August 2014.

Hand, Joe, *Typical Values for Water Quality Parameters for Florida's Lakes, Streams and Estuaries*, Watershed Assessment Section, Bureau of Watershed Management Florida Department of Environmental Protection. October 2004.

Fairchild, J. F. and L. A. Vradenburg. *Fate and Effects of Nitrogen and Phosphorus in Shallow Vegetated Aquatic Ecosystems*. U.S. Environmental Protection Agency, Washington, D.C., EPA/600/R-06/058, 2006.

Florida LAKEWATCH, *A Beginner's Guide to Water Management in Florida Lakes; Fish Communities and Trophic State*, Information Circular 110, Department of Fisheries and Aquatic Sciences, Institute of Food and Agricultural Sciences, University of Florida, Gainesville, Florida, April 2007.


wateratlas.org, USF Water Institute, School of Geosciences, College of Arts and Sciences, University of South Florida, Tampa, Florida.






APPENDIX A

Figures

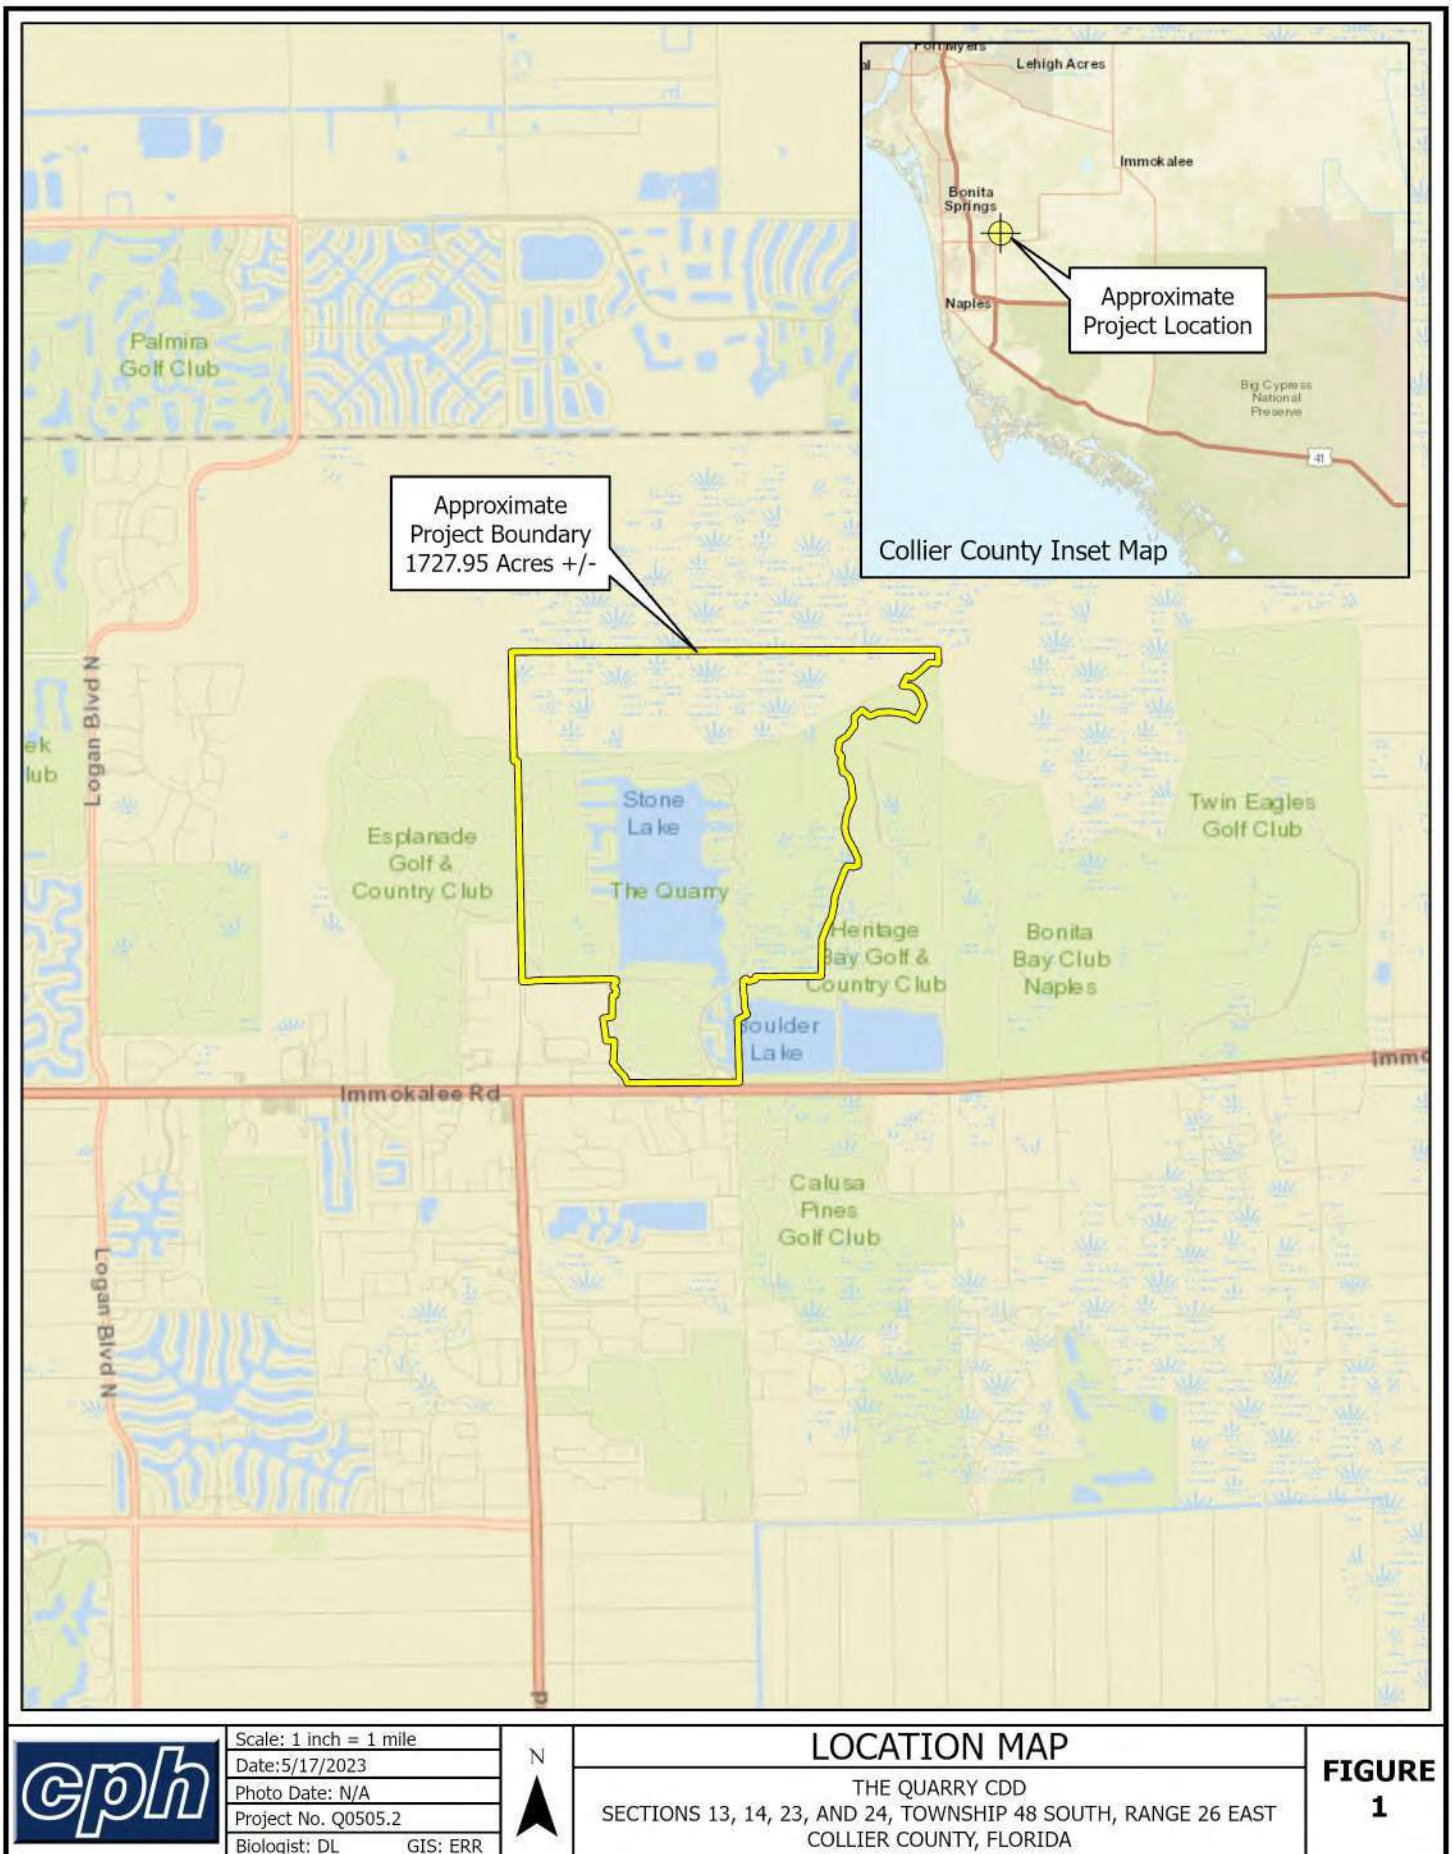
The Quarry CDD
May 2023
Water Quality Monitoring Report
Collier County, Florida

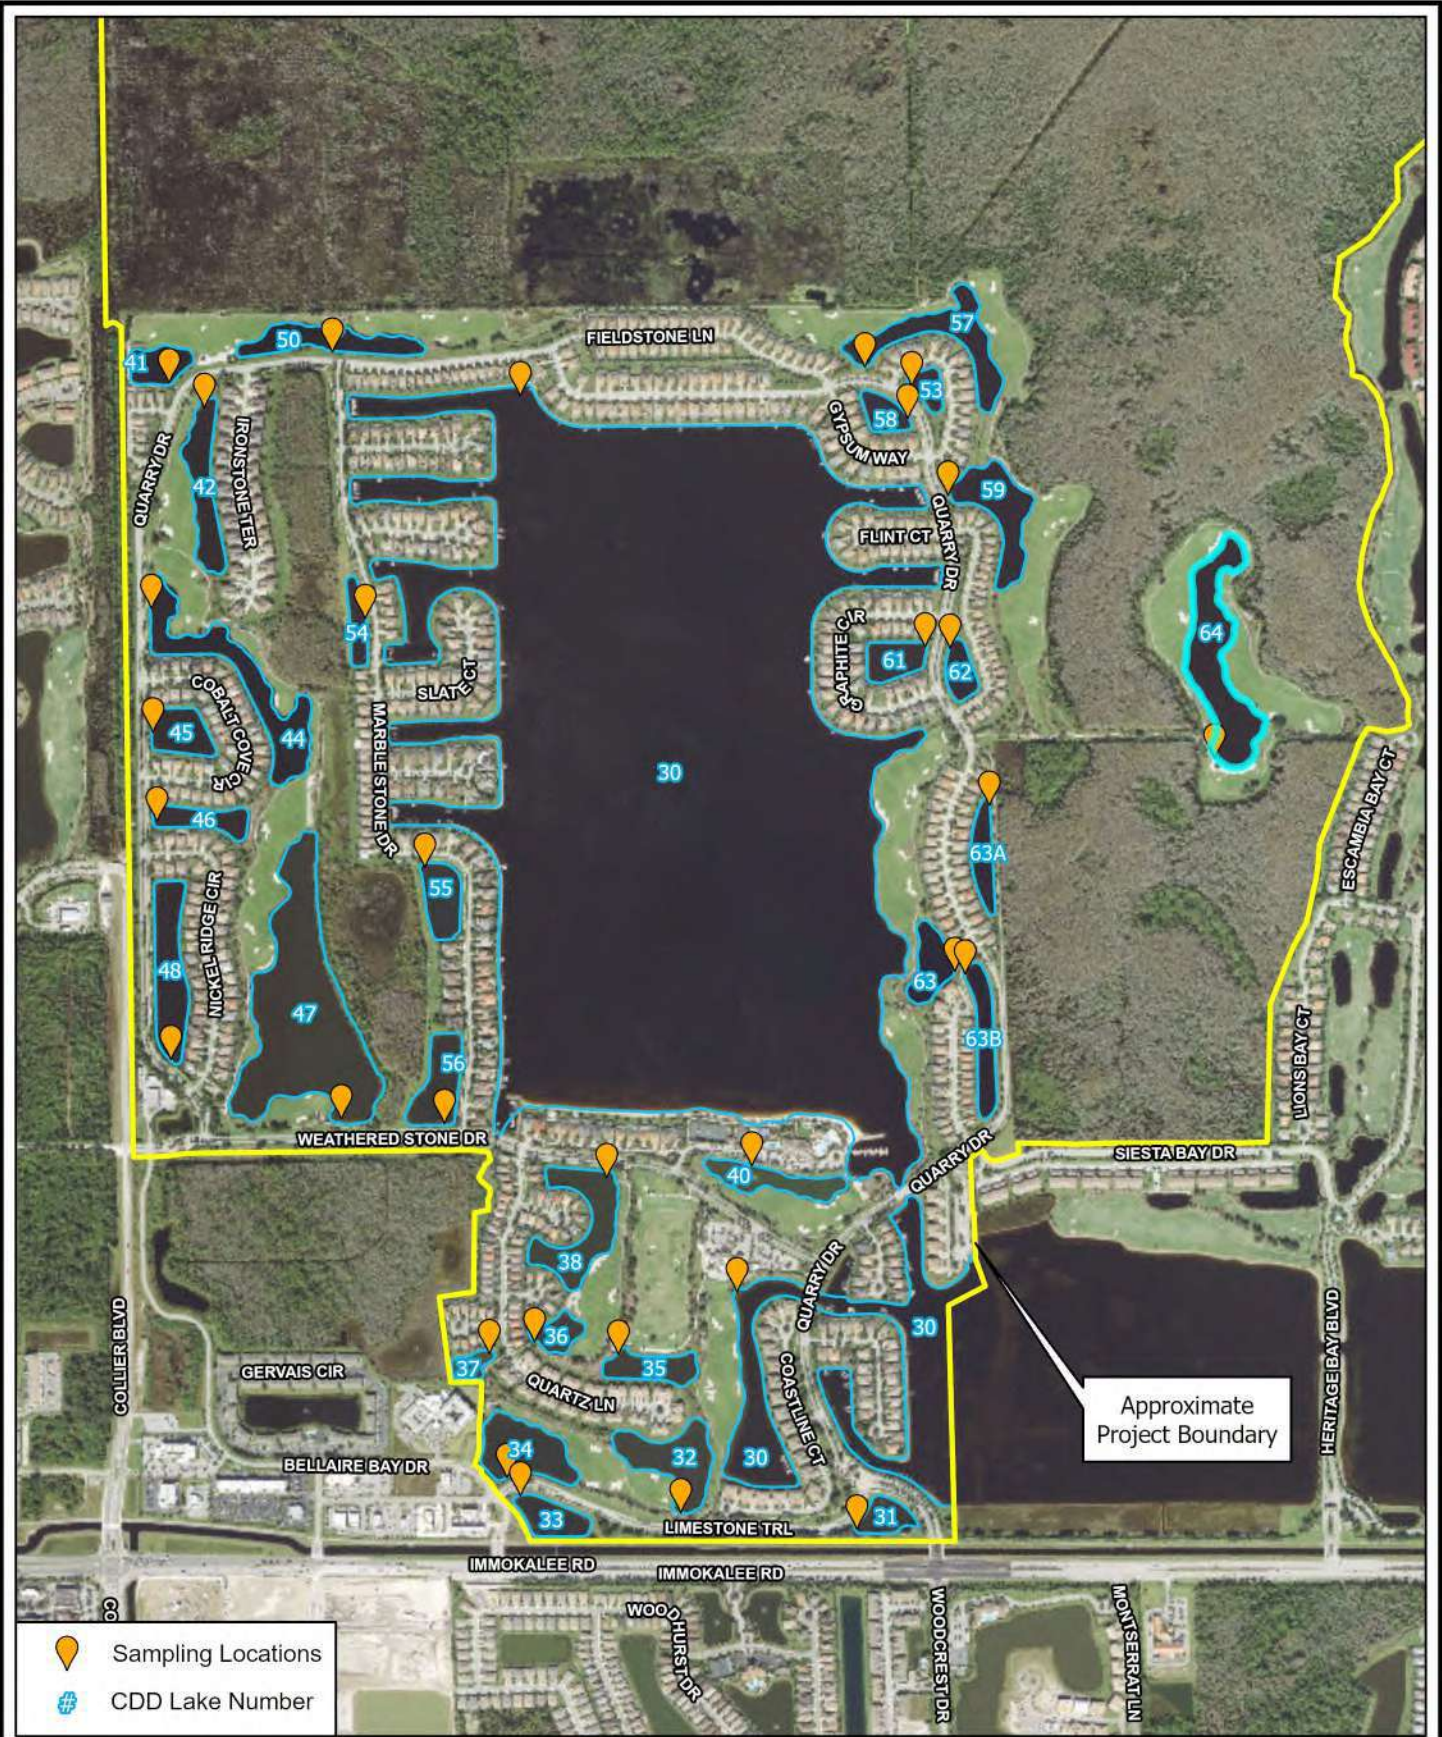



	Scale: 1 inch = 1,250 feet		LAKE SAMPLING LOCATIONS MAP THE QUARRY CDD SECTIONS 13, 14, 23, AND 24, TOWNSHIP 48 SOUTH, RANGE 26 EAST COLLIER COUNTY, FLORIDA		FIGURE 2
	Date: 5/17/2023				
	Photo Date: 2019				
	Project No. Q0505.2				
	Biologist: DL GIS: ERR				

Normal Range = 24 Degrees - 30 Degrees C (Annual Average)

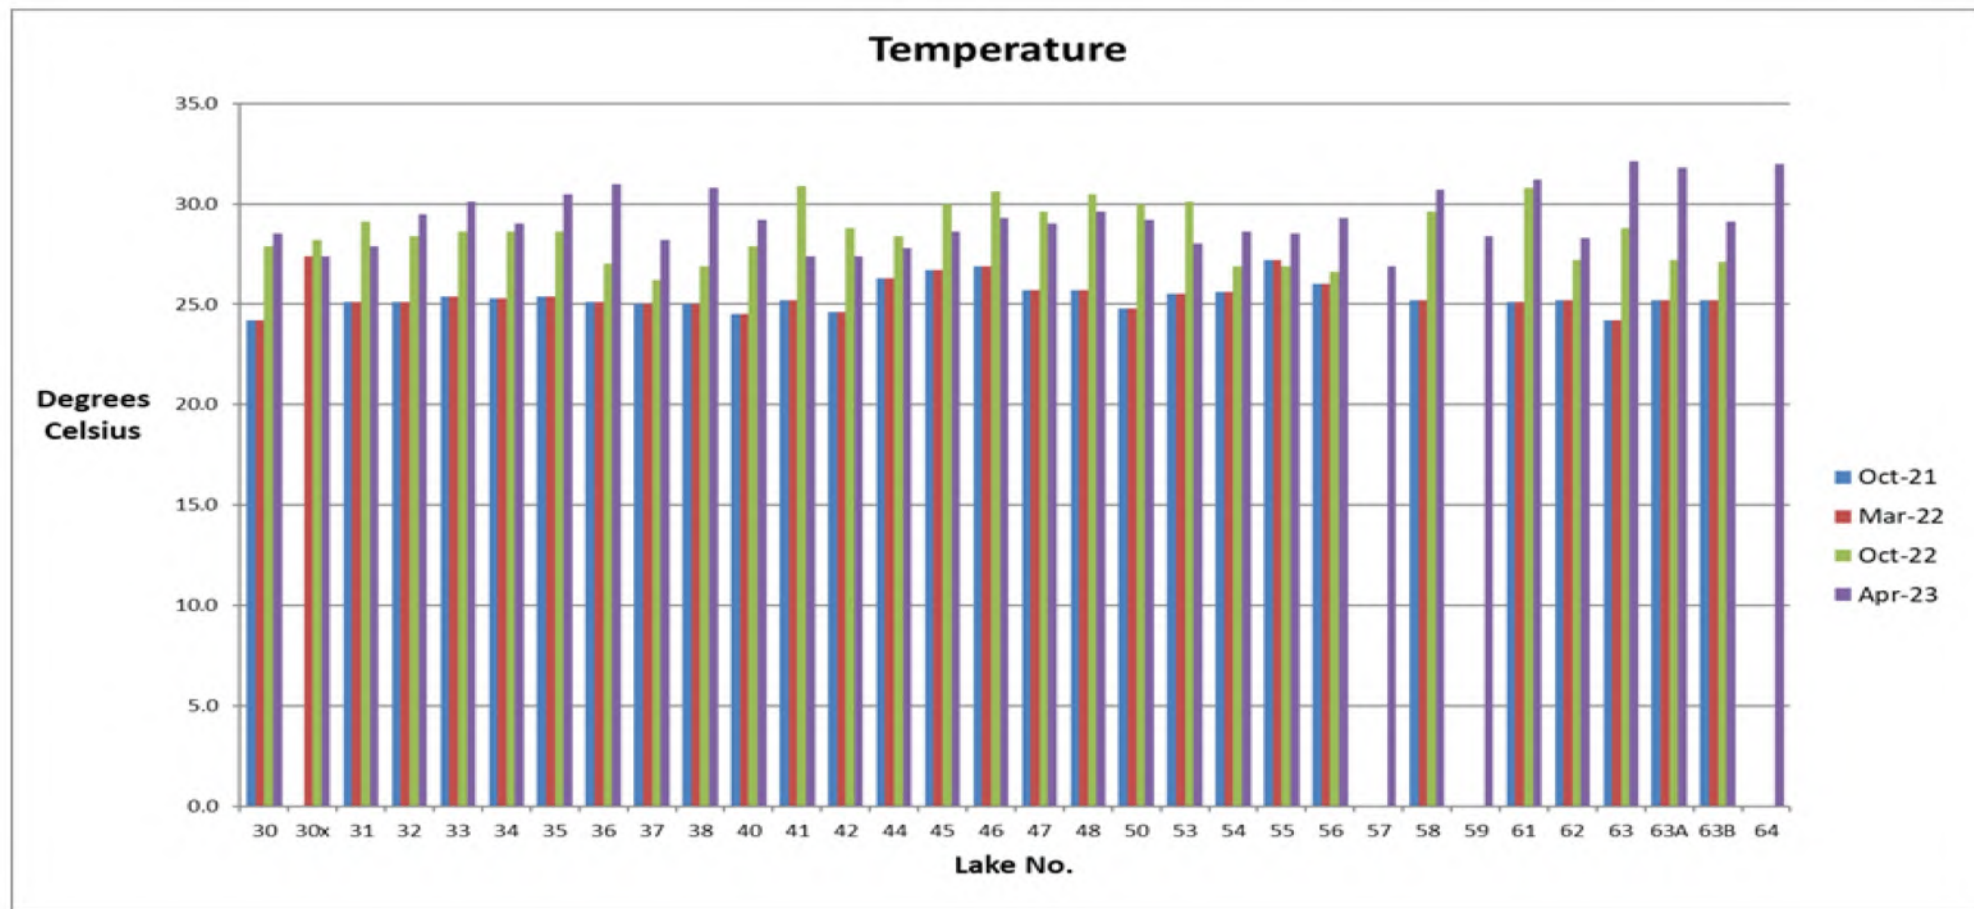


Scale: N/A
 Date: 5/17/2023
 Photo Date: N/A
 Project No. Q0505.2
 Biologist: DL GIS: ERR

TEMPERATURE MEASUREMENTS OCT 2021 - APR 2023

THE QUARRY CDD
 SECTIONS 13, 14, 23, AND 24, TOWNSHIP 48 SOUTH, RANGE 26 EAST
 COLLIER COUNTY, FLORIDA

**FIGURE
3**

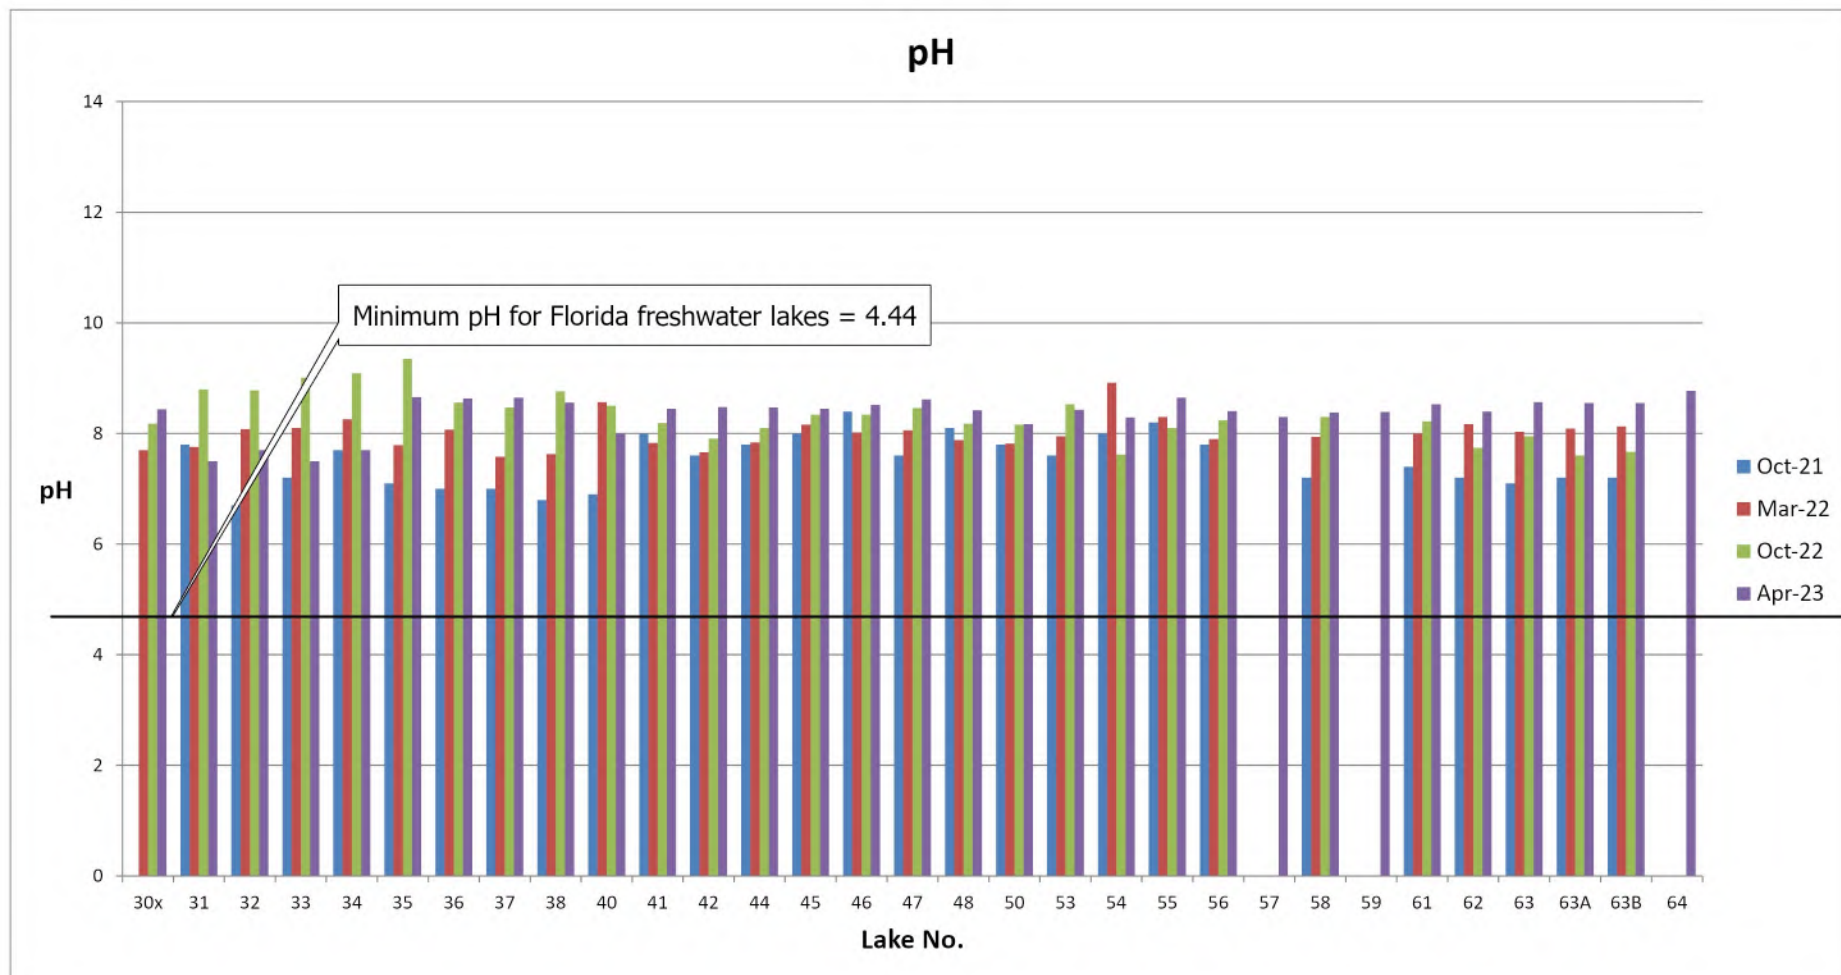


Scale: N/A
 Date: 5/17/2023
 Photo Date: N/A
 Project No. Q0505.2
 Biologist: DL GIS: ERR

PH MEASUREMENTS OCT 2021 - APR 2023

THE QUARRY CDD
 SECTIONS 13, 14, 23, AND 24, TOWNSHIP 48 SOUTH, RANGE 26 EAST
 COLLIER COUNTY, FLORIDA

**FIGURE
4**

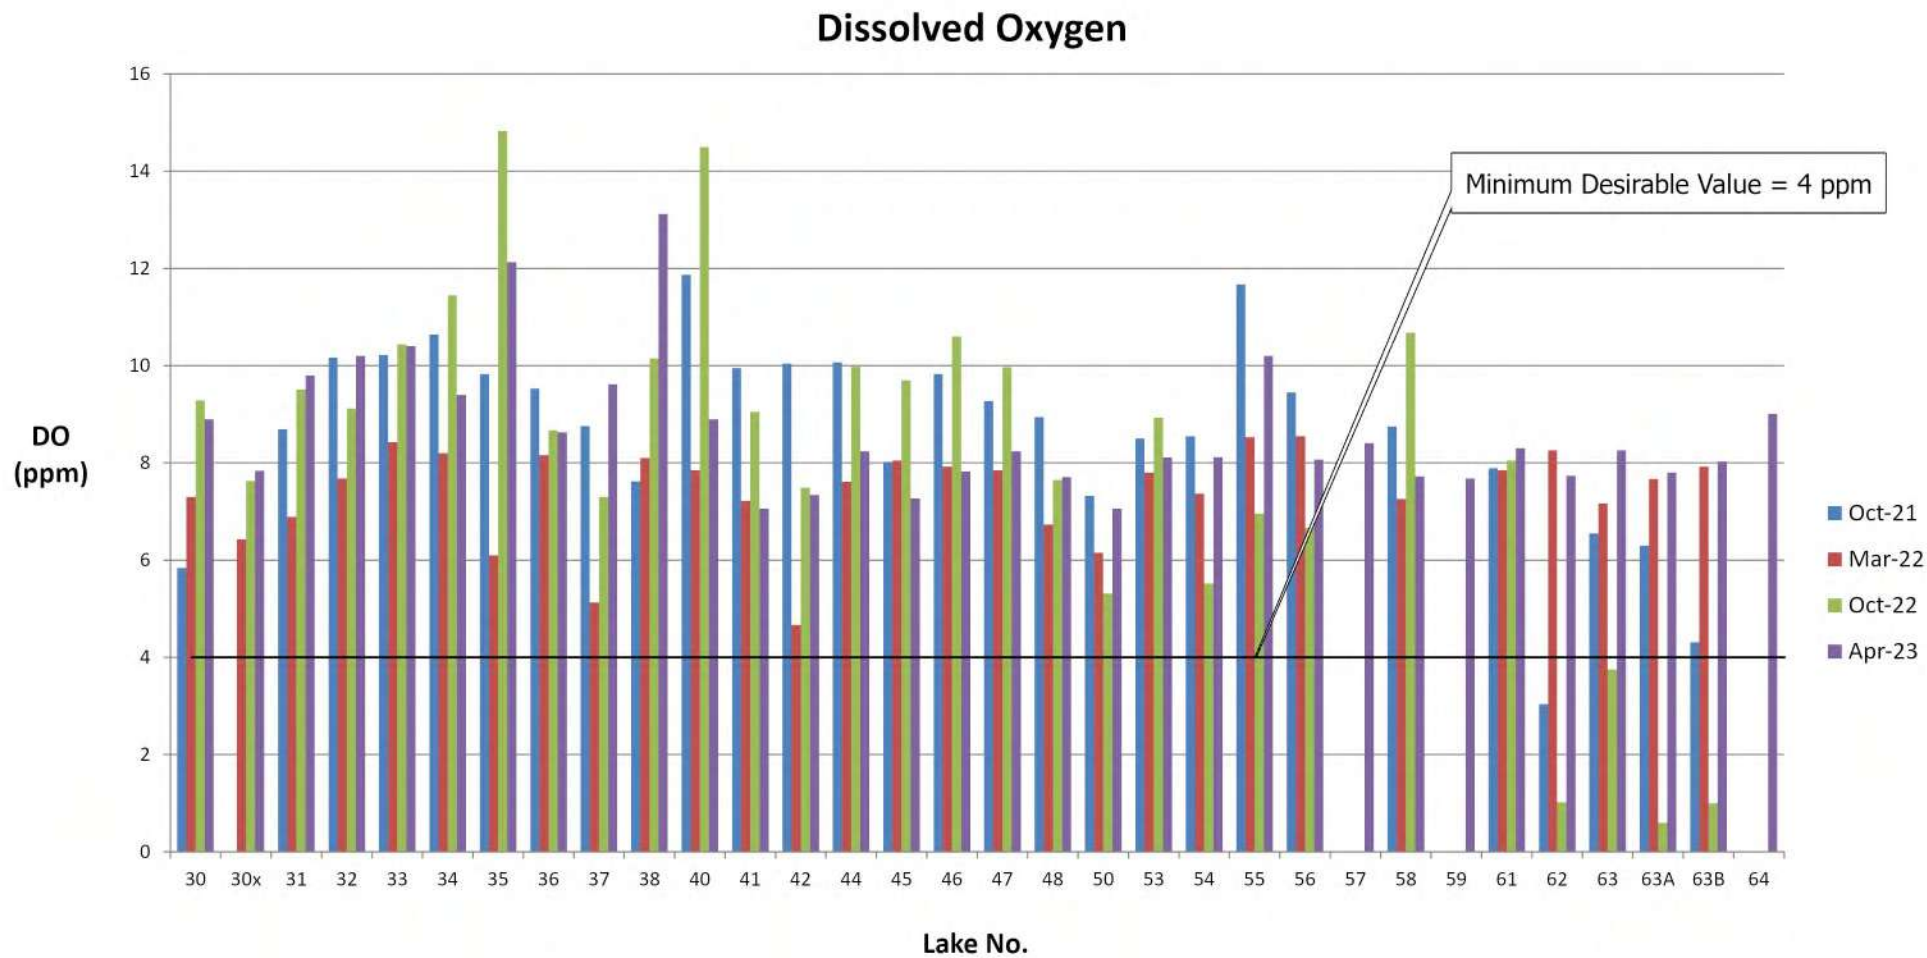


Scale: N/A
 Date: 5/17/2023
 Photo Date: N/A
 Project No. Q0505.2
 Biologist: DL GIS: ERR

DISSOLVED OXYGEN MEASUREMENTS OCT 2021 - APR 2023

THE QUARRY CDD
 SECTIONS 13, 14, 23, AND 24, TOWNSHIP 48 SOUTH, RANGE 26 EAST
 COLLIER COUNTY, FLORIDA

**FIGURE
5**

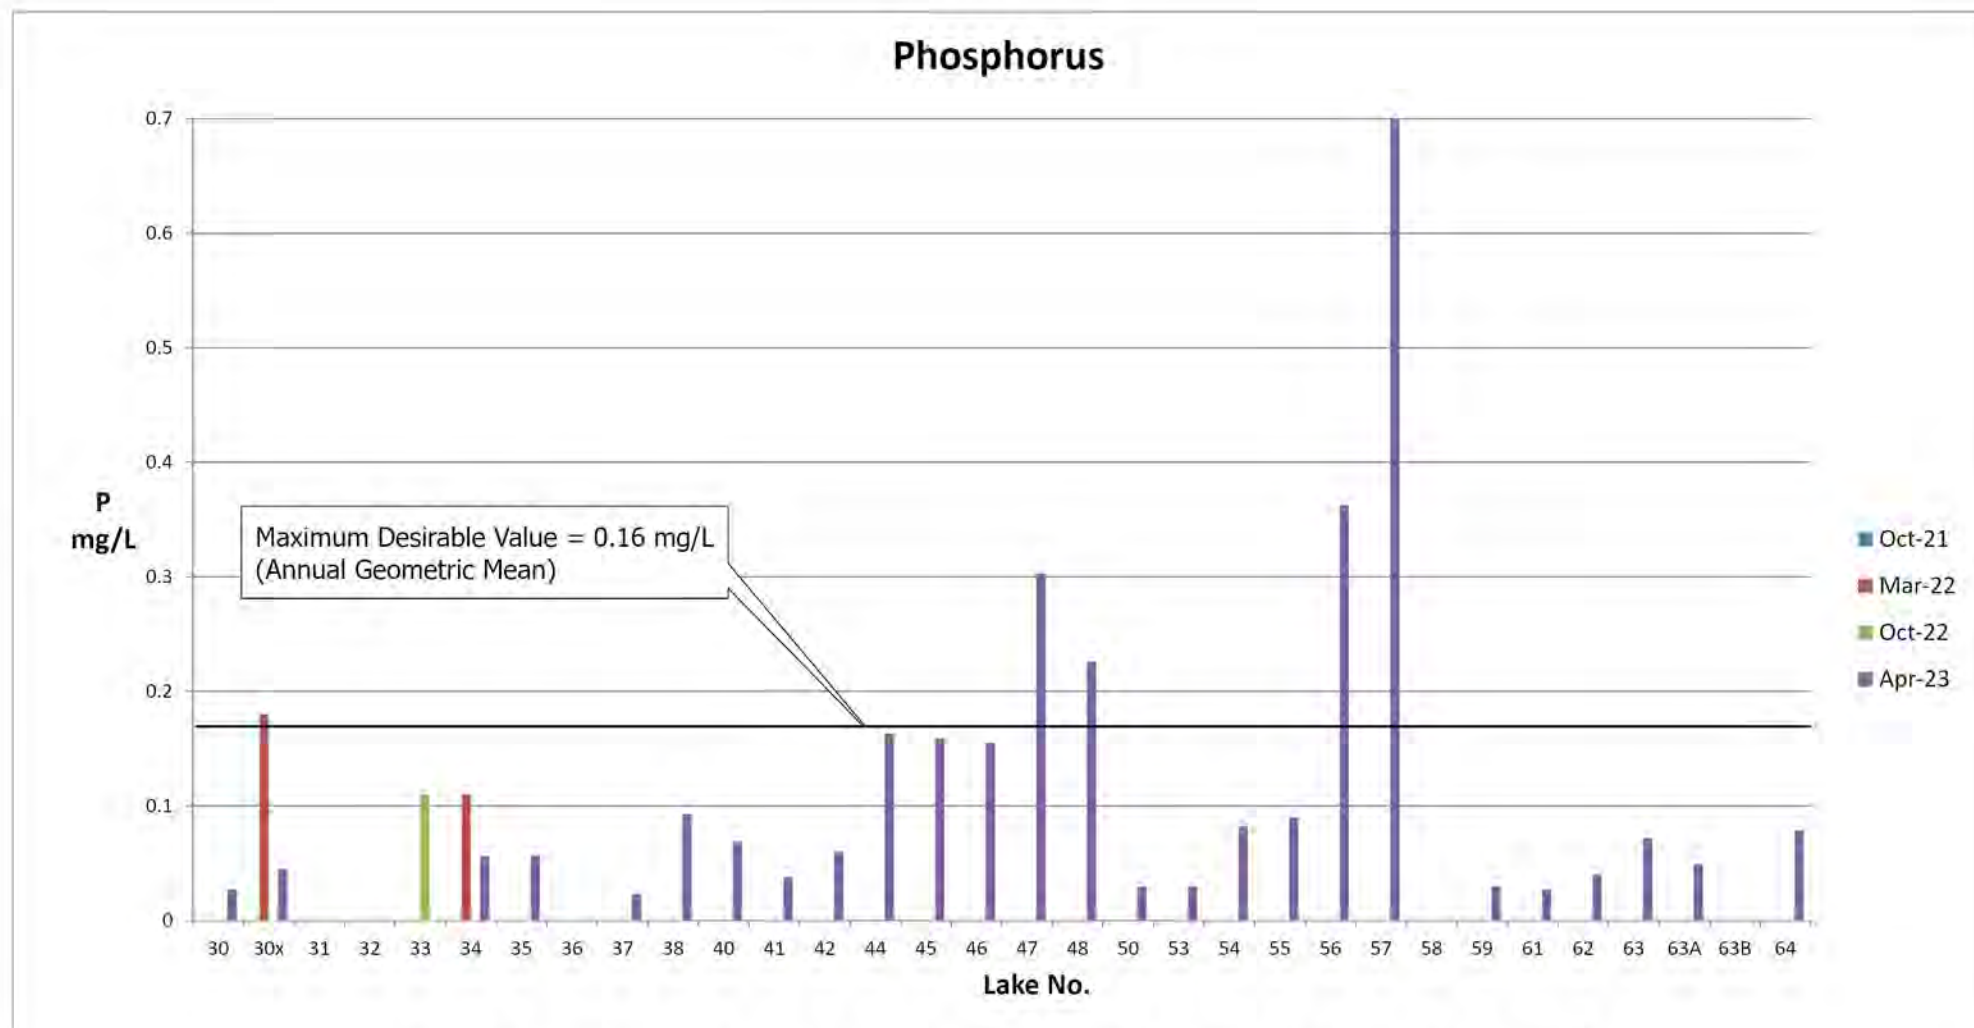

Note: Phosphorus was not detected or was below the quantification limit in all lakes in October 2021




Scale: N/A
 Date: 5/17/2023
 Photo Date: N/A
 Project No. Q0505.2
 Biologist: DL GIS: ERR

PHOSPHORUS MEASUREMENTS OCT 2021 - APR 2023

THE QUARRY CDD
 SECTIONS 13, 14, 23, AND 24, TOWNSHIP 48 SOUTH, RANGE 26 EAST
 COLLIER COUNTY, FLORIDA

**FIGURE
6**

Maximum Desirable Value = 2.23mg/L
(Annual Geometric Mean)

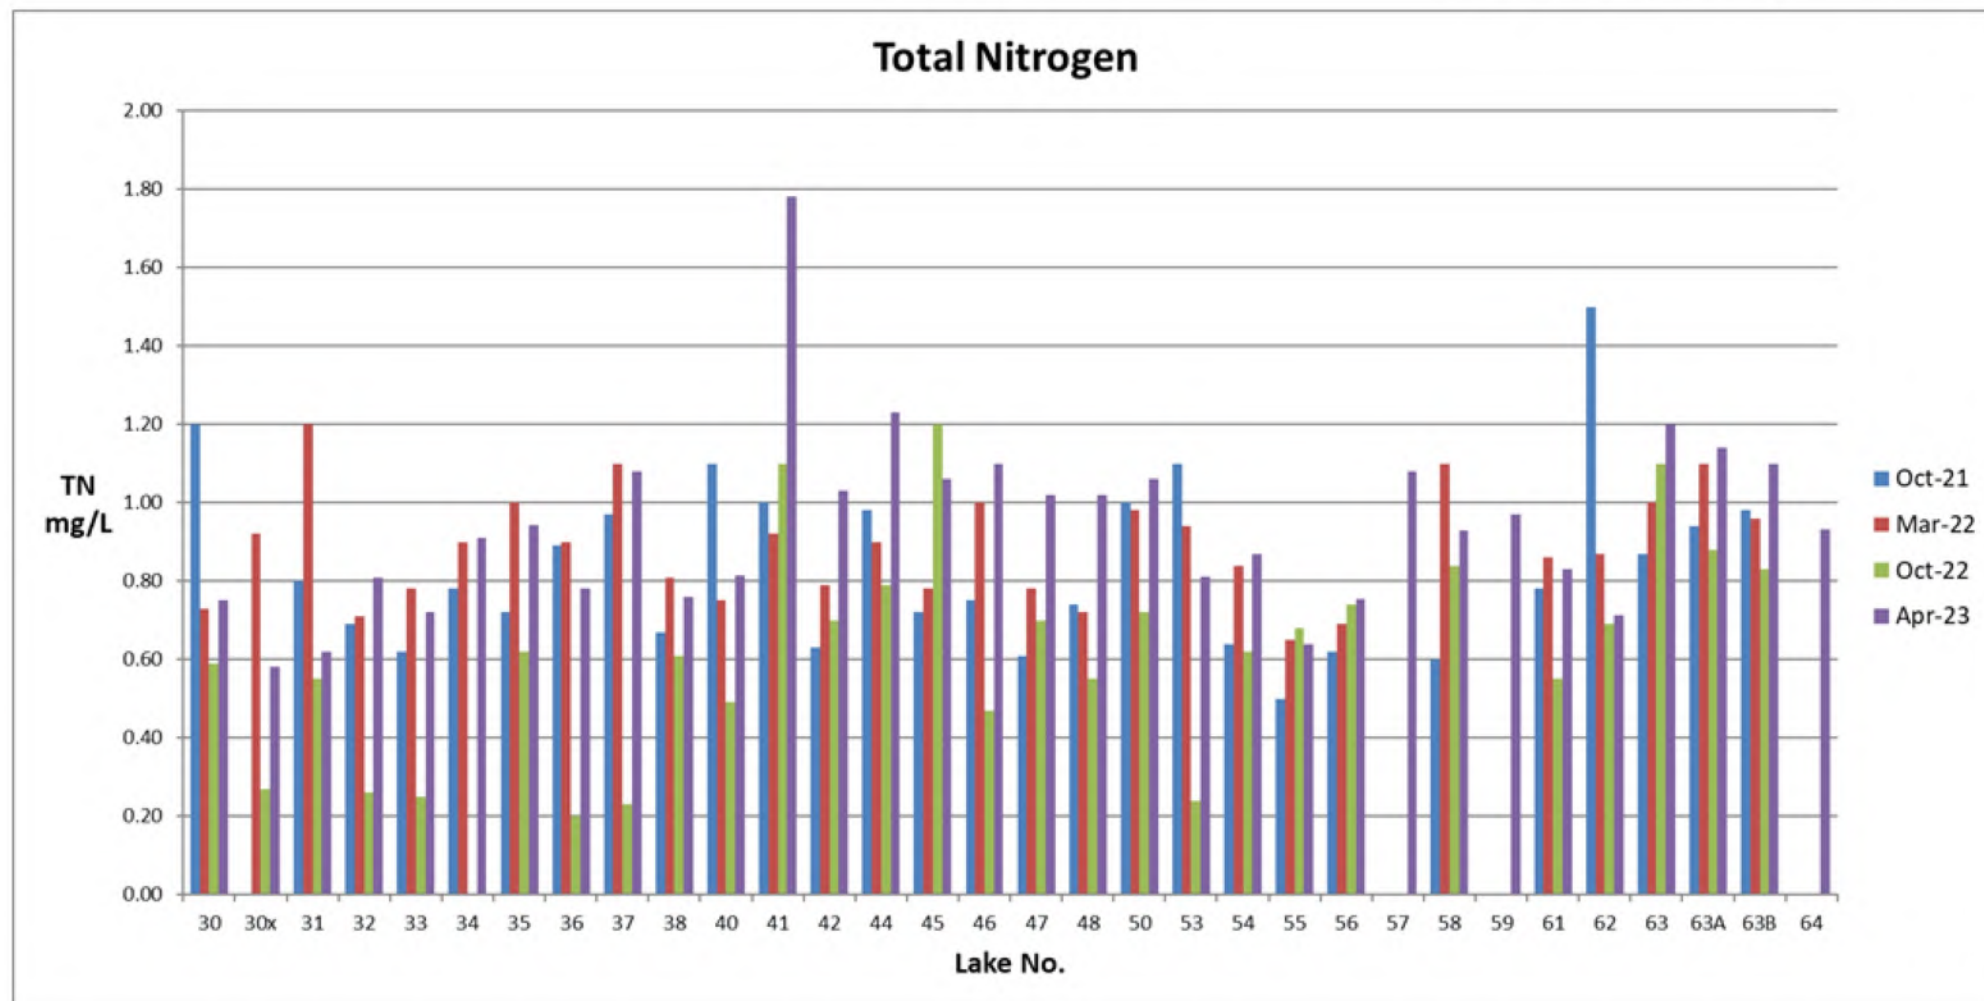


Scale: N/A
Date: 5/17/2023
Photo Date: N/A
Project No. Q0505.2
Biologist: DL GIS: ERR

TOTAL NITROGEN MEASUREMENTS OCT 2021 - APR 2023

THE QUARRY CDD
SECTIONS 13, 14, 23, AND 24, TOWNSHIP 48 SOUTH, RANGE 26 EAST
COLLIER COUNTY, FLORIDA

**FIGURE
7**

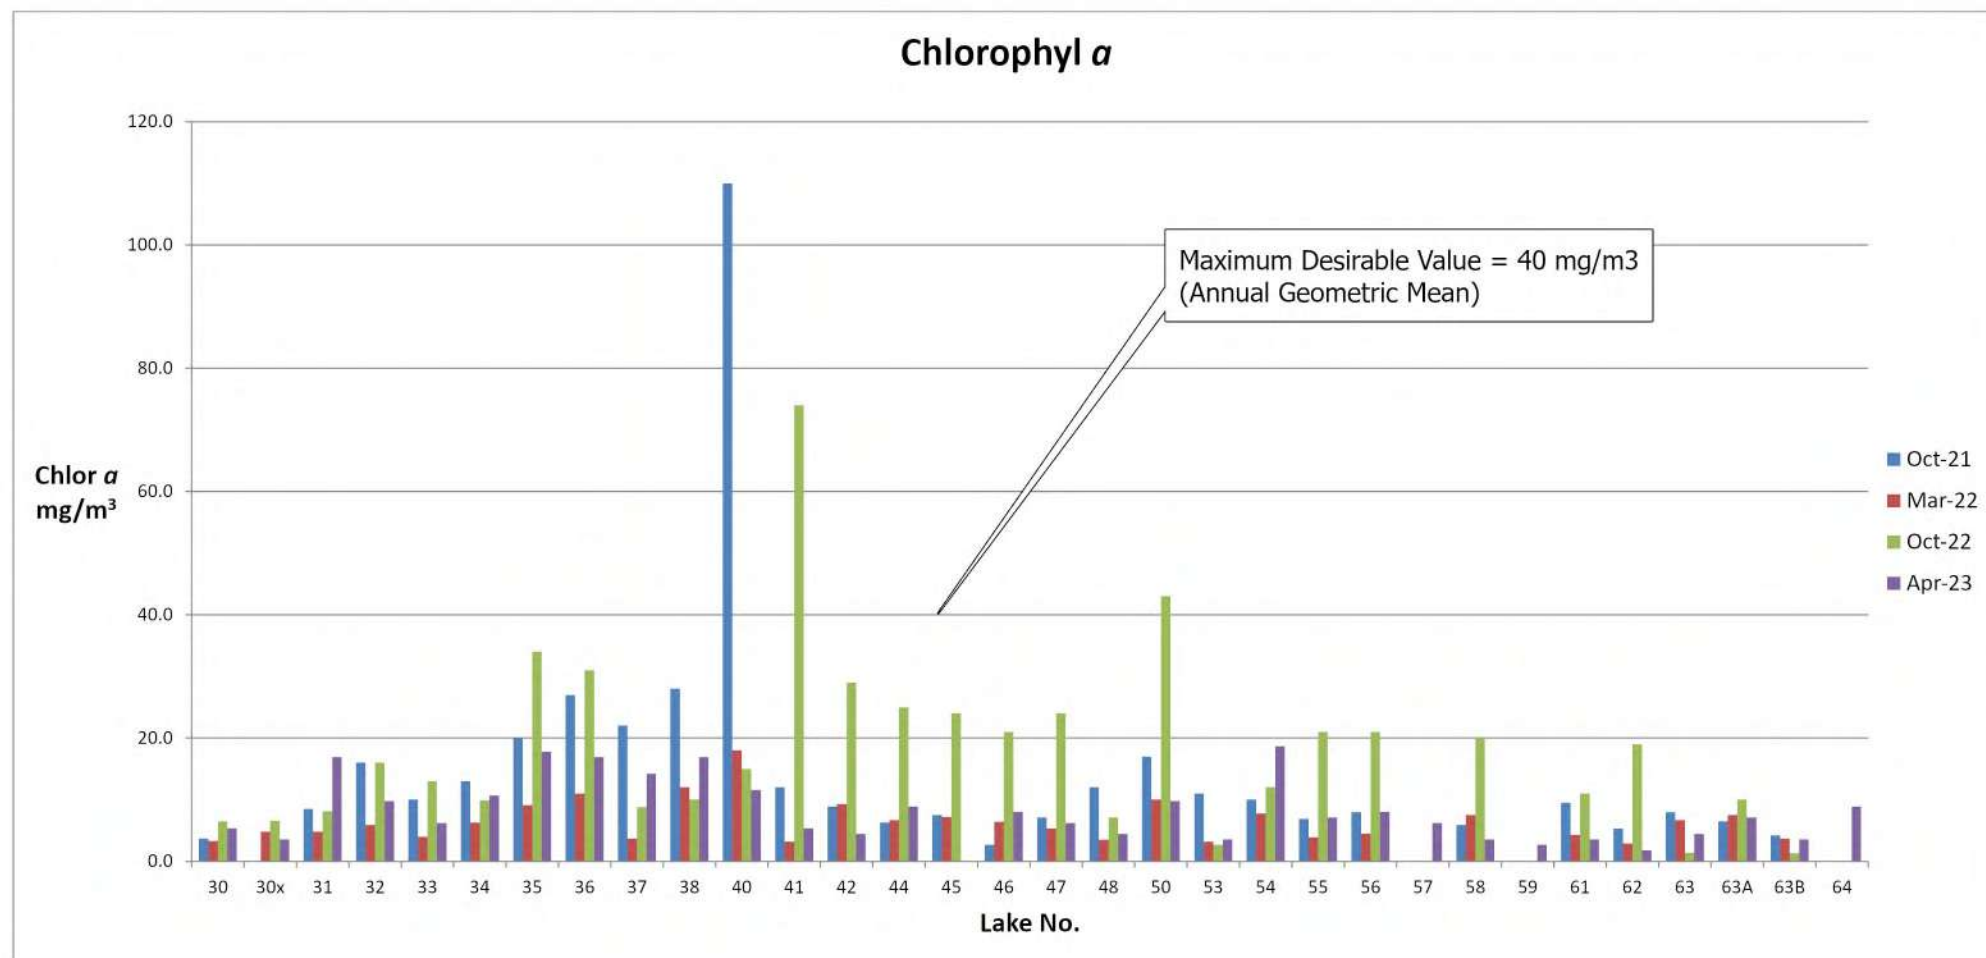


Scale: N/A
 Date: 5/17/2023
 Photo Date: N/A
 Project No. Q0505.2
 Biologist: DL GIS: ERR

CHLOROPHYLL A MEASUREMENTS OCT 2021 - APR 2023

THE QUARRY CDD
 SECTIONS 13, 14, 23, AND 24, TOWNSHIP 48 SOUTH, RANGE 26 EAST
 COLLIER COUNTY, FLORIDA

**FIGURE
8**

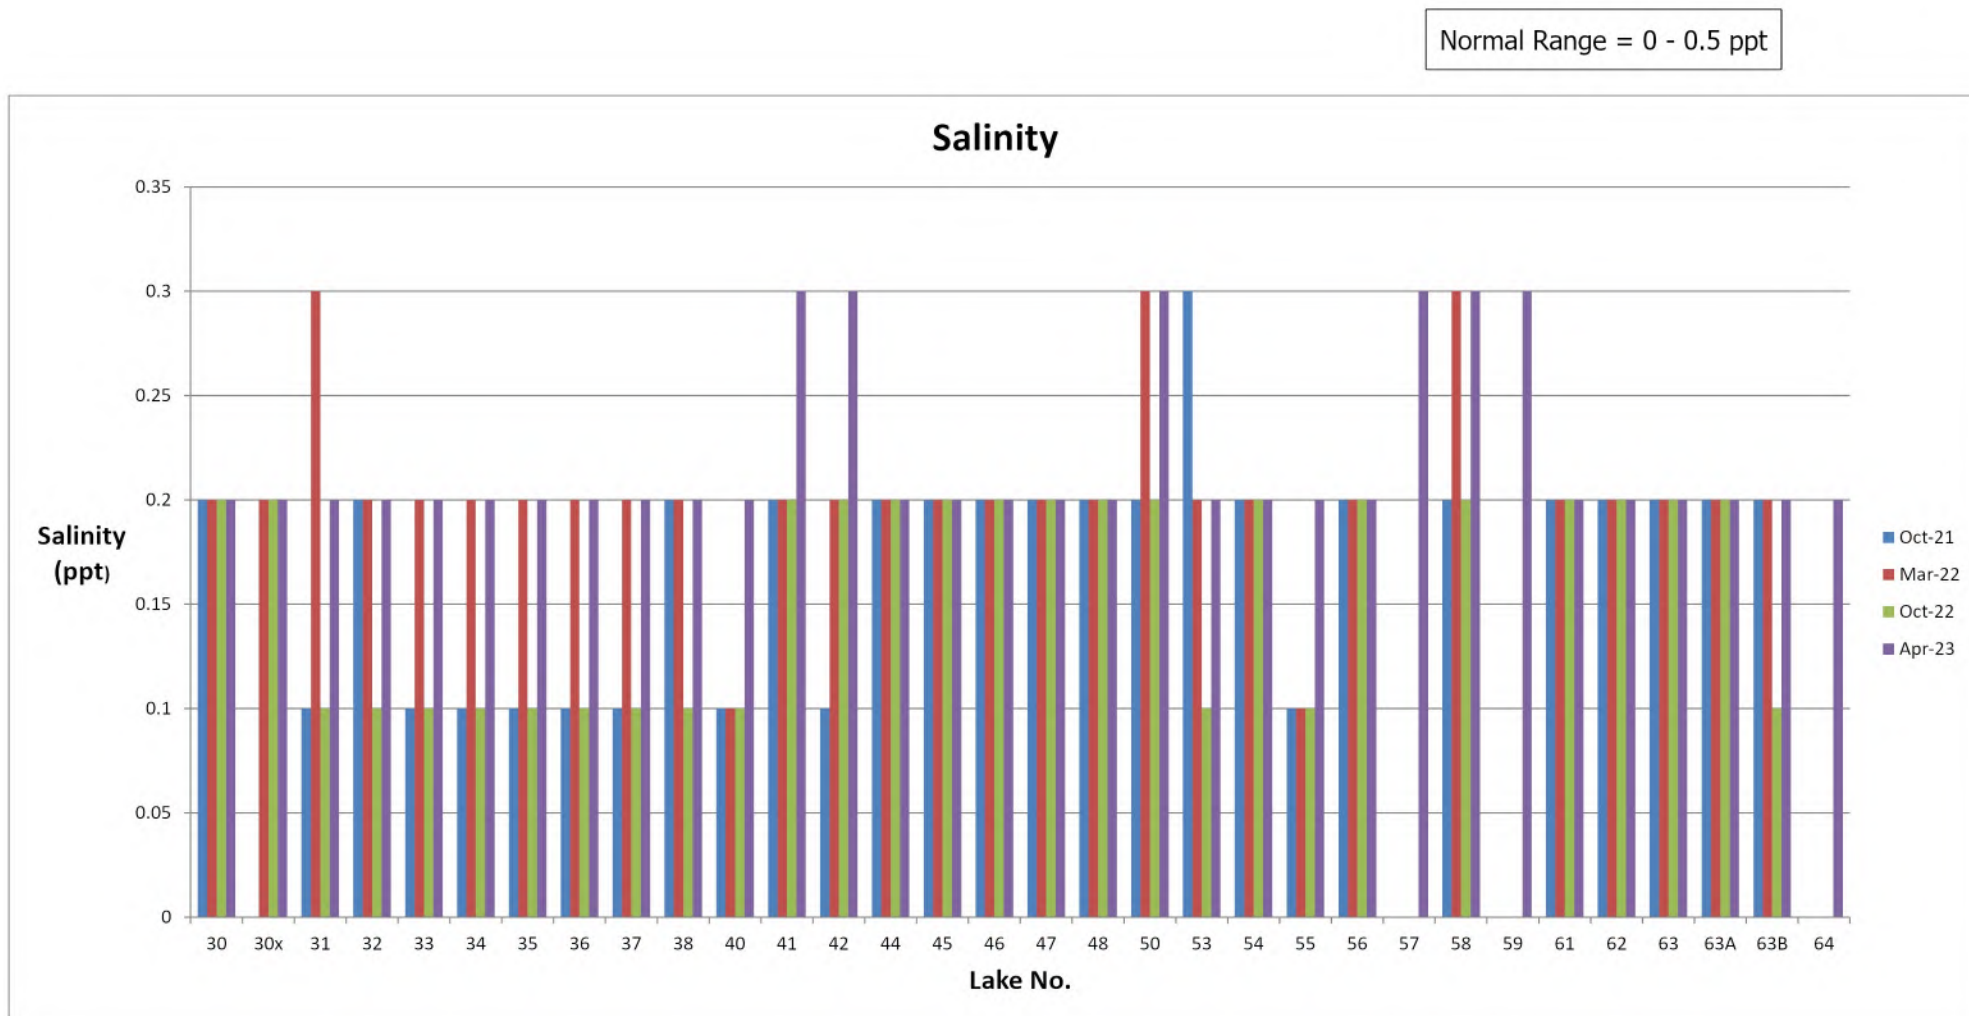


Scale: N/A
 Date: 5/17/2023
 Photo Date: N/A
 Project No. Q0505.2
 Biologist: DL GIS: ERR

SALINITY MEASUREMENTS OCT 2021 - APR 2023

THE QUARRY CDD
 SECTIONS 13, 14, 23, AND 24, TOWNSHIP 48 SOUTH, RANGE 26 EAST
 COLLIER COUNTY, FLORIDA

**FIGURE
9**

Maximum Desirable Value = 1,275 uS/cm

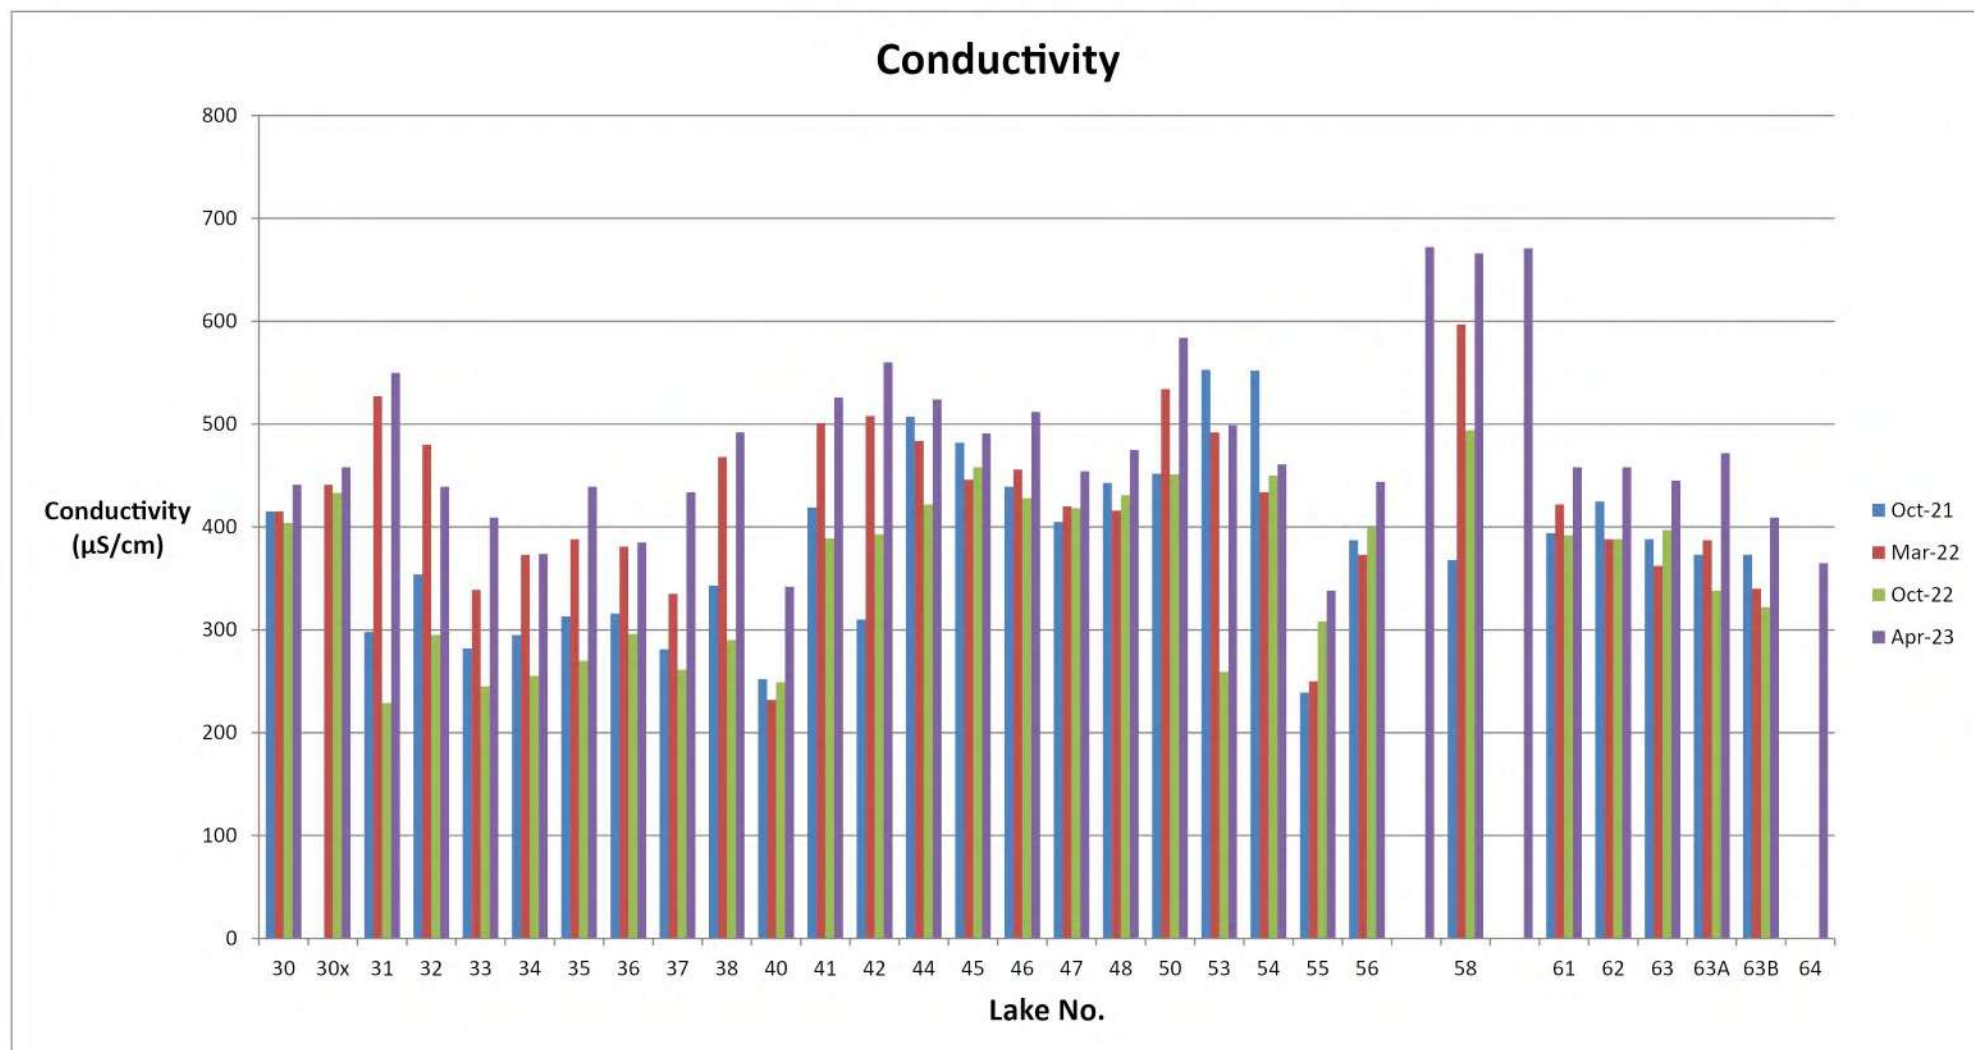

Scale: N/A

Date: 5/17/2023

Photo Date: N/A

Project No. Q0505.2

Biologist: DL GIS: ERR

CONDUCTIVITY MEASUREMENTS OCT 2021 - APR 2023

THE QUARRY CDD
SECTIONS 13, 14, 23, AND 24, TOWNSHIP 48 SOUTH, RANGE 26 EAST
COLLIER COUNTY, FLORIDA

**FIGURE
10**



APPENDIX B

Photographs of Sampling Locations

The Quarry CDD
May 2023
Water Quality Monitoring Report
Collier County, Florida



Lake 30



Lake 30



Lake 31



Lake 32



Lake 33



Lake 34



Lake 35



Lake 36



Date: 5/17/2023
 Photo Date: March 2023
 Project No. Q0505.2
 Biologist: DL
 GIS: ERR

PHOTOGRAPHS

THE QUARRY CDD
 SECTIONS 13, 14, 23, AND 24, TOWNSHIP 48 SOUTH, RANGE 26 EAST
 COLLIER COUNTY, FLORIDA

**APPENDIX
 C-1**



Lake 37



Lake 38



Lake 40



Lake 41



Lake 42



Lake 44



Lake 45



Lake 46



Date: 5/17/2023
Photo Date: March 2023
Project No. Q0505.2
Biologist: DL
GIS: ERR

PHOTOGRAPHS
THE QUARRY CDD
SECTIONS 13, 14, 23, AND 24, TOWNSHIP 48 SOUTH, RANGE 26 EAST
COLLIER COUNTY, FLORIDA

APPENDIX
C-2



Lake 47



Lake 48



Lake 50



Lake 53



Lake 54



Lake 55



Lake 56



Lake 57



Date: 5/17/2023
Photo Date: March 2023
Project No. Q0505.2
Biologist: DL
GIS: ERR

PHOTOGRAPHS
THE QUARRY CDD
SECTIONS 13, 14, 23, AND 24, TOWNSHIP 48 SOUTH, RANGE 26 EAST
COLLIER COUNTY, FLORIDA

**APPENDIX
C-3**



Lake 58



Lake 59



Lake 61



Lake 62



Lake 63



Lake 63A



Lake 63B



Lake 64



Date: 5/17/2023
 Photo Date: March 2023
 Project No. Q0505.2
 Biologist: DL
 GIS: ERR

PHOTOGRAPHS

THE QUARRY CDD
 SECTIONS 13, 14, 23, AND 24, TOWNSHIP 48 SOUTH, RANGE 26 EAST
 COLLIER COUNTY, FLORIDA


APPENDIX
 C-4

5B

FIELD OBSERVATION REPORT

Project Name	2022 Shoreline Phase IIB	Dates	05/8/2023 – 05/12/2023
Owner	Quarry CDD	Time/Weather	Sunny/Partly Cloudy/Rainy
CPH No.	Q0513	Inspector	Dimitrios Lambros
Personnel and Equipment on Site			
Contractor	Glase Golf LLC		
Subcontractor(s)			
Geotechnical Testing Lab			
Contractor Employees	1 Superintendent, 6 Operators, 6 Laborers		
Subcontractor Employees			
Equipment Active	2 – Excavators 3 – Dumpers 2 – Skid Steer	1 - Sweeper 1 - Loader 1 – Power Broom	
Work In Progress, Location, and Remarks			
<ul style="list-style-type: none"> • SWPPP in compliance. MOT in compliance, but minimal. 			
<ul style="list-style-type: none"> • Roads open to traffic. 			
<ul style="list-style-type: none"> • Scheduled 5 days for construction observation. 			
<ul style="list-style-type: none"> • Lake 57 <ul style="list-style-type: none"> ○ 287 LF of option 1: Fill, geotextile, rip rap ○ 230 LF of option 3 modification: Fill, coconut mesh, no littorals planted, geotextile, rip rap • Lake 42 <ul style="list-style-type: none"> ○ Leader drains to catch basins at 5 locations 			
<ul style="list-style-type: none"> • No accidents were reported this week. 			

Monday, May 8, 2023

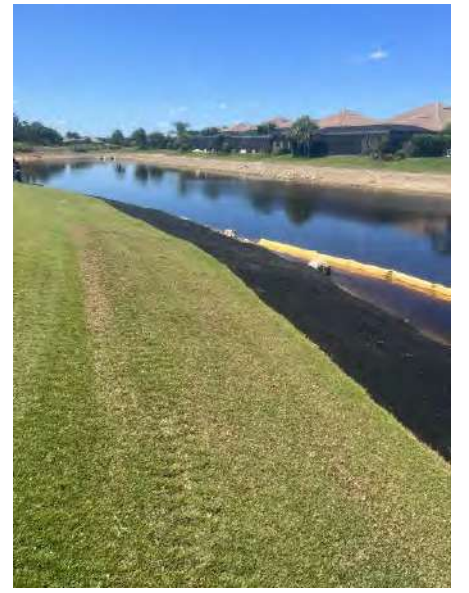

Tuesday, May 9, 2023



Wednesday, May 10, 2023



Thursday, May 11, 2023



Friday, May 12, 2023





FIELD OBSERVATION REPORT

Project Name.	2022 Shoreline Phase IIB	Dates	05.22 to 05.26.23
Owner	Quarry CDD	Time/Weather	Sunny/Partly Cloudy/Rainy
CPH No.	Q0513	Inspector	Dimitrios Lambros
Personnel and Equipment on Site			
Contractor	Glase Golf LLC		
Subcontractor(s)			
Geotechnical Testing Lab			
Contractor Employees	1 Superintendent, 2 Operators, 9 Laborers		
Subcontractor Employees			
Equipment Active	2 – Excavators 3 - Buggies 2 – Skid Steer	1 - Sweeper 1 -Front end Loader	
Work In Progress, Location, and Remarks			
<ul style="list-style-type: none"> SWPPP in compliance. 			
<ul style="list-style-type: none"> Roads open to traffic. 			
<ul style="list-style-type: none"> MOT in compliance, but minimal 			



- Meet 8:00 am Monday 5.22.23, Albert, Scott, Mike and Tony from Down to Earth at Clubhouse compiled a list of sites to review.
 - Ironstone Ln, no issues littorals planted.
 - Lake 50, Hole10; extend 5 sprinkler heads for better irrigation.
 - Copper rock Ct, Lake 30; move heads to inside of burm.
 - Boat ramp between Copper canyon/Copper rock Ct; change 5 heads to Rotors.
 - Marblestone Dr, Lake 54; check for irrigation heads at house #9359 side yard.
 - Lake 55; irrigation heads are up slope, no issues.
 - Lake 56; Weatherstone Dr. no issues.
 - Shale Ct, Lake 38; need 3 heads installed to irrigate Littorals.
 - Crystal Ct Lake 38; heads are very low. They need to be upslope.
- Lake 61, Graphite Cir, leader drain lines installed to the Lake:
 - between #9096/#9100 trench excavated to lake.
 - between #9104/#9100 trench excavated to lake.
 - between #9020/#9024 trench excavated, bubble box removed piped to lake.
 - between #9036/#9028 trench excavated to lake.
 - Repairs to broken pipe/wire in trench #9036/9028 and pipe/head in trench #9020/#9024.
 - Tony from Down to Earth completed the repairs.
- Lake 61; Graphite Cir, Opt 3; 140 LF of Fill dirt and 8' of coconut blanket on North shore, 90 LF at south shore.
- Lake 62; Limestone Ln, Opt 3; 62 LF, Fill dirt and 8' coconut blanket.
- **Thompson Underwater Contractors on site** and located the 4-48" outflows at easement.
- Clase Golf LLC crew jumped in and hand dug irrigation lines/heads;
 - Lake 48, Nickle Ridge; several marked heads on south/east relocated/installed for proper irrigation of Littorals.
 - Lake 46; several marked heads around lake relocated/installed for proper irrigation of Littorals.
 - Lake 50, Quarry Dr; four heads relocated/installed for proper irrigation of Littorals.
 - Lake 54; Marblestone Dr; 3 heads relocated/installed.
 - Lake 55; Marblestone Dr, 2 heads relocated/installed.
 - Lake 56; Marblestone Dr, 3 heads relocated/installed.
 - Lake 32; Quartz Ln, 1 head relocated/installed.
- Lake 30; Hideaway Harbor Ct, excavated trenches for 5 heads.
- Lake 63; Siesta Bay Dr; Opt 3, 357 LF, Fill dirt and 8' width of coconut blanket, rip rap around outfalls.
- Lake 45; between #9681/#9685 Cobalt Cir, trench drain to lake.
 - Bubble box removed, drain pipe added to lake.
- Lake 58; #9230 Gypsum Way, trench drain to lake.
 - Bubble box removed, drain pipe added to lake.
- Lake 57; Ores Cir, Opt 3; 145 LF, Fill dirt and 8' width of coconut blanket.





Monday, May 22, 2023, Ironstone Ln



Tuesday, May 23, 2023, #9096 and #9100, Graphite Cir, Lake 61.





Wednesday, May 24, 2023,
Thompson Underwater Contractors at Outflow easement



Wednesday, May,24, 2023, Outflow easement, cleaning 1 of 4 - 48" outfalls headwall,
Lake 30 Shore Lake easement.





Wednesday, May 24, 2023, Lake 48, Nickle Ridge Cir.



Thursday, May 25, 2023, Lake 50, Hole 10
4 heads moved





Friday, May 26, 2023, #9681/#9685 Cobalt Cir, bubble box removed
drainpipe added to lake



Friday, May 26, 2023, Gypsum Way lake 58, downspout washout





Friday, May 26, 2023, Gypsum Way, Lake 57
bubble box removed. Gutter leader piped to lake.



Siesta Bay Lake 63, opt 3, rip rap around out falls.





Friday, May 26, 2023, Lake 57, Ores Cir
Opt 3, 145 LF



Friday, May 26, 2023, Hideaway Harbor Ct; lines and heads added





FIELD OBSERVATION REPORT

Project Name.	2022 Shoreline Phase IIB		Dates	05.29 to 06.02.23
Owner	Quarry CDD		Time/Weather	Sunny/Partly Cloudy/Rainy
CPH No.	Q0513		Inspector	Dimitrios Lambros
Personnel and Equipment on Site				
Contractor	Glase Golf LLC			
Subcontractor(s)				
Geotechnical Testing Lab				
Contractor Employees	1 Superintendent, 6 Operators, 6 Laborers			
Subcontractor Employees				
Equipment Active	2 – Excavators 3 - Buggies 2 – Skid Steer	1 - Sweeper 1 -Front end Loader		
Work In Progress, Location, and Remarks				
<ul style="list-style-type: none"> • SWPPP in compliance. 				
<ul style="list-style-type: none"> • Roads open to traffic. 				
<ul style="list-style-type: none"> • MOT in compliance, but minimal 				



- Memorial Day, no work
- Shale Ct, Lake 36; 8 irrigation lines and sprinkler heads installed for Littoral irrigation.
 - Turbidity barrier placed.
 - Washout behind #9170 Shale Ct; filled, trench to lake and placed drainage pipe.
 - Washout behind #9162 Shale; filled, trench between #9162/#9166, 4" to 8" drain to lake.
 - Washout behind #9180 Quartz Ln filled, trench between #9180/#9176 and behind #9176 catch basin placed, piped 4" to 8" drainage to lake.
 - Fill dirt placed in washout.
- Quarry Dr, Lake 63 A; Opt 3; 312 LF, fill dirt compacted and 8' of coconut blanket placed.
- Ironstone Ln, Lake #42; Turbidity barrier placed.
 - Hand trench between #9545/#9541 Ironstone and placed drain pipe to lake.
Option 2, 60 LF between #9541/9545.
 - Hand trench between #9537/#9533 Ironstone and placed drain pipe to lake.
Opt 2, 60 LF between #9537/#9533.
 - Hand trench between #9533/# 9529 Ironstone and paced drain pipe to lake.
Opt 2, 60 LF between #9533/#9529.
 - Hand trench between #9525/#9521 Ironstone and placed drain pipe to lake.
Opt 2, 60 LF between #9525/#952.
- Siesta Bay #9060 hand trench leaders, pipe to lake 63.
 - #9064/#9060; hand trench 4 irrigation lines and heads for Littoral irrigation.



Tuesday, May 30, 2023, Ironstone Ln #9545/#9541





Tuesday, May 30, 2023, Shale Ct. irrigation





Tuesday, May 30, 2023, Quarry Dr., Lake 36a





Wednesday, May 31, 2023, Shale Ct.
#9166/#9162





Wednesday, May 31, 2023, Washout #9170 Shale Ct.





Thursday, June 1, 2023, washout #9180, #9176
Quartz Ln.



Thursday, June 1, 2023, #9180 and #9176 Quartz Ln





Friday, June 2, 2023, Ironstone Ln #9525/#9521
trench to lake



Friday, June 2, 2023, Siesta Bay # 9060/#9064
leaders to lake 36







FIELD OBSERVATION REPORT

Project Name.	2022 Shoreline Phase IIB	Dates	06.05 to 06.09.23
Owner	Quarry CDD	Time/Weather	Sunny/Partly Cloudy/Rainy
CPH No.	Q0513	Inspector	Dimitrios Lambros
Personnel and Equipment on Site			
Contractor	Glase Golf LLC		
Subcontractor(s)			
Geotechnical Testing Lab			
Contractor Employees	1 Superintendent, 6 Operators, 6 Laborers		
Subcontractor Employees			
Equipment Active	2 – Excavators 3 - Buggies 1 – Skid Steer	1 - Sweeper 1 -Front end Loader	
Work In Progress, Location, and Remarks			
<ul style="list-style-type: none"> SWPPP in compliance. 			
<ul style="list-style-type: none"> Roads open to traffic. 			
<ul style="list-style-type: none"> MOT in compliance, but minimal 			



- Ironstone Ln, Lake #42, between #9509/#9505 hand trench and drain to lake, opt 2 between #9509/#9505 to round bend in lake
- Gypsum Way, Lake ; between #9230/#9236 repair washout again from heavy weekend rains. As per Albert Marafi/Rip rap placed 10' to each side of wash out area.
- Limestone Ln, Lake 59; between #9154/9150, hand trench 4' - 8" drain to Lake. As per Albert Marafi/rip rap placed 10' to each side of drain in wash out area.
- Limestone Ln, Lake 59, hole #7; Littorals planted.
- Universal Testing tech (Patrick) onsite; Protor taken last week from fill pile in the staging area; Rip rap samples taken today from staging area; compaction tests taken at 6 sites, Lake 61 Lake 62, Lake 36, Lake 36a, Lake 56 and Lake 45.
- Quartz Ln, Lake 36, between #9180/9176 repair washout again from heavy weekend rains. As per Albert, rip rap placed in wash out from grassline to shoreline. Basin area re contoured and sod placed to rip rap.
- Shale Ct, between #9166/#9162, repair previously repaired (5/31) washout, fill dirt placed into washout and compacted. Fresh coconut blanket placed.
- Limestone Ln; between #9130/9134 outside Lanai (9134) screen door, removed old sod and replaced with new sod. I walked/inspected the site with Scott.
- As per Albert, I asked Scott on future leader to lake drain installs, to knock on owner doors before starting, also asked Scott to place a silt fence at dirt pile in the staging area.
- Graphite Cir; between #9036/#9028 repair washout and remove old sod/replace with new sod.
 - #9104/#9100 remove old sod/replace with new.
 - #9020/#9024 repair washout and remove old sod/replace with new sod.
- Coastline Ct; Lk 30, Turbidity curtain placed, Opt 3, 150 LF. 28 LF of rip rap from grass line to shoreline on south where washout occuring between bldgs #8779/#8775.
- Crystal Ct; between #9121/#9131, trench to drain leaders to lake, 4" to 8".
- Power sweep Coastal Ct, Quarry Dr and Ped walk at the staging area.



Monday, June 5, 2023
Ironstone Ln, #9509/#9505



Monday, June 5, 2023
Gypsum Way #9230/#9236 rip rap





Monday, June 5, 2023

Limestone Ln, #9154 and #9150 rip rap at washout



Tuesday, June 6, 2023

Littorals Lake 59, Hole 7





Tuesday, June 6, 2023
Limestone Ln; #9134



Tuesday, June 6, 2023.
Shale Ct, repair





Tuesday, June 6, 2023.
Universal Testing Compaction Test
Lake 61



Tuesday, June 6, 2023
Universal Testing Compaction Test
Lake 45





Wednesday, June 7, 2023
Quartz Ln #9180 rip rap and Shale Ct, #9166/#9162 repair.



Thursday, June 8, 2023
Graphite Cir; #9036/#9028





Thursday, June 8, 2023
Graphite Cir; #9104/9100



Thursday, June 8, 2023
Graphite Cir; #9020/#9024





Friday June 8, 2023
Coastal Ct; Lk 30




Friday June 9, 2023
Crystal Ct; #9121/#9131








5D

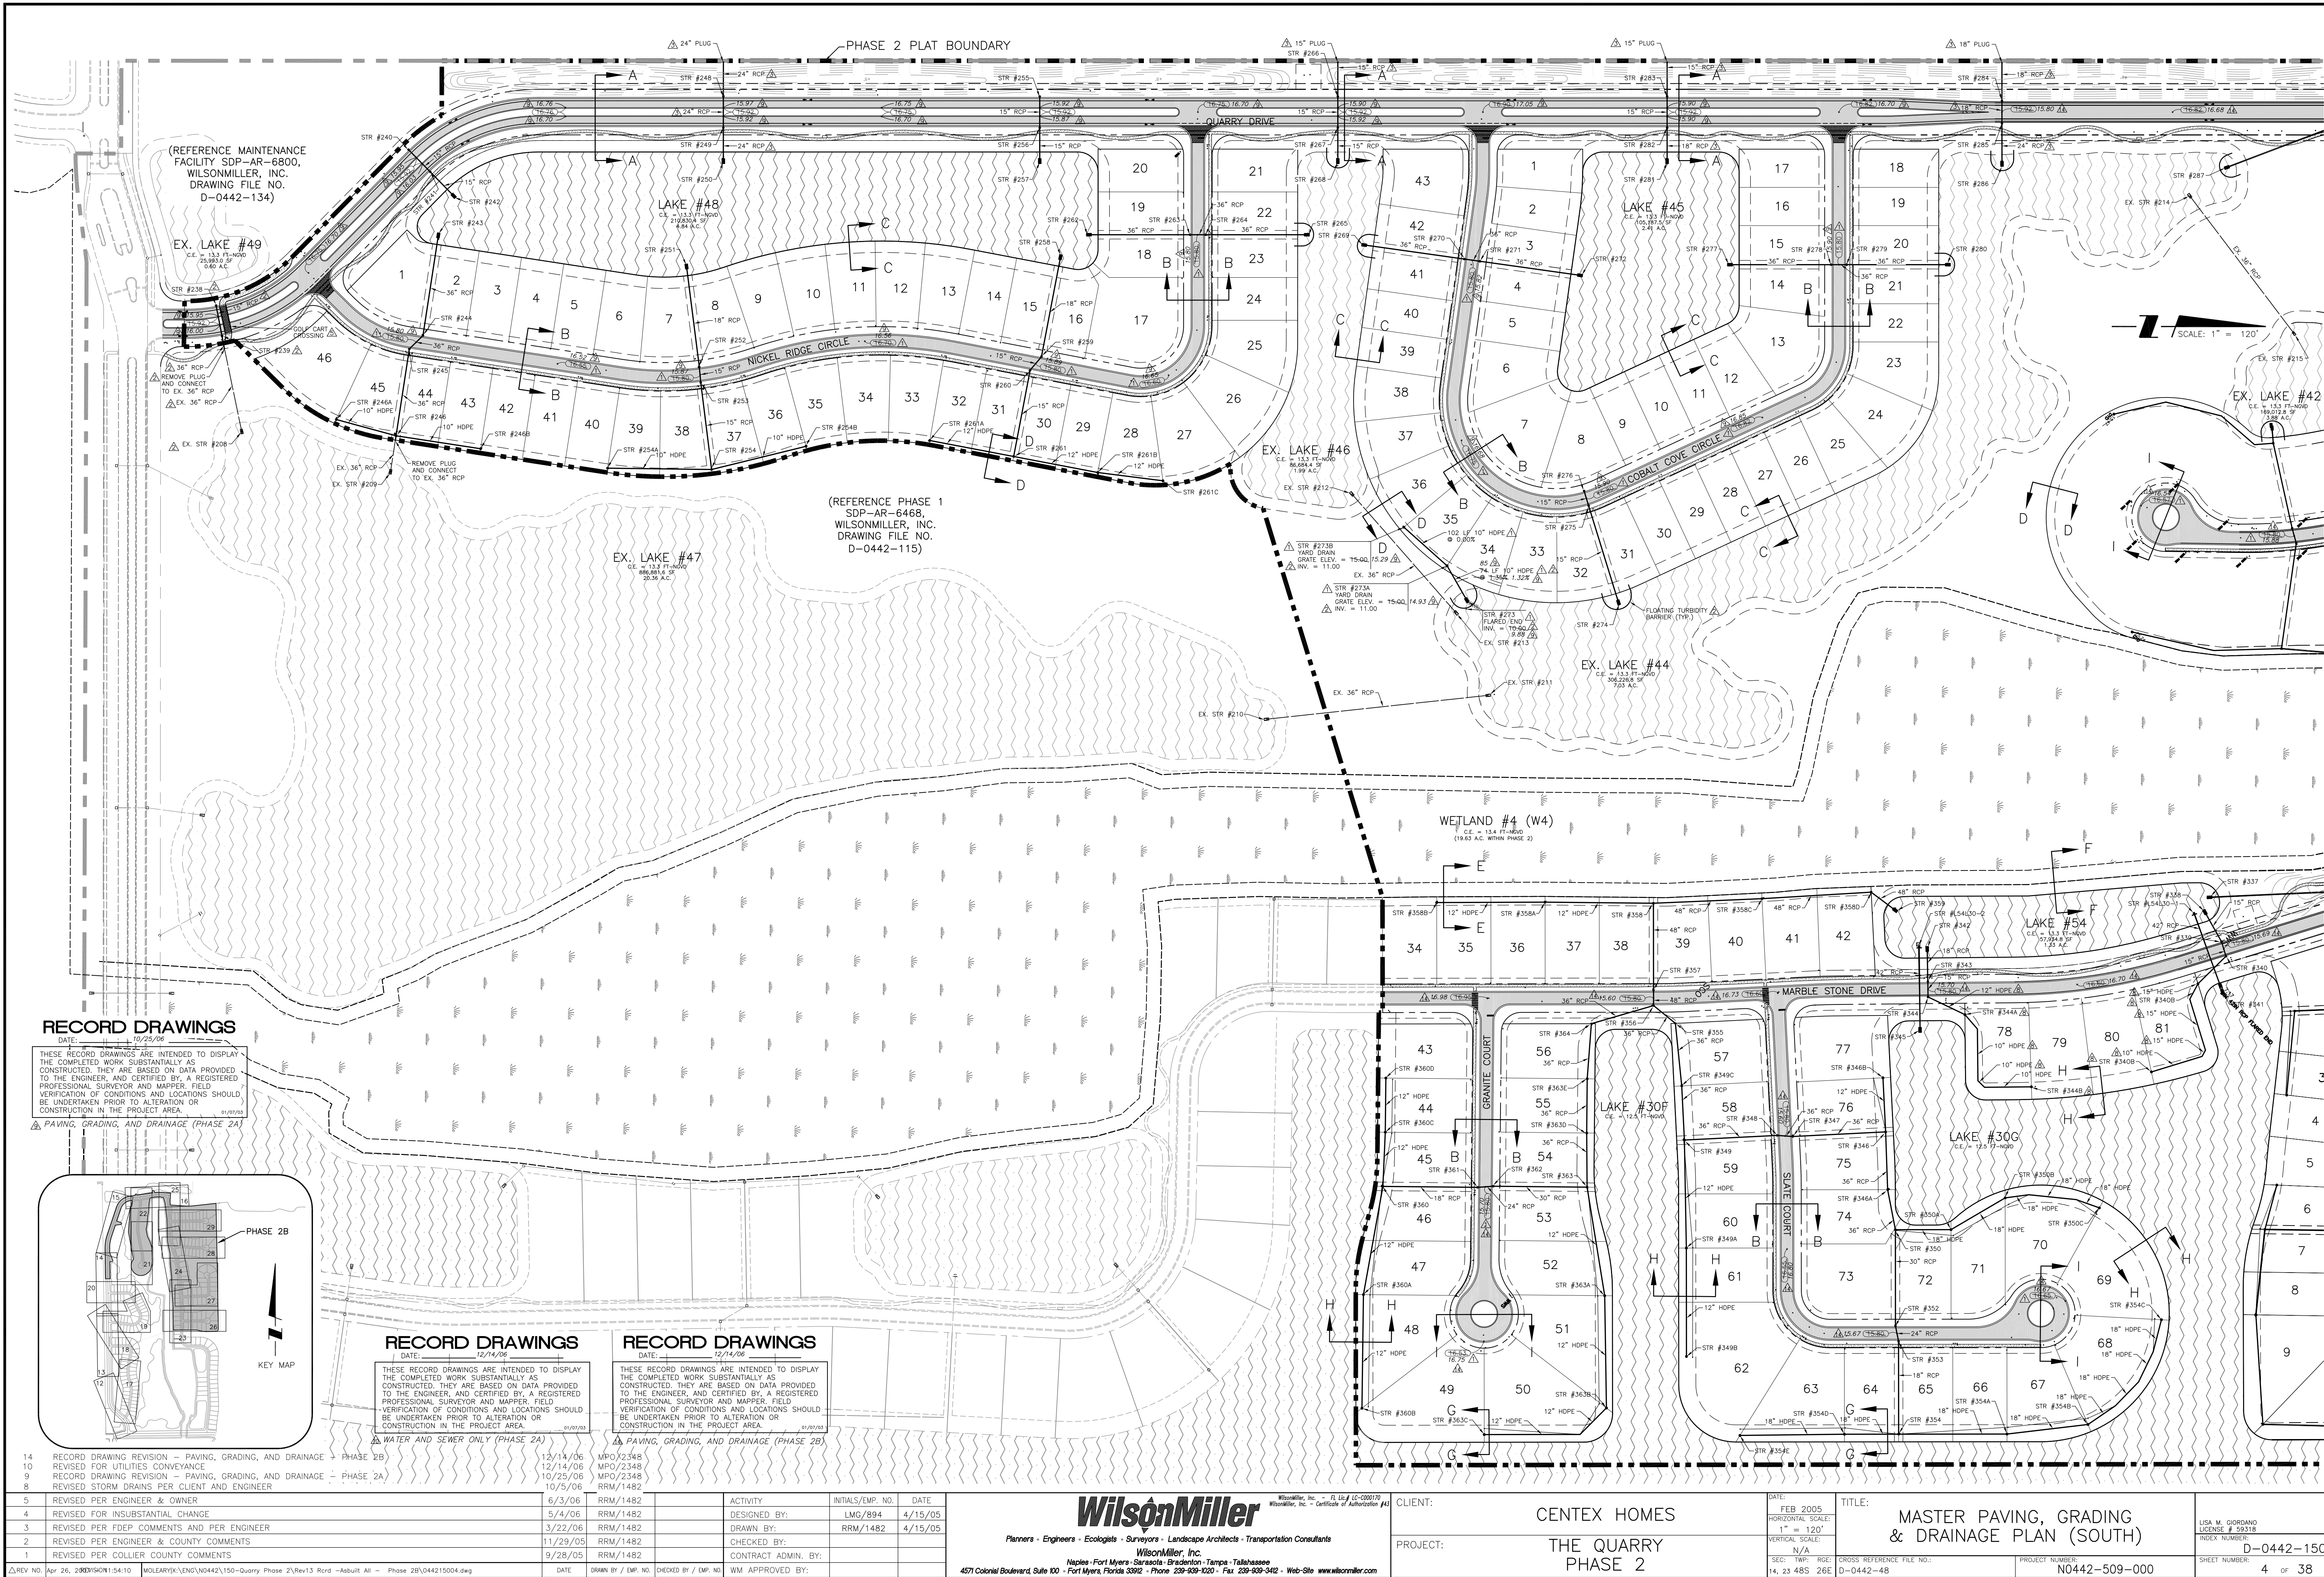



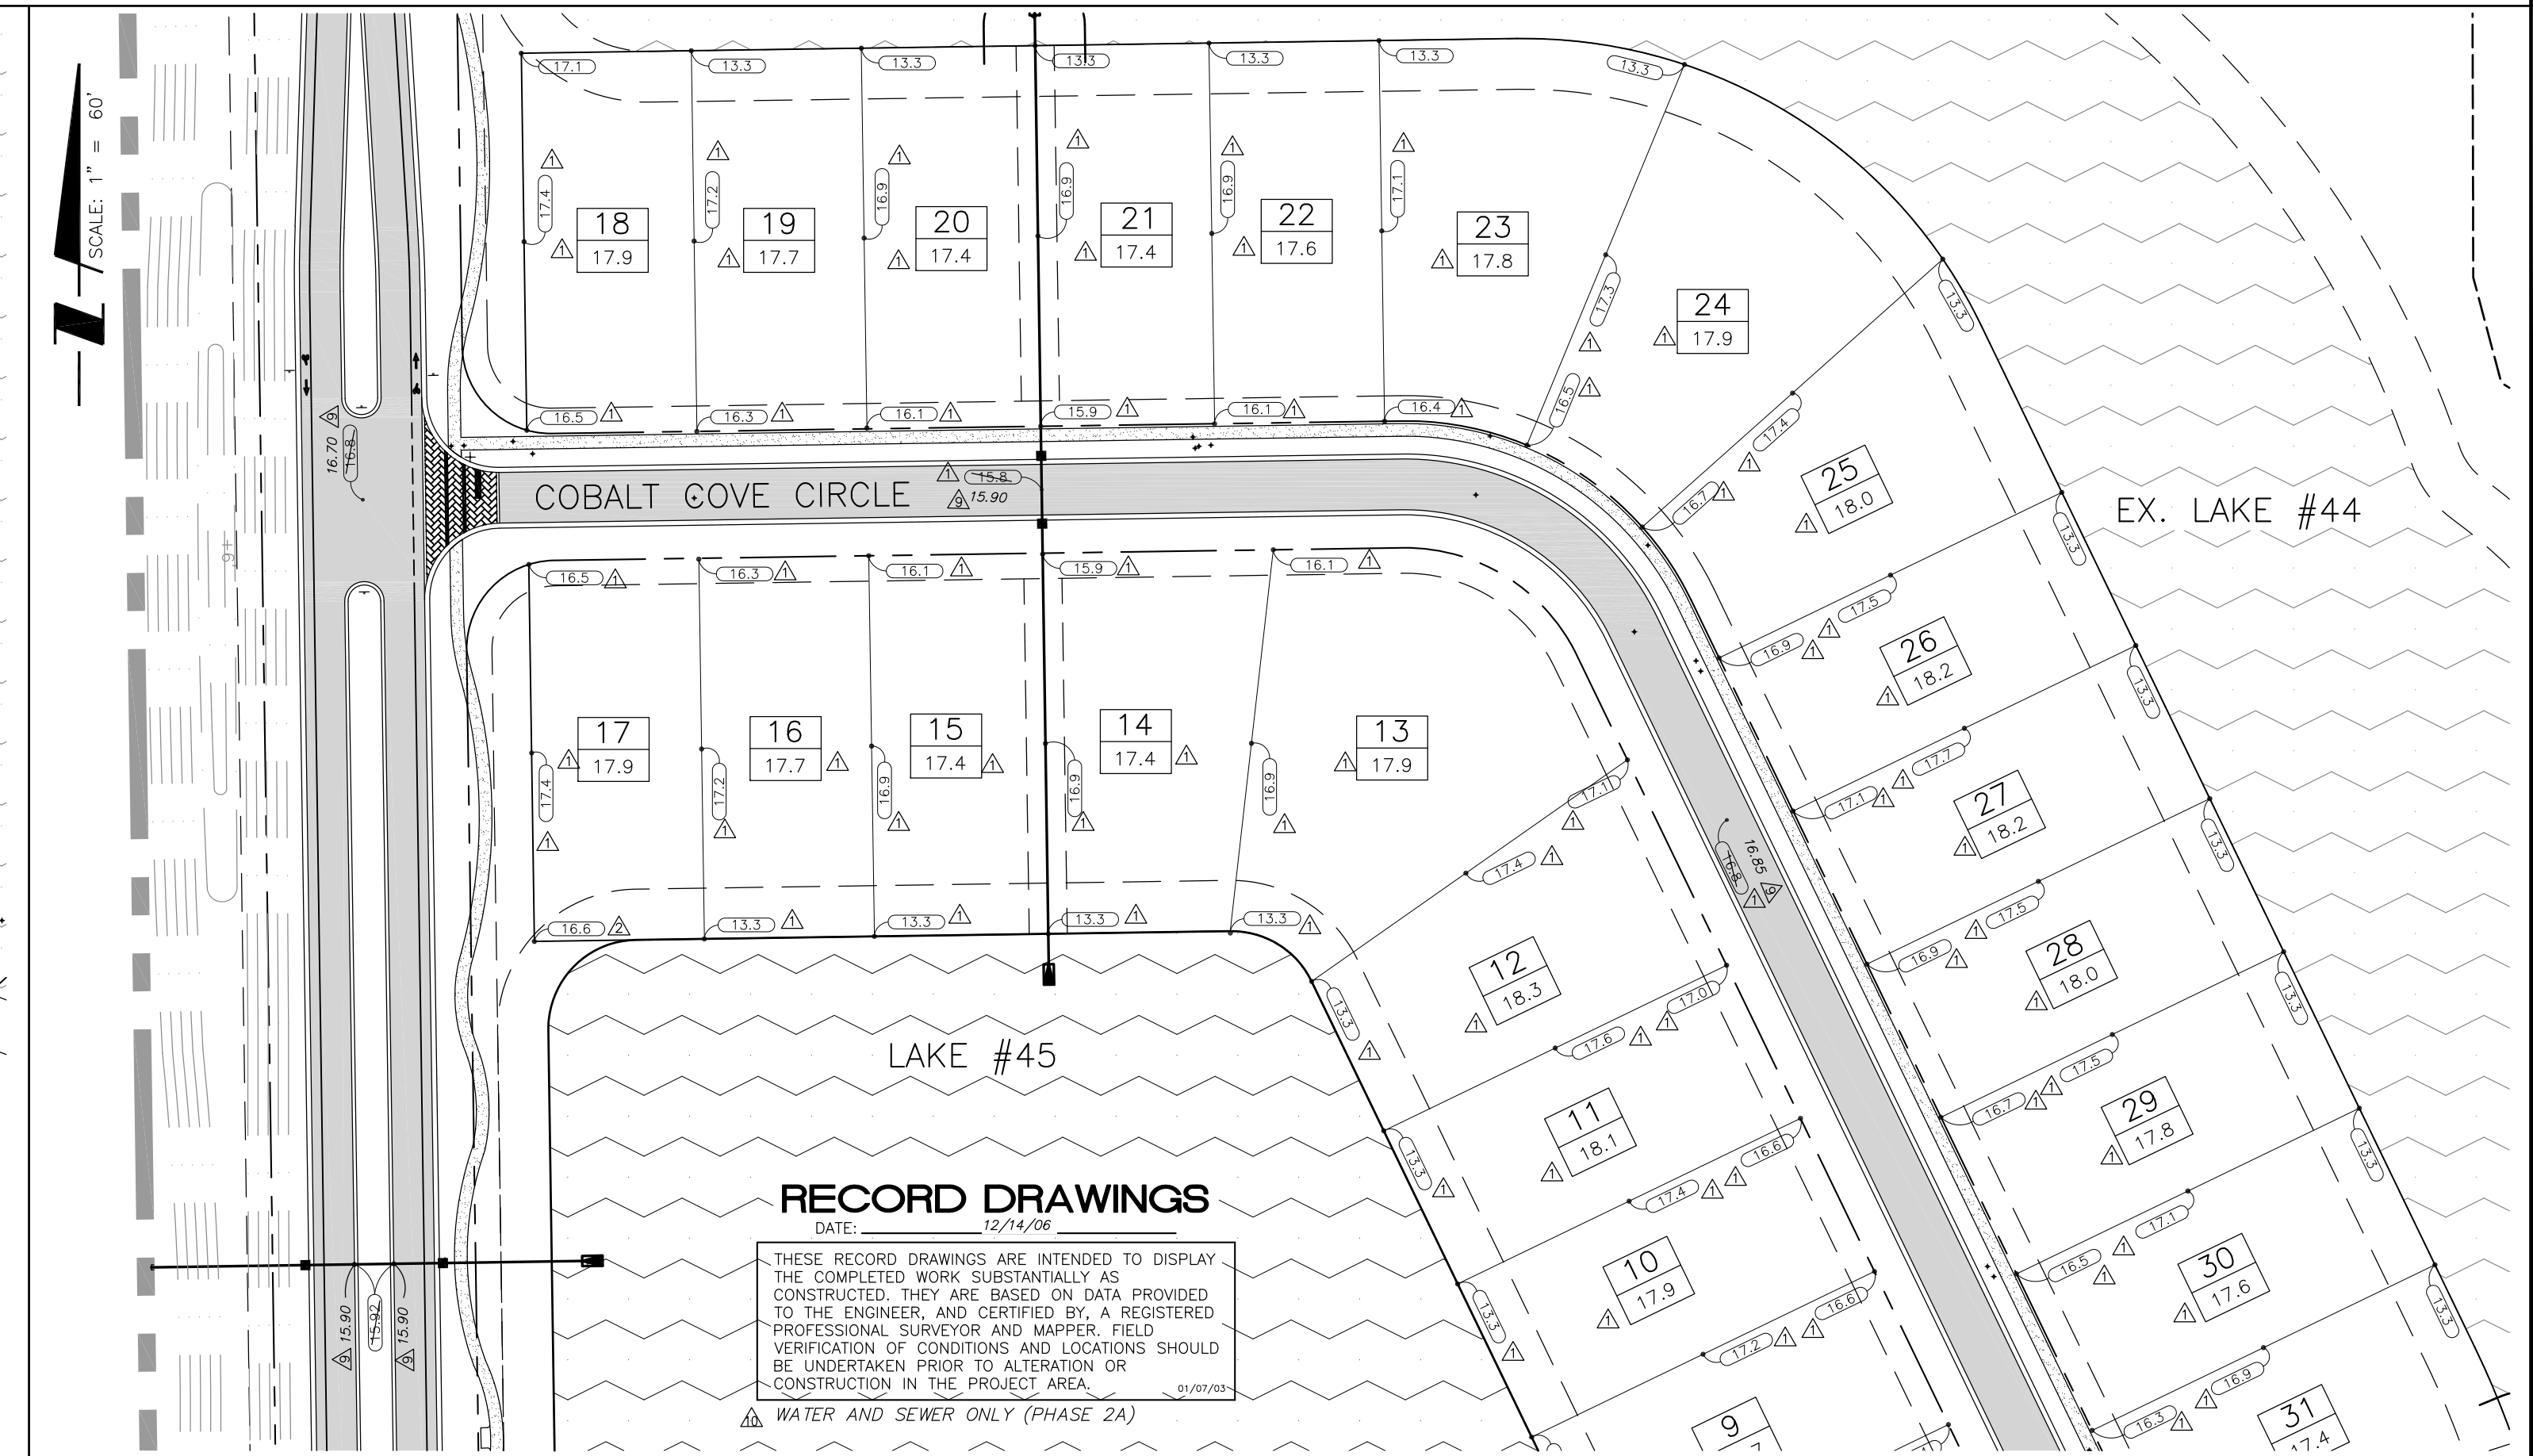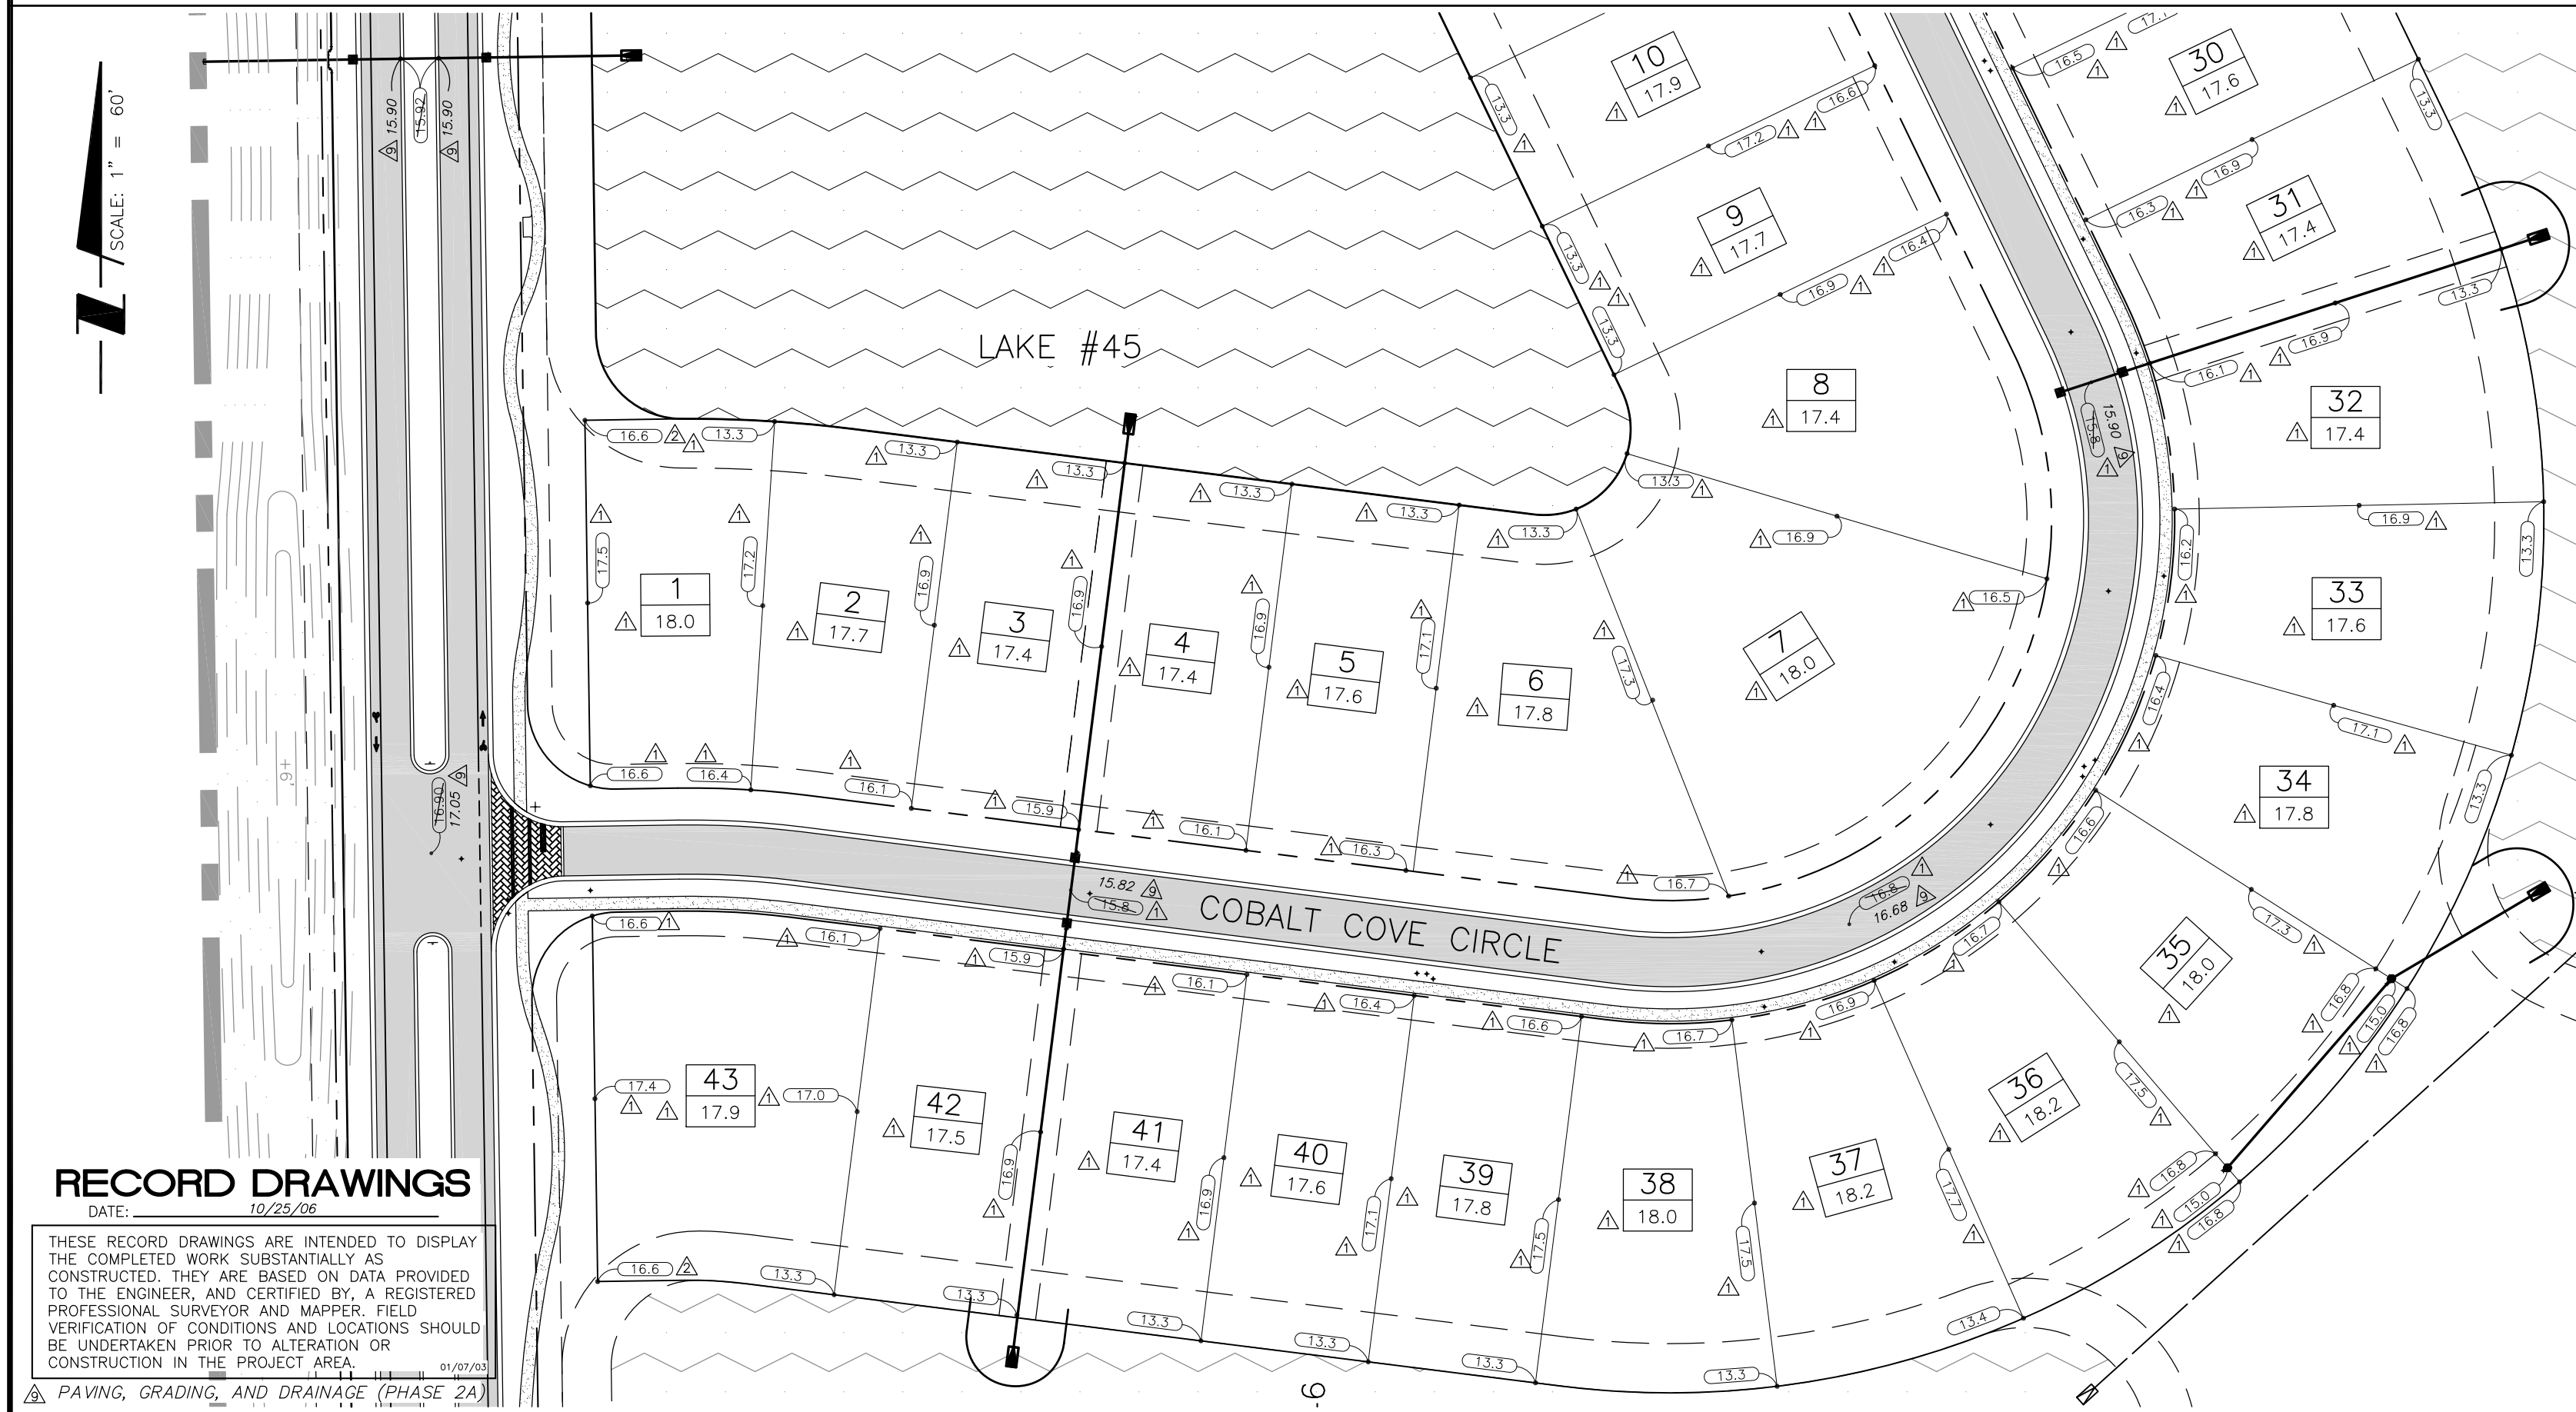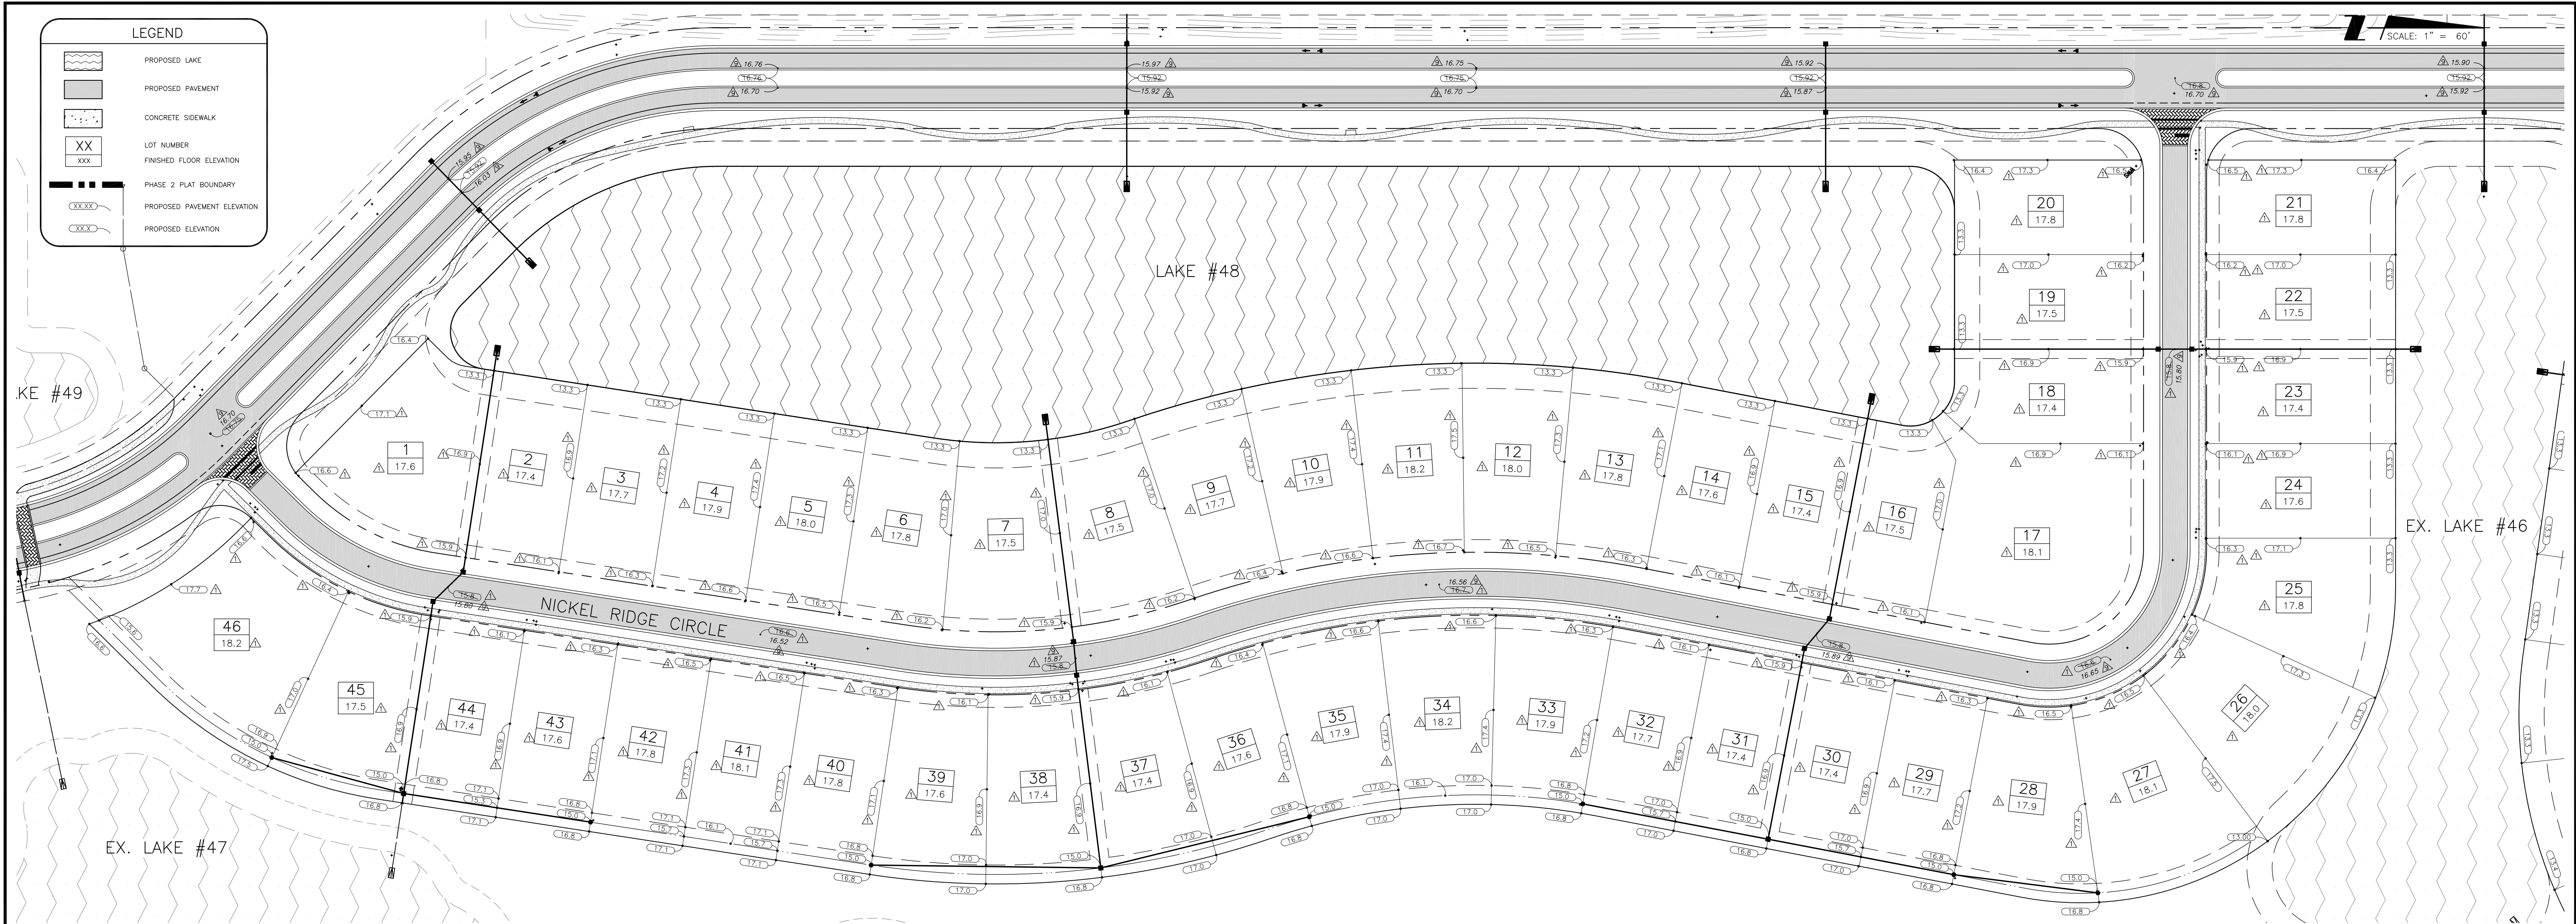

10	REVISED FOR UTILITIES CONVEYANCE	12/14/06	MPO/2348	ACTIVITY	INITIALS/EMP. NO.	DATE	<div><div><div><div><div></div><div></div><div></div><div></div></div><div><div></div><div></div><div></div><div></div></div></div><div><div><div><div></div><div></div><div></div><div></div></div><div><div></div><div></div><div></div><div></div></div></div><div><div><div><div></div><div></div><div></div><div></div></div><div><div></div><div></div><div></div><div></div></div></div><div><div><div><div></div><div></div><div></div><div></div></div><div><div></div><div></div><div></div><div></div></div></div><div><div><div><div></div><div></div><div></div><div></div></div><div><div></div><div></div><div></div><div></div></div></div><div><div><div><div></div><div></div><div></div><div></div></div><div><div></div><div></div><div></div><TO THE ENGINEER, AND CERTIFIED BY, A REGISTERED PROFESSIONAL SURVEYOR AND MAPPER. FIELD VERIFICATION OF CONDITIONS AND LOCATIONS SHOULD BE UNDERTAKEN PRIOR TO ALTERATION OR CONSTRUCTION IN THE PROJECT AREA.

01/01/03


WATER AND SEWER ONLY (PHASE 2A) 08/20/06
PAVING, GRADING, AND DRAINAGE (PHASE 2A) 10/05/06
WATER AND SEWER ONLY (PHASE 2B) 12/14/06
PAVING, GRADING, AND DRAINAGE (PHASE 2B-1) 12/14/06

LEGEND

- PROPOSED LAKE
- PROPOSED PAVEMENT
- CONCRETE SIDEWALK
- LOT NUMBER
- FINISHED FLOOR ELEVATION
- PHASE 2 PLAT BOUNDARY
- PROPOSED PAVEMENT ELEVATION
- PROPOSED ELEVATION



NOTE:
RECORD PAVEMENT ELEVATIONS ARE FOR 1ST LIFT OF ASPHALT ONLY.


WETLAND #4 (W4)

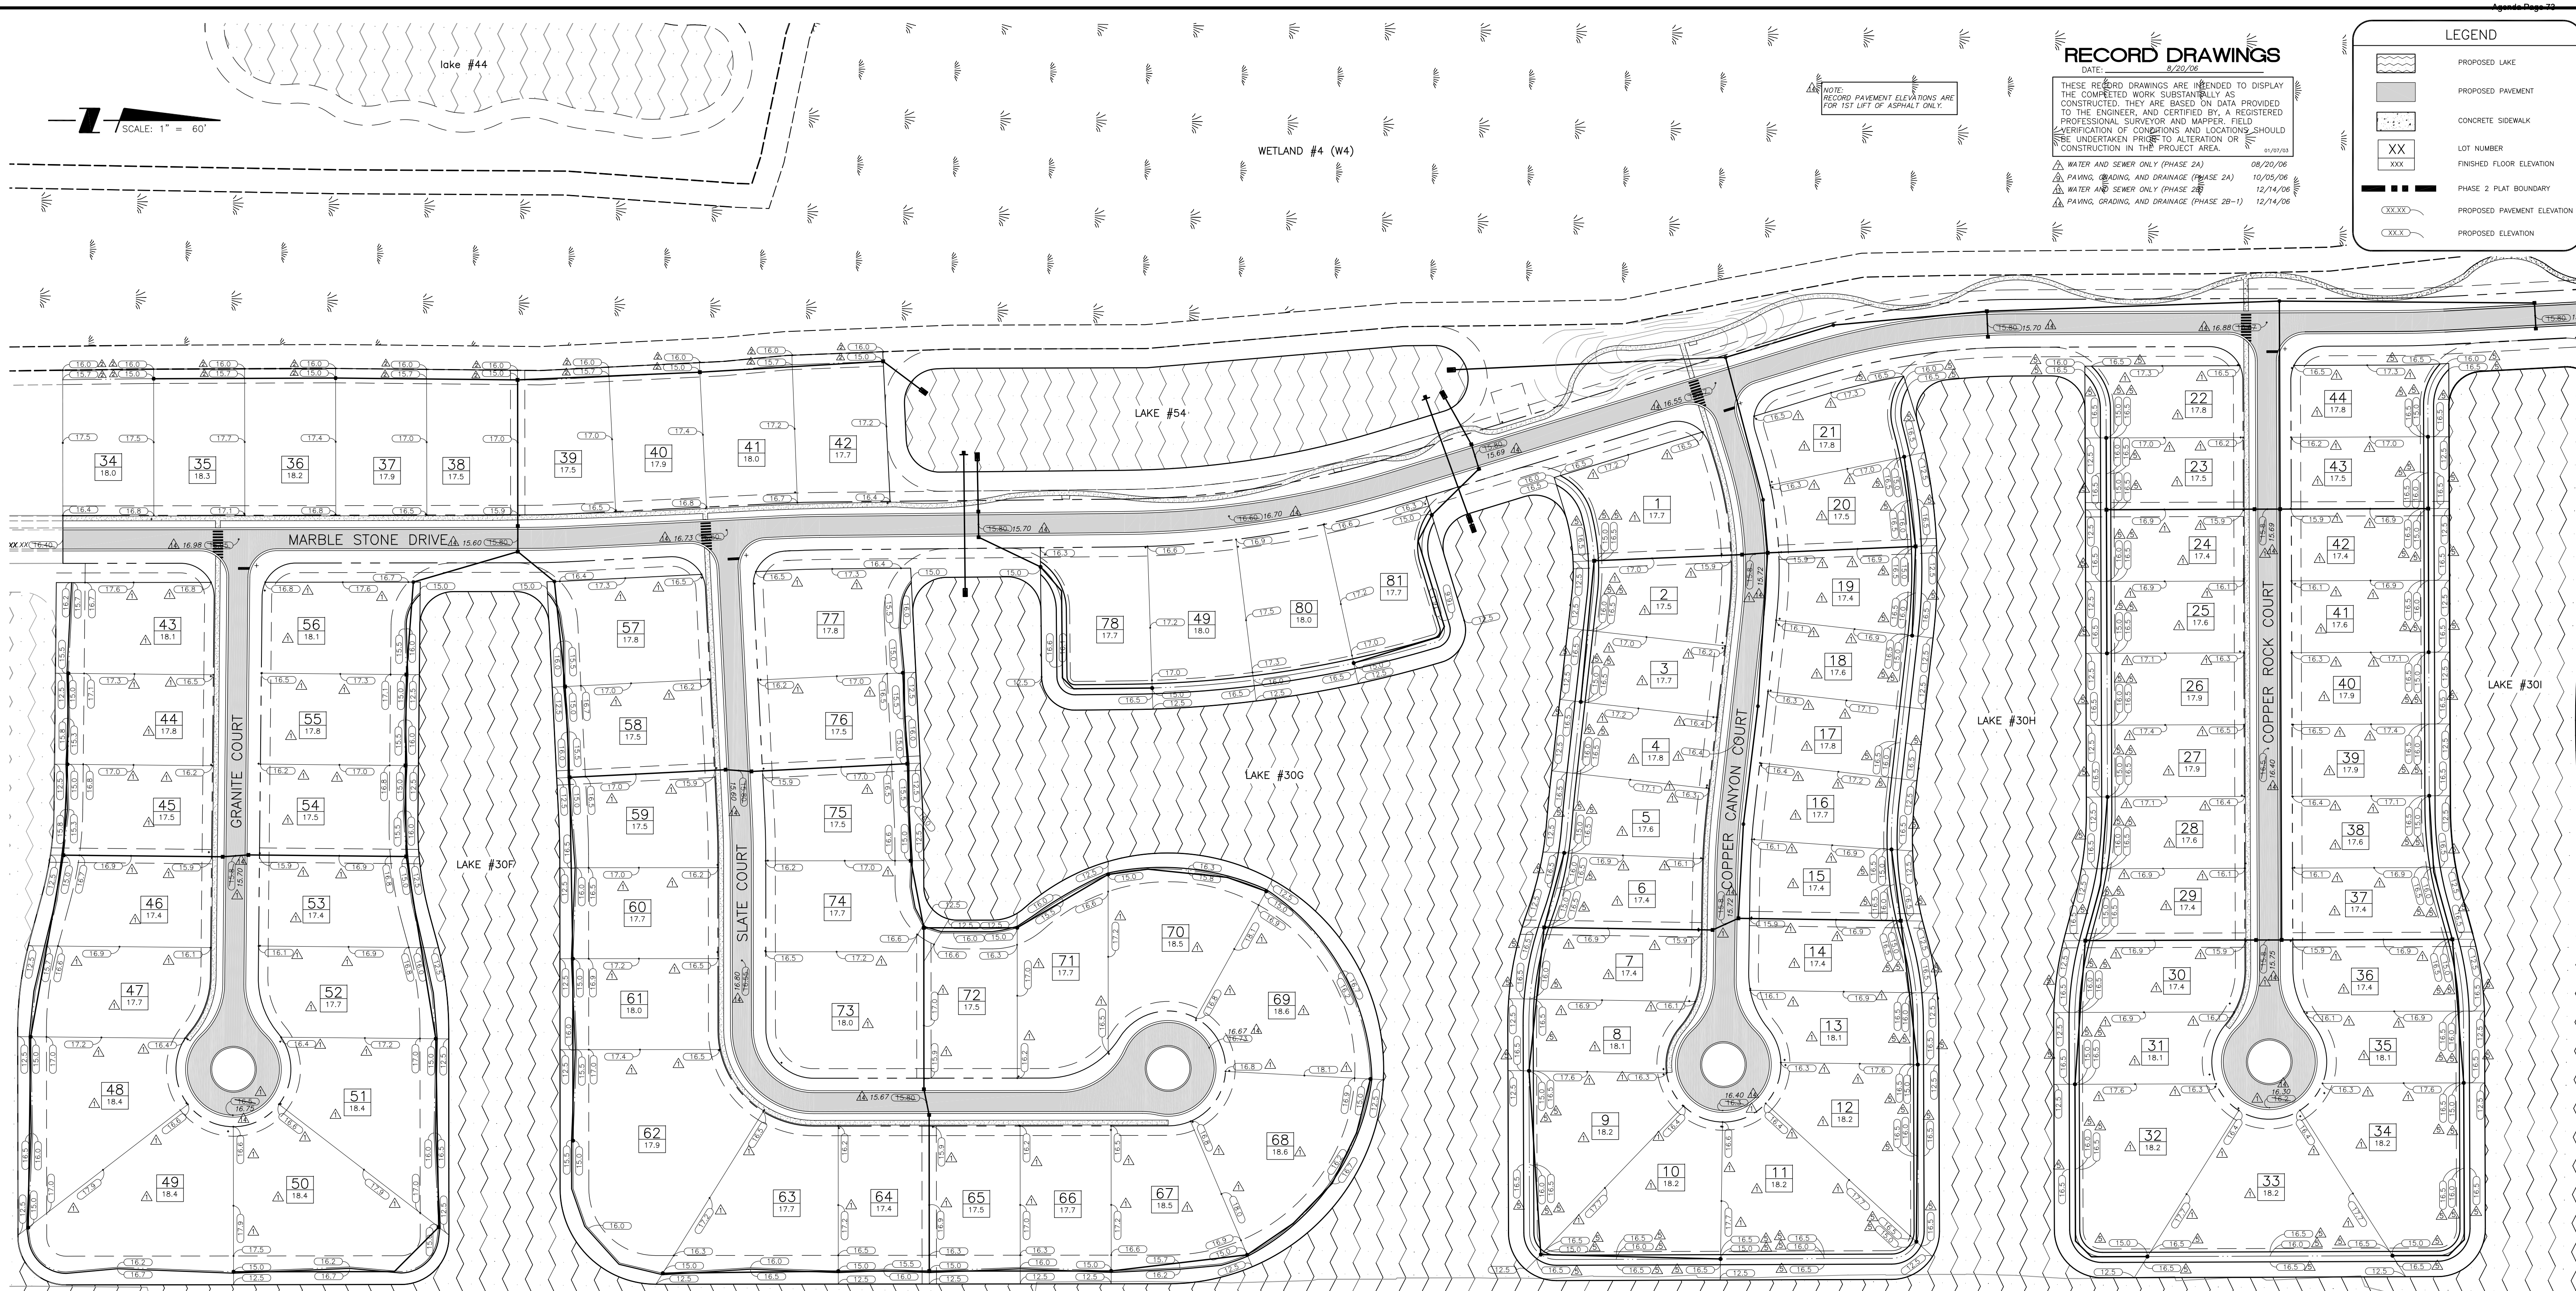




LOT DIMENSIONS


NICKEL RIDGE				QUARRY SHORES NORTH			
LOT#	LOT WIDTH	LOT DEPTH	AREA	LOT#	LOT WIDTH	LOT DEPTH	AREA
1	104.8 LF.	150 LF.	0.37 AC.	19	75 LF.	150 LF.	0.26 AC.
2	75 LF.	150 LF.	0.26 AC.	20	75 LF.	150 LF.	0.26 AC.
3	75 LF.	150 LF.	0.26 AC.	21	75 LF.	150 LF.	0.26 AC.
4	75 LF.	150 LF.	0.26 AC.	22	75 LF.	150 LF.	0.26 AC.
5	75 LF.	150 LF.	0.26 AC.	23	75 LF.	150 LF.	0.26 AC.
6	78.3 LF.	150 LF.	0.27 AC.	24	75 LF.	150 LF.	0.26 AC.
7	86.4 LF.	150 LF.	0.30 AC.	25	94.7 LF.	154.8 LF.	0.34 AC.
8	85.4 LF.	150 LF.	0.29 AC.	26	102.2 LF.	161.9 LF.	0.39 AC.
9	80.4 LF.	150 LF.	0.28 AC.	27	102.1 LF.	160.9 LF.	0.38 AC.
10	80.4 LF.	150 LF.	0.28 AC.	28	92.2 LF.	153.8 LF.	0.32 AC.
11	80.4 LF.	150 LF.	0.28 AC.	29	75 LF.	150 LF.	0.26 AC.
12	80.4 LF.	150 LF.	0.28 AC.	30	75 LF.	150 LF.	0.26 AC.
13	80.5 LF.	150 LF.	0.28 AC.	31	75 LF.	150 LF.	0.26 AC.
14	75 LF.	150 LF.	0.26 AC.	32	77.5 LF.	150 LF.	0.26 AC.
15	75 LF.	150 LF.	0.26 AC.	33	82.6 LF.	150 LF.	0.28 AC.
16	75 LF.	150 LF.	0.26 AC.	34	82.7 LF.	150 LF.	0.29 AC.
17	224 LF.	150 LF.	0.55 AC.	35	82.6 LF.	150 LF.	0.28 AC.
18	75 LF.	150 LF.	0.26 AC.	36	79.2 LF.	150 LF.	0.27 AC.
19	75 LF.	150 LF.	0.26 AC.	37	82.1 LF.	150 LF.	0.28 AC.
20	75 LF.	150 LF.	0.26 AC.	38	82.1 LF.	150 LF.	0.28 AC.
21	75 LF.	150 LF.	0.26 AC.	39	82.8 LF.	150 LF.	0.28 AC.
22	75 LF.	150 LF.	0.26 AC.	40	73.6 LF.	150 LF.	0.26 AC.
23	75 LF.	150 LF.	0.26 AC.	41	75 LF.	150 LF.	0.26 AC.
24	75 LF.	150 LF.	0.26 AC.	42	75 LF.	150 LF.	0.26 AC.
25	94.7 LF.	154.8 LF.	0.34 AC.	43	75 LF.	150 LF.	0.26 AC.
26	102.2 LF.	161.9 LF.	0.39 AC.	44	75 LF.	150 LF.	0.26 AC.
27	102.1 LF.	160.9 LF.	0.38 AC.	45	89.4 LF.	150 LF.	0.31 AC.
28	92.2 LF.	153.8 LF.	0.32 AC.	46	138.9 LF.	150 LF.	0.46 AC.
29	75 LF.	150 LF.	0.26 AC.	47	67 LF.	150 LF.	0.23 AC.
30	75 LF.	150 LF.	0.26 AC.	48	67 LF.	150 LF.	0.23 AC.
31	75 LF.	150 LF.	0.26 AC.	49	67 LF.	150 LF.	0.23 AC.
32	77.5 LF.	150 LF.	0.26 AC.	50	67 LF.	150 LF.	0.23 AC.
33	82.6 LF.	150 LF.	0.28 AC.	51	67 LF.	150 LF.	0.23 AC.
34	82.7 LF.	150 LF.	0.29 AC.	52	67 LF.	150 LF.	0.23 AC.
35	82.6 LF.	150 LF.	0.28 AC.	53	67 LF.	150 LF.	0.23 AC.
36	79.2 LF.	150 LF.	0.27 AC.	54	67 LF.	150 LF.	0.23 AC.
37	82.1 LF.	150 LF.	0.28 AC.	55	67 LF.	150 LF.	0.23 AC.
38	82.1 LF.	150 LF.	0.28 AC.	56	67 LF.	150 LF.	0.23 AC.
39	82.8 LF.	150 LF.	0.28 AC.	57	67 LF.	150 LF.	0.23 AC.
40	73.6 LF.	150 LF.	0.26 AC.	58	67 LF.	150 LF.	0.23 AC.
41	75 LF.	150 LF.	0.26 AC.	59	67 LF.	150 LF.	0.23 AC.
42	75 LF.	150 LF.	0.26 AC.	60	67 LF.	150 LF.	0.23 AC.
43	75 LF.	150 LF.	0.26 AC.	61	67 LF.	150 LF.	0.23 AC.
44	75 LF.	150 LF.	0.26 AC.	62	67 LF.	150 LF.	0.23 AC.
45	89.4 LF.	150 LF.	0.31 AC.	63	67 LF.	150 LF.	0.23 AC.
46	138.9 LF.	150 LF.	0.46 AC.	64	67 LF.	150 LF.	0.23 AC.
47	67 LF.	150 LF.	0.23 AC.	65	67 LF.	150 LF.	0.23 AC.
48	67 LF.	150 LF.	0.23 AC.	66	67 LF.	150 LF.	0.23 AC.
49	67 LF.	150 LF.	0.23 AC.	67	67 LF.	150 LF.	0.23 AC.
102	67 LF.	150 LF.	0.23 AC.	120	67 LF.	150 LF.	0.23 AC.

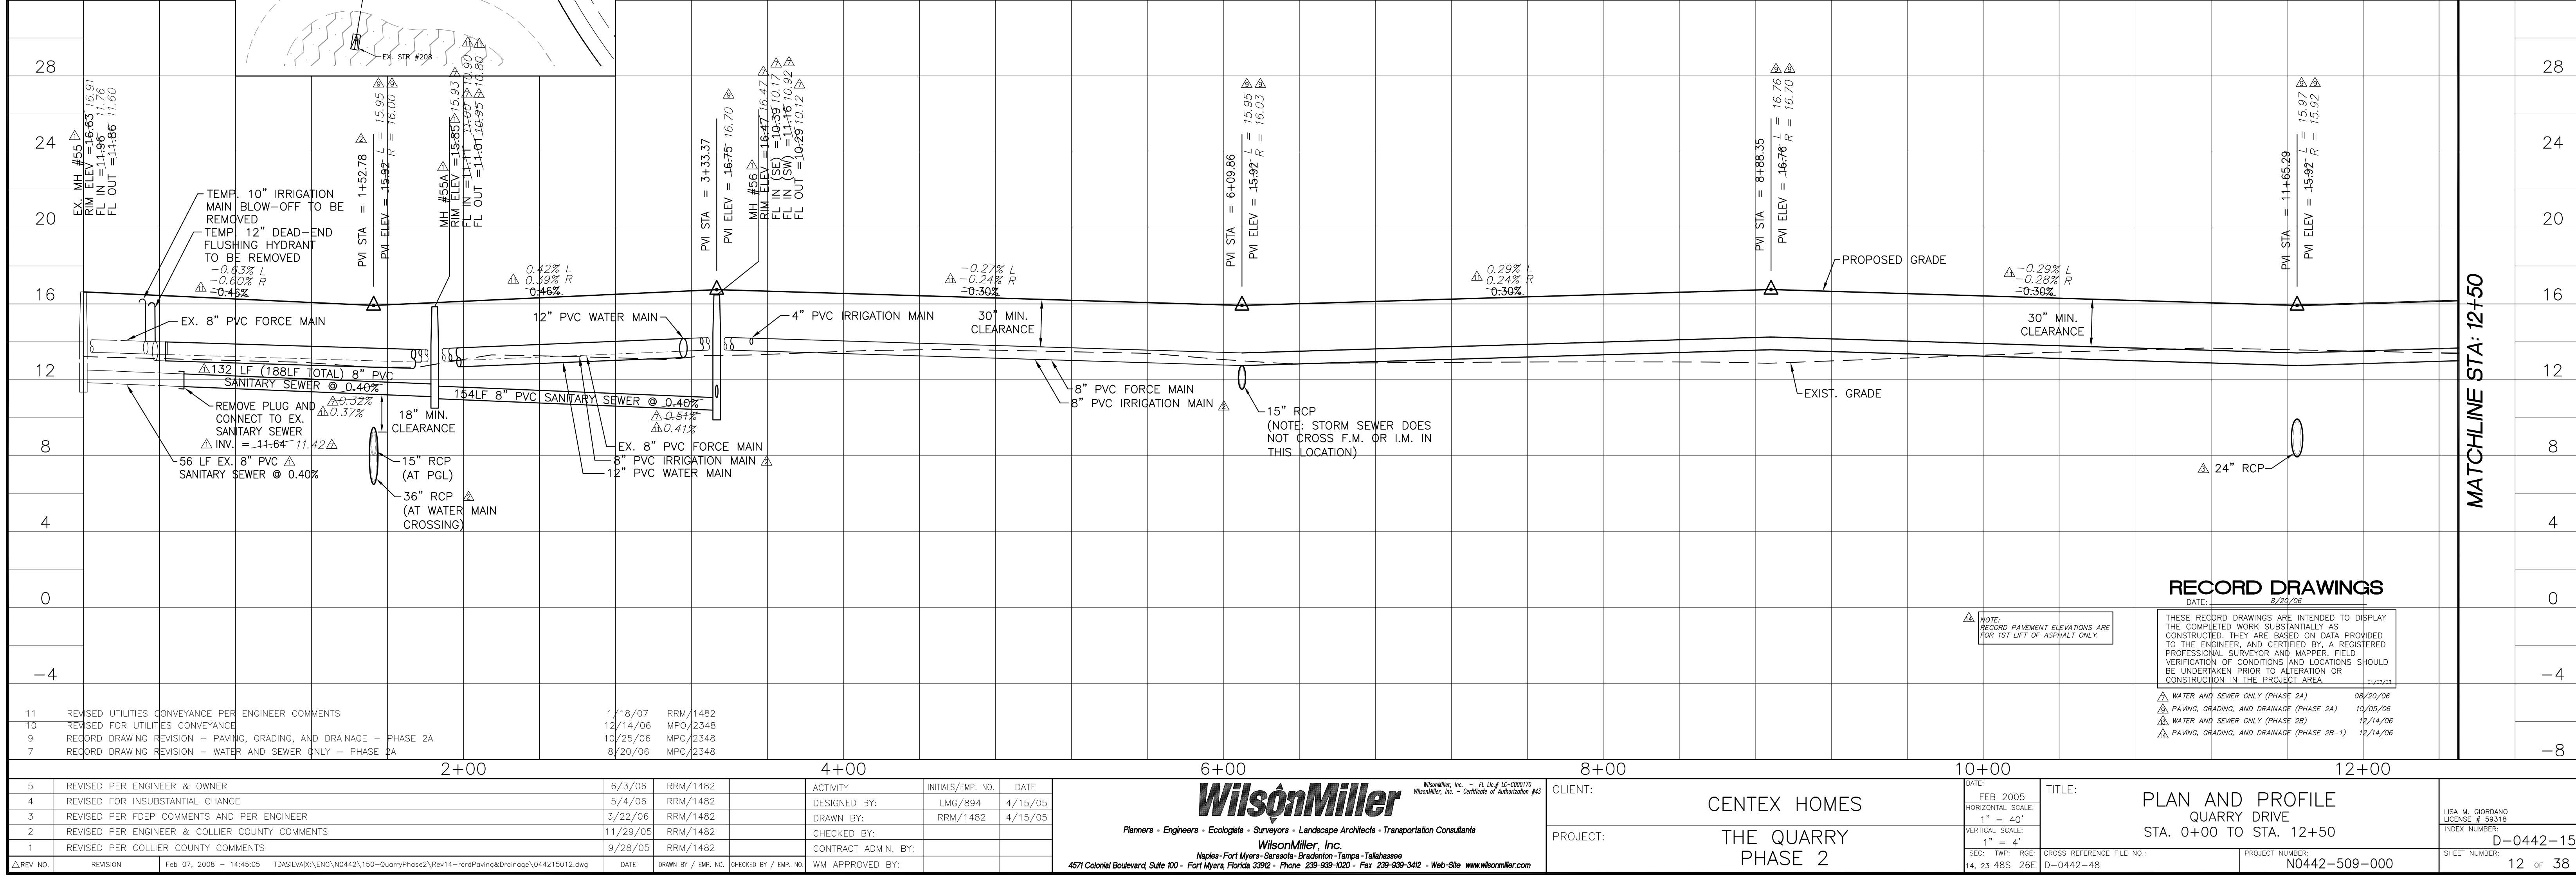
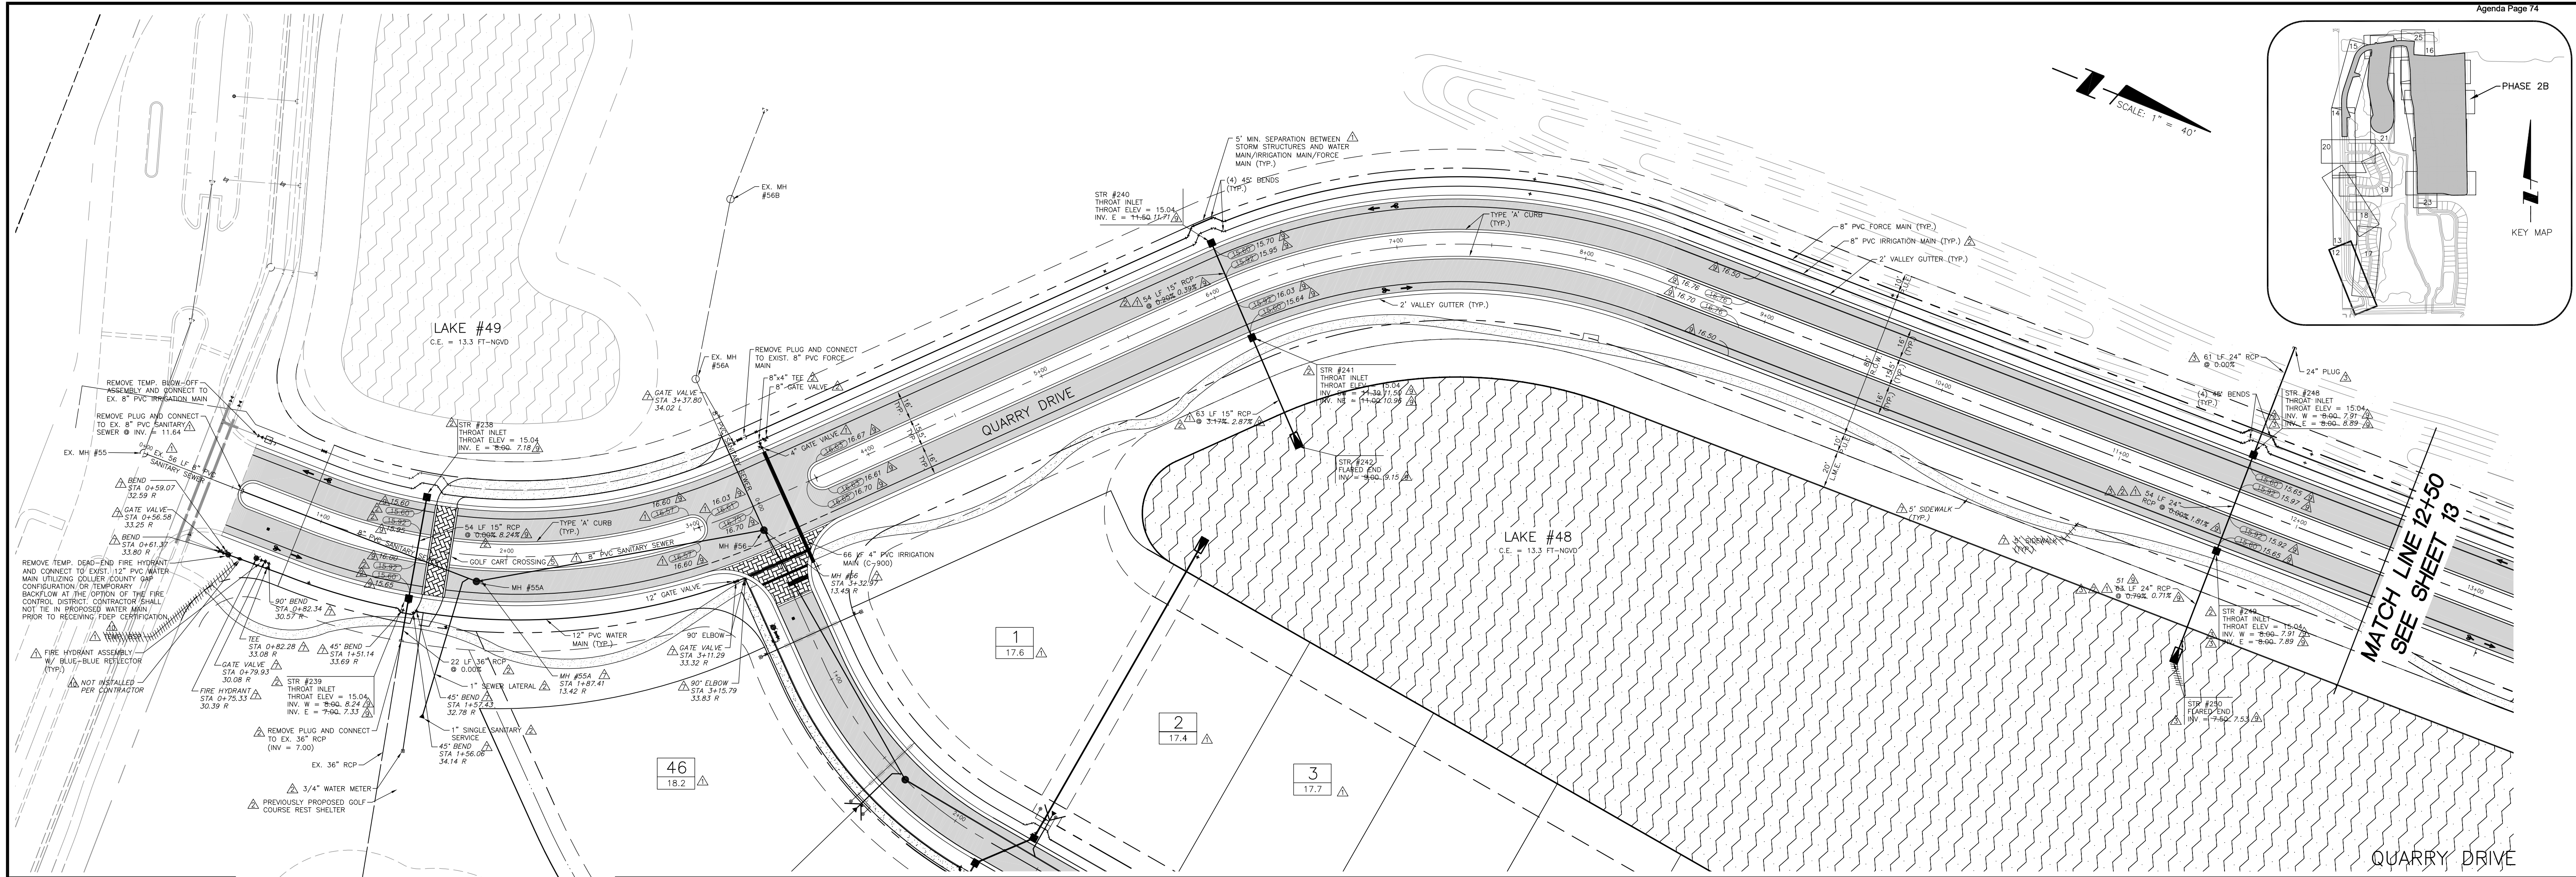


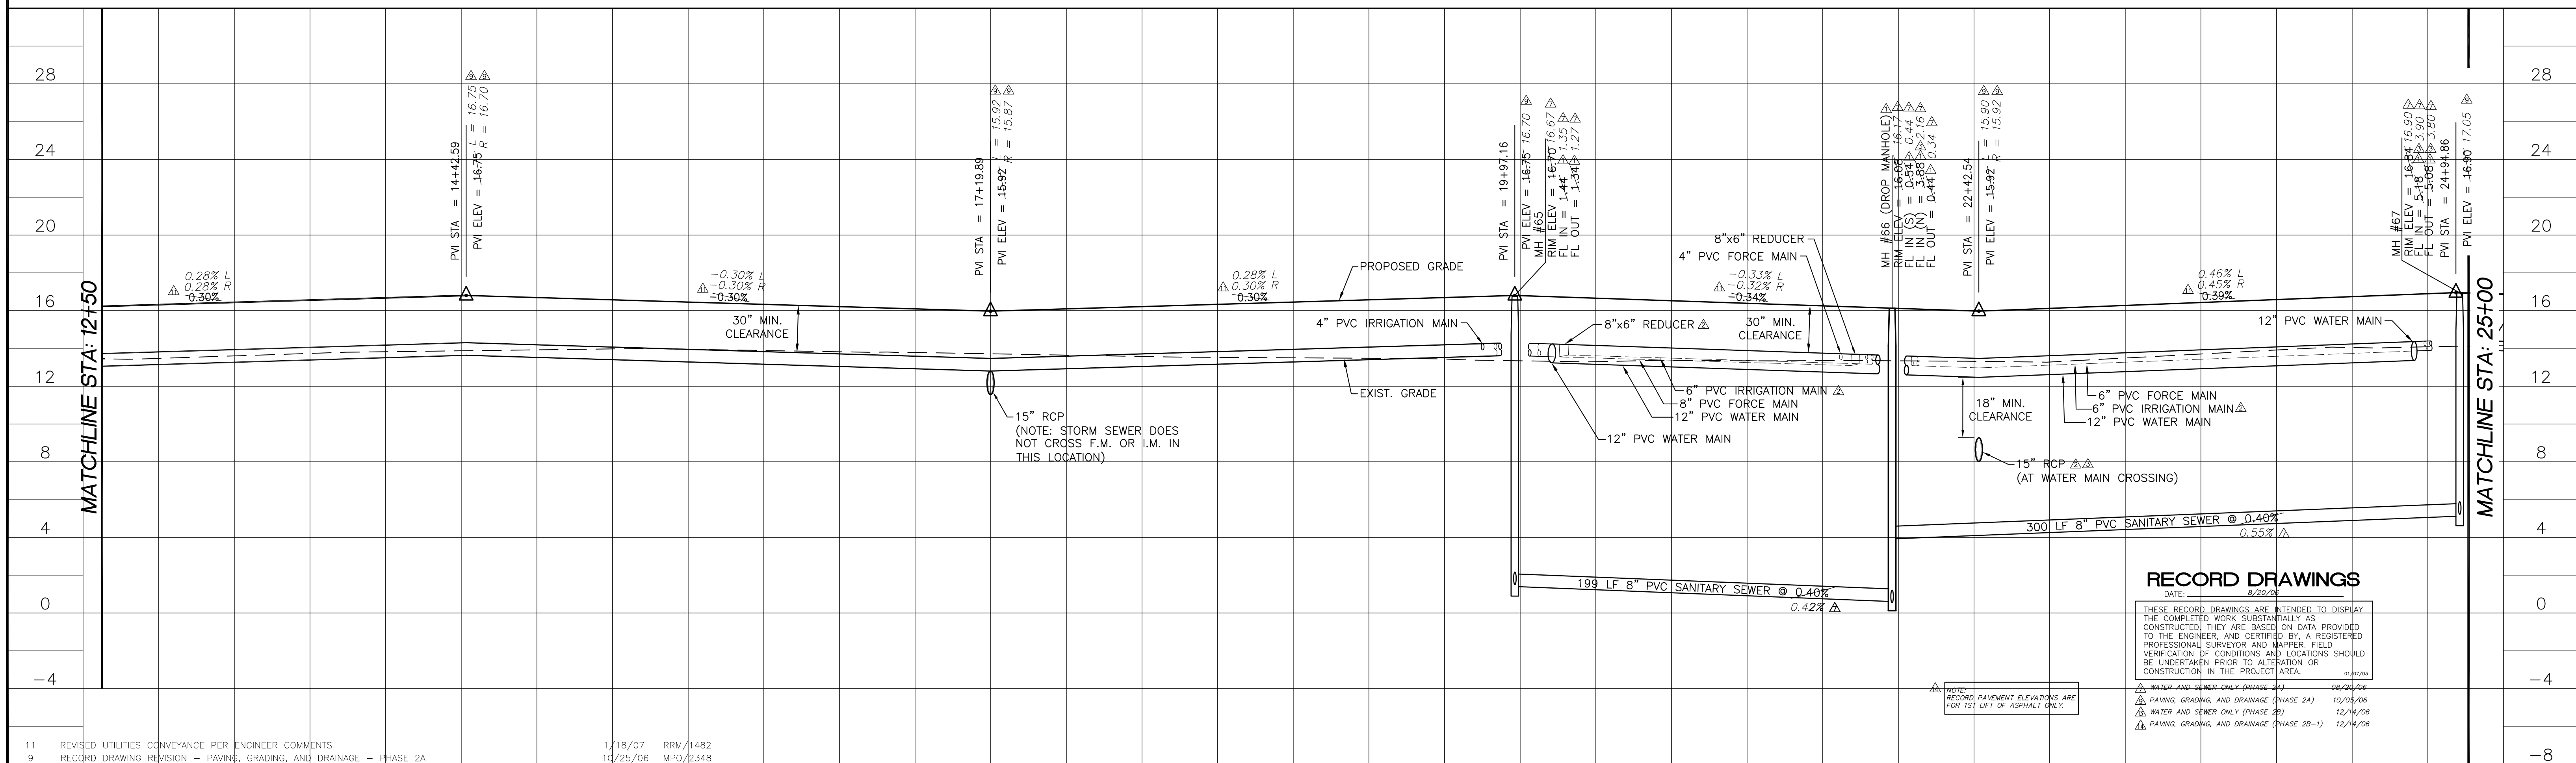

14+00										16+00										18+00										20+00										22+00										24+00									
7	RECORD DRAWING REVISION - WATER AND SEWER ONLY - PHASE 2A										8/14/06	MPO/2348	ACTIVITY		INITIALS/EMP. NO.	DATE	<div><div><div><div><div><div></div><div></div><div></div><div></div><div></div></div><div><div></div><div></div><div></div><div></div><div></div></div><div><div></div><div></div><div></div><div></div><div></div></div><div><div></div><div></div><div></div><div></div><div></div></div><div><div></div><div></div><div></div><div></div><div></div></div></div><div><div></div><div></div><div></div><div></div><div></div></div><div><div></div><div></div><div></div><div></div><div></div></div><div><div></div><div></div><div></div><div></div><div></div></div><div><div></div><div></div><div></div><div></div><div></div></div><div><div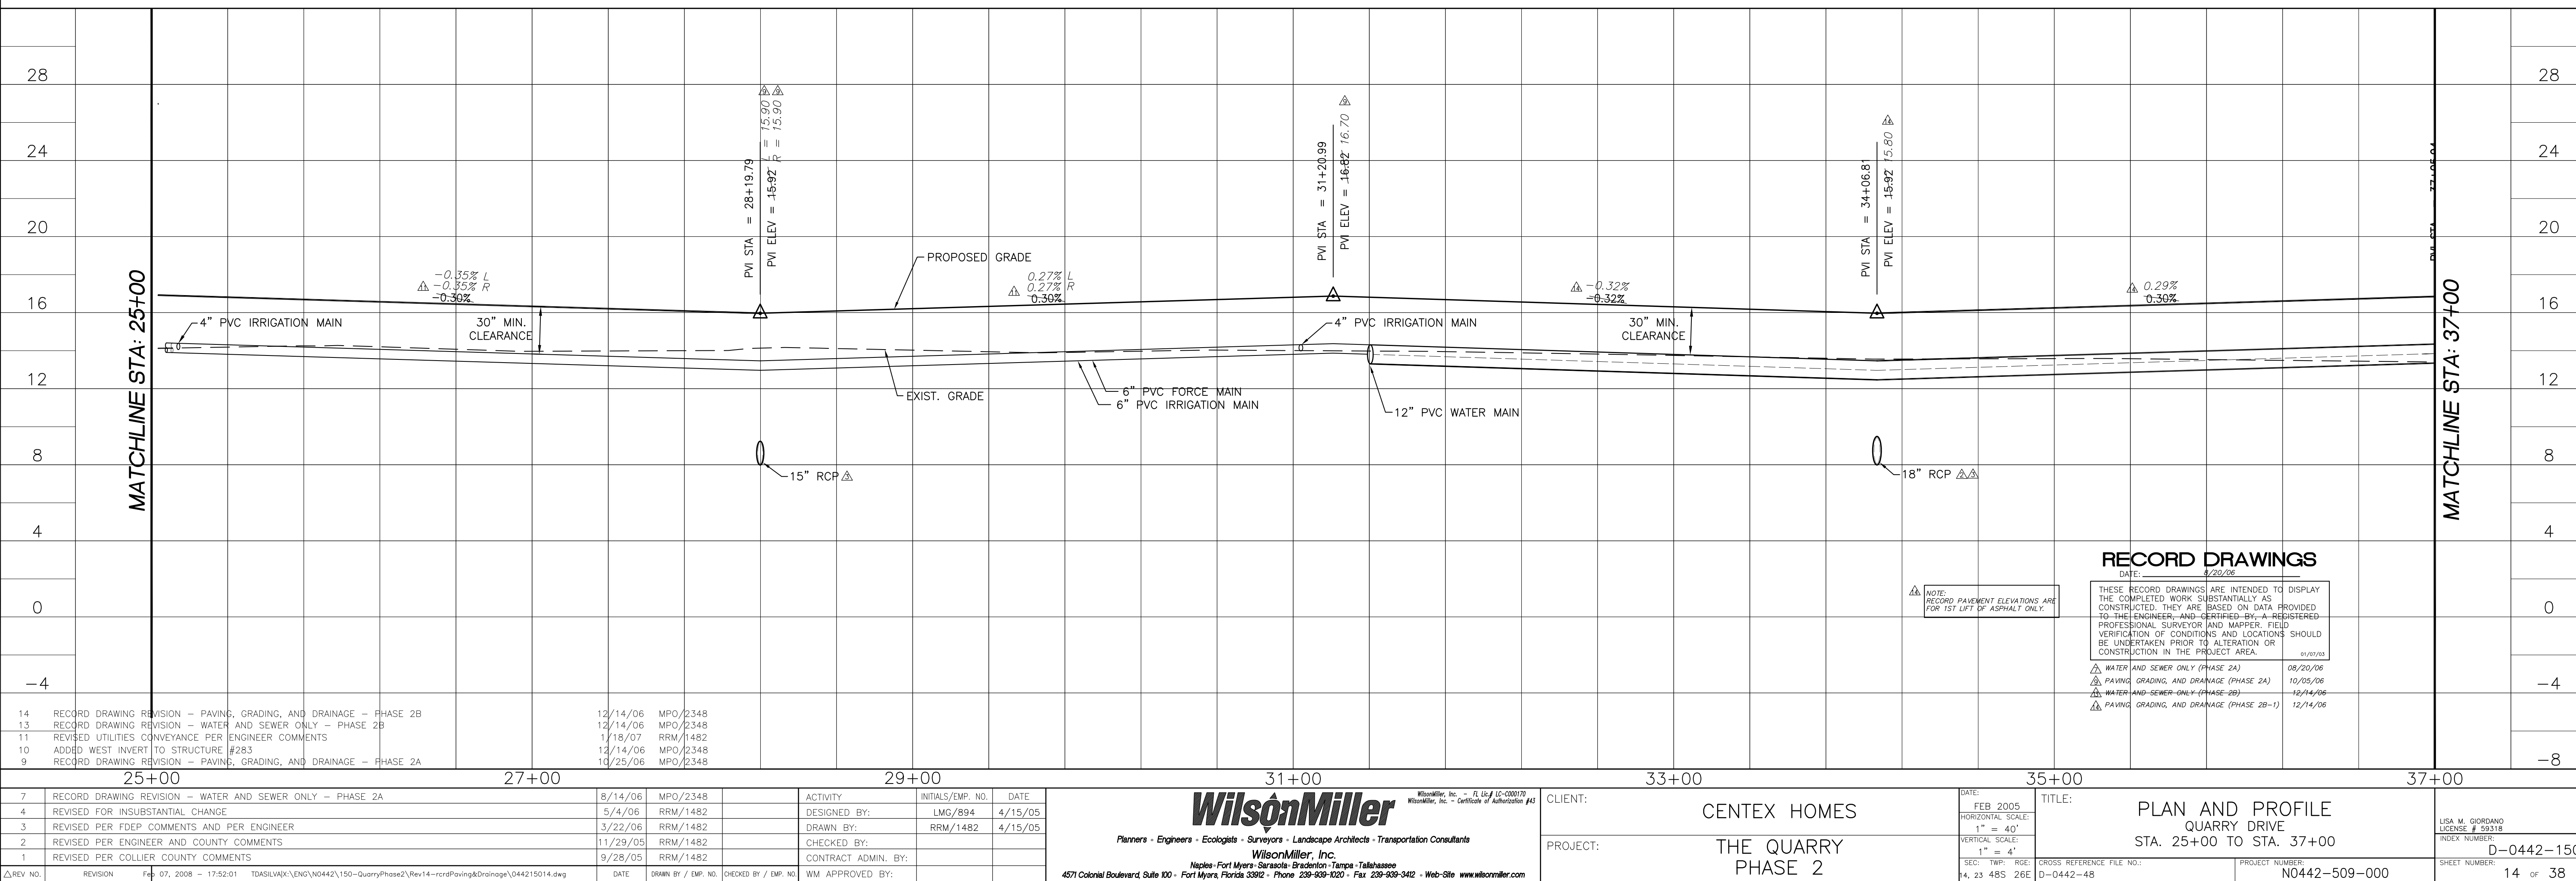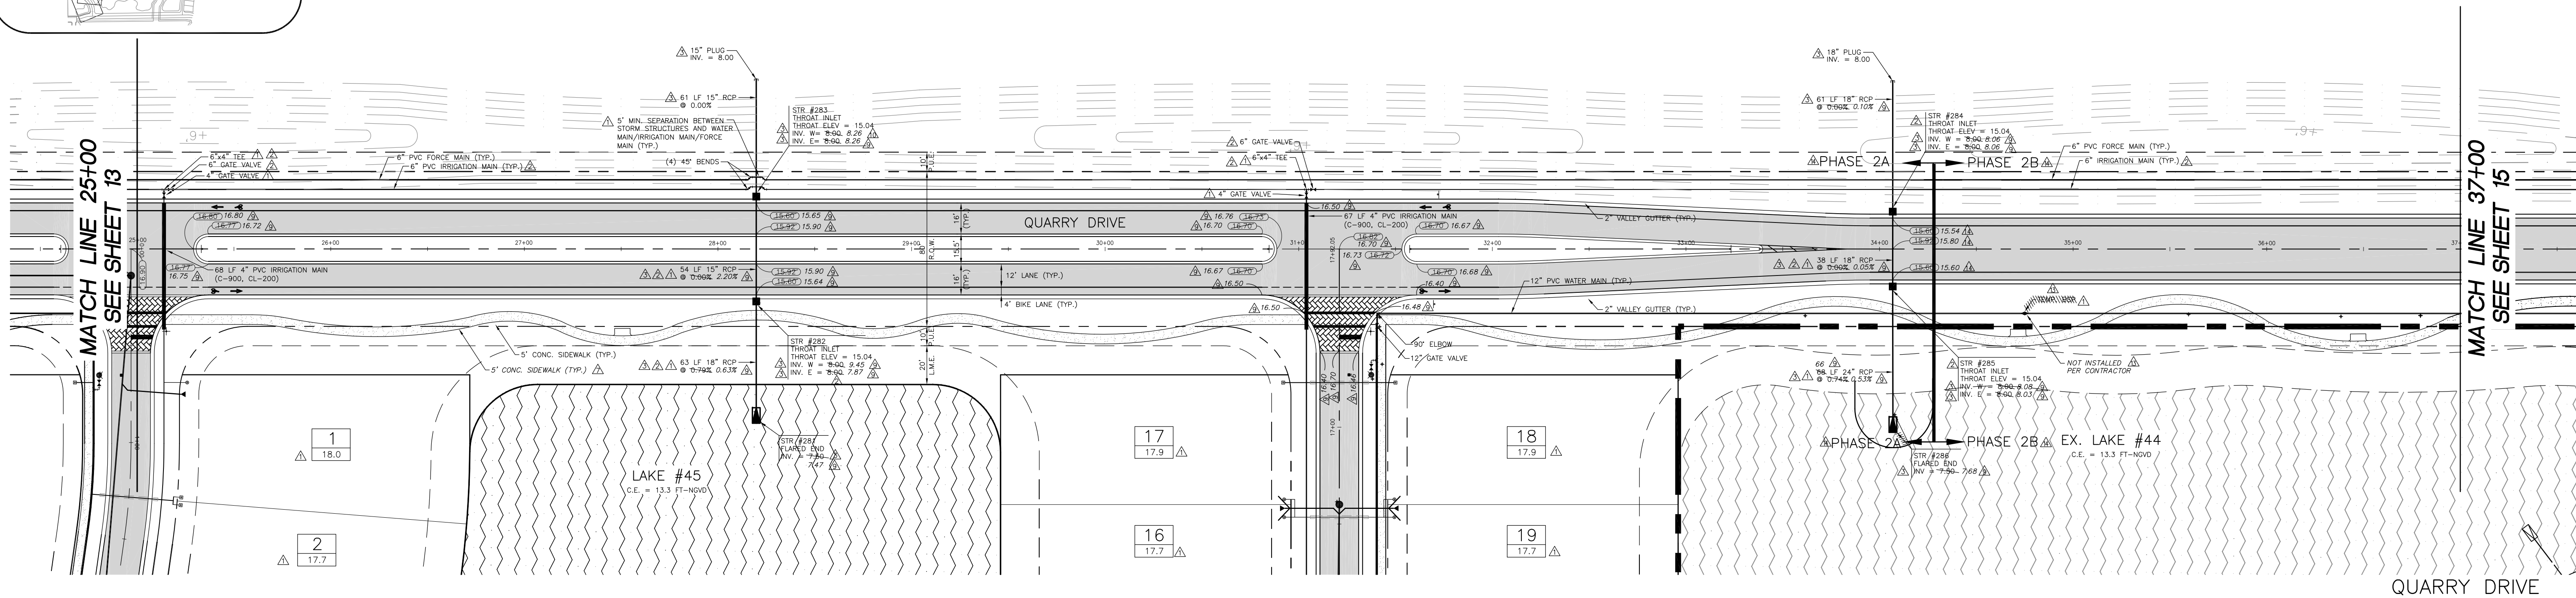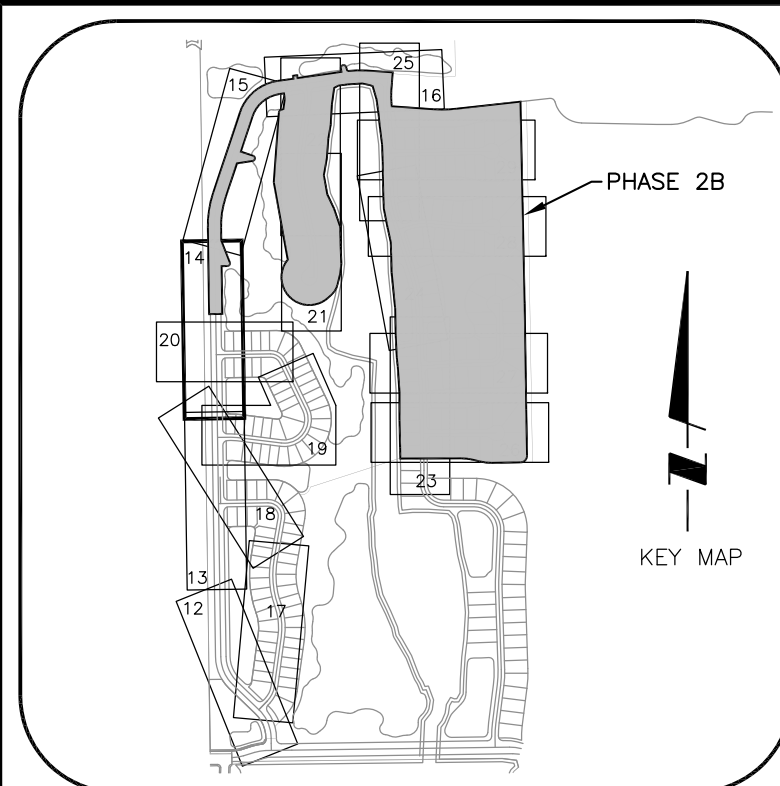

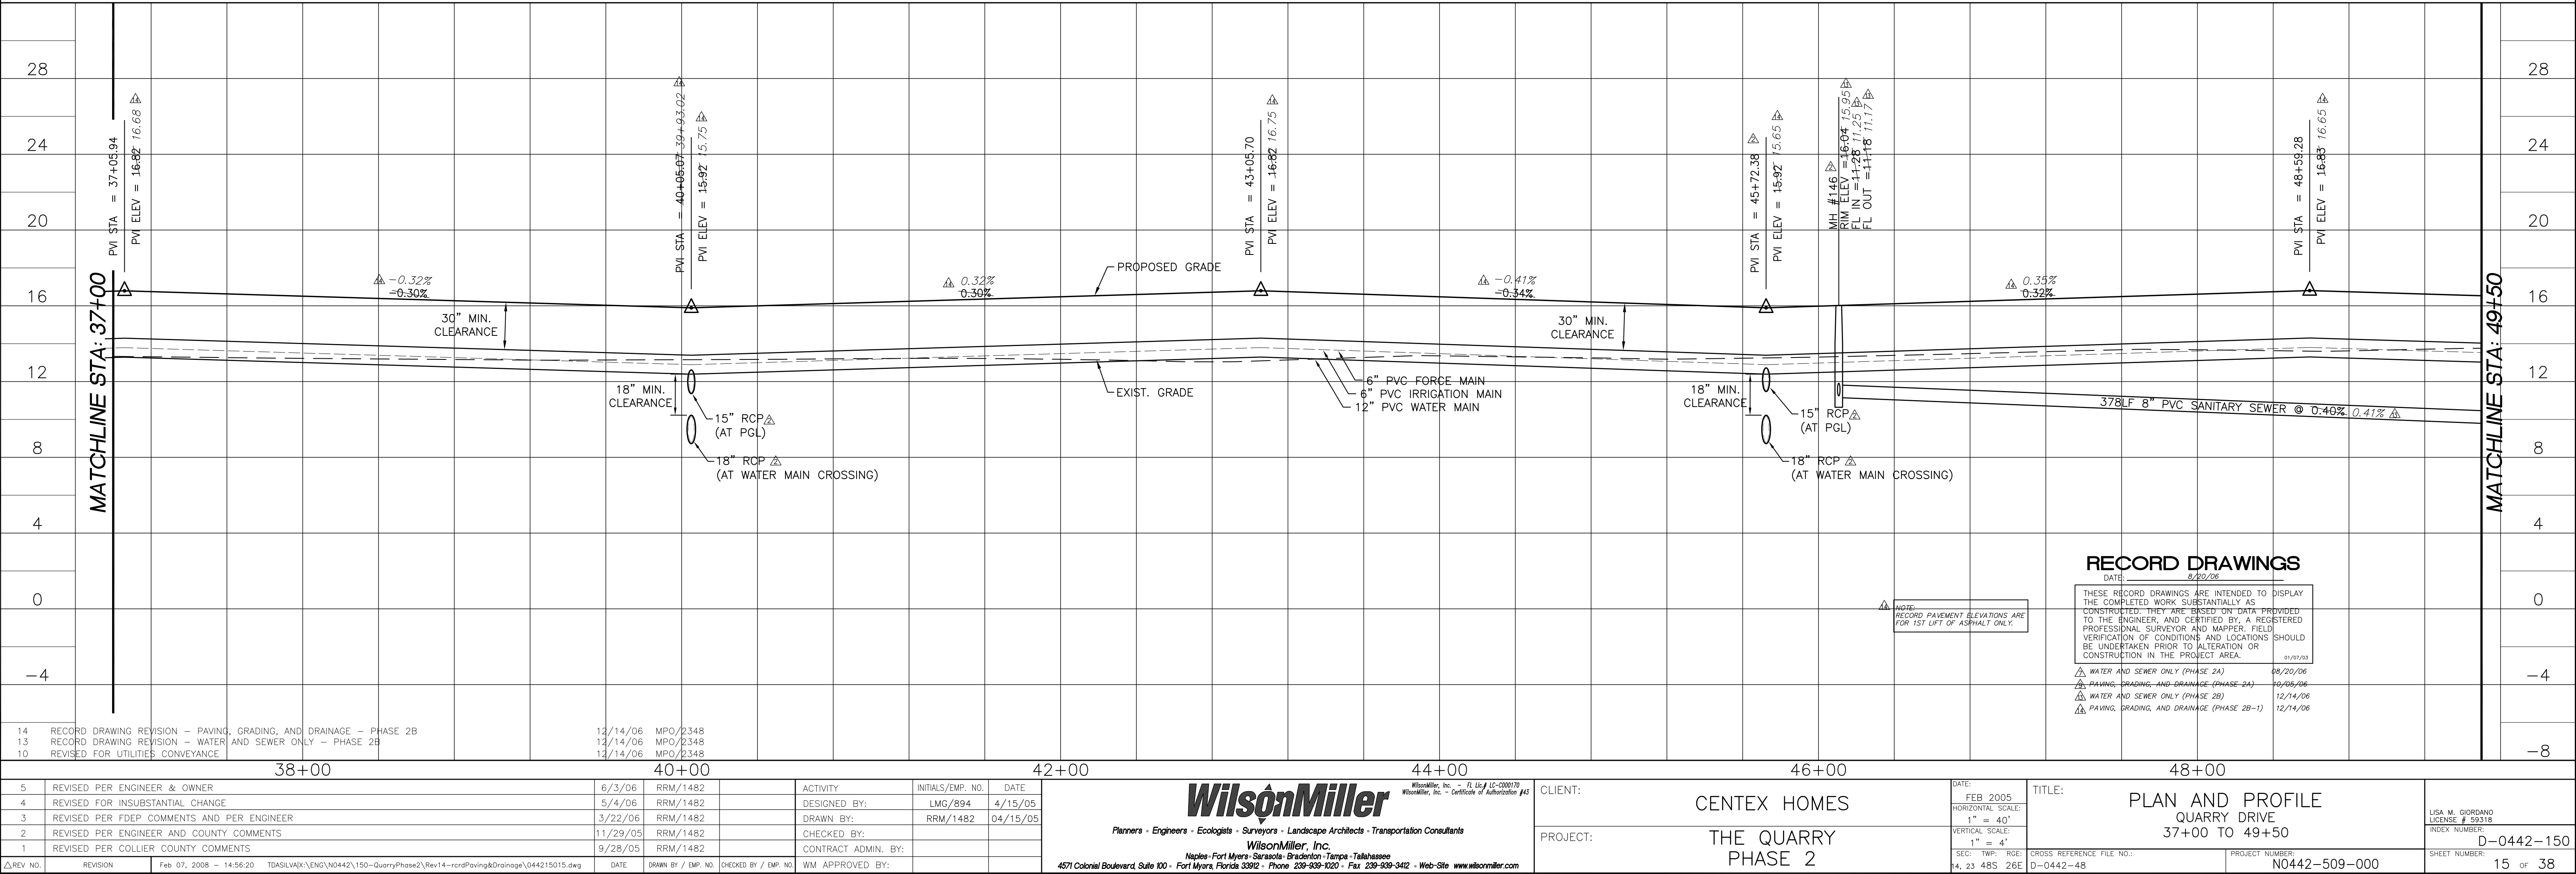

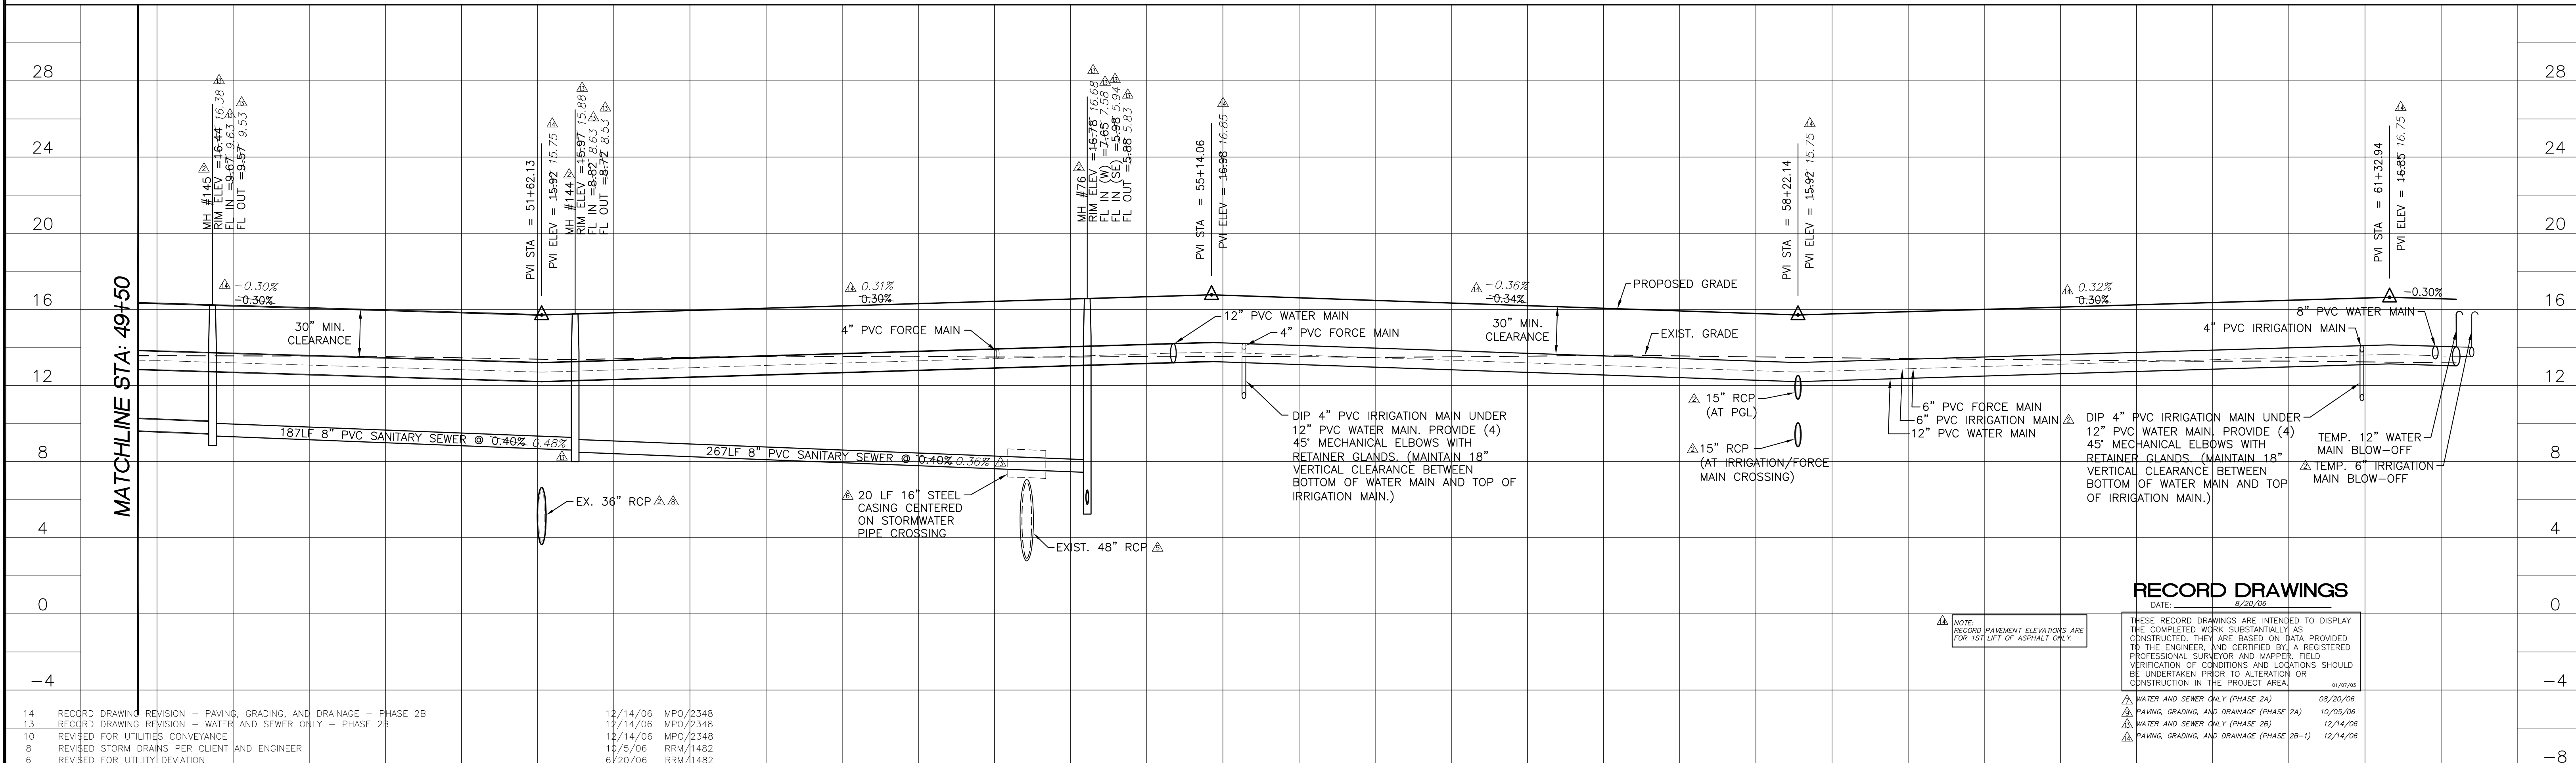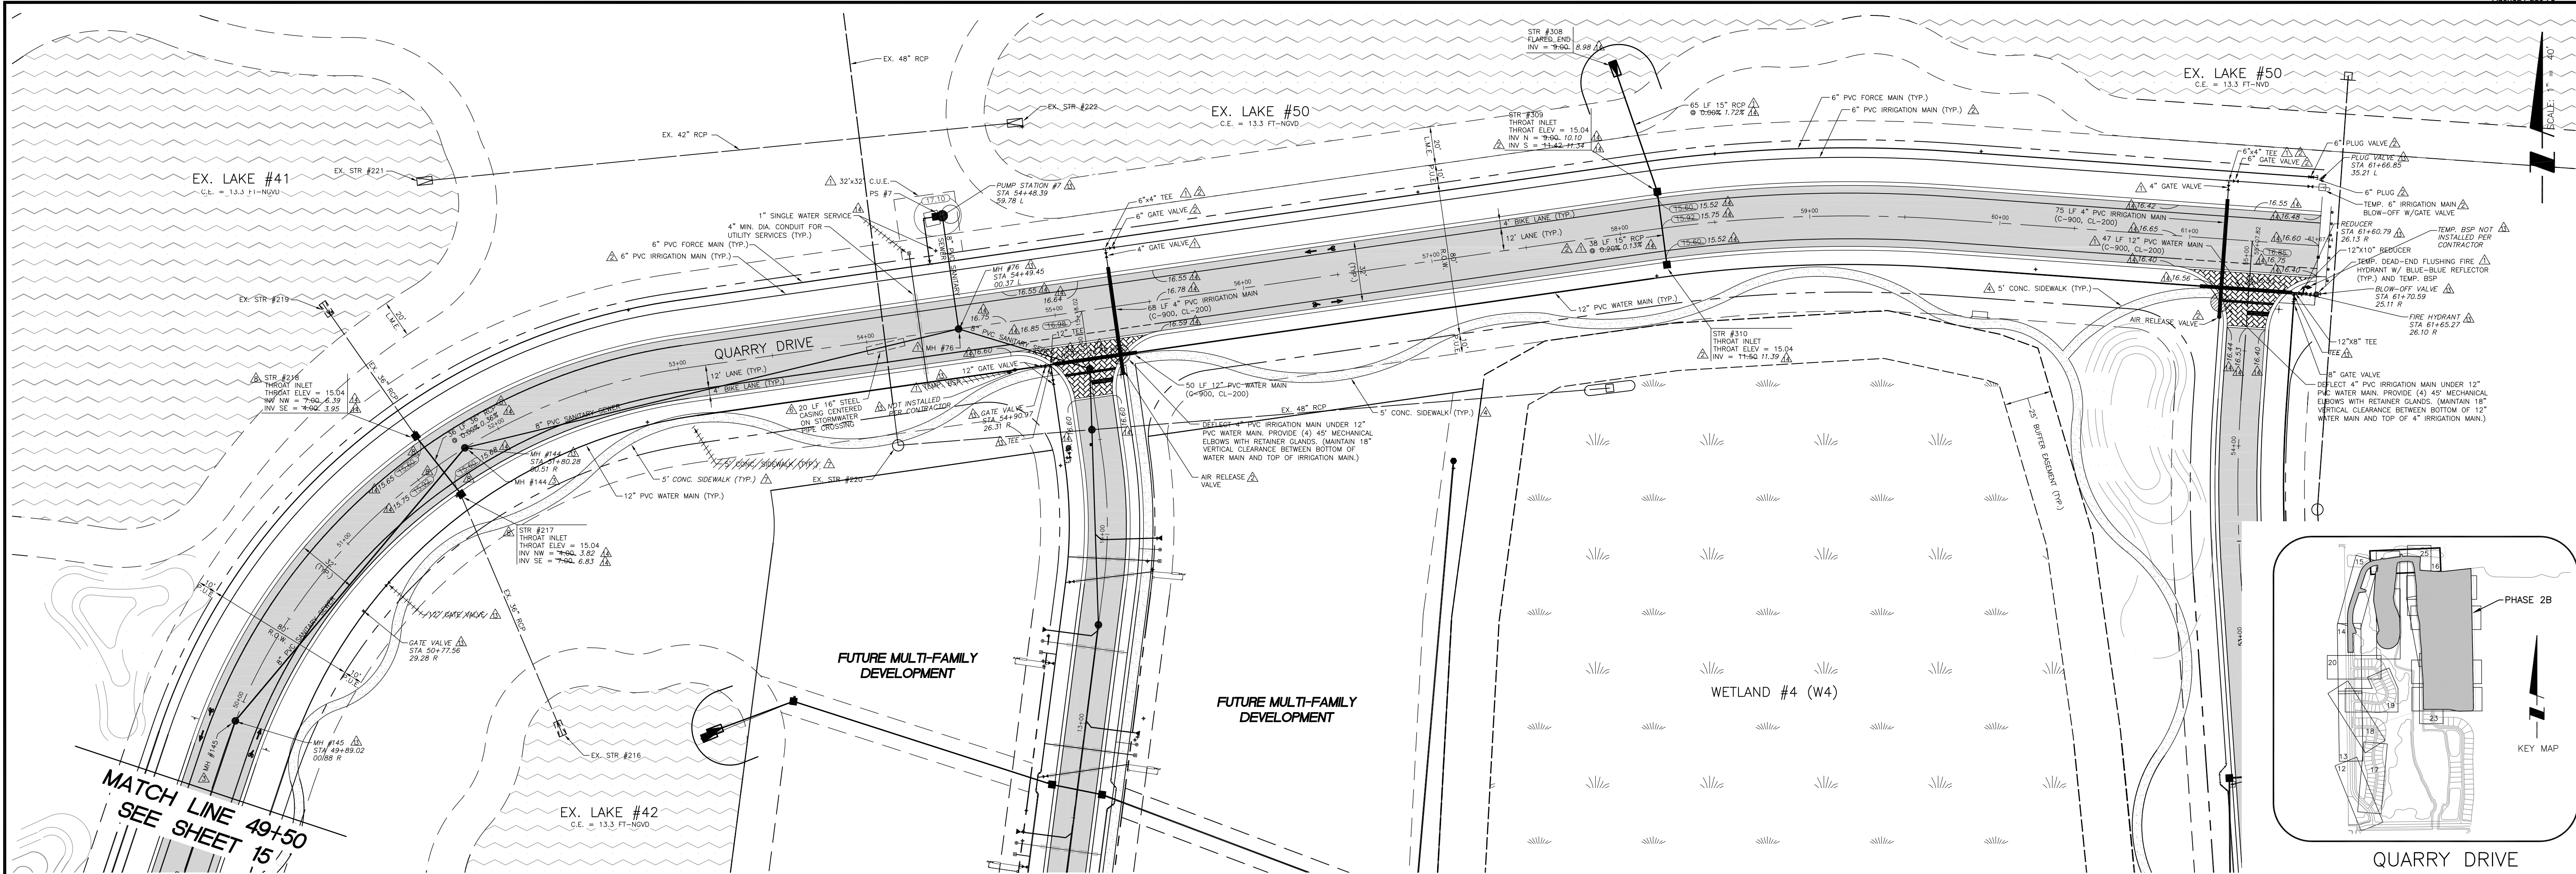

14	RECORD DRAWING REVISION - PAVING, GRADING, AND DRAINAGE - PHASE 2B	12/14/06	MPO/2348
13	RECORD DRAWING REVISION - WATER AND SEWER ONLY - PHASE 2B	12/14/06	MPO/2348
10	REVISED FOR UTILITIES CONVEYANCE	12/14/06	MPO/2348
8	REVISED STORM DRAINS PER CLIENT AND ENGINEER	11/25/06	RRM/1482
6	REVISED FOR UTILITY DEVIATION	9/20/06	RRM/1482

5	REVISED PER ENGINEER & OWNER	6/3/06	RRM/1482	ACTIVITY	INITIALS/EMP. NO.	DATE
4	REVISED FOR INSUBSTANTIAL CHANGE	5/4/06	RRM/1482	DESIGNED BY:	LMG/894	4/15/05
3	REVISED PER FDEP COMMENTS AND PER ENGINEER	3/22/06	RRM/1482	DRAWN BY:	RRM/1482	4/15/05
2	REVISED PER ENGINEER & COUNTY COMMENTS	11/29/05	RRM/1482	CHECKED BY:		
1	REVISED PER COLLIER COUNTY COMMENTS	9/28/05	RRM/1482	CONTRACT ADMIN. BY:		

DATE	DRAWN BY / EMP. NO.	CHECKED BY / EMP. NO.	WM APPROVED BY:
6/3/06	RRM/1482		
5/4/06	RRM/1482		
3/22/06	RRM/1482		
11/29/05	RRM/1482		
9/28/05	RRM/1482		

DATE	DRAWN BY / EMP. NO.	CHECKED BY / EMP. NO.	WM APPROVED BY:
6/3/06	RRM/1482		
5/4/06	RRM/1482		
3/22/06	RRM/1482		
11/29/05	RRM/1482		
9/28/05	RRM/1482		

DATE	DRAWN BY / EMP. NO.	CHECKED BY / EMP. NO.	WM APPROVED BY:
6/3/06	RRM/1482		
5/4/06	RRM/1482		
3/22/06	RRM/1482		
11/29/05	RRM/1482		

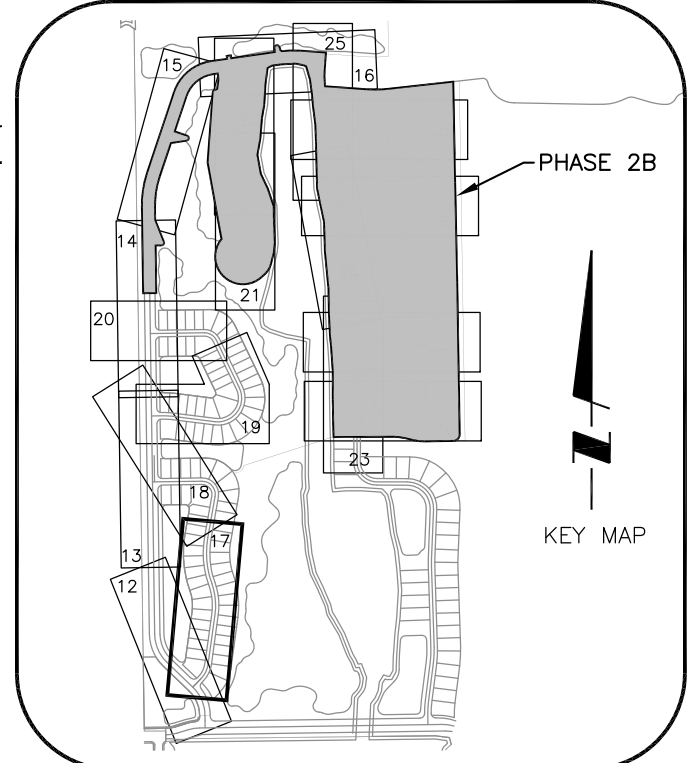

0+00				2+00				4+00				6+00				8+00				10+00			
7	RECORD DRAWING REVISION -- WATER AND SEWER ONLY -- PHASE 2A			8/14/06	MPO/2348	ACTIVITY	INITIALS/EMP. NO.	DATE	<div><div><div>WilsonMiller</div><div>Planners - Engineers - Ecologists - Surveyors - Landscape Architects - Transportation Consultants</div></div><div><div>WilsonMiller, Inc.</div><div>Naples - Fort Myers - Sarasota - Bradenton - Tampa - Tallahassee</div><div>4571 Colonial Boulevard, Suite 100 - Fort Myers, Florida 33912 - Phone 239-939-1020 - Fax 239-939-3412 - Web-Site www.wilsonmiller.com</div></div></div>	CLIENT:	CENTEX HOMES		DATE:	FEB 2005		TITLE:	PLAN AND PROFILE NICKEL RIDGE CIRCLE STA. 0+00 TO 11+00		LISA M. GIORIANO LICENSE # 59318				
4	REVISED FOR INSUBSTANTIAL CHANGE			5/4/06	RRM/1482	DESIGNED BY:	LMG/894	4/15/05		PROJECT:	THE QUARRY PHASE 2		HORIZONTAL SCALE:	1" = 40'		VERTICAL SCALE:	1" = 4'		D-0442-150				
3	REVISED PER FDEP AND PER ENGINEER			3/22/06	RRM/1482	DRAWN BY:	RRM/1482	4/15/05		CROSS REFERENCE FILE NO.:	D-0442-48		PROJECT NUMBER:	N0442-509-000		SHEET NUMBER:	17 OF 38						
2	REVISED PER ENGINEER & COUNTY COMMENTS			11/29/05	RRM/1482	CHECKED BY:																	
1	REVISED PER COLLIER COUNTY COMMENTS			9/28/05	RRM/1482	CONTRACT ADMIN. BY:																	
REV. NO.	REVISION	Feb 07, 2008 -- 14:51:46			DRAWN BY / EMP. NO.			CHECKED BY / EMP. NO.															
		TDA5146(X)(ENG,N0442)-150-QuarryPhase2,Rev14--roadPaving&Drainage\044215017.dwg																					

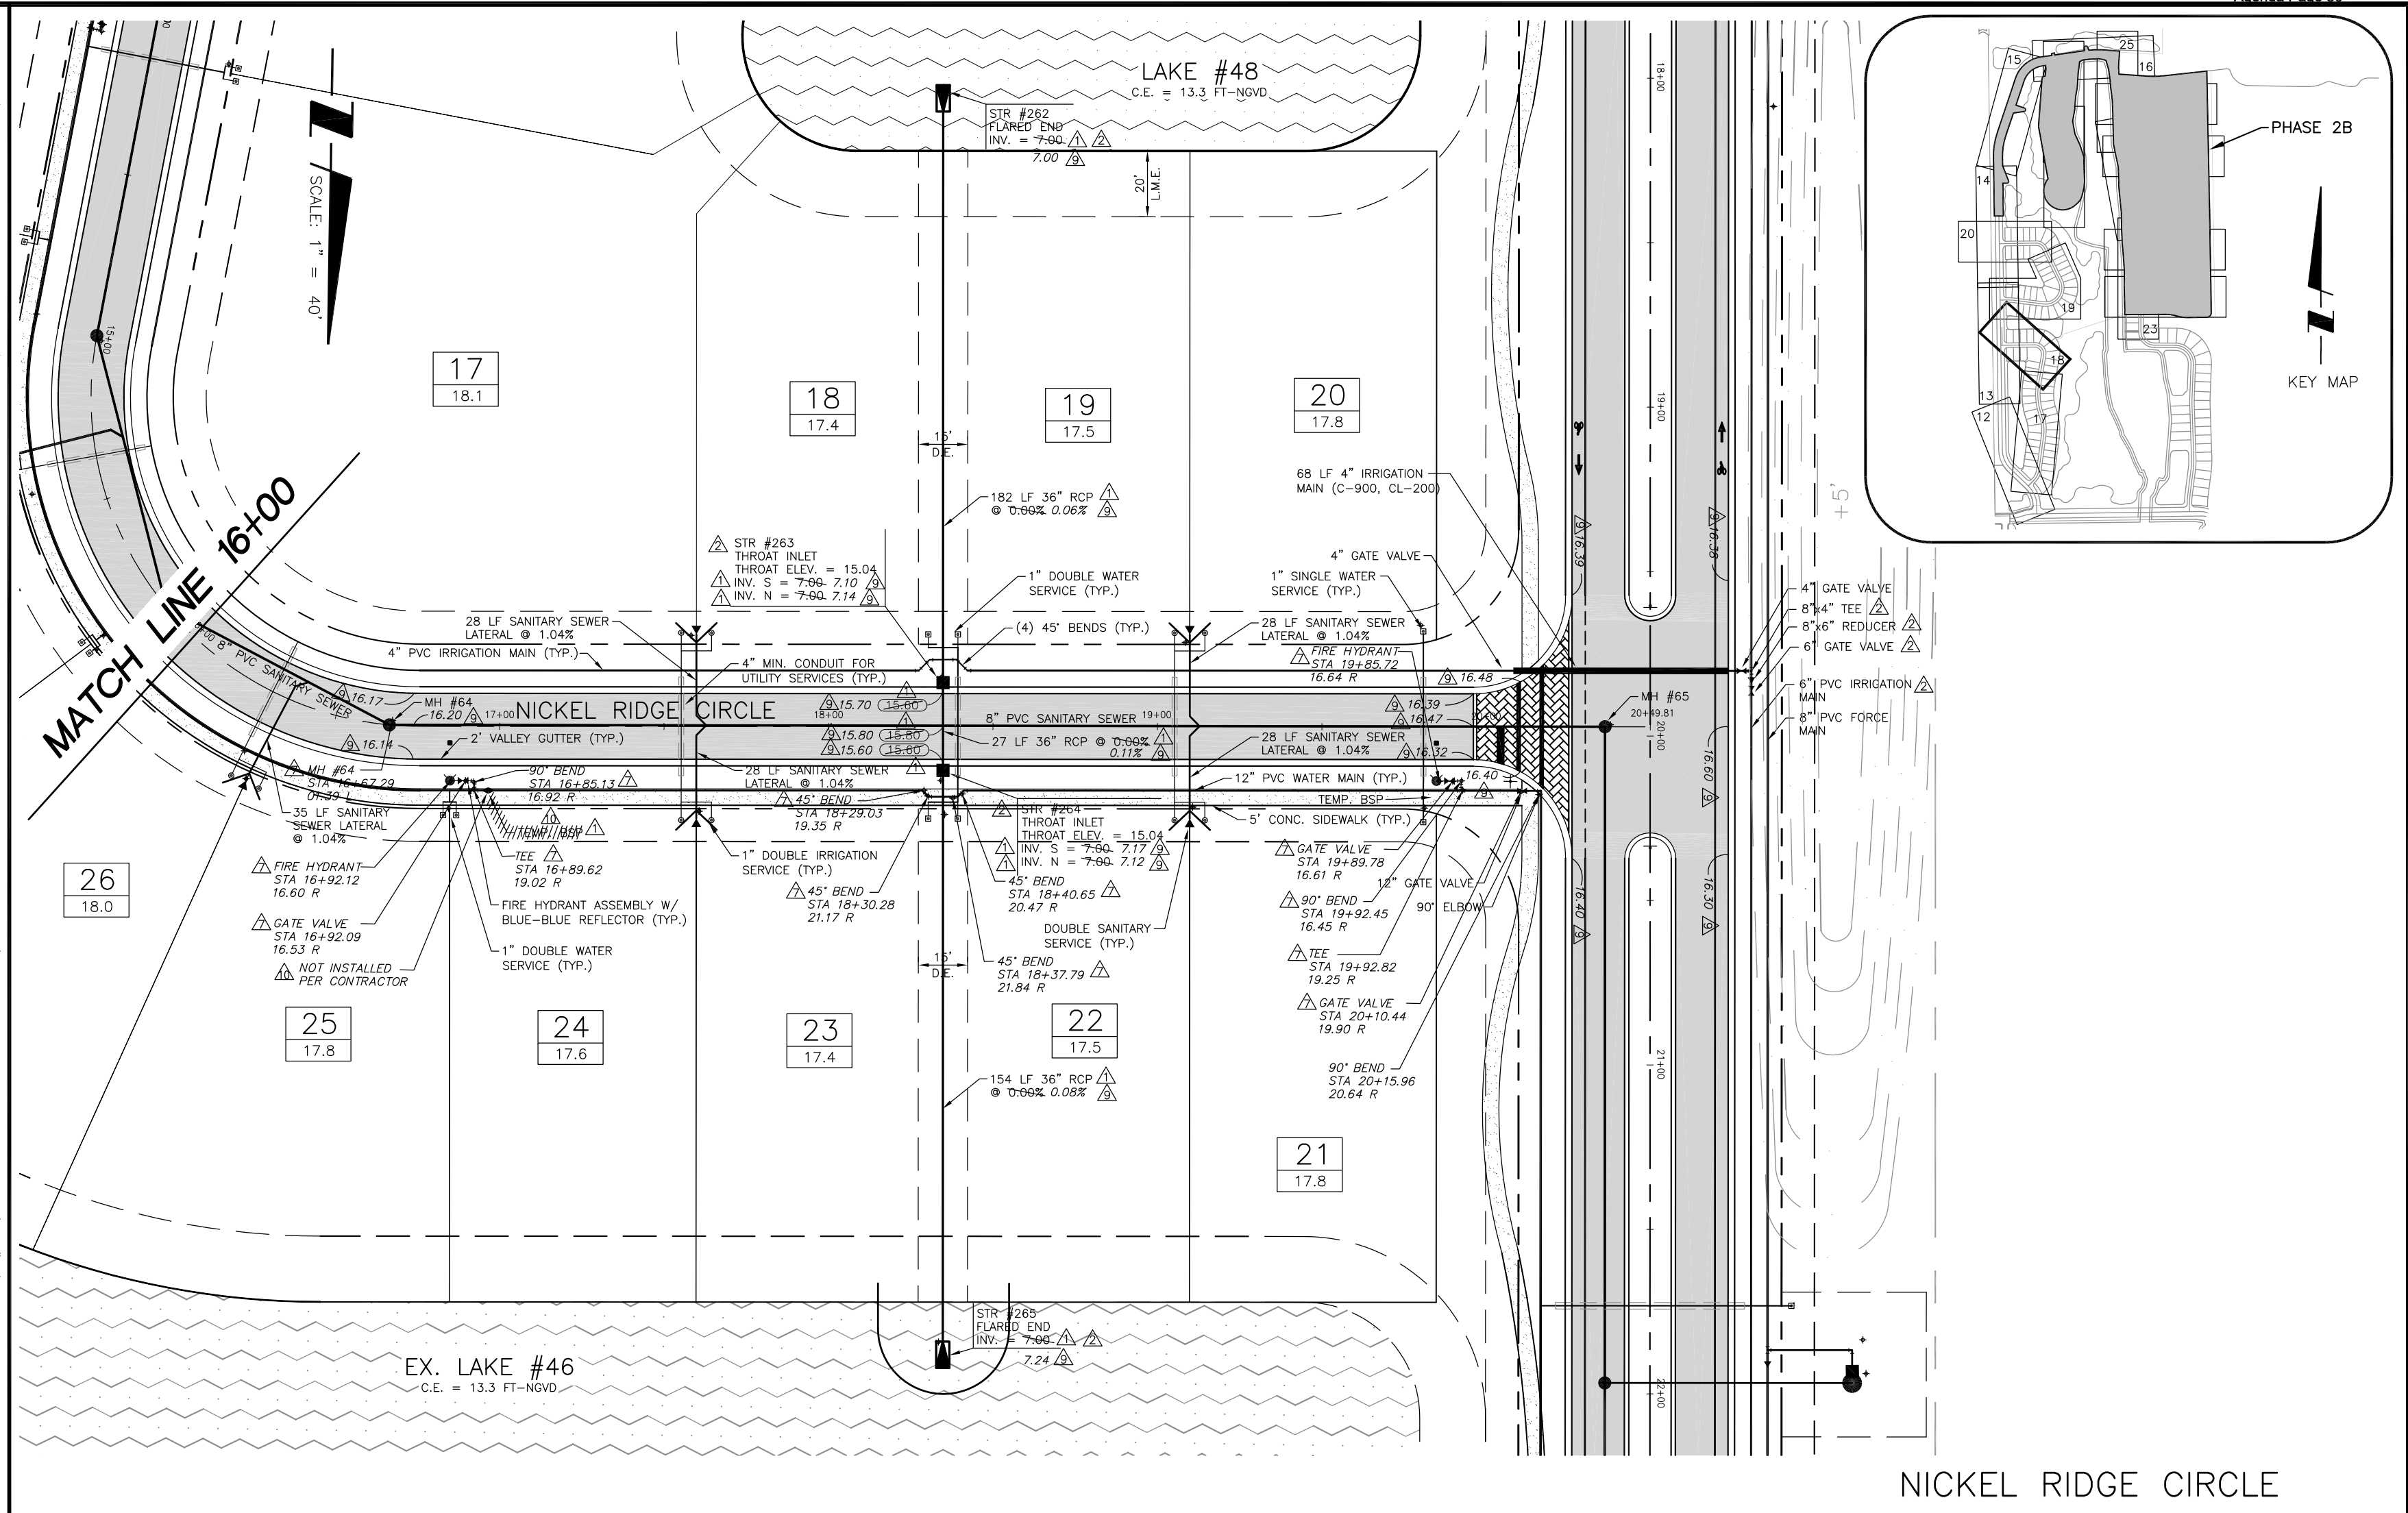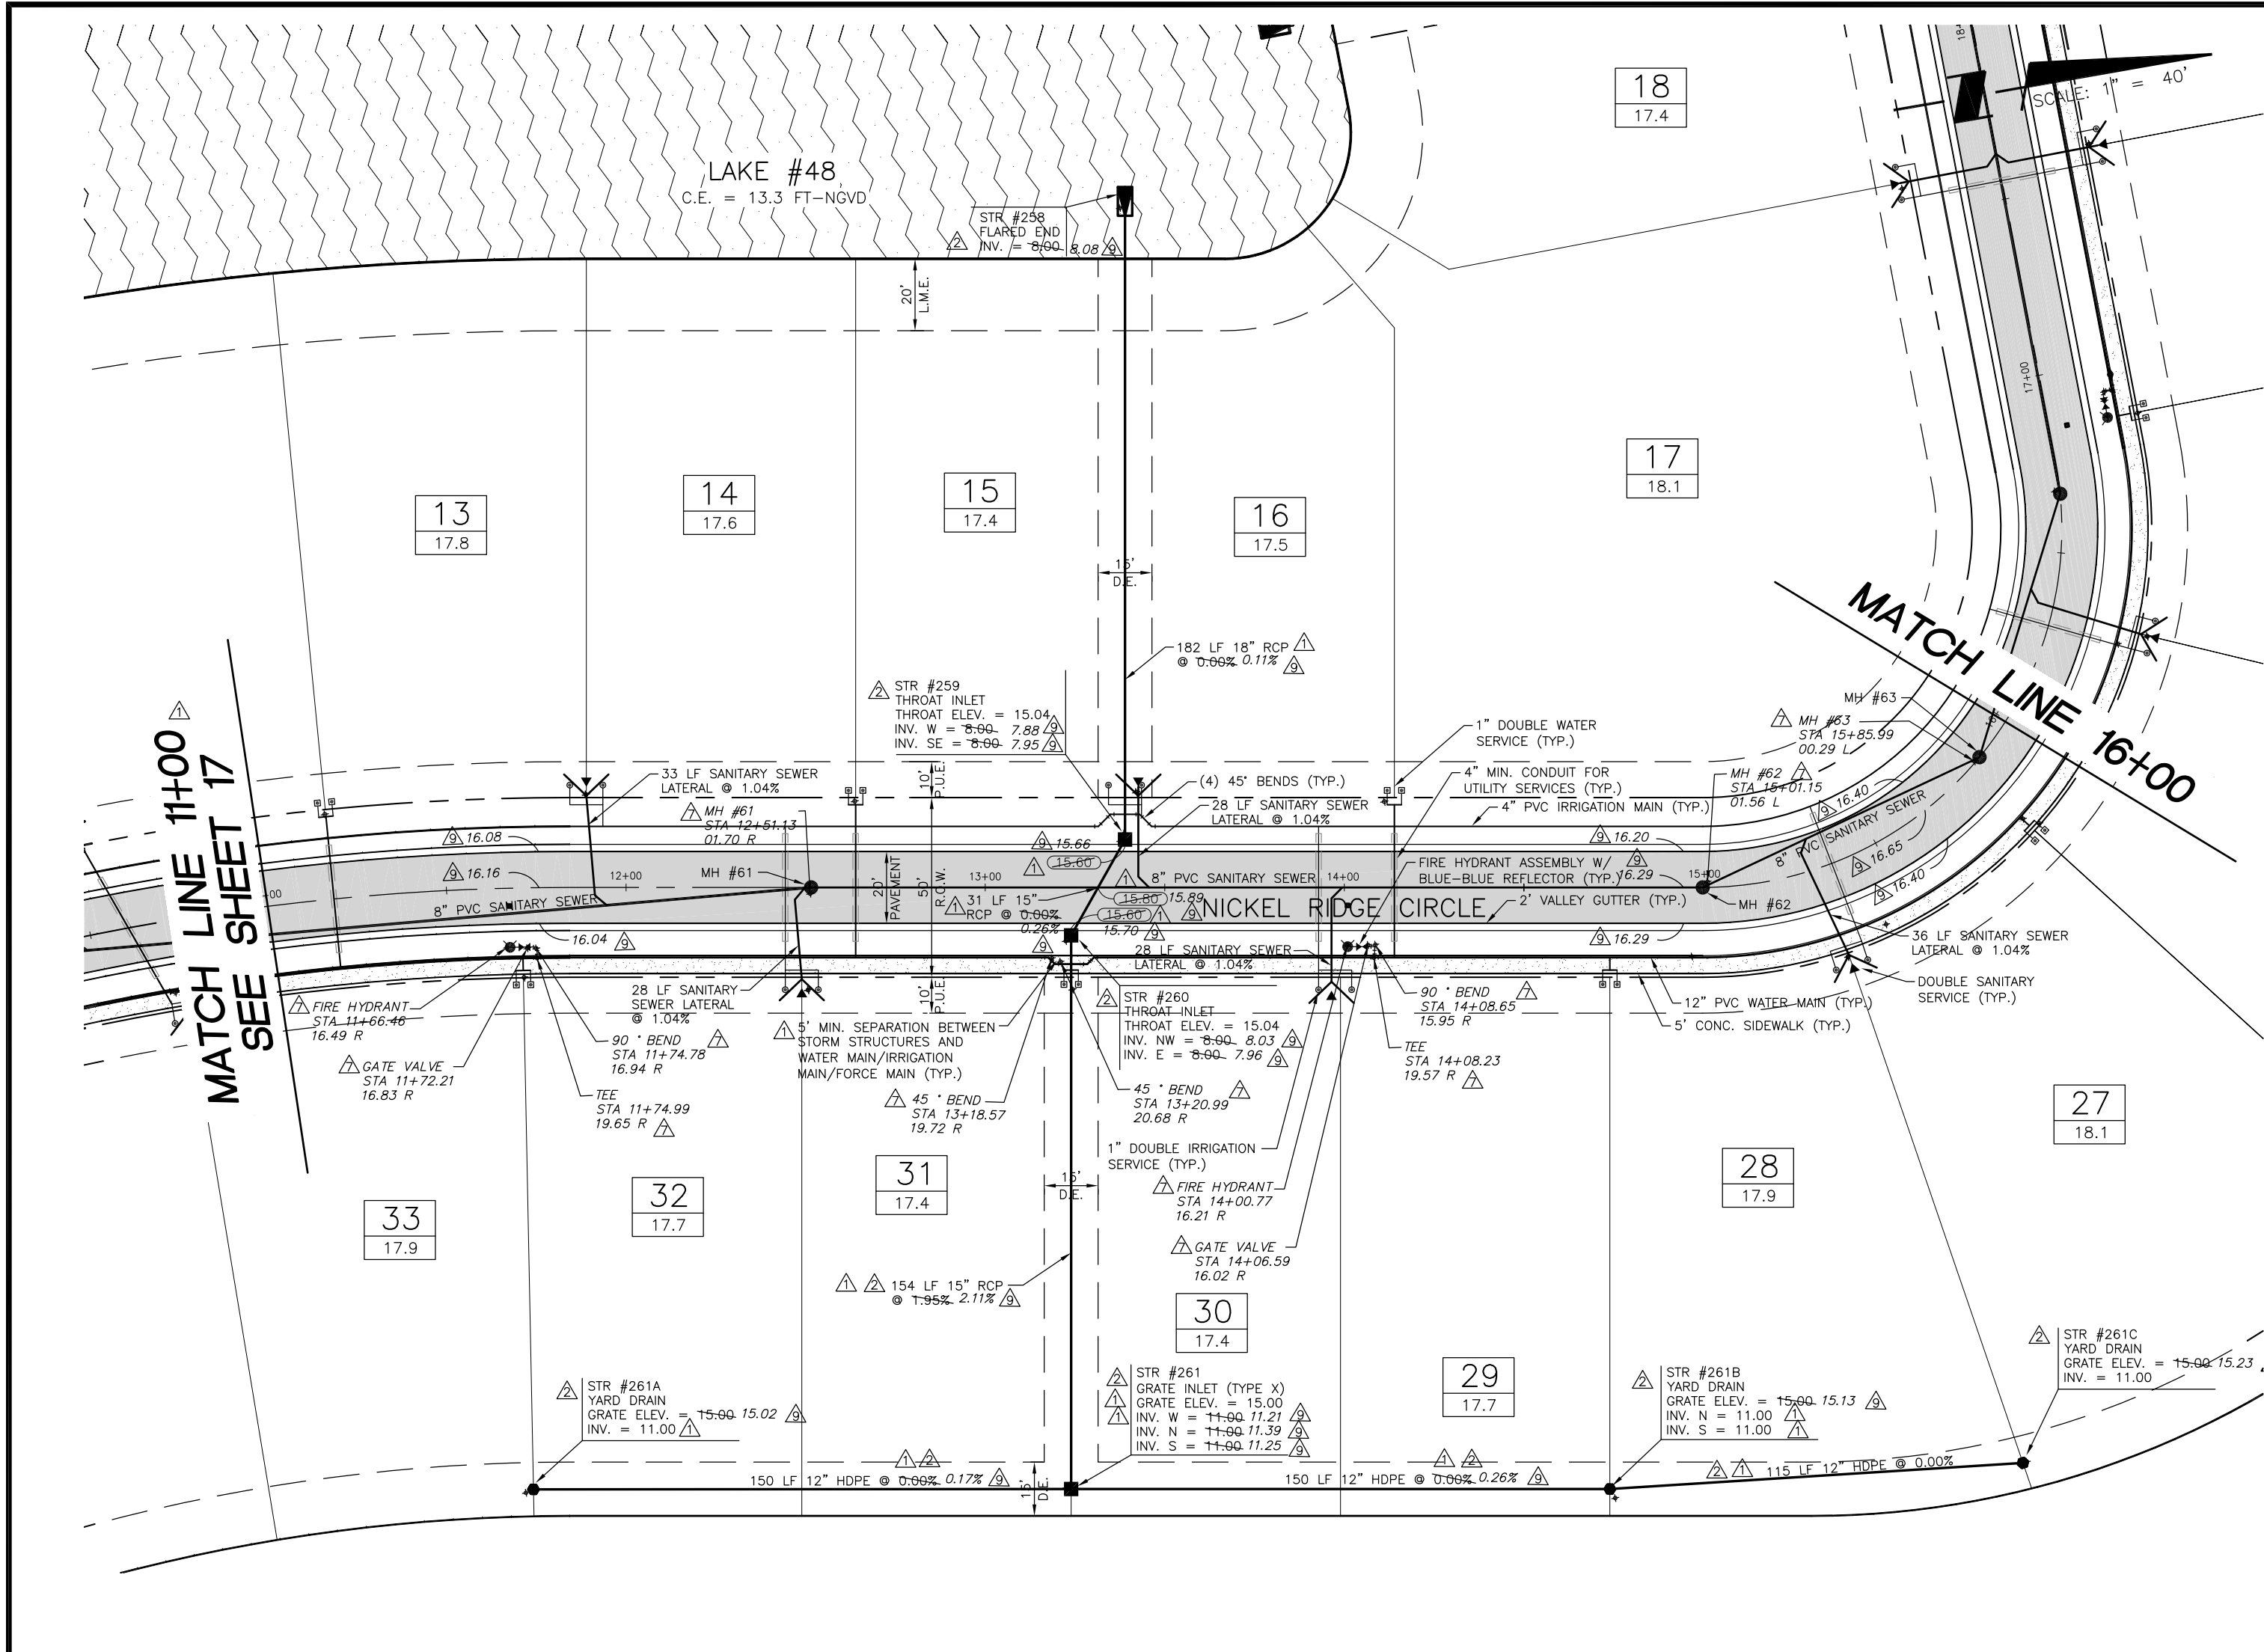

NICKEL RIDGE CIRCLE

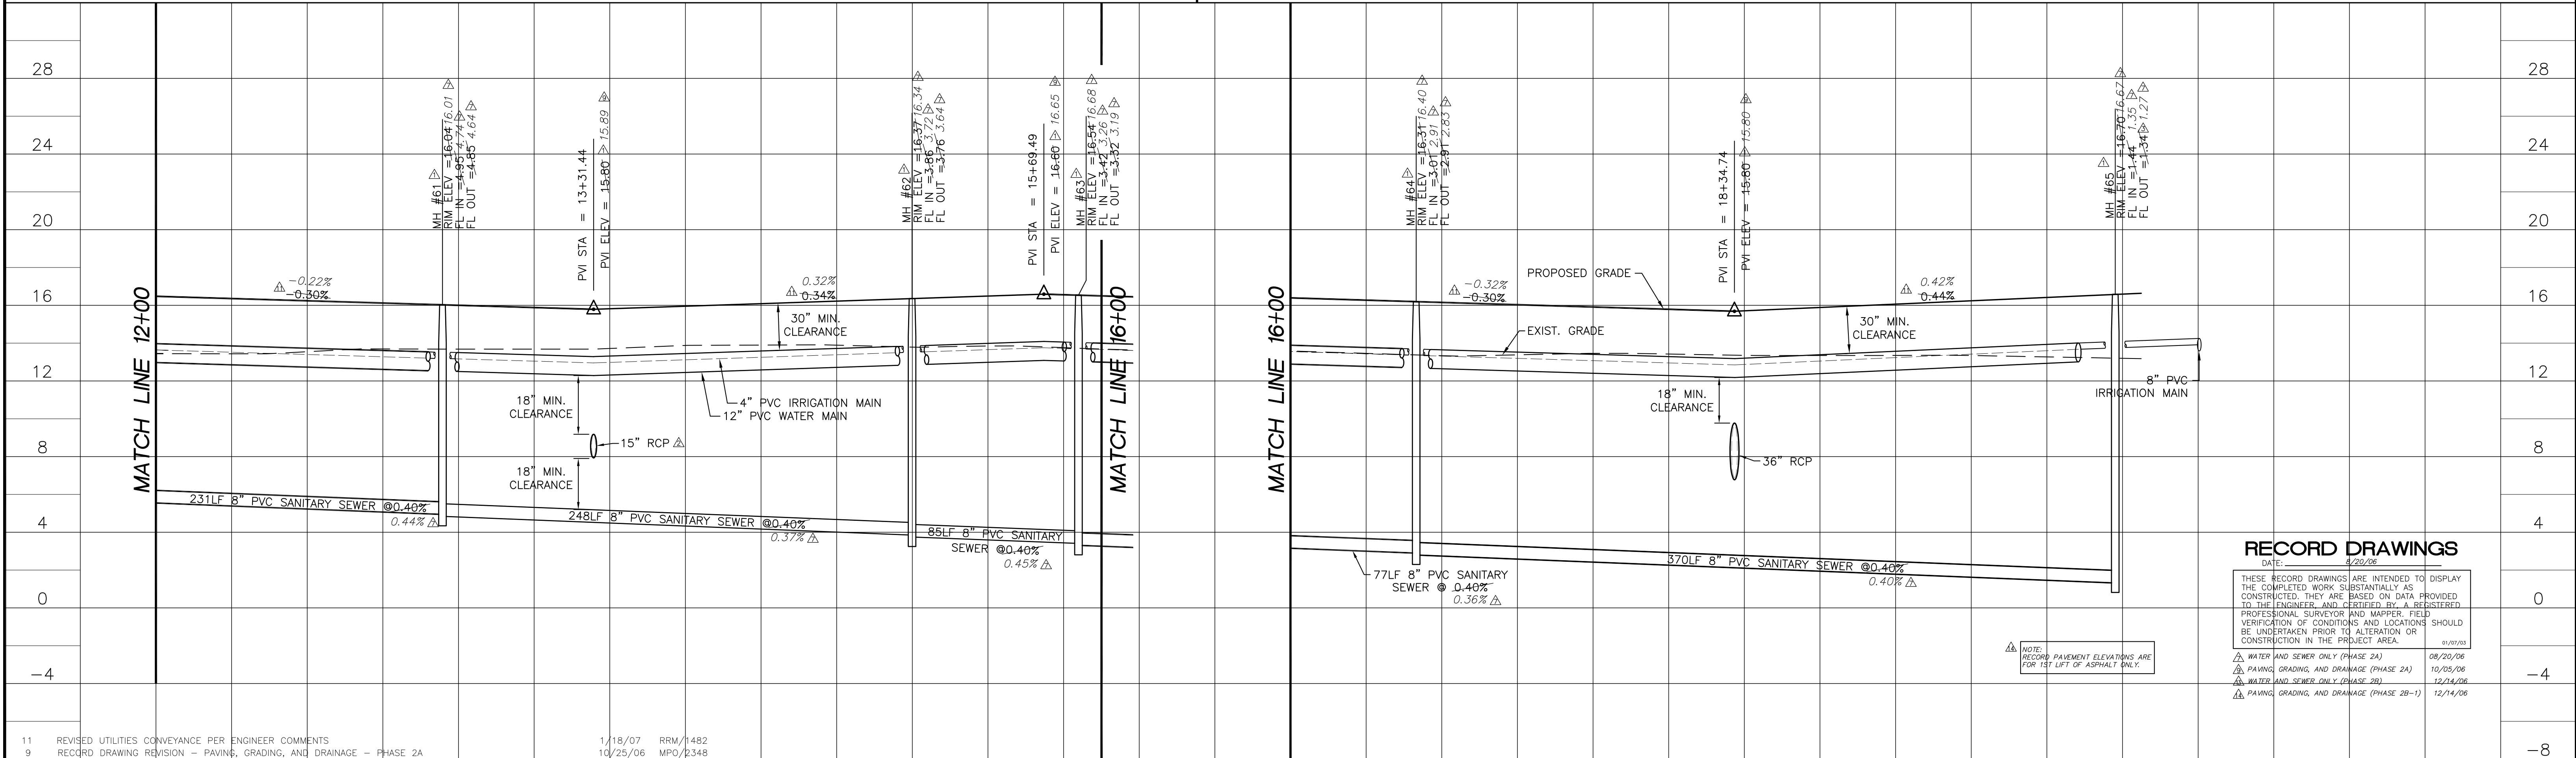

RECORD DRAWINGS

DATE: 8/20/06

THESE RECORD DRAWINGS ARE INTENDED TO DISPLAY THE COMPLETED WORK SUBSTANTIALLY AS CONSTRUCTED. THEY ARE BASED ON DATA PROVIDED TO THE ENGINEER AND CERTIFIED BY A REGISTERED PROFESSIONAL SURVEYOR AND MAPPER. FIELD VERIFICATION OF CONDITIONS AND LOCATIONS SHOULD BE UNDERTAKEN PRIOR TO ALTERATION OR CONSTRUCTION IN THE PROJECT AREA.

NOTE: RECORD PAVEMENT ELEVATIONS ARE FOR 1ST LIFT OF ASPHALT ONLY.

DATE: 8/20/06

DATE: 8/20/06

11	REVISED UTILITIES CONVEYANCE PER ENGINEER COMMENTS	1/19/07	RRM/1482
9	RECORD DRAWING REVISION - PAVING, GRADING, AND DRAINAGE - PHASE 2A	10/25/06	MPO/2348
7	RECORD DRAWING REVISION - WATER AND SEWER ONLY - PHASE 2A	8/14/06	MPO/2348
4	REVISED FOR INSUBSTANTIAL CHANGE	5/4/06	RRM/1482
3	REVISED PER FDEP COMMENTS AND PER ENGINEER	3/22/06	RRM/1482
2	REVISED PER ENGINEER & COUNTY COMMENTS	11/29/05	RRM/1482
1	REVISED PER COLLIER COUNTY COMMENTS	9/28/05	RRM/1482
ΔREV NO.	REVISION	Feb. 07, 2008 - 14:48:37	TDASILVA\K\END\N0442\150-QuarryPhase2\Rev14-rordPaving&Drainage\044215018.dwg
DATE	DRAWN BY / EMP. NO.	CHECKED BY / EMP. NO.	WM APPROVED BY:

WilsonMiller

Planners • Engineers • Ecologists • Surveyors • Landscape Architects • Transportation Consultants

WilsonMiller, Inc.

Naples • Fort Myers • Sarasota • Bradenton • Tampa • Tallahassee

457 Colonial Boulevard Suite 100 • Fort Myers, Florida 33902 • Phone: 239-939-1200 • Fax: 239-939-3412 • Web Site: www.wilsonmiller.com

CLIENT:	CENTEX HOMES
PROJECT:	THE QUARRY PHASE 2
DATE:	FEB 2005
HORIZONTAL SCALE:	1" = 40'
VERTICAL SCALE:	1" = 4'
SEC. INVS:	RGE
CROSS REFERENCE FILE NO.:	D-0442-48
TITLE:	PLAN AND PROFILE NICKEL RIDGE CIRCLE STA. 11+00 TO END
INDEX NUMBER:	D-0442-150
SHEET NUMBER:	18 OF 38
PROJECT NUMBER:	N0442-509-000


LISA M. GORDANO
LICENSE # 59318

INDEX NUMBER:

D-0442-150

SHEET NUMBER:

18 OF 38



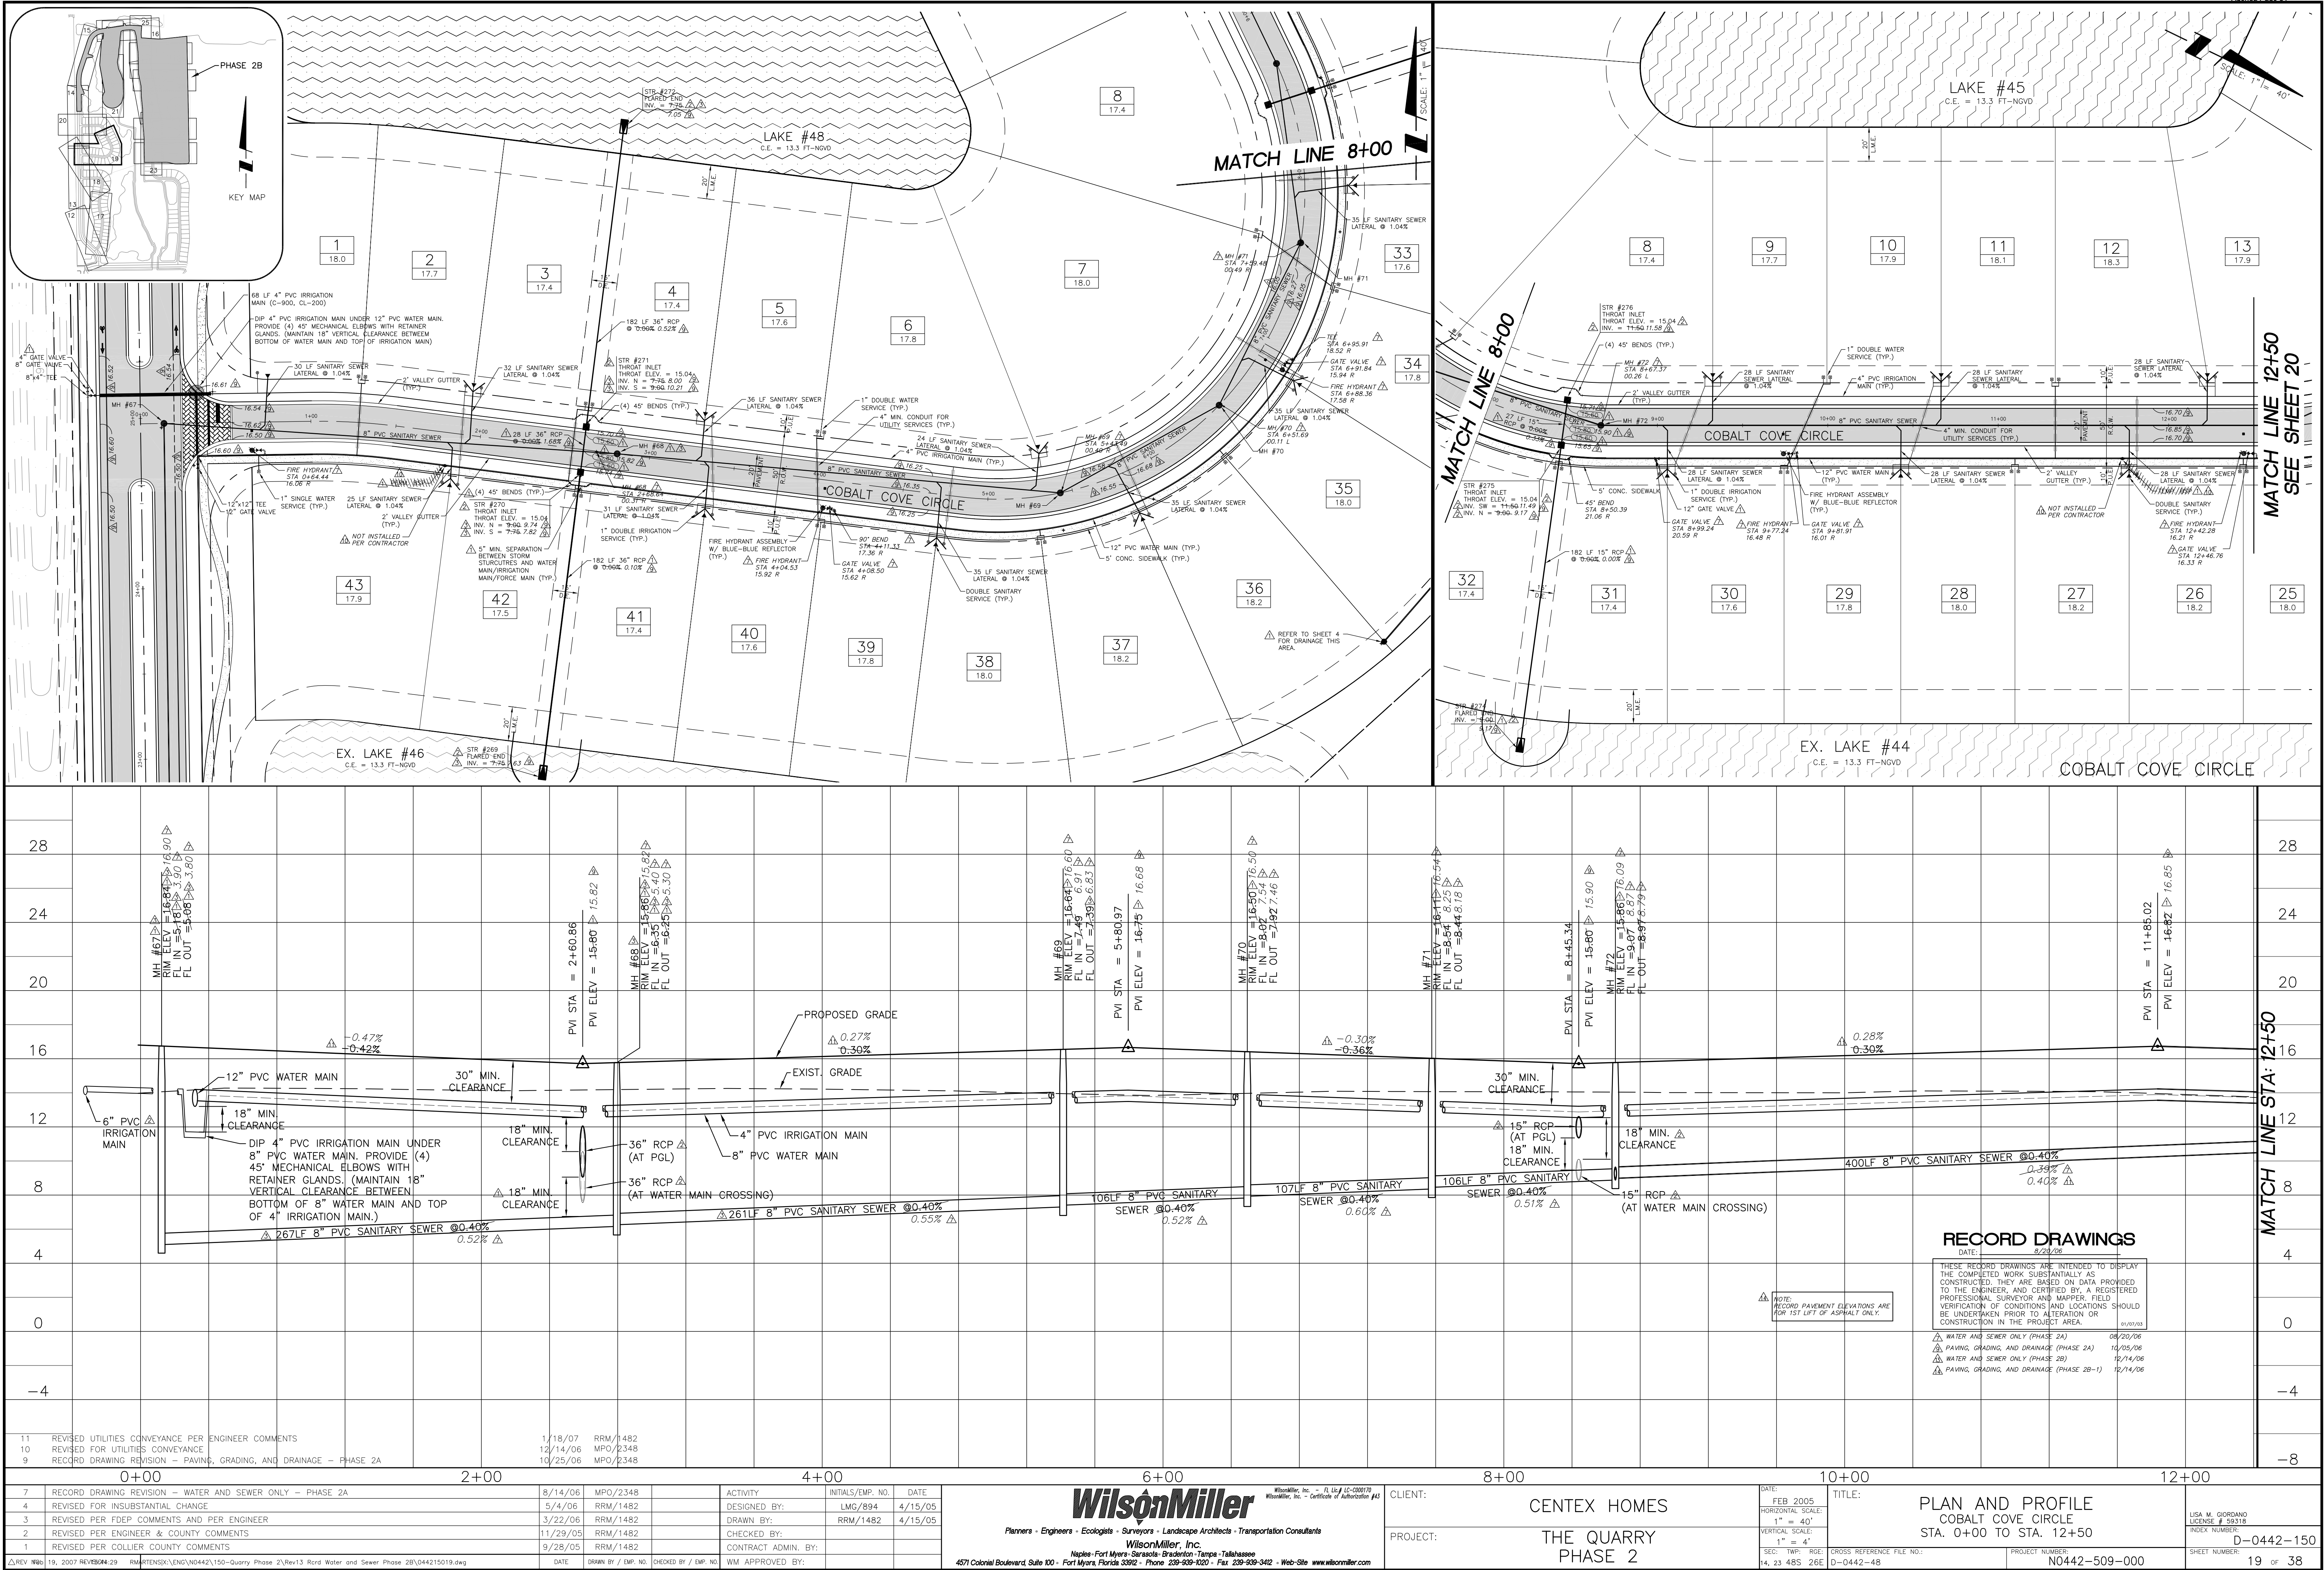


[illegible]

NOTE:		
RECORD PAVEMENT ELEVATIONS ARE		
FOR 1ST LIFT OF ASPHALT ONLY.		

<p>THESE RECORD DRAWINGS ARE INTENDED TO DISPLAY THE COMPLETED WORK SUBSTANTIALLY AS CONSTRUCTED. THEY ARE BASED ON DATA PROVIDED TO THE ENGINEER, AND CERTIFIED BY A REGISTERED PROFESSIONAL SURVEYOR AND MAPPER. FIELD VERIFICATION OF CONDITIONS AND LOCATIONS SHOULD BE UNDERTAKEN PRIOR TO ALTERATION OR CONSTRUCTION IN THE PROJECT AREA.</p>		01/23/20
△	PAVE AND SEWER ONLY (PHASE 2A)	08/20/20
△	PAVING, GRADING, AND DRAINAGE (PHASE 2A)	10/05/20
△	PAVE AND SEWER ONLY (PHASE 2B)	12/14/20
△	PAVING, GRADING, AND DRAINAGE (PHASE 2B-1)	12/14/20

9	RECORD DRAWING REVISION -- PAVING, GRADING, AND DRAINAGE -- PHASE 2A	10/25/06	MPO/2348		ACTIVITY:	INITIALS/EMP. NO.	DATE	 <p>WilsonMiller Planners • Engineers • Ecologists • Surveyors • Landscape Architects • Transportation Consultants WilsonMiller, Inc. Naples • Fort Myers • Sarasota • Bradenton • Tampa • Tallahassee 4571 Colonial Boulevard, Suite 100 • Fort Myers, Florida 33912 • Phone 239-939-1020 • Fax 239-939-3412 • Web-Site www.wilsonmiller.com</p>	CLIENT:	CENTEX HOMES	DATE: FEB 2005	TITLE: PLAN AND PROFILE COBALT COVE CIRCLE STA. 12+50 TO END	LISA M. GIORIANO LICENSE # 59318	
7	RECORD DRAWING REVISION -- WATER AND SEWER ONLY	8/14/06	MPO/2348		DESIGNED BY:	LMG/894	4/15/05		PROJECT:	THE QUARRY PHASE 2	HORIZONTAL SCALE: 1" = 40'			INDEX NUMBER: D-0442-150
4	REVISED FOR INSUBSTANTIAL CHANGE	5/4/06	RRM/1482		DRAWN BY:	RRM/1482	4/15/05				VERTICAL SCALE: 1" = 4'			SHEET NUMBER: 20 OF 38
2	REVISED PER ENGINEER & COUNTY COMMENTS	11/29/05	RRM/1482		CHECKED BY:						SEC. TWP. RGE: 14, 23 48S 26E	CROSS REFERENCE FILE NO.: D-0442-48	PROJECT NUMBER: N0442-509-000	
1	REVISED PER COLLIER COUNTY COMMENTS	9/28/05	RRM/1482		CONTRACT ADMIN. BY:									
REV NO.	REVISION	Feb 07, 2008 - 17:55:37	TBMSLVA\K\ENG\N0442\120-QuarryPhase2\Rev14-rccrdPaving&Drainage\044215020.dwg	DATE	DRAWN BY / EMP. NO.	CHECKED BY / EMP. NO.	WM APPROVED BY:							

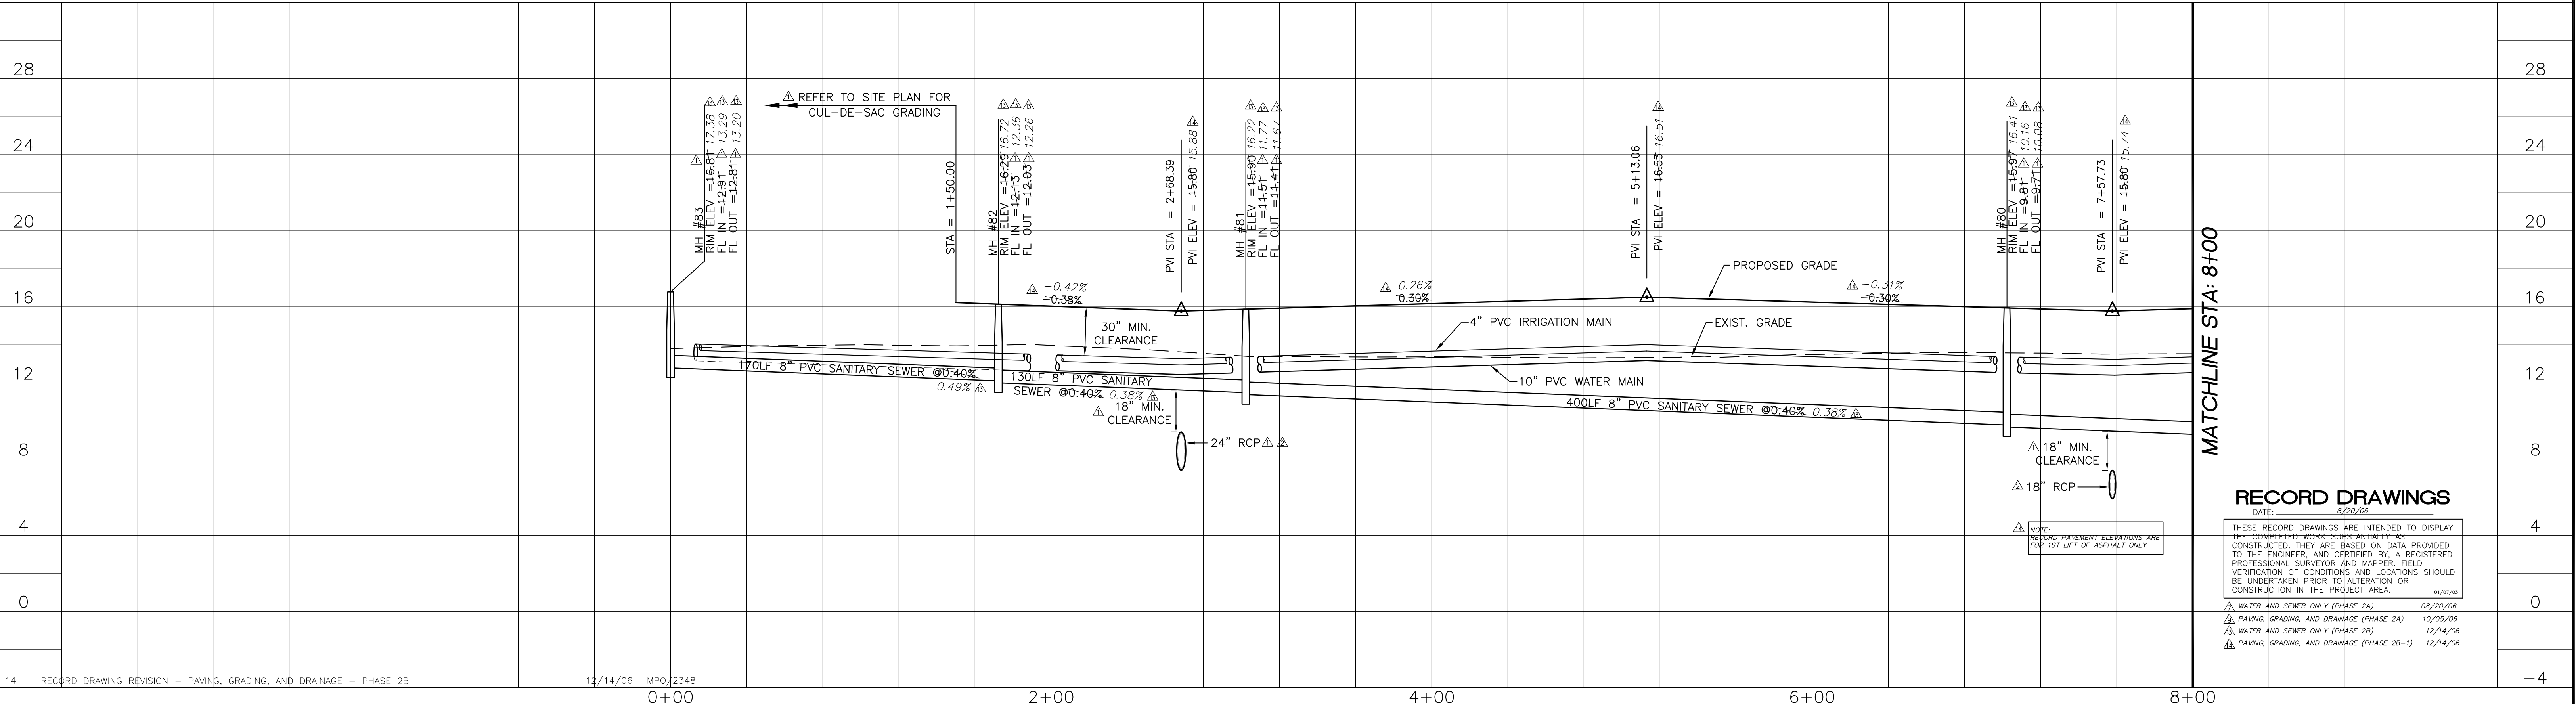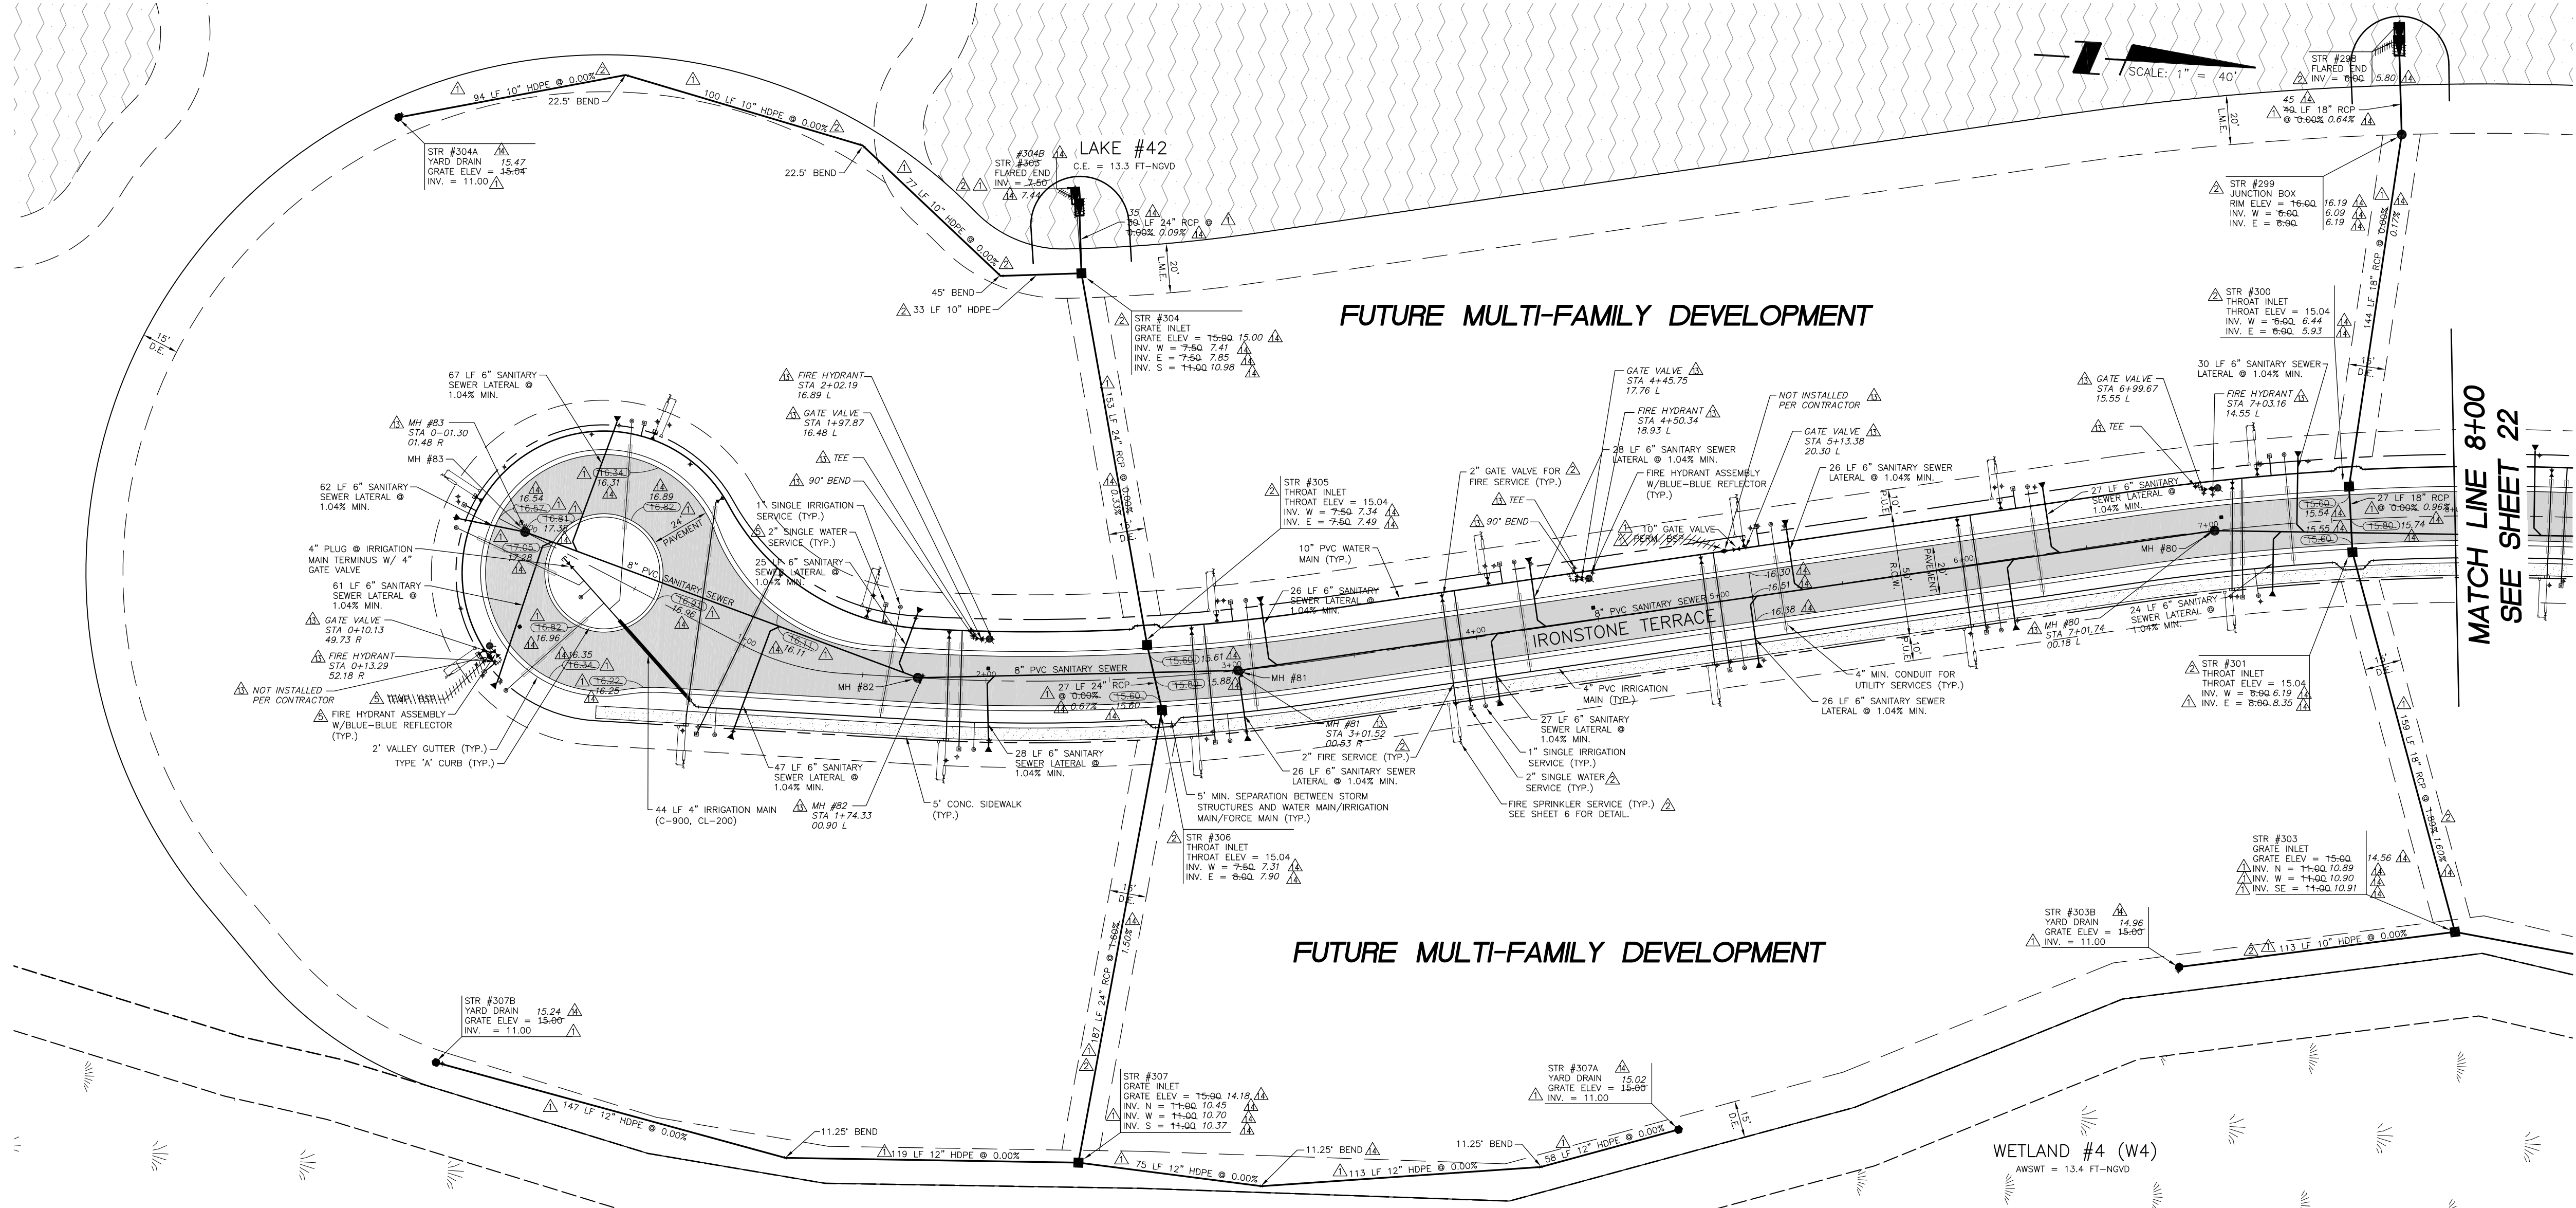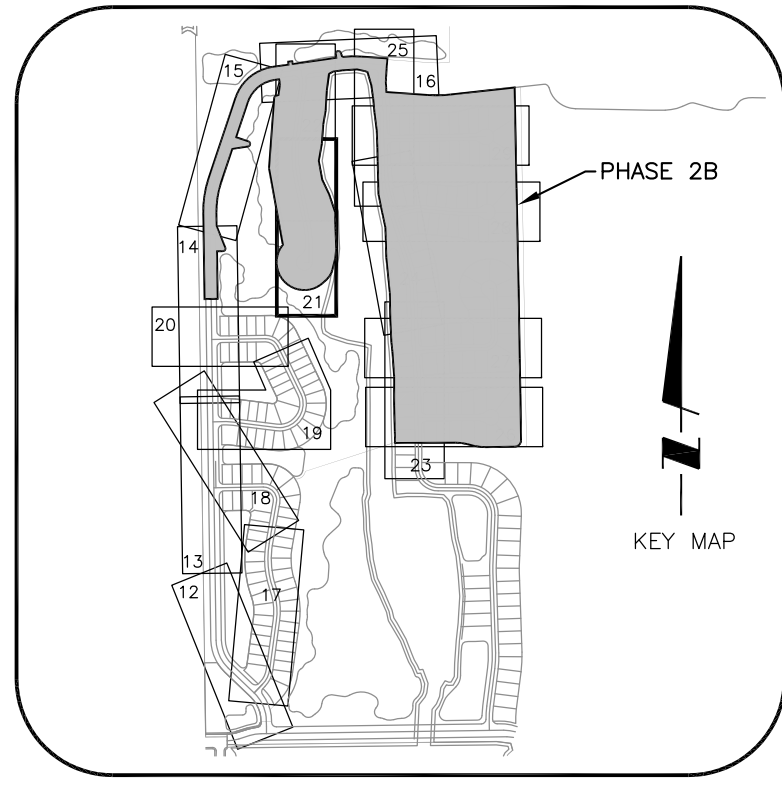

13	RECORD DRAWING REVISION - WATER AND SEWER ONLY - PHASE 2B	12/14/06	MPO/2348	ACTIVITY	INITIALS/EMP. NO.	DATE
10	REVISED FOR UTILITIES CONVEYANCE	12/14/06	MPO/2348	DESIGNED BY:	LMG/894	4/15/05
5	REVISED PER ENGINEER & OWNER	6/3/06	RRM/1482	DRAWN BY:	RRM/1482	4/15/05
2	REVISED PER ENGINEER & COUNTY COMMENTS	11/29/05	RRM/1482	CHECKED BY:		
1	REVISED PER COLLIER COUNTY COMMENTS	9/28/05	RRM/1482	CONTRACT ADMIN. BY:		
ΔREV NO.	REVISION	DATE	DRAWN BY / EMP. NO.	CHECKED BY / EMP. NO.	WM APPROVED BY:	
14	RECORD DRAWING REVISION - PAVING, GRADING, AND DRAINAGE - PHASE 2B	12/14/06	MPO/2348			
0+00						
2+00						
4+00						
6+00						
8+00						
-4						

WilsonMiller
Planners • Engineers • Ecologists • Surveyors • Landscape Architects • Transportation Consultants
WilsonMiller, Inc.
Naples • Fort Myers • Sarasota • Bradenton • Tampa • Tallahassee
4571 Colonial Boulevard, Suite 100 • Fort Myers, Florida 33912 • Phone 239-559-1020 • Fax 239-559-3412 • Web Site www.wilsonmiller.com

PROJECT: CENTEX HOMES
THE QUARRY
PHASE 2



DATE: FEB 2005
HORIZONTAL SCALE: 1" = 40'
VERTICAL SCALE: 1" = 4'
SHEET: 14 OF 26

TITLE: PLAN AND PROFILE
IRONSTONE TERRACE
STA. 0+00 TO STA. 8+00


CRASS REFERENCE FILE NO.: D-0442-48
PROJECT NUMBER: N0442-509-000
SHEET NUMBER: 21 OF 38

RECORD DRAWINGS
DATE: 8/20/06
THESE RECORD DRAWINGS ARE INTENDED TO DISPLAY THE "COMPLETED WORK" SUBSTANTIALLY AS CONSTRUCTED. THEY ARE BASED ON DATA PROVIDED TO THE ENGINEER, AND CERTIFIED BY, A REGISTERED PROFESSIONAL SURVEYOR AND MAPPER. FIELD VERIFICATION OF CONDITIONS AND LOCATIONS SHOULD BE UNDERTAKEN PRIOR TO ALTERATION OR CONSTRUCTION IN THE PROJECT AREA.

Δ WATER AND SEWER ONLY (PHASE 2A) 08/20/06
Δ PAVING, GRADING, AND DRAINAGE (PHASE 2A) 10/05/06
Δ WATER AND SEWER ONLY (PHASE 2B) 12/14/06
Δ PAVING, GRADING, AND DRAINAGE (PHASE 2B-1) 12/14/06

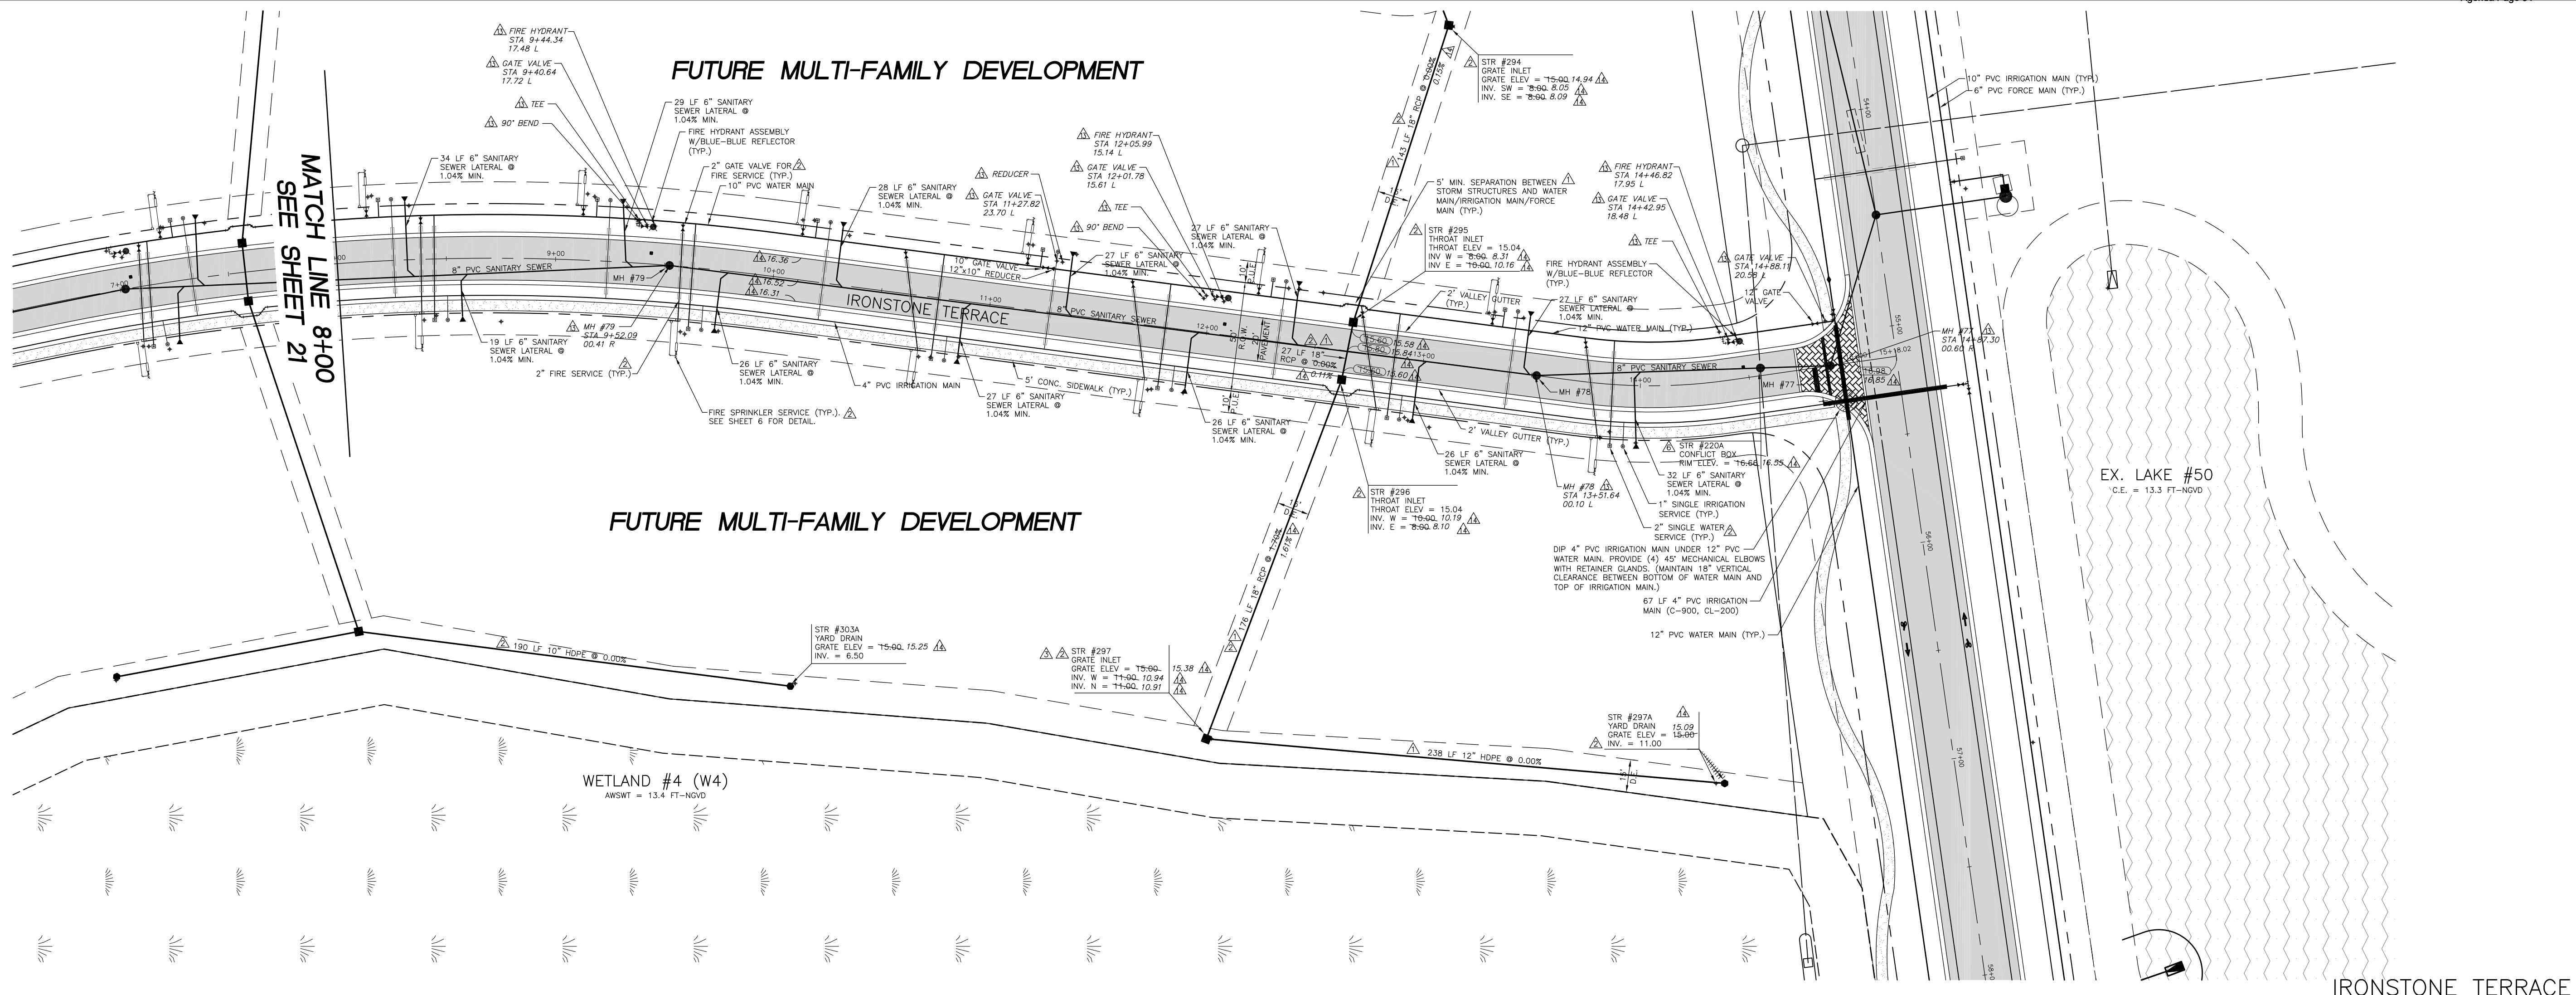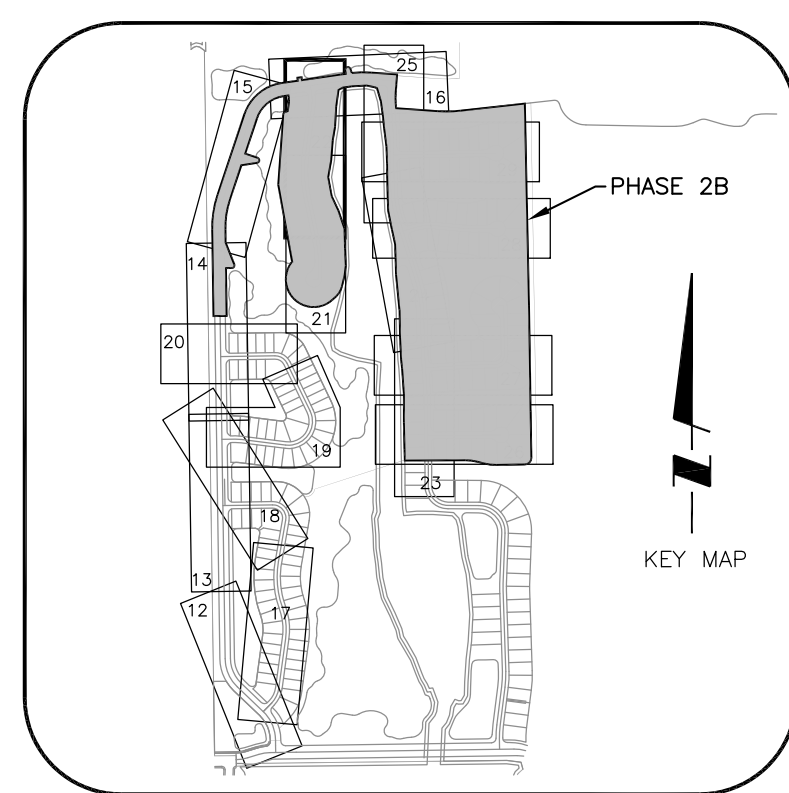

IRONSTONE TERRACE

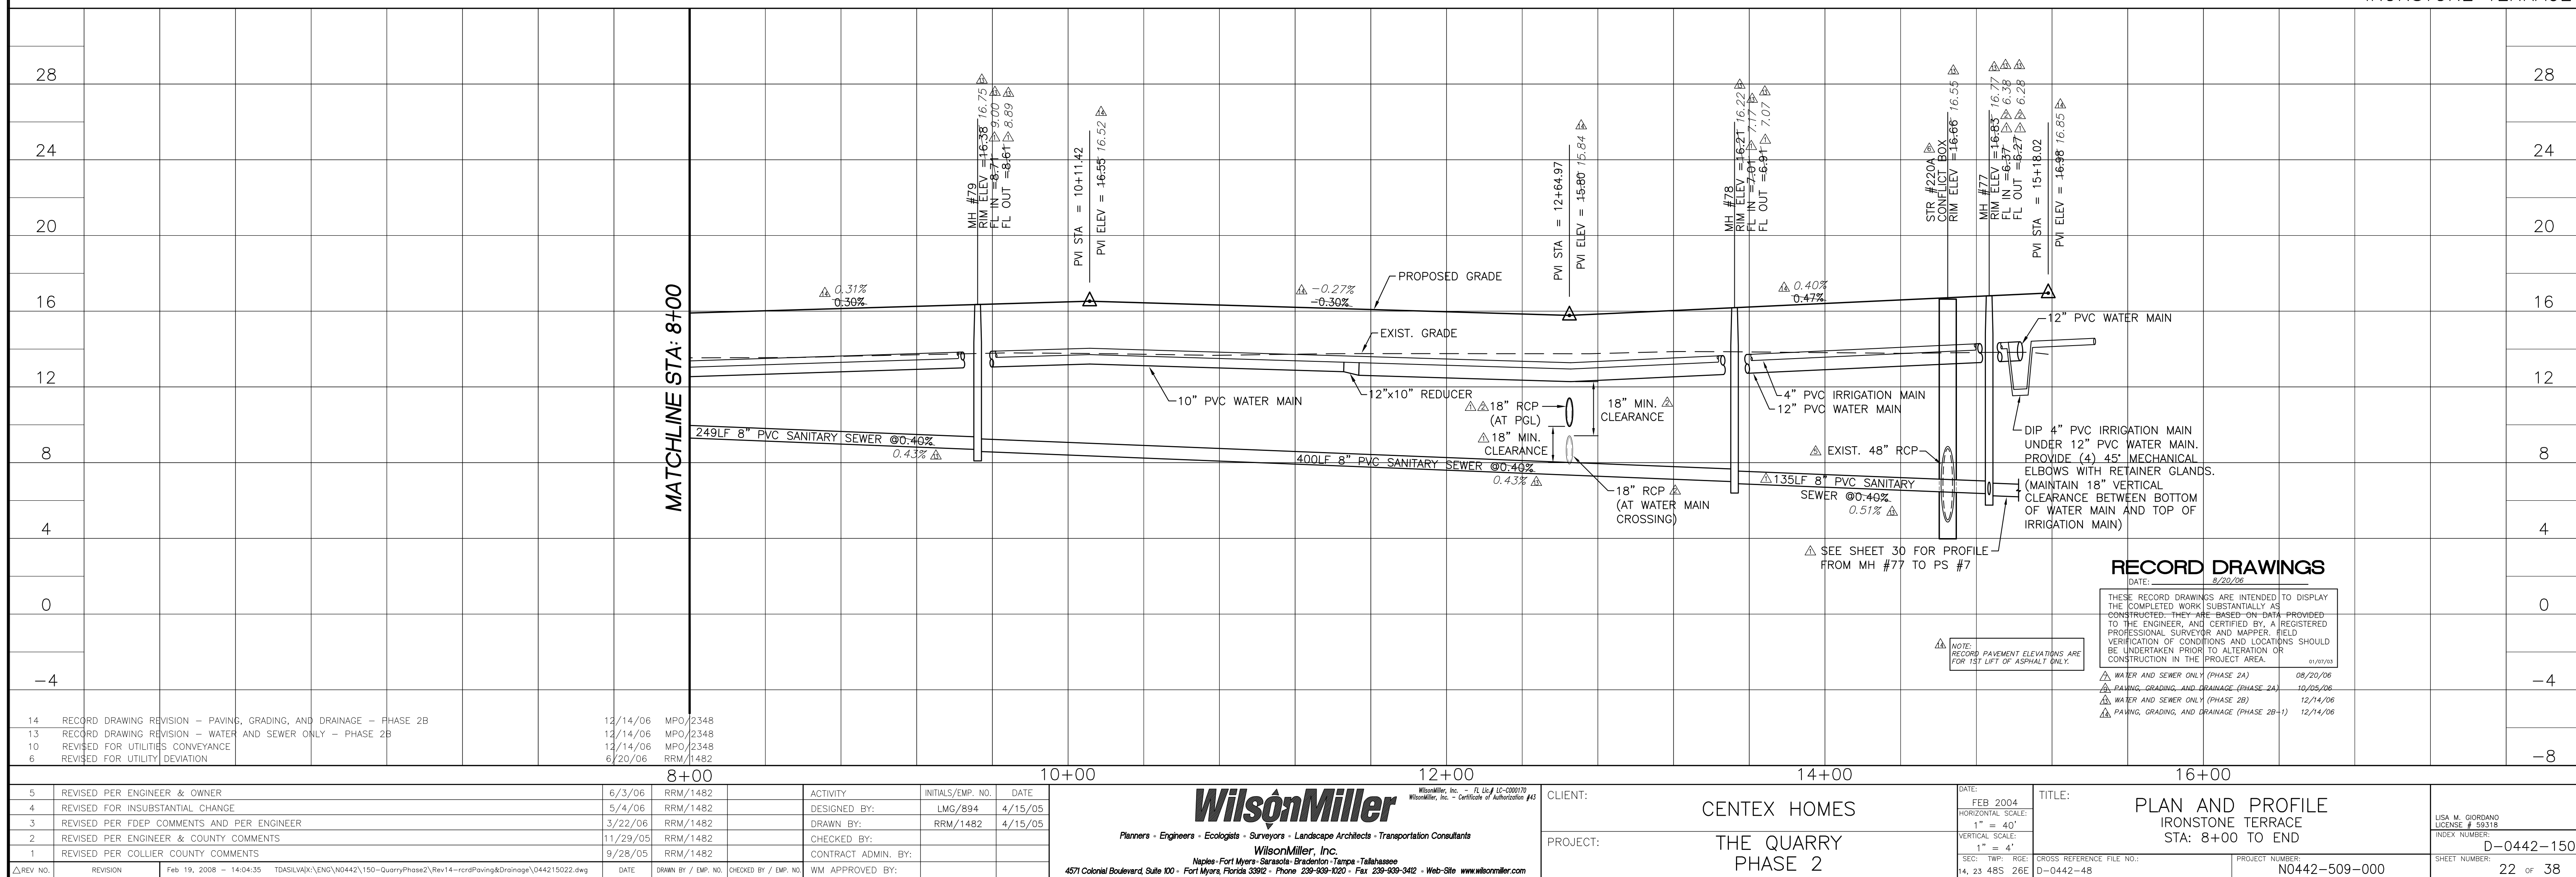

RECORD DRAWINGS

DATE: 8/20/06

THESE RECORD DRAWINGS ARE INTENDED TO DISPLAY THE COMPLETED WORK SUBSTANTIALLY AS CONSTRUCTED. THEY ARE BASED ON DATA PROVIDED TO THE ENGINEER, AND CERTIFIED BY A REGISTERED PROFESSIONAL SURVEYOR AND MAPPER. FIELD VERIFICATION OF CONDITIONS AND LOCATIONS SHOULD BE UNDERTAKEN PRIOR TO ALTERATION OR CONSTRUCTION IN THE PROJECT AREA.

WATER AND SEWER ONLY (PHASE 2A) 08/20/06
PAVING, GRADING, AND DRAINAGE (PHASE 2A) 10/25/06
WATER AND SEWER ONLY (PHASE 2B) 12/14/06
PAVING, GRADING, AND DRAINAGE (PHASE 2B-1) 12/14/06

NOTE: RECORD PAVEMENT ELEVATIONS ARE FOR 1ST LIFT OF ASPHALT ONLY.

5	REVISED PER ENGINEER & OWNER	6/3/06	RRM/1482	ACTIVITY	INITIALS/EMP. NO.	DATE	<div><div><div>WilsonMiller, Inc. - P. 06/10-000070</div><div>WilsonMiller, Inc. - Certificate of Authorization #12</div></div><div><div>WilsonMiller</div><div>Planners • Engineers • Ecologists • Surveyors • Landscape Architects • Transportation Consultants</div><div>WilsonMiller, Inc.</div><div>Naples • Fort Myers • Sarasota • Bradenton • Tampa • Tallahassee</div><div>4571 Colonial Boulevard, Suite 100 • Fort Myers, Florida 33912 • Phone 239-939-9020 • Fax 239-939-3412 • Web-Site www.wilsonmiller.com</div></div></div>	CLIENT:	CENTEX HOMES	DATE:	FEB 2004	TITLE:	PLAN AND PROFILE IRONSTONE TERRACE STA: 8+00 TO END	LISA M. GORDANO LICENSE # 59318			
4	REVISED FOR INSUBSTANTIAL CHANGE	5/4/06	RRM/1482	DESIGNED BY:	LMG/894	4/15/05		PROJECT:	THE QUARRY PHASE 2	HORIZONTAL SCALE:	1" = 40'	CROSS REFERENCE FILE NO.:	D-0442-48	PROJECT NUMBER:	N0442-509-000	SHEET NUMBER:	22 OF 38
3	REVISED PER FDP COMMENTS AND PER ENGINEER	3/22/06	RRM/1482	DRAWN BY:	RRM/1482	4/15/05			VERTICAL SCALE:	1" = 4'	INDEX NUMBER:	D-0442-150					
2	REVISED PER ENGINEER & COUNTY COMMENTS	11/29/05	RRM/1482	CHECKED BY:					SEC:	TWP:	RGE:						
1	REVISED PER COLLIER COUNTY COMMENTS	9/28/05	RRM/1482	CONTRACT ADMIN. BY:					14, 23 48S	26E							
ΔREV NO.	REVISION	Feb 19, 2008 - 14:04:35	TDASLVA\X\EN\N0442\150-QuarryPhase2\Rev14-rctPaving&Drainage\044215022.dwg	DATE	DRAWN BY / EMP. NO.	CHECKED BY / EMP. NO.	WM APPROVED BY:										

WilsonMiller

Planners • Engineers • Ecologists • Surveyors • Landscape Architects • Transportation Consultants




WilsonMiller, Inc.

Naples • Fort Myers • Sarasota • Bradenton • Tampa • Tallahassee

4571 Colonial Boulevard, Suite 100 • Fort Myers, Florida 33912 • Phone 239-939-1020 • Fax 239-939-3412 • Web Site www.wilsonmiller.com

WilsonMiller, Inc. - FL Lic # LC-000070
WilsonMiller, Inc. - Certificate of Authorization #45

CLIENT:	CENTEX HOMES	DATE:	FEB 2004	TITLE:	PLAN AND PROFILE IRONSTONE TERRACE STA: 8+00 TO END	LISA M. GIORGANO LICENSE # 59318
PROJECT:	THE QUARRY PHASE 2	HORIZONTAL SCALE:	1" = 40'	CROSS REFERENCE FILE NO.:	D-0442-48	INDEX NUMBER:
		VERTICAL SCALE:	1" = 4'			D-0442-150
		SEC: TWP: RGE:	14, 23 48S 26E			SHEET NUMBER:
				PROJECT NUMBER:	N0442-509-000	22 OF 38

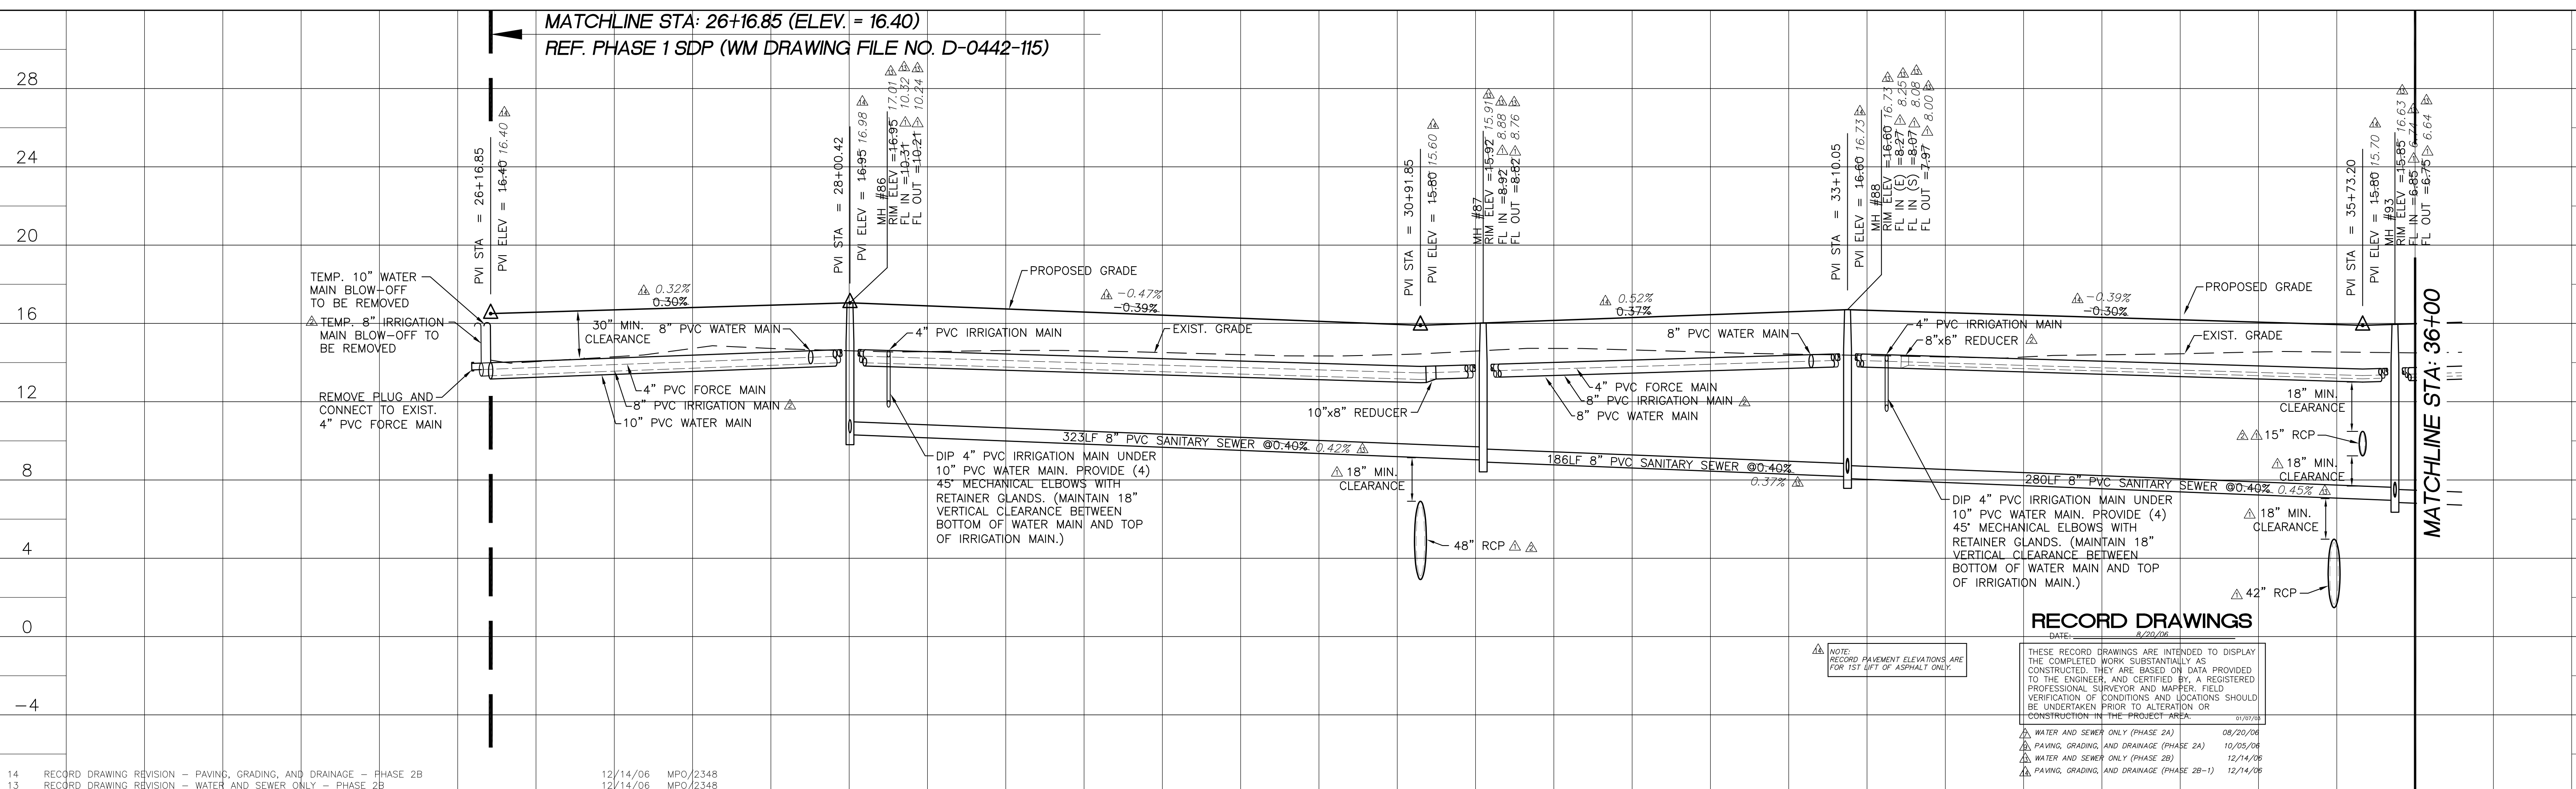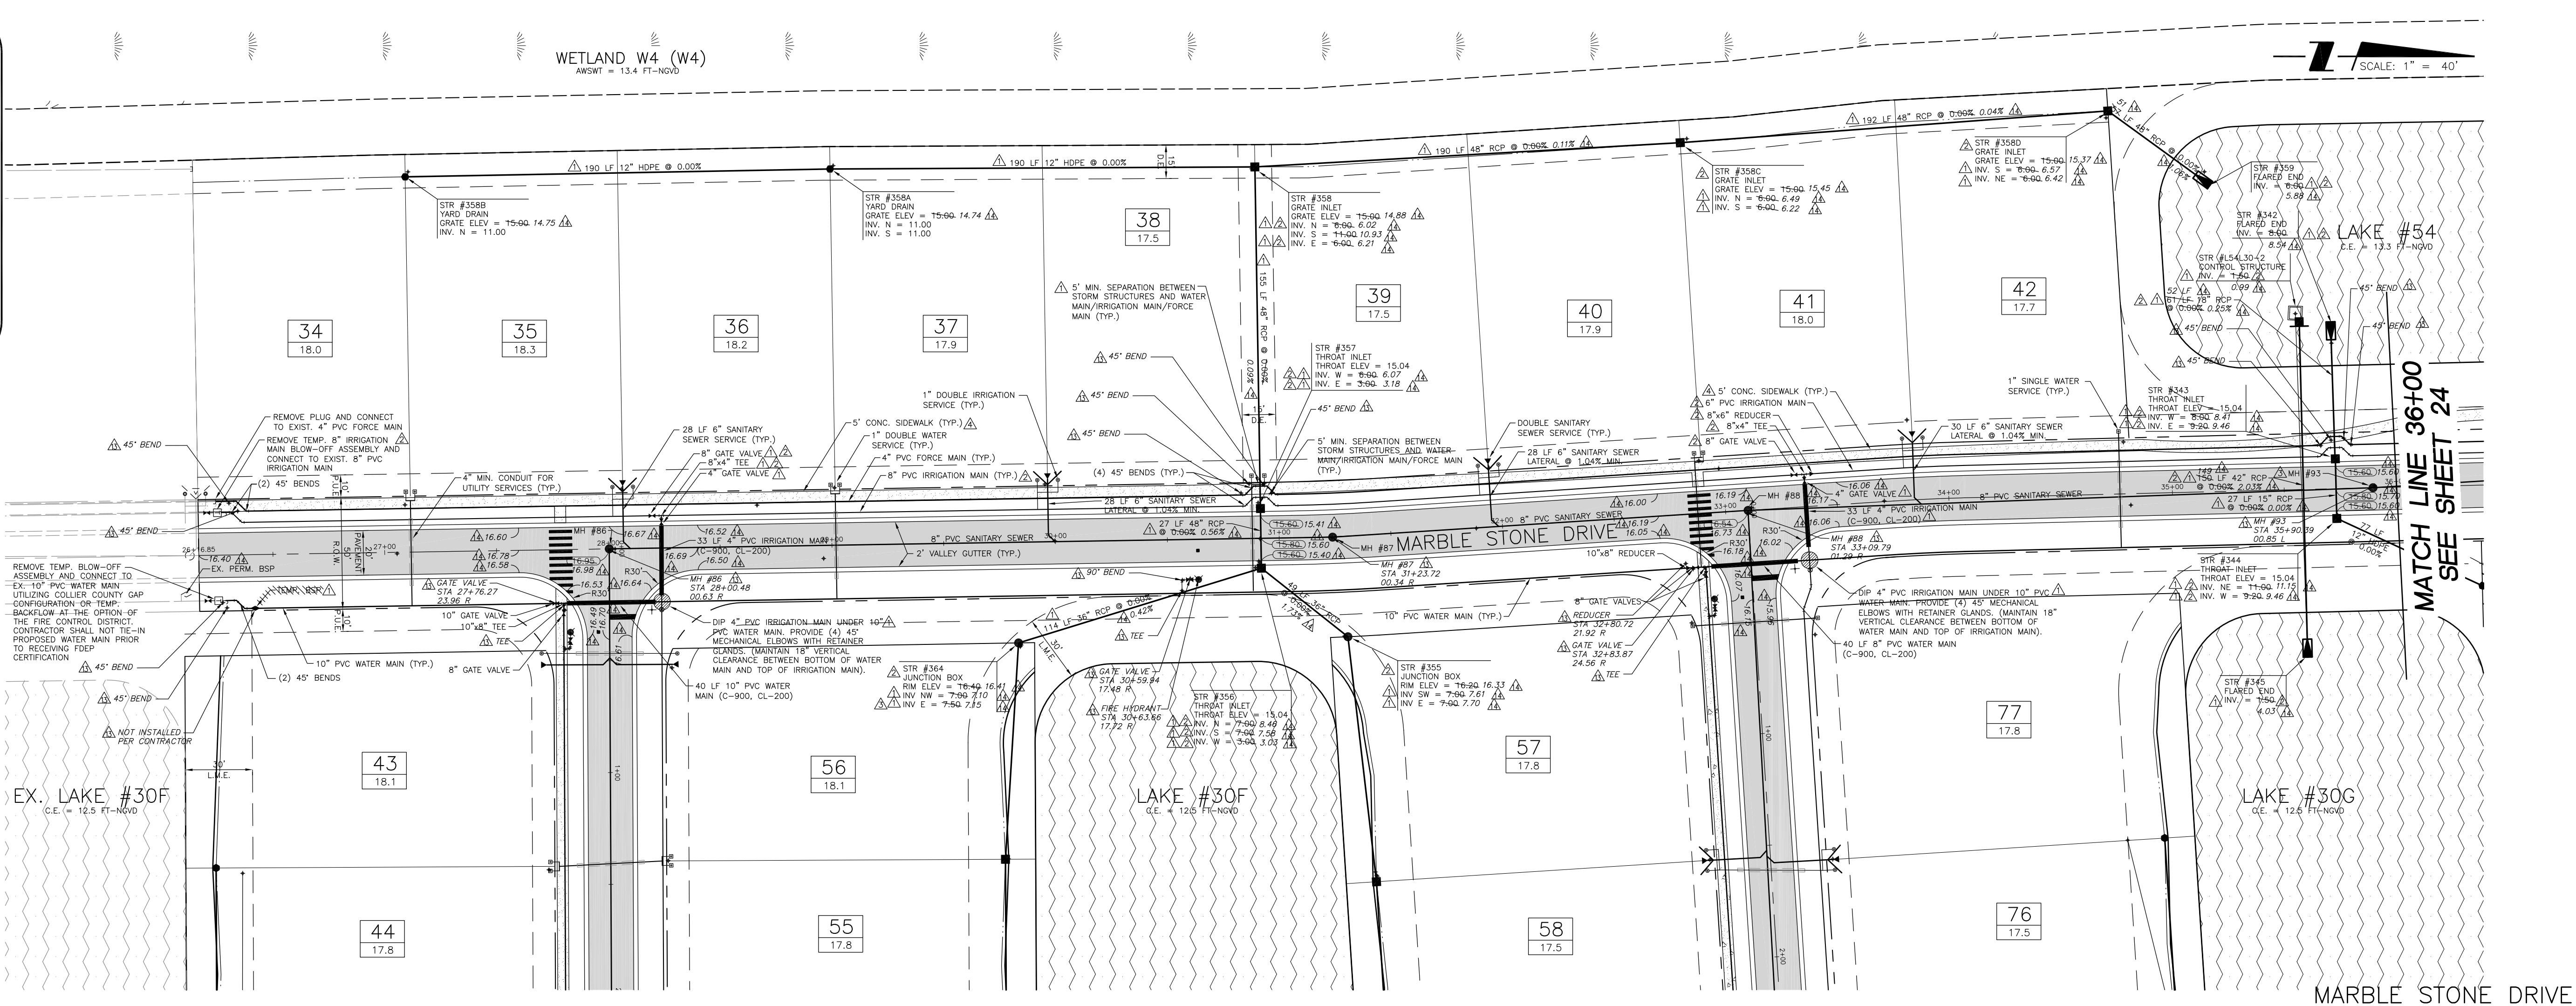
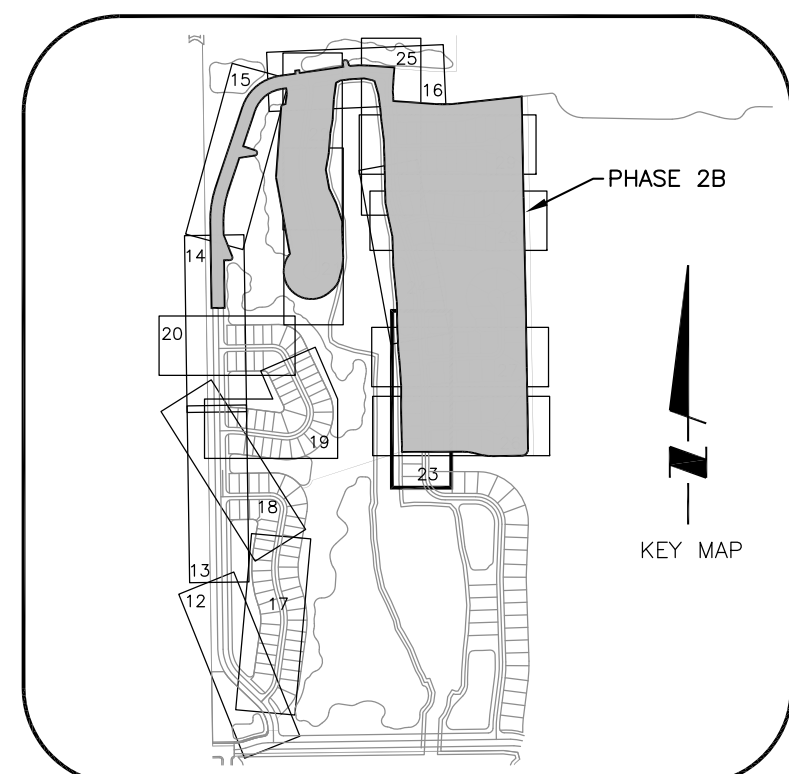




10	REVISED FOR UTILITIES CONVEYANCE	12/14/06	MPO/2348	ACTIVITY	INITIALS/EMP. NO.	DATE	10
4	REVISED FOR INSUBSTANTIAL CHANGE	5/4/06	RRM/1482	DESIGNED BY:	LMG/894	4/15/05	4
3	REVISED PER FDP COMMENTS AND PER ENGINEER	3/22/06	RRM/1482	DRAWN BY:	RRM/1482	4/15/05	3
2	REVISED PER ENGINEER & COUNTY COMMENTS	11/29/05	RRM/1482	CHECKED BY:			2
1	REVISED PER COLLIER COUNTY COMMENTS	9/29/05	RRM/1482	CONTRACT ADMIN. BY:			1
ΔREV NO.	REVISION	Feb. 19, 2008 - 14:27:04	TDAS\VA\X\EN\0442\150-QuarryPhase2\Rev14-rsdPaving&Drainage\044215023.dwg	DATE	DRAWN BY / EMP. NO.	CHECKED BY / EMP. NO.	ΔREV NO.
14	RECORD DRAWING REVISION - PAVING, GRADING, AND DRAINAGE - PHASE 2B	12/14/06	MPO/2348	WM APPROVED BY:			14
13	RECORD DRAWING REVISION - WATER AND SEWER ONLY - PHASE 2B	12/14/06	MPO/2348				13

WilsonMiller

Planners • Engineers • Ecologists • Surveyors • Landscape Architects • Transportation Consultants
 WilsonMiller, Inc.
 Naples • Fort Myers • Sarasota • Bradenton • Tampa • Tallahassee
 4571 Colonial Boulevard, Suite 100 • Fort Myers, Florida 33912 • Phone: 239-939-1020 • Fax: 239-939-3412 • Web-Site: www.wilsonmiller.com

CLIENT:	CENTEX HOMES	DATE:	FEB 2005	TITLE:	PLAN AND PROFILE
PROJECT:	THE QUARRY PHASE 2	HORIZONTAL SCALE:	1" = 40'		MARBLE STONE DRIVE
		VERTICAL SCALE:	1" = 4'		STA. 26+16.85 TO STA. 36+00
		CROSS REFERENCE FILE NO.:	D-0442-48	PROJECT NUMBER:	N0442-509-000
		SHEET NUMBER:	23 OF 38	INDEX NUMBER:	D-0442-150

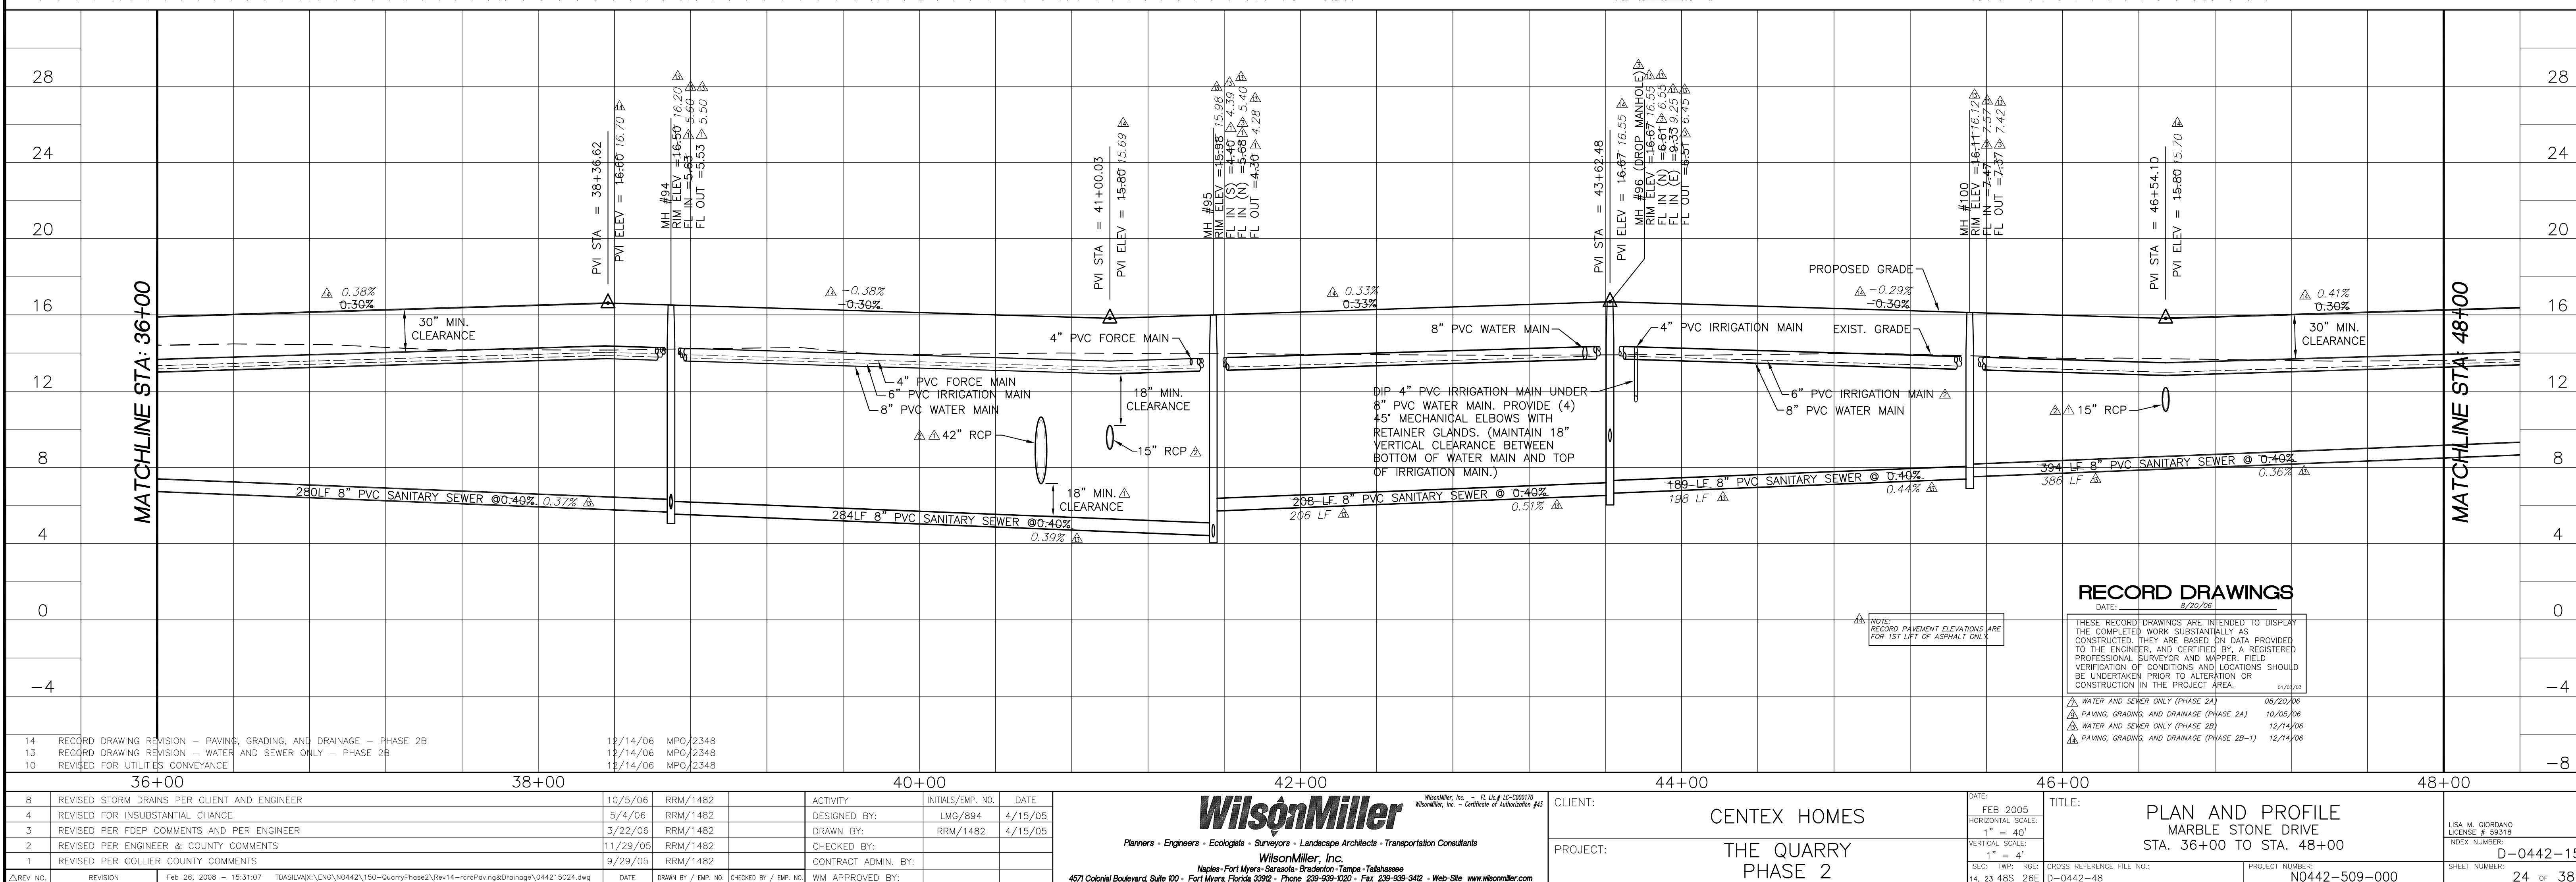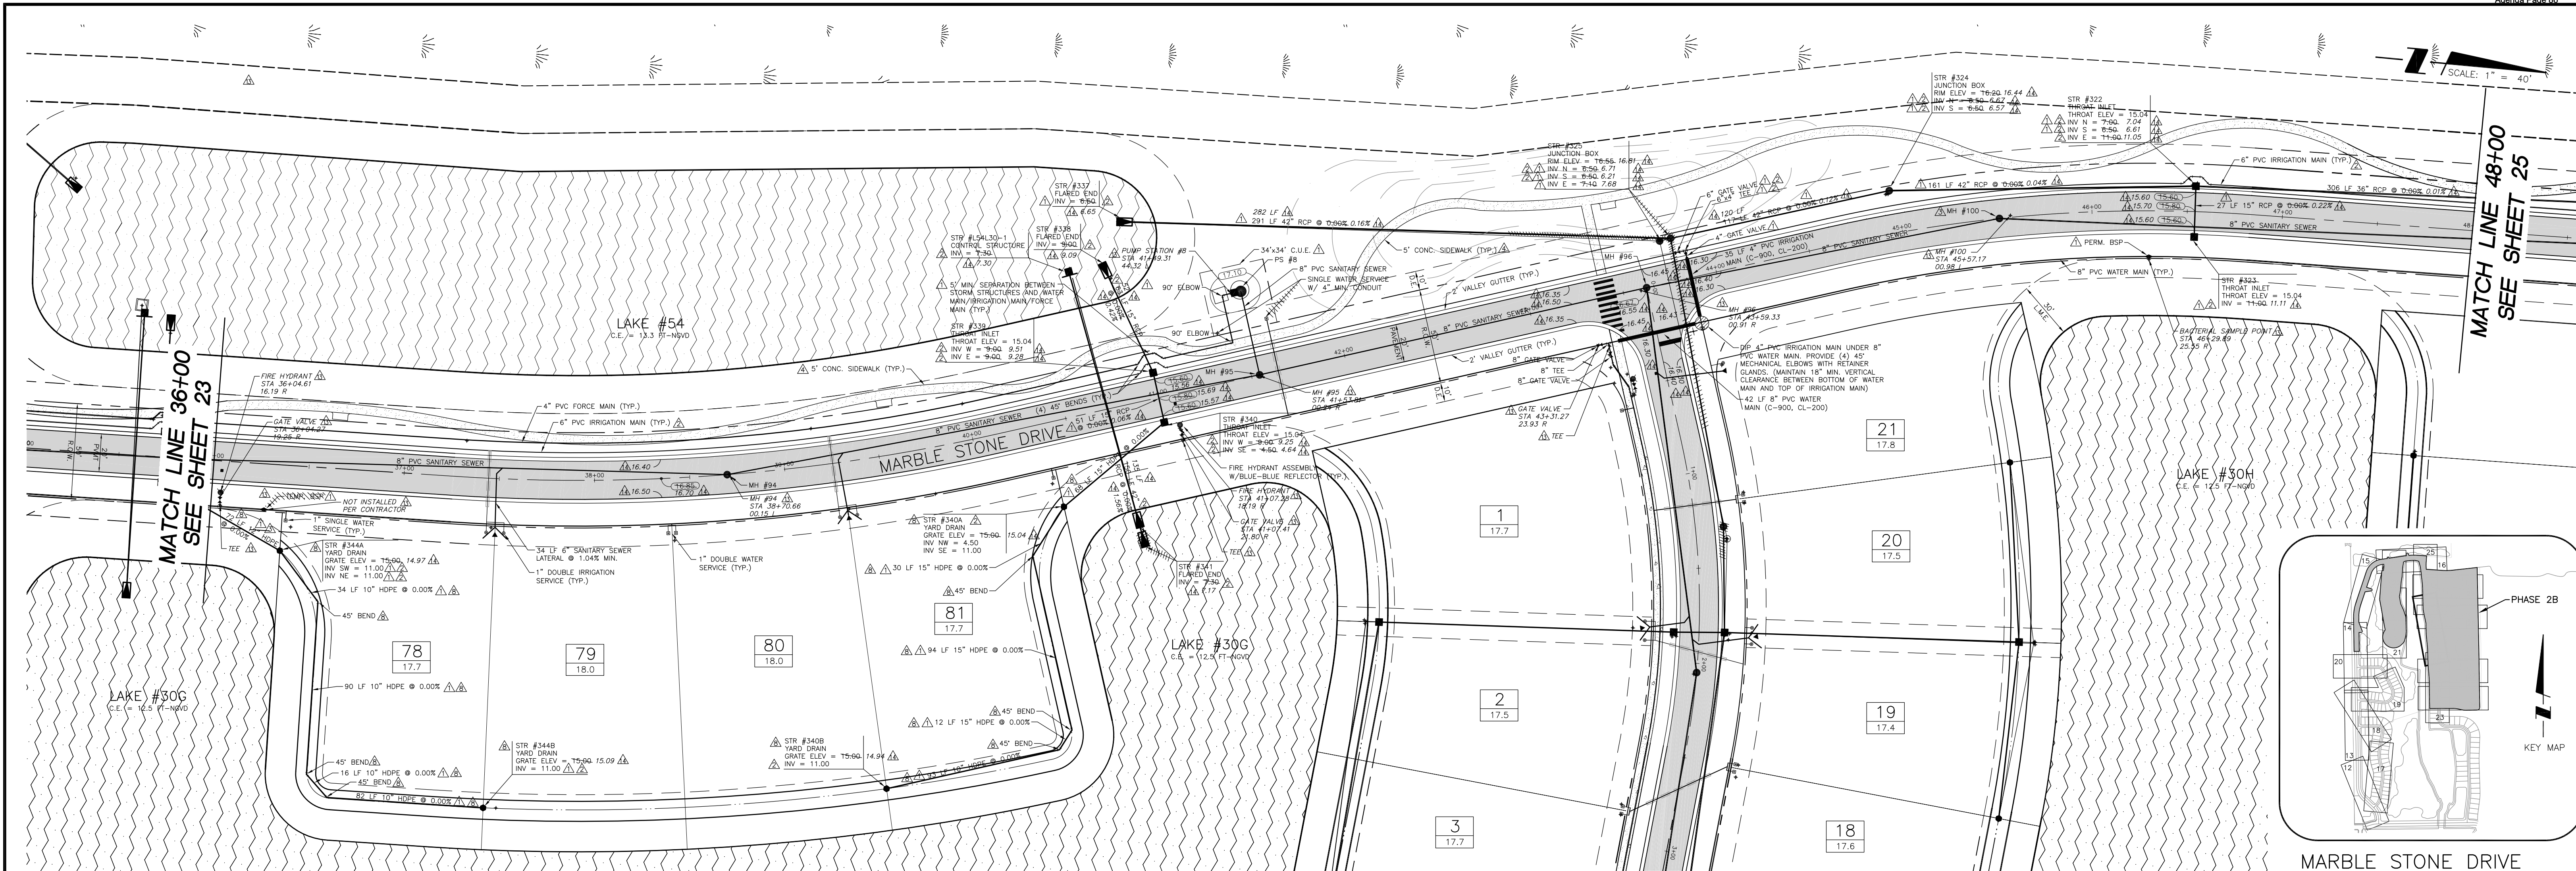

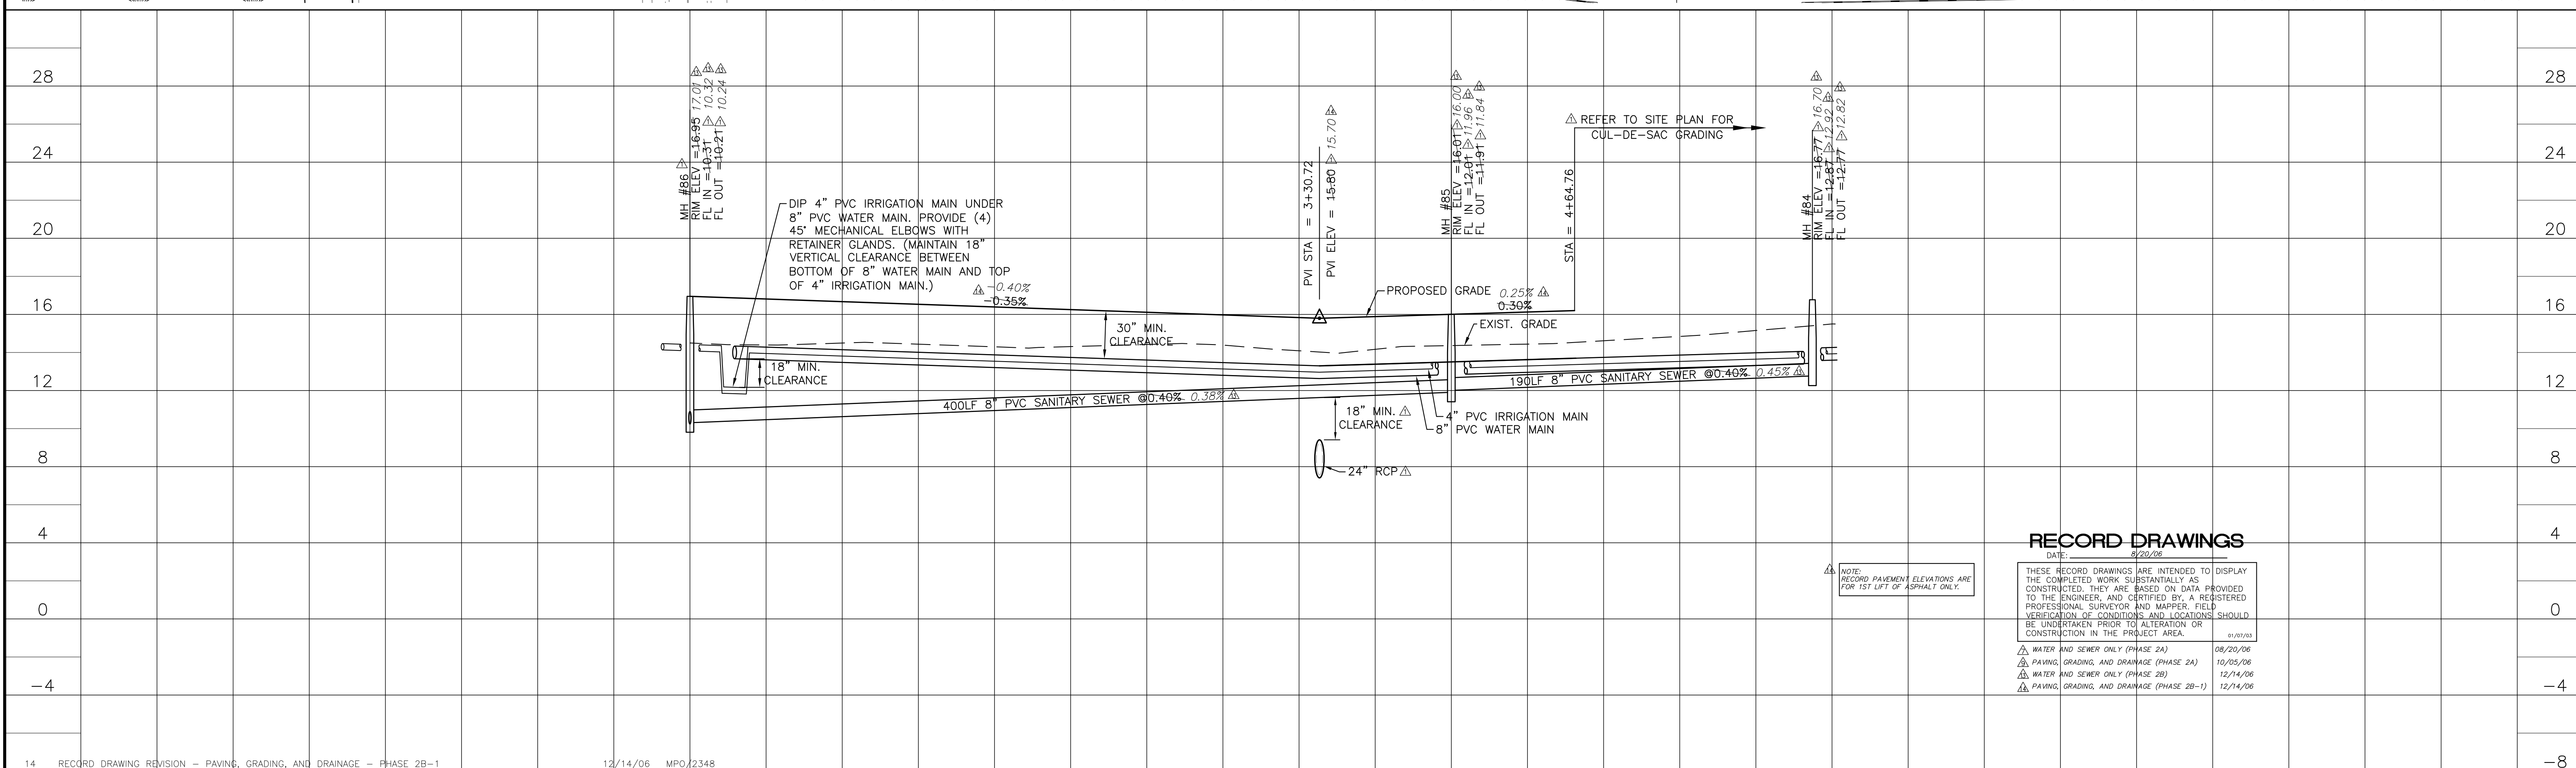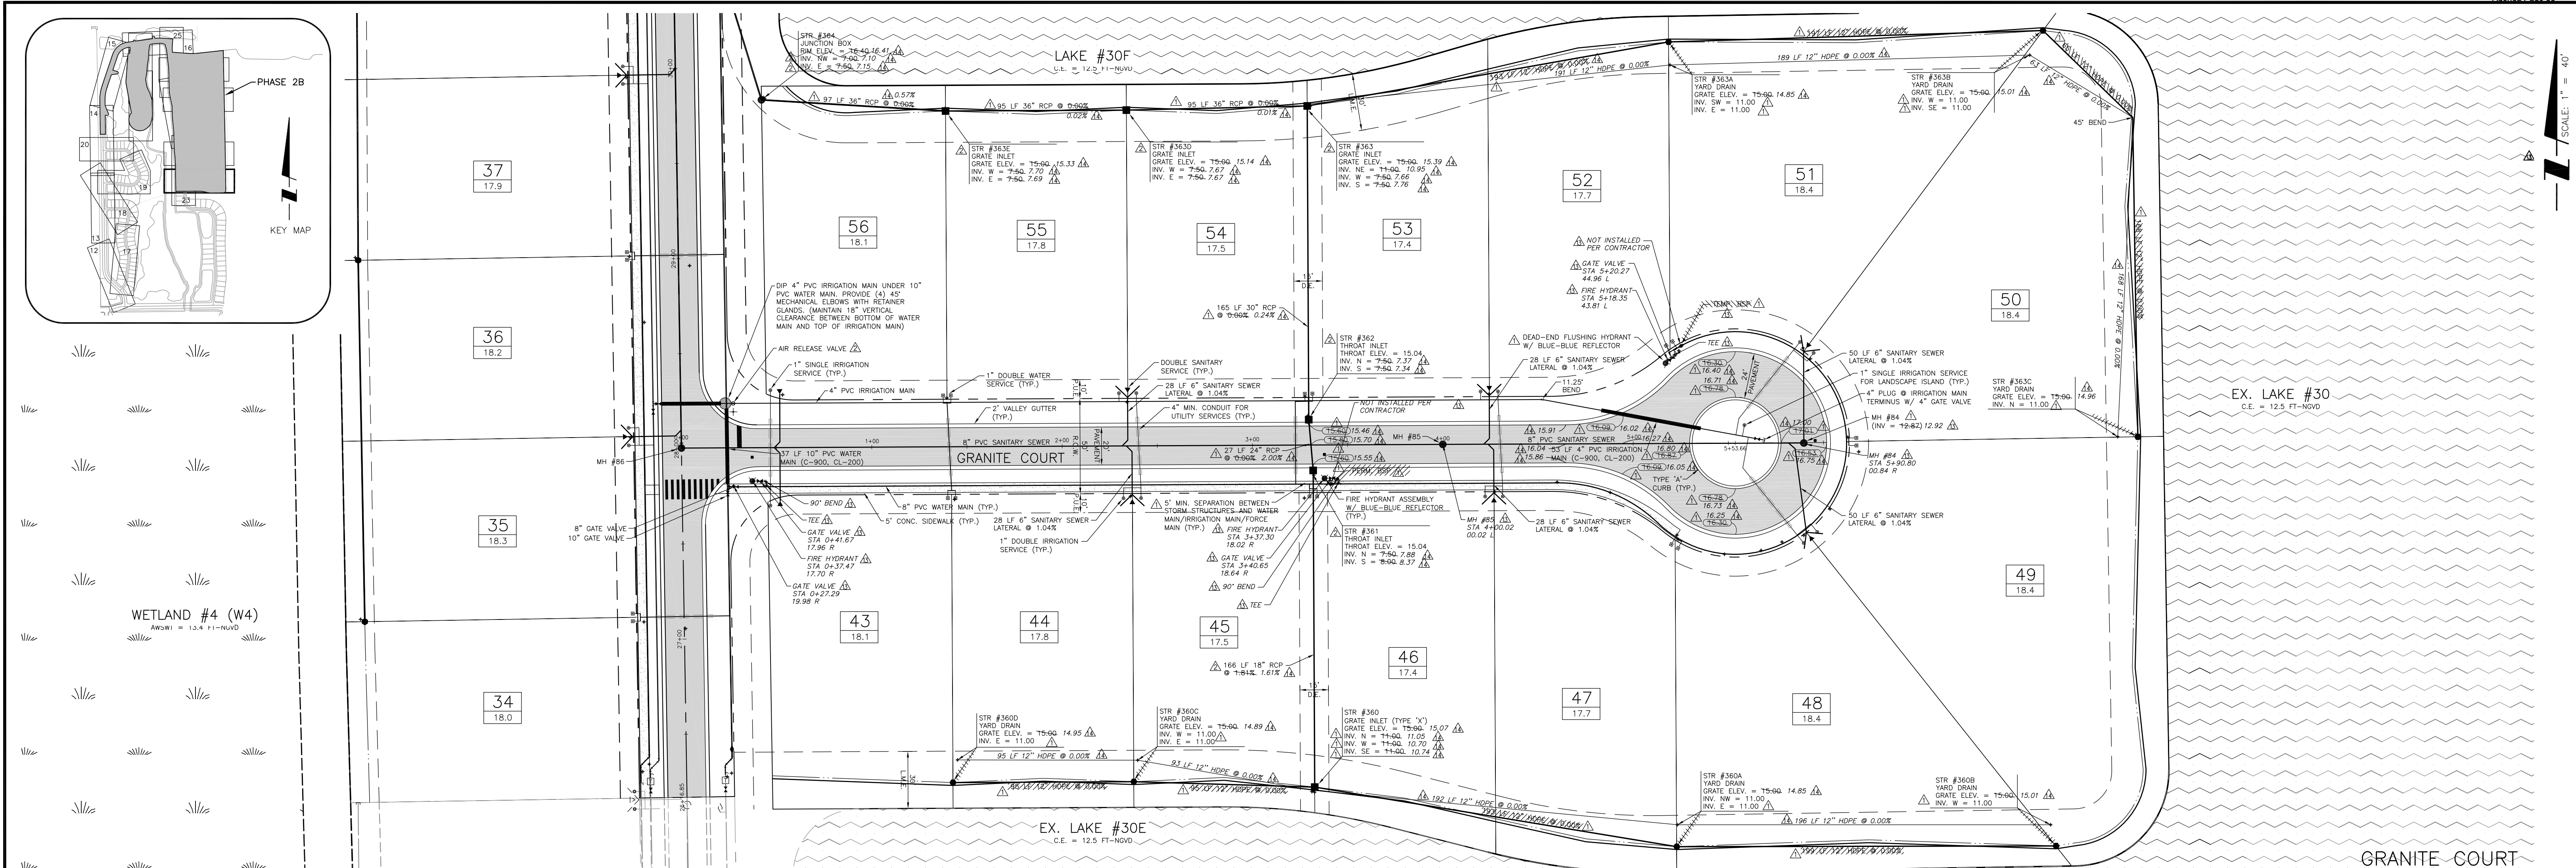

14	RECORD DRAWING REVISION - PAVING, GRADING, AND DRAINAGE - PHASE 2B-1	12/14/06	MPO/2348	0+00	2+00	4+00	6+00
13	RECORD DRAWING REVISION - WATER AND SEWER ONLY - PHASE 2B	12/14/06	MPO/2348	ACTIVITY	INITIALS/EMP. NO.	DATE	
10	REVISED FOR UTILITIES CONVEYANCE	12/14/06	MPO/2348	DESIGNED BY:	LMG/894	4/15/05	
4	REVISED FOR INSUBSTANTIAL CHANGE	5/4/06	RRM/1482	DRAWN BY:	RRM/1482	4/15/05	
2	REVISED PER ENGINEER & COUNTY COMMENTS	11/29/05	RRM/1482	CHECKED BY:			
1	REVISED PER COLLIER COUNTY COMMENTS	9/28/05	RRM/1482	CONTRACT ADMIN. BY:			
ΔREV NO.	REVISION	Feb 19, 2008 -- 14:44:05	TDASILVAK\JENS\N0442\150-QuarryPhase2\Rev14-wcrd\paving&Drainage\0442150026.dwg	DATE	DRAWN BY / EMP. NO.	CHECKED BY / EMP. NO.	WM APPROVED BY:

WilsonMiller
Planners • Engineers • Ecologists • Surveyors • Landscape Architects • Transportation Consultants


WilsonMiller, Inc.
Naples • Fort Myers • Sarasota • Bradenton • Tampa • Tallahassee
457 Colonial Boulevard Suite 100 • Fort Myers, Florida 33902 • Phone: 239-939-1202 • Fax: 239-939-3412 • Web Site: www.wilsonmiller.com

CLIENT:	CENTEX HOMES
PROJECT:	THE QUARRY PHASE 2


DATE:	FEB 2005
HORIZONTAL SCALE:	1" = 40'
VERTICAL SCALE:	1" = 4'
SEC. TWP. RGE.	14, 23 48S 26E
CROSS REFERENCE FILE NO.:	D-0442-48



TITLE:	PLAN AND PROFILE GRANITE COURT STA. 0+00 TO END
PROJECT NUMBER:	N0442-509-000
SHEET NUMBER:	26 OF 38


LISA M. GORDANO LICENSE # 59318	D-0442-150
------------------------------------	------------

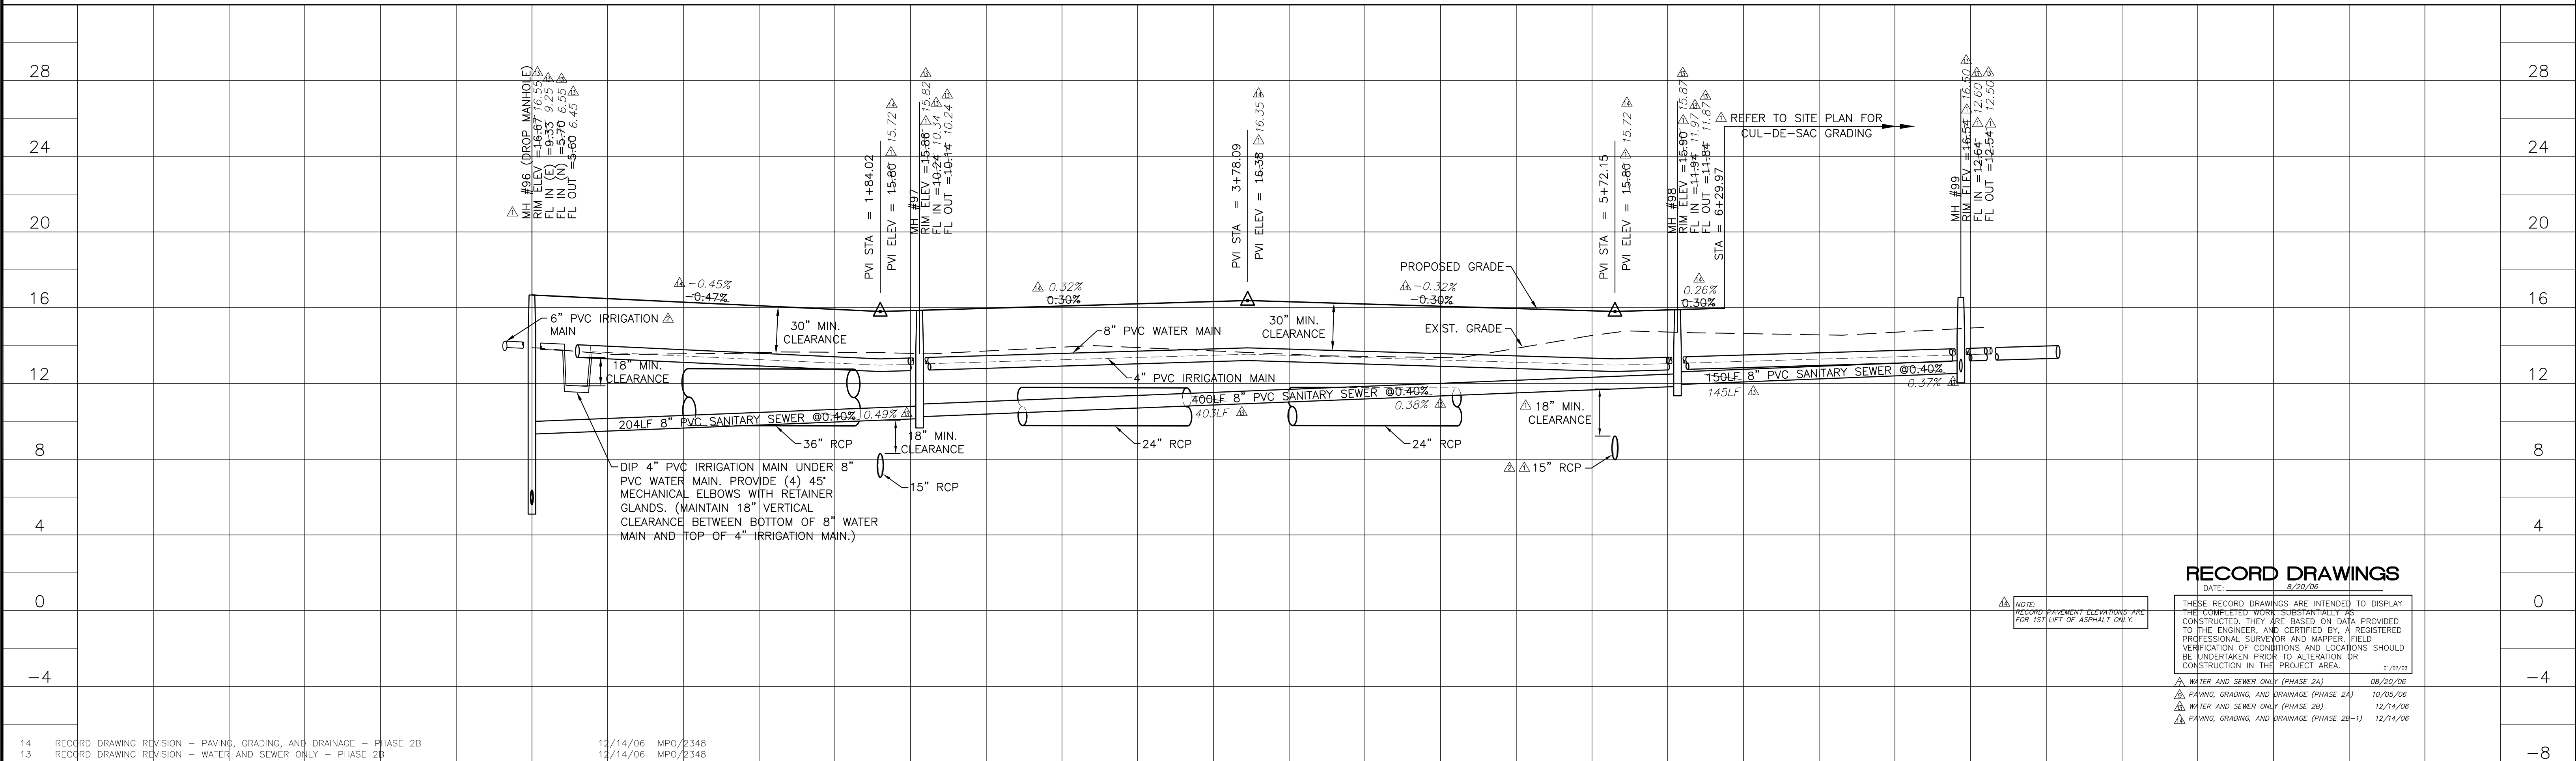

0+00										2+00										4+00										6+00										8+00																																																										
10	REVISED FOR UTILITIES CONVEYANCE				12/14/06	MPO/2348		ACTIVITY	INITIALS/EMP. NO.	DATE	<div><div><div>WilsonMiller, Inc. - FL L&E LC-000770</div><div>WilsonMiller, Inc. - Certificate of Authorization #43</div></div><div><div>CLIENT:</div><div>CENTEX HOMES</div></div><div><div>PROJECT:</div><div>THE QUARRY PHASE 2</div></div><div><div>DATE:</div><div>FEB 2005</div></div><div><div>TITLE:</div><div>PLAN AND PROFILE COPPER CANYON COURT STA. 0+00 TO END</div></div><div><div>LISA M. GIORIANO LICENSE # 59316 INDEX NUMBER:</div><div>D-0442-150</div></div></div> <tr><td>5</td><td colspan="4">REVISED PER ENGINEER & OWNER</td><td>6/3/06</td><td>RRM/1482</td><td></td><td>DESIGNED BY:</td><td>LMG/894</td><td>4/15/05</td></tr> <tr><td>4</td><td colspan="4">REVISED FOR INSUBSTANTIAL CHANGE</td><td>5/4/06</td><td>RRM/1482</td><td></td><td>DRAWN BY:</td><td>RRM/1482</td><td>4/15/05</td></tr> <tr><td>2</td><td colspan="4">REVISED PER ENGINEER & COUNTY COMMENTS</td><td>11/29/05</td><td>RRM/1482</td><td></td><td>CHECKED BY:</td><td></td><td></td></tr> <tr><td>1</td><td colspan="4">REVISED PER COLLIER COUNTY COMMENTS</td><td>9/29/05</td><td>RRM/1482</td><td></td><td>CONTRACT ADMIN. BY:</td><td></td><td></td></tr> <tr><td>Δ</td><td>REV. NO.</td><td>REVISION</td><td colspan="2">Feb 07, 2008 - 15:40:04</td><td colspan="2">TMSL\AD\X\EN\N0442\150-QuarryPhase2\Rev14-mcrrdPaving&Drainage\044215028.dwg</td><td>DATE</td><td>DRAWN BY / EMP. NO.</td><td>CHECKED BY / EMP. NO.</td><td>WM APPROVED BY:</td><td colspan="2">CROSS REFERENCE FILE NO.</td><td colspan="2">PROJECT NUMBER:</td><td colspan="2">SHEET NUMBER:</td></tr> <tr><td></td><td></td><td></td><td colspan="2"></td><td colspan="2"></td><td></td><td></td><td></td><td></td><td colspan="2">D-0442-48</td><td colspan="2">N0442-509-000</td><td colspan="2">28 OF 38</td></tr>										5	REVISED PER ENGINEER & OWNER				6/3/06	RRM/1482		DESIGNED BY:	LMG/894	4/15/05	4	REVISED FOR INSUBSTANTIAL CHANGE				5/4/06	RRM/1482		DRAWN BY:	RRM/1482	4/15/05	2	REVISED PER ENGINEER & COUNTY COMMENTS				11/29/05	RRM/1482		CHECKED BY:			1	REVISED PER COLLIER COUNTY COMMENTS				9/29/05	RRM/1482		CONTRACT ADMIN. BY:			Δ	REV. NO.	REVISION	Feb 07, 2008 - 15:40:04		TMSL\AD\X\EN\N0442\150-QuarryPhase2\Rev14-mcrrdPaving&Drainage\044215028.dwg		DATE	DRAWN BY / EMP. NO.	CHECKED BY / EMP. NO.	WM APPROVED BY:	CROSS REFERENCE FILE NO.		PROJECT NUMBER:		SHEET NUMBER:													D-0442-48		N0442-509-000		28 OF 38	
5	REVISED PER ENGINEER & OWNER				6/3/06	RRM/1482		DESIGNED BY:	LMG/894	4/15/05																																																																																								
4	REVISED FOR INSUBSTANTIAL CHANGE				5/4/06	RRM/1482		DRAWN BY:	RRM/1482	4/15/05																																																																																								
2	REVISED PER ENGINEER & COUNTY COMMENTS				11/29/05	RRM/1482		CHECKED BY:																																																																																										
1	REVISED PER COLLIER COUNTY COMMENTS				9/29/05	RRM/1482		CONTRACT ADMIN. BY:																																																																																										
Δ	REV. NO.	REVISION	Feb 07, 2008 - 15:40:04		TMSL\AD\X\EN\N0442\150-QuarryPhase2\Rev14-mcrrdPaving&Drainage\044215028.dwg		DATE	DRAWN BY / EMP. NO.	CHECKED BY / EMP. NO.	WM APPROVED BY:	CROSS REFERENCE FILE NO.		PROJECT NUMBER:		SHEET NUMBER:																																																																																			
											D-0442-48		N0442-509-000		28 OF 38																																																																																			

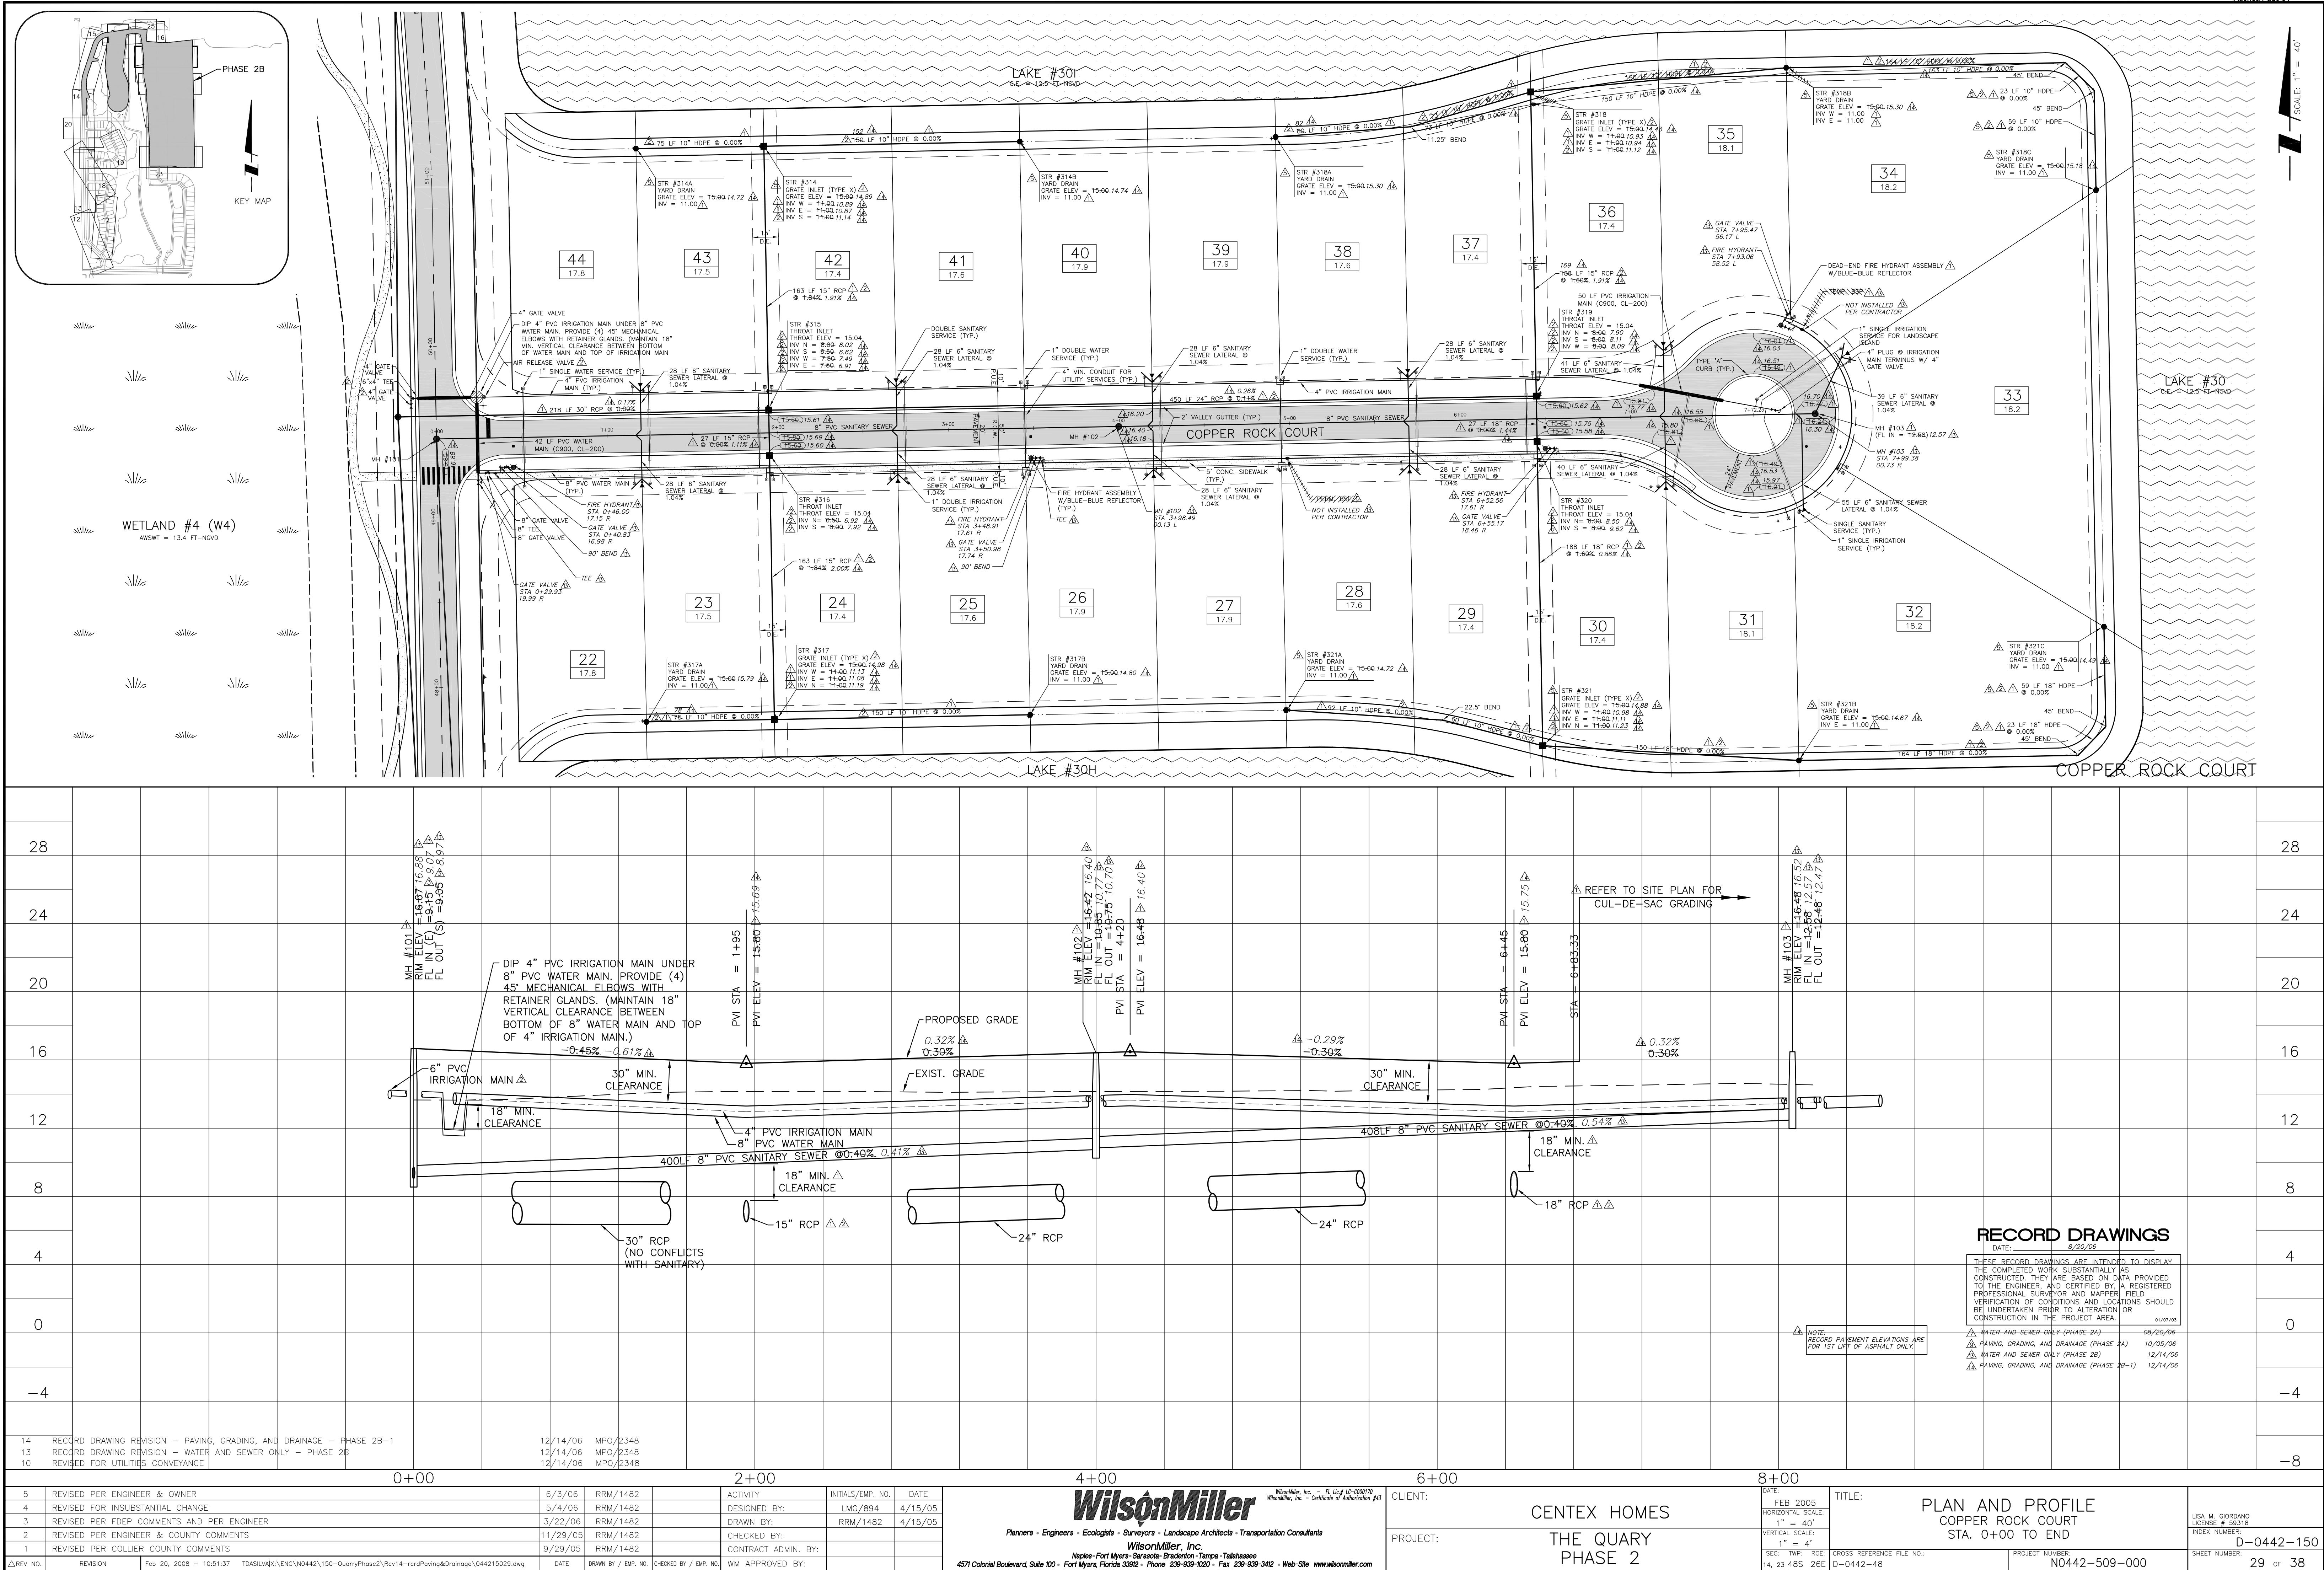


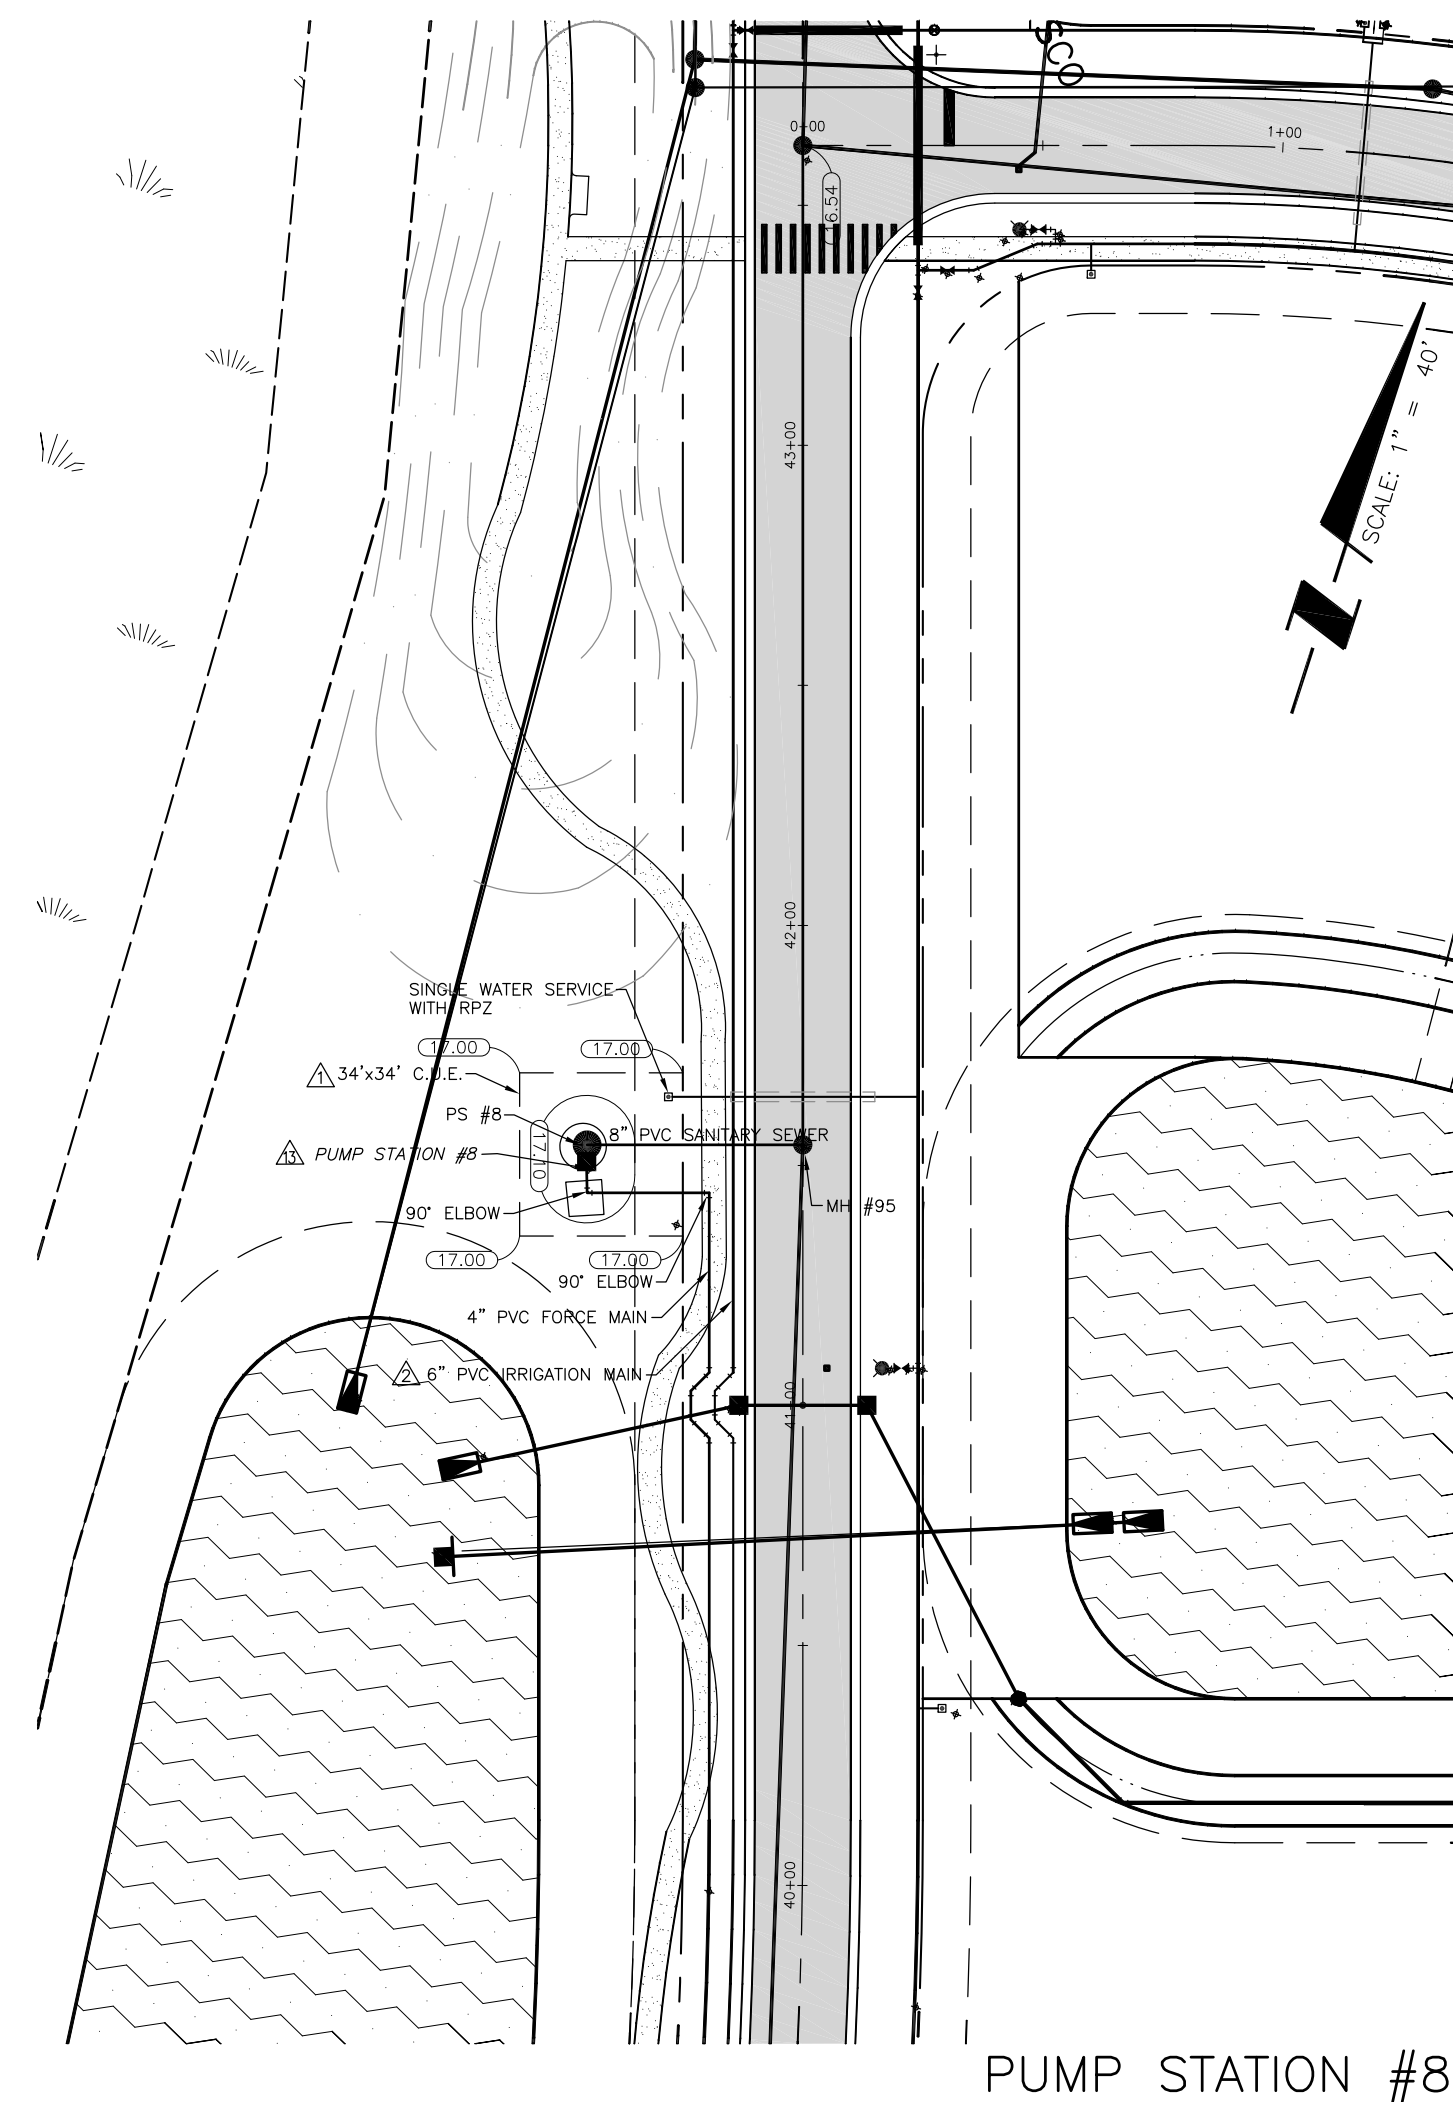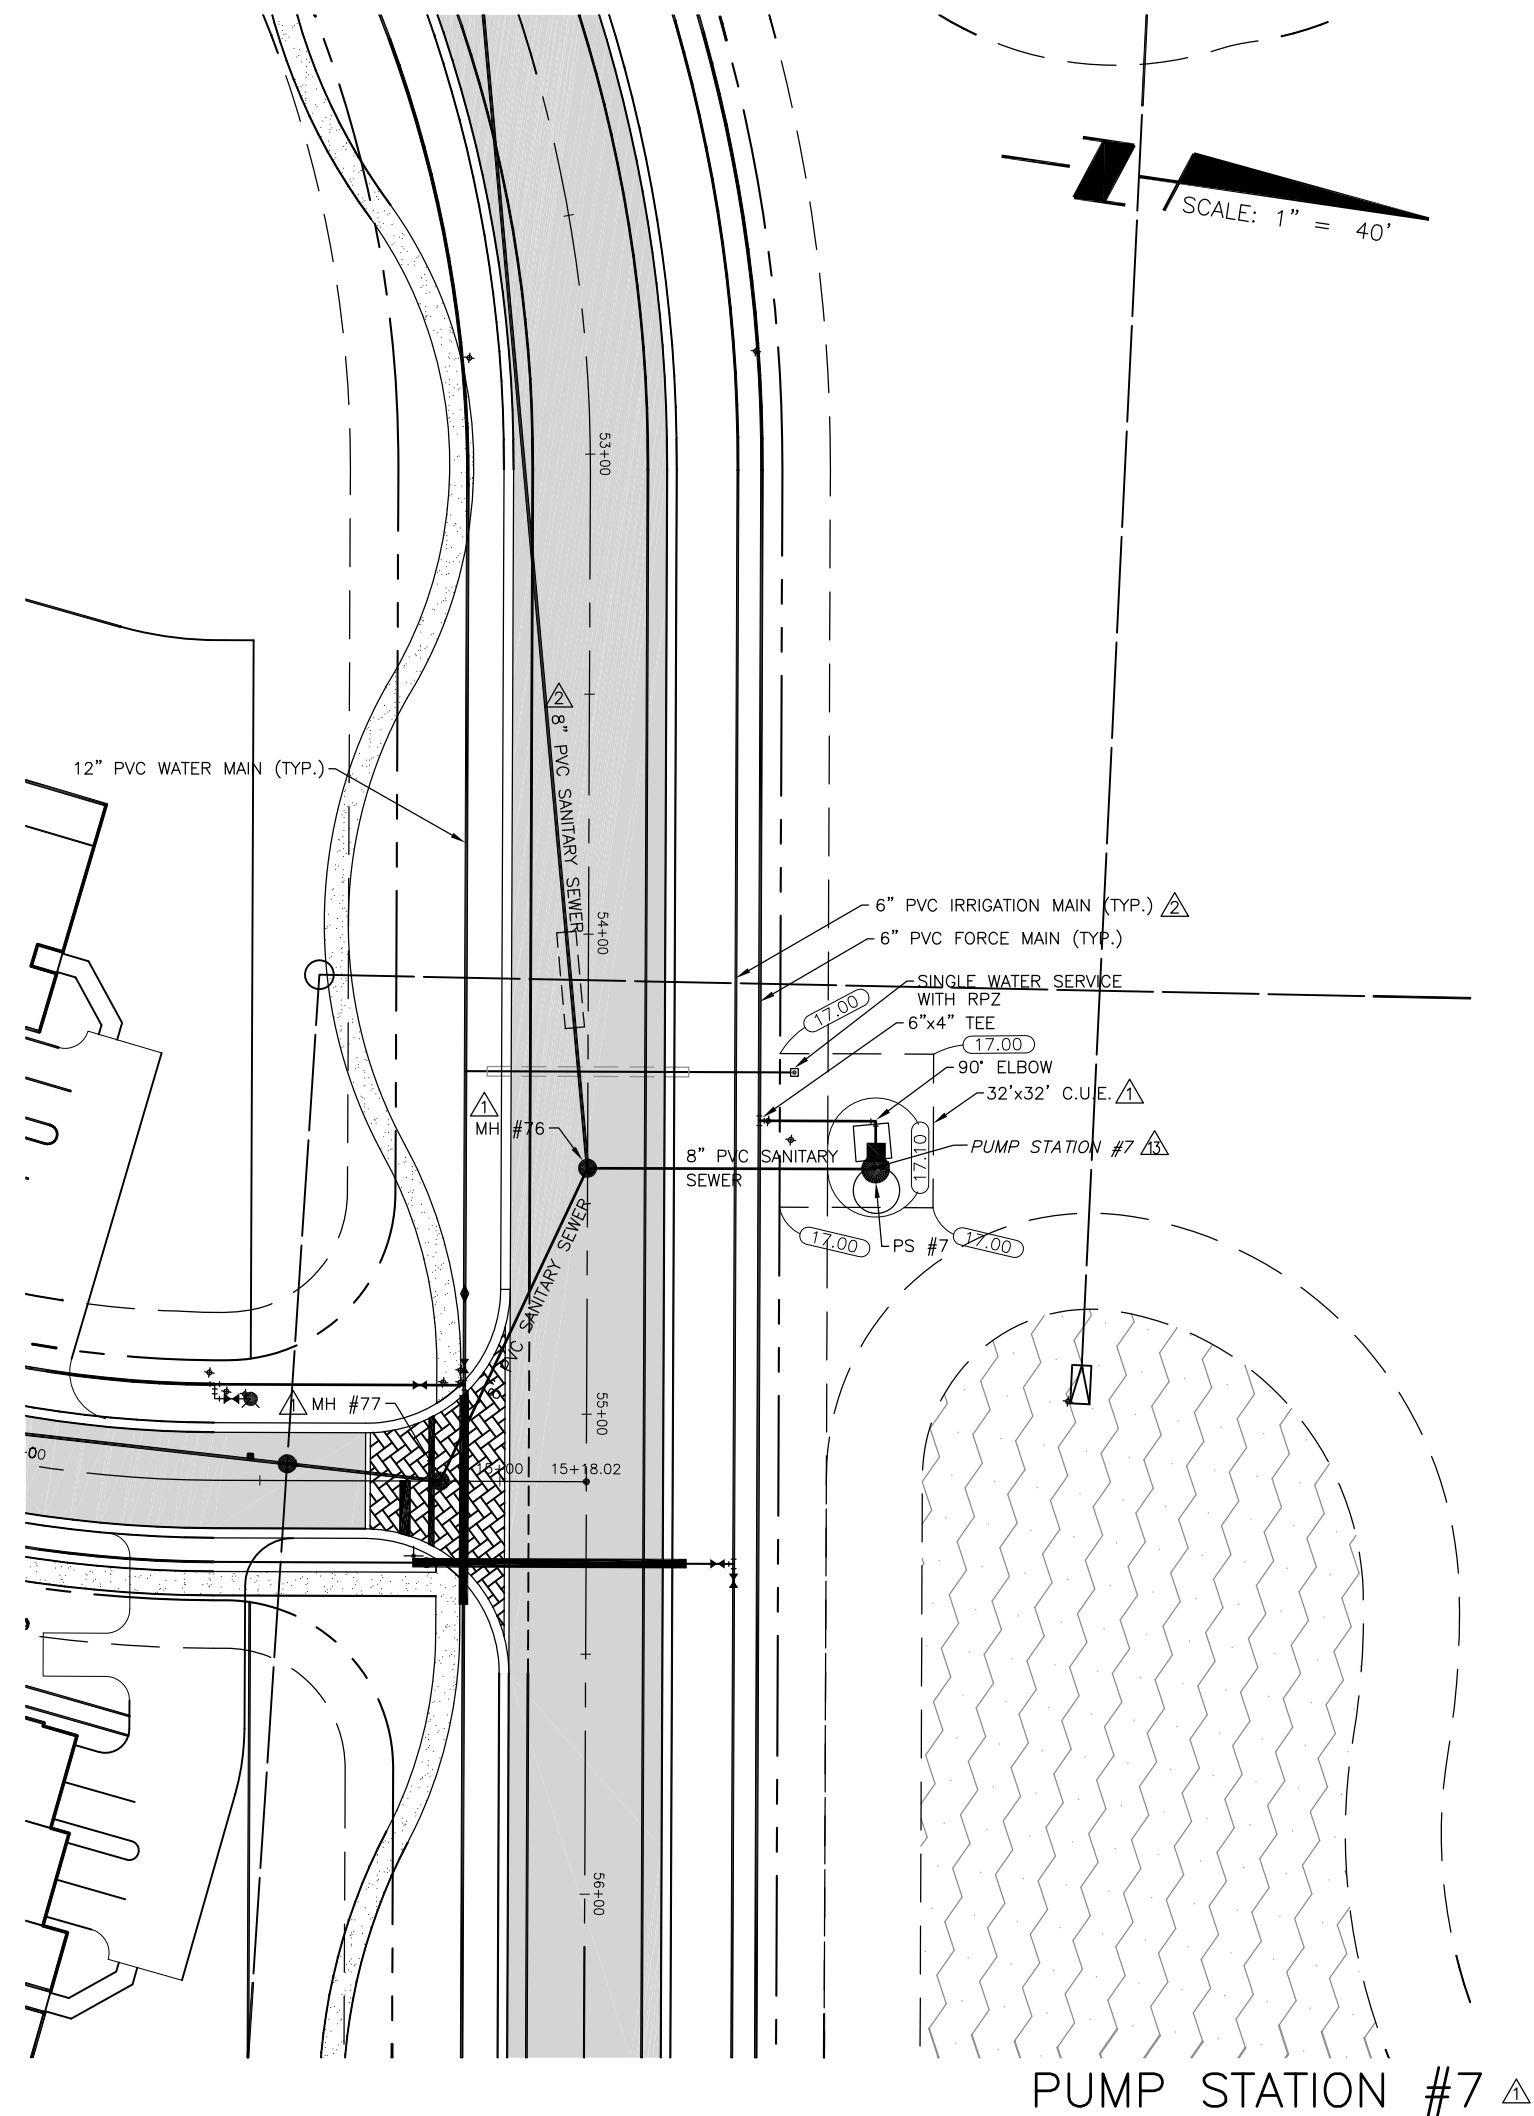[illegible]

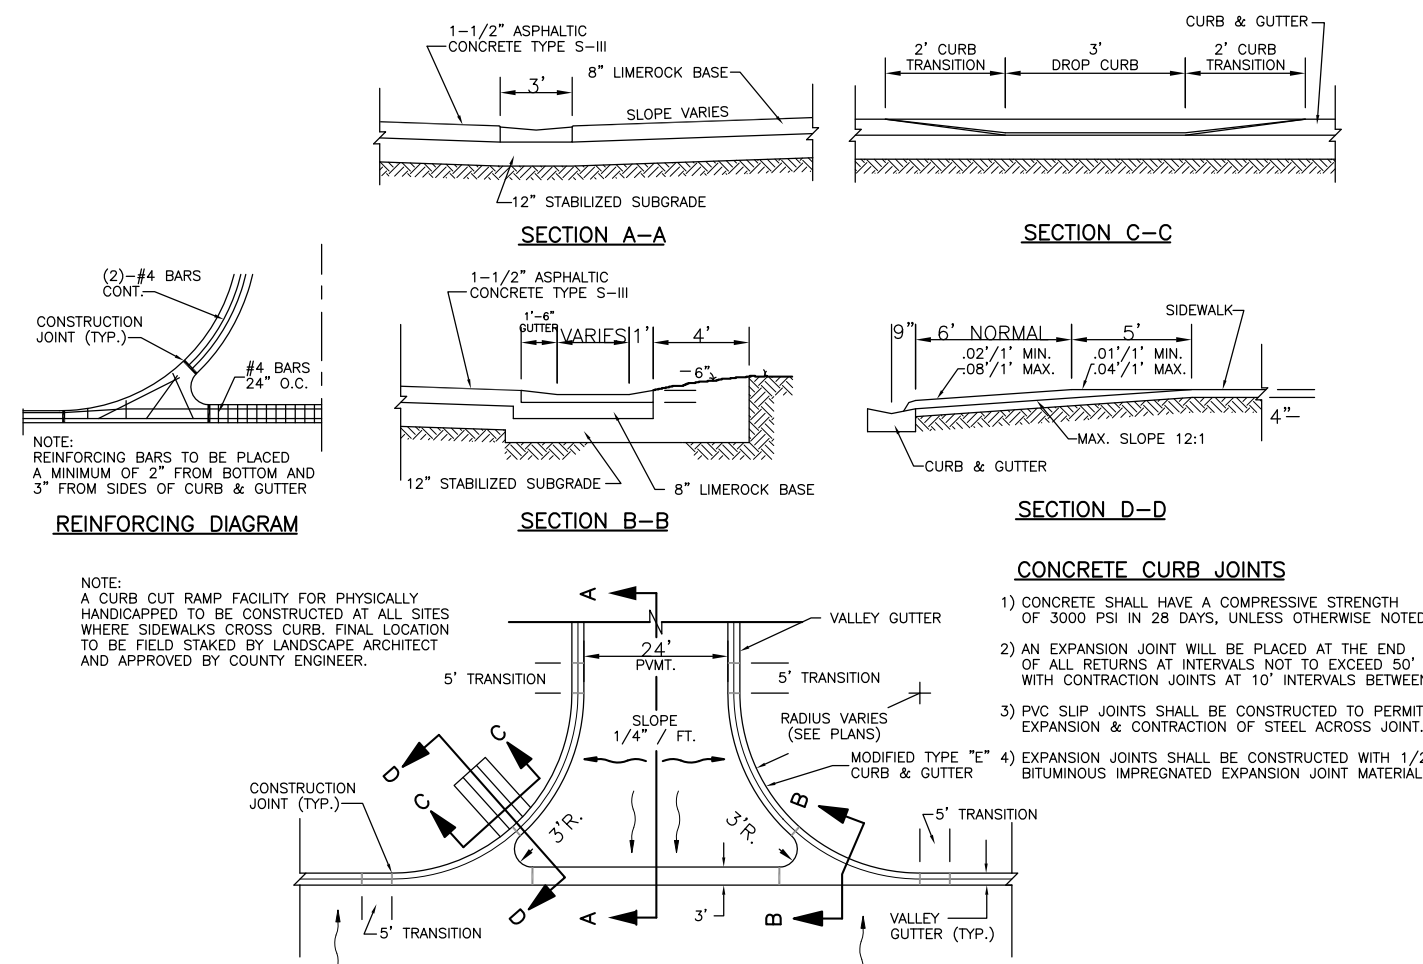


TYPICAL VALLEY CROSSING DETAIL (VALLEY GUTTER) N.T.S.



ADA COMPLIANT CURB RAMP CONFIGURATION FOR VALLEY GUTTER N.T.S.

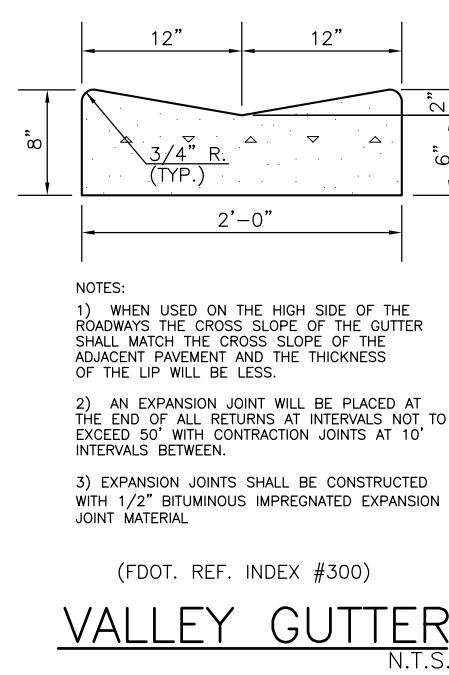


VALLEY GUTTER N.T.S.

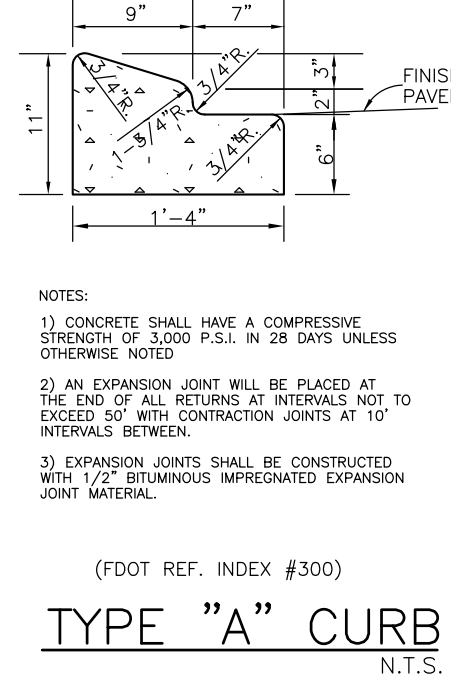


TYPE "A" CURB N.T.S.

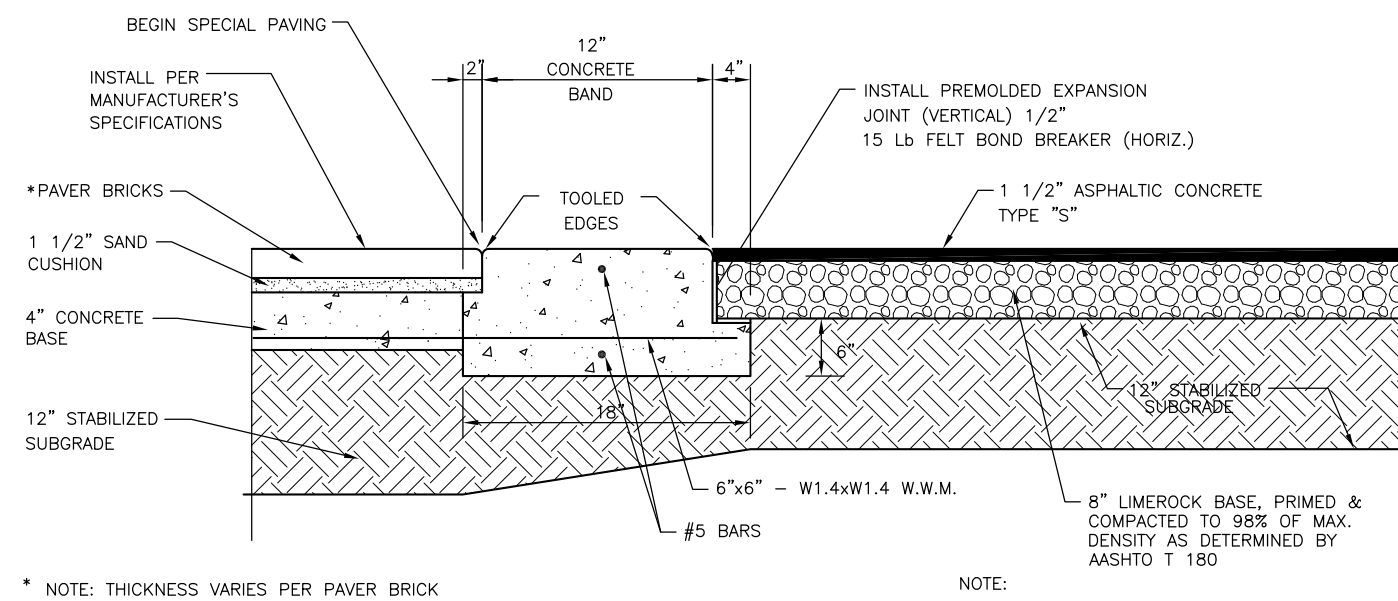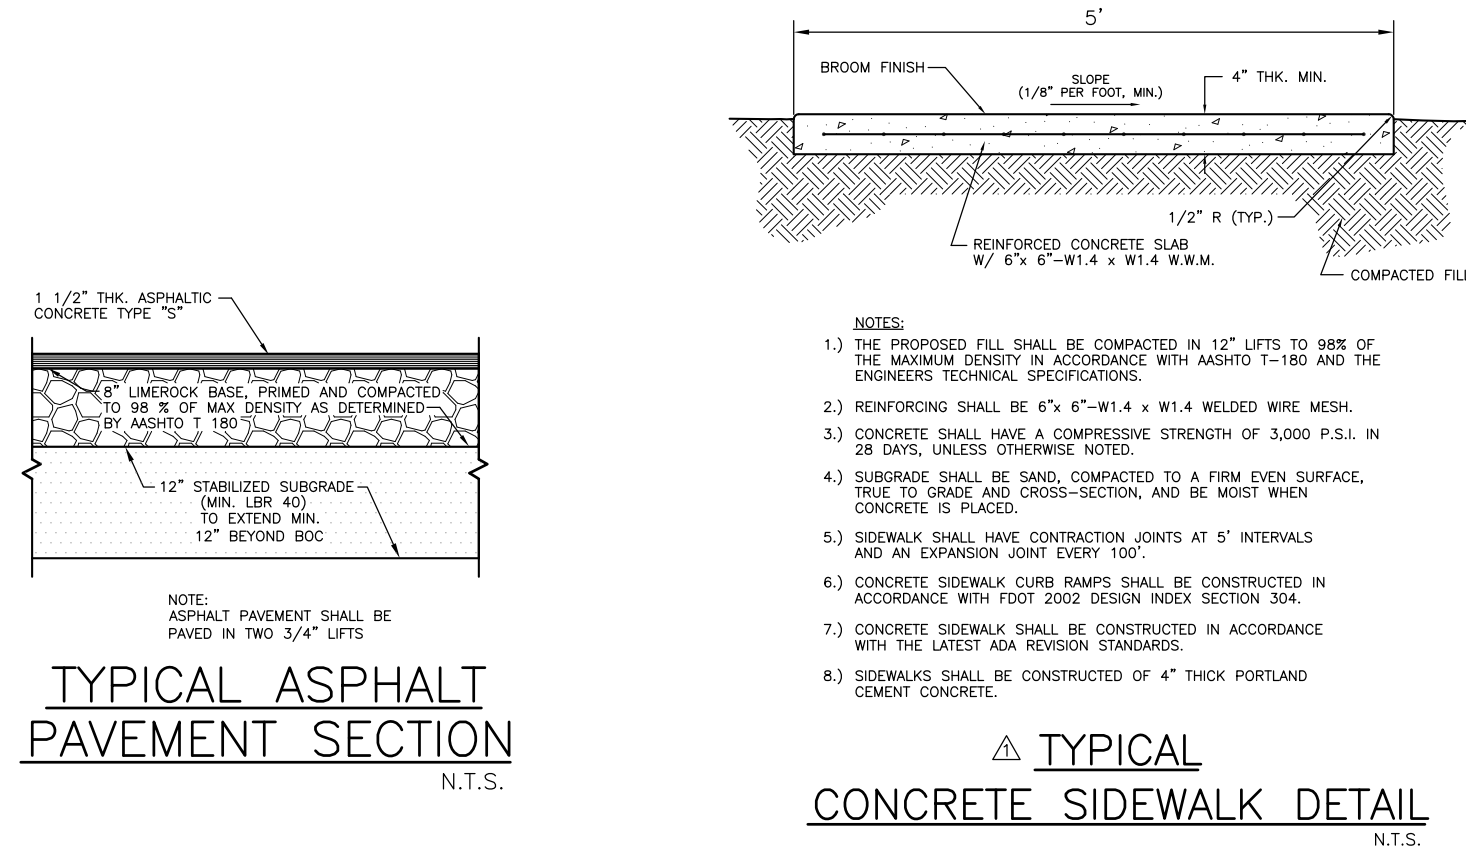

CONCRETE RIBBON AND PAVER BRICK INTERFACE EDGE RESTRAINT DETAIL N.T.S.

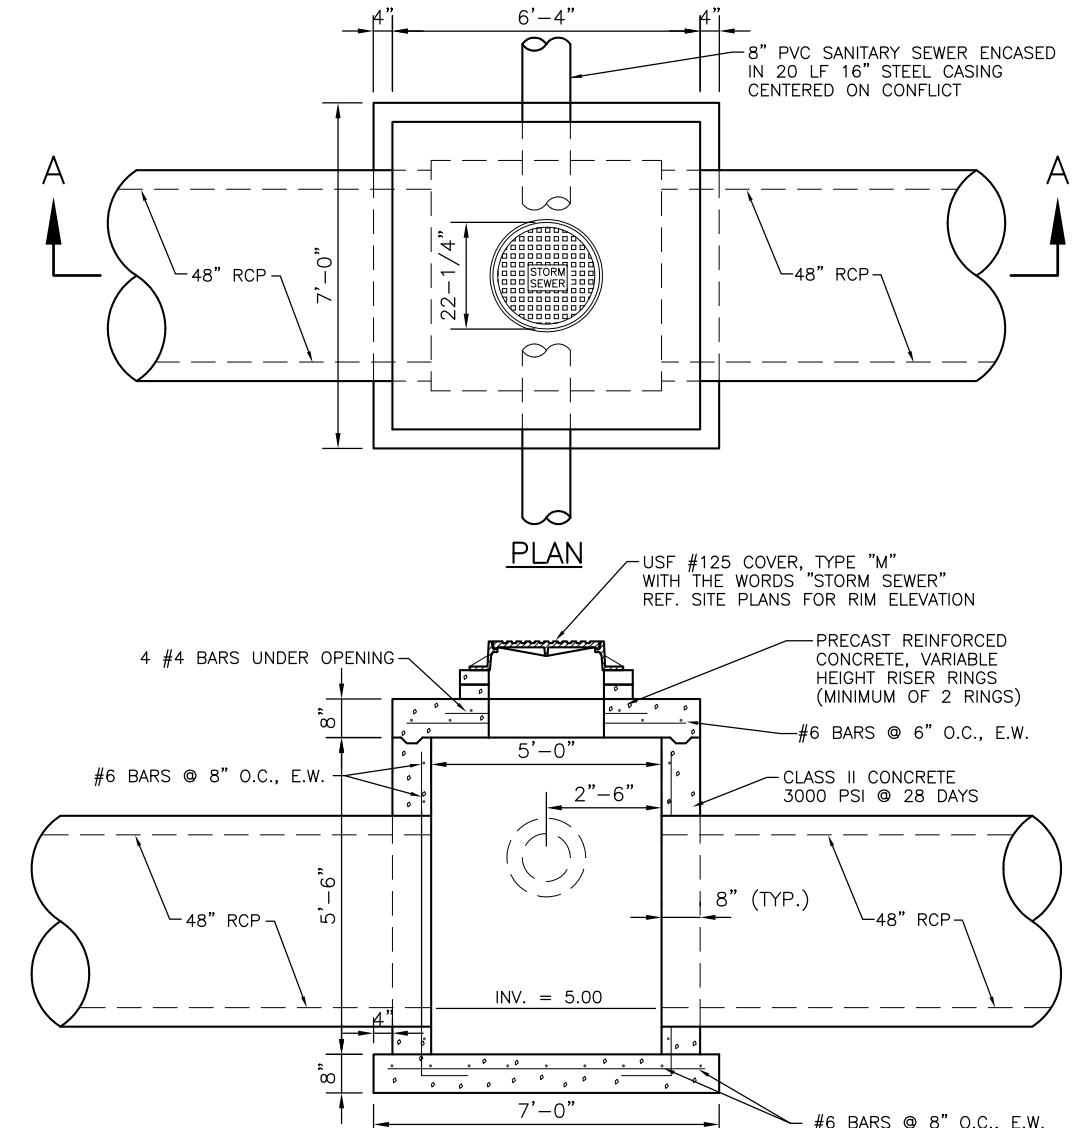


CONFLICT BOX N.T.S.

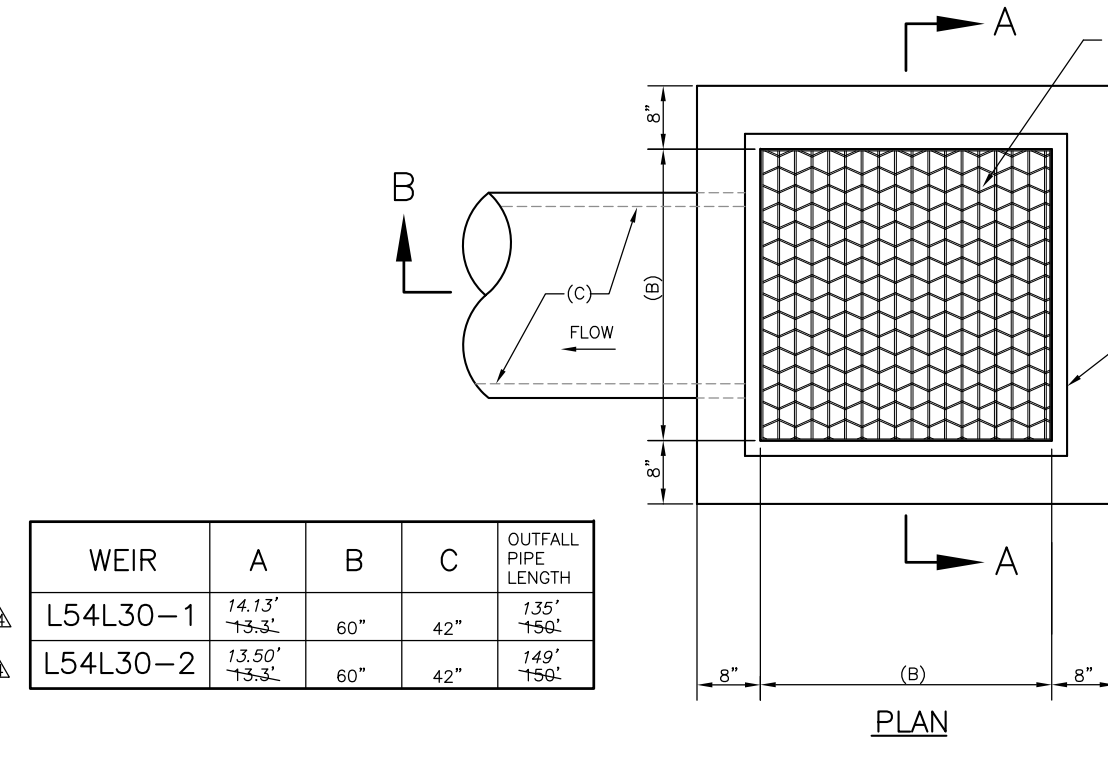


WEIR	A	B	C	OUTFALL PIPE LENGTH
L54L30-1	14.13" 73.3%	60"	42"	155"
L54L30-2	13.50" 73.3%	60"	42"	149"


WEIR N.T.S.

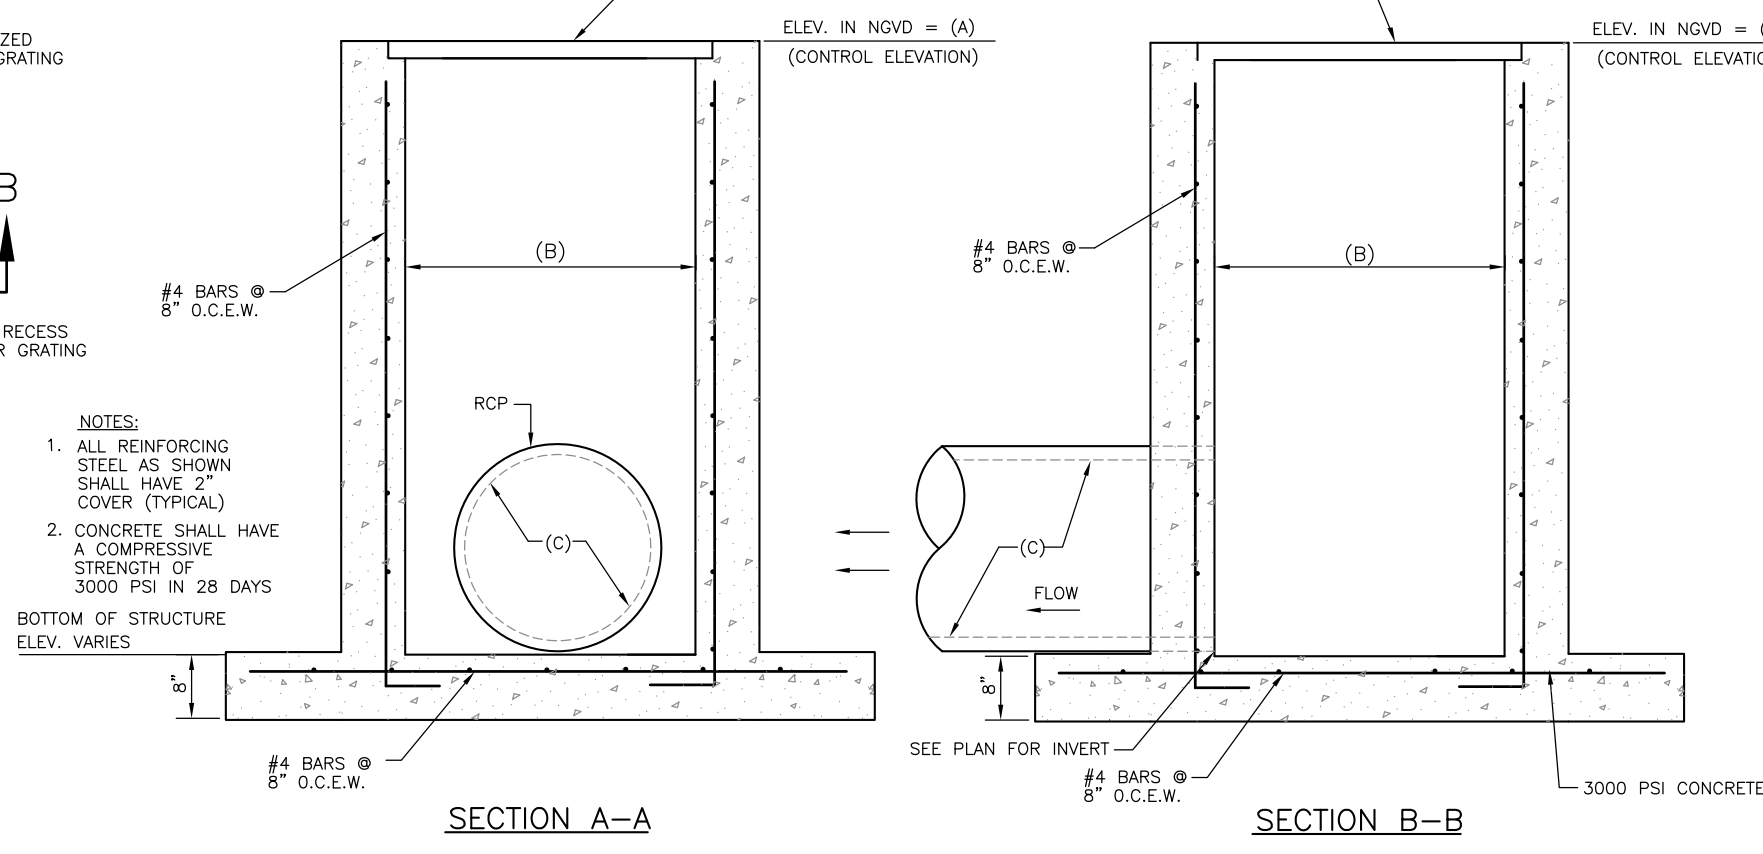


CONTROL STRUCTURES (SEE TABLE) N.T.S.

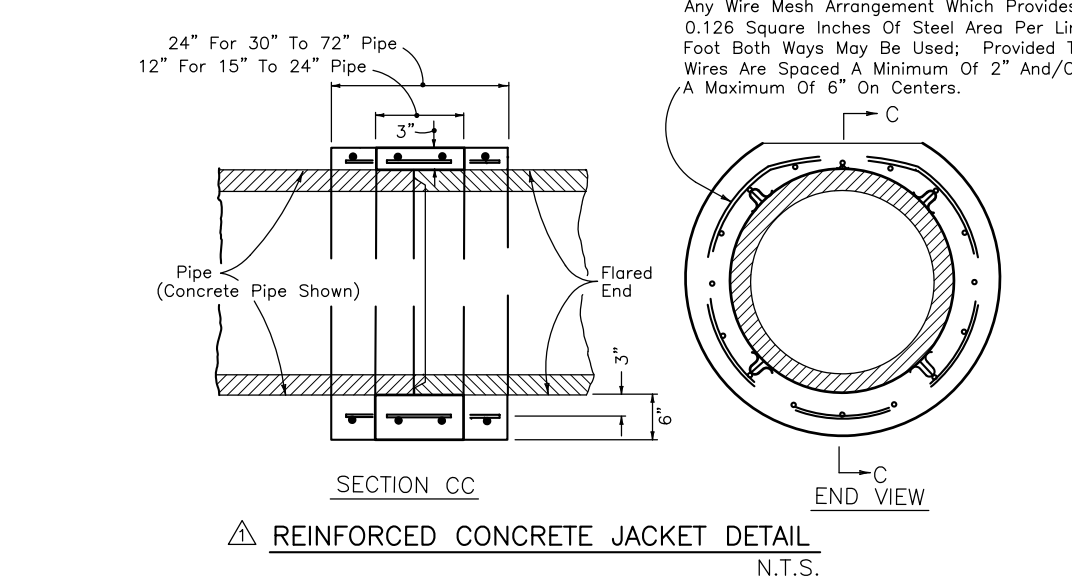


REINFORCED CONCRETE JACKET DETAIL N.T.S.

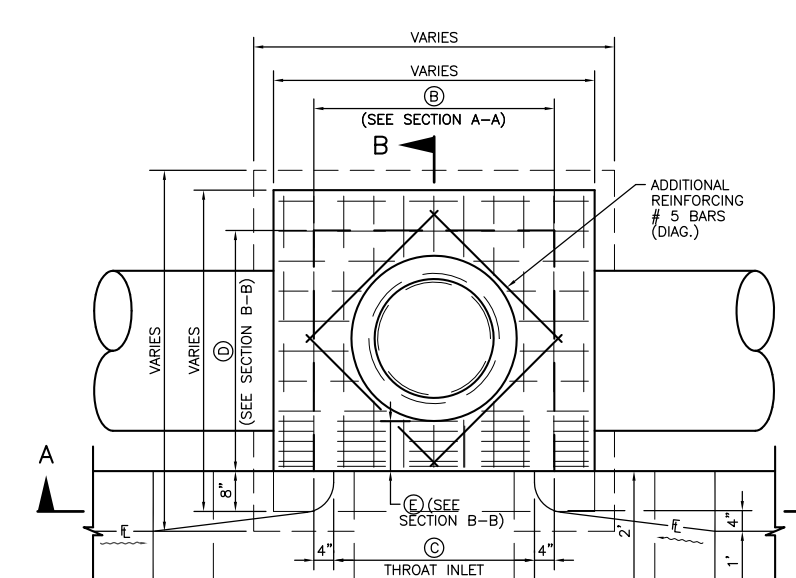


MANHOLE COVER N.T.S.

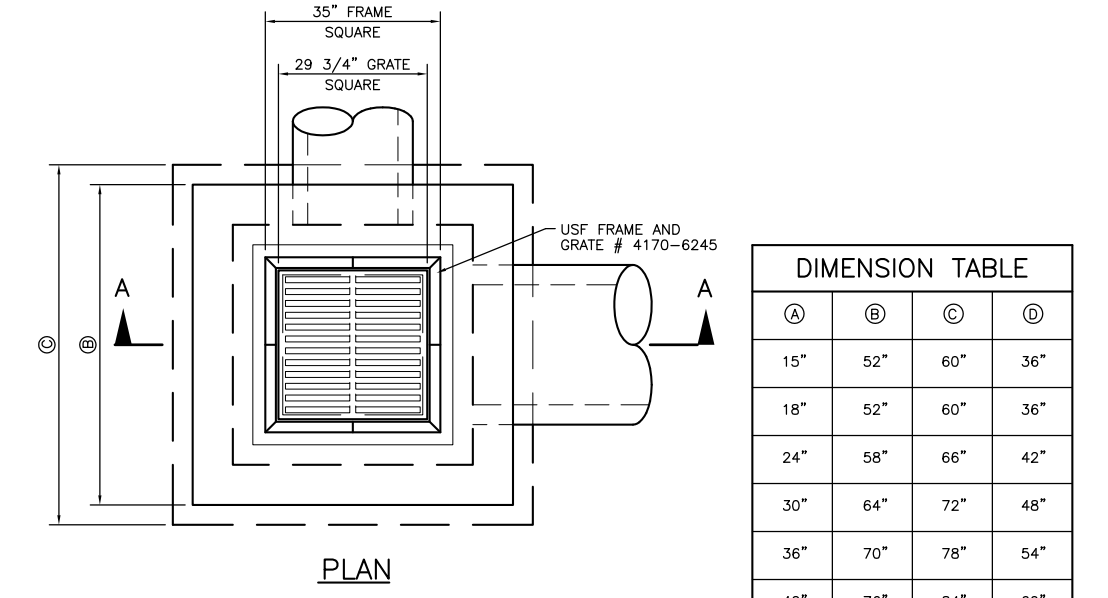

GRATE INLET DETAIL N.T.S.

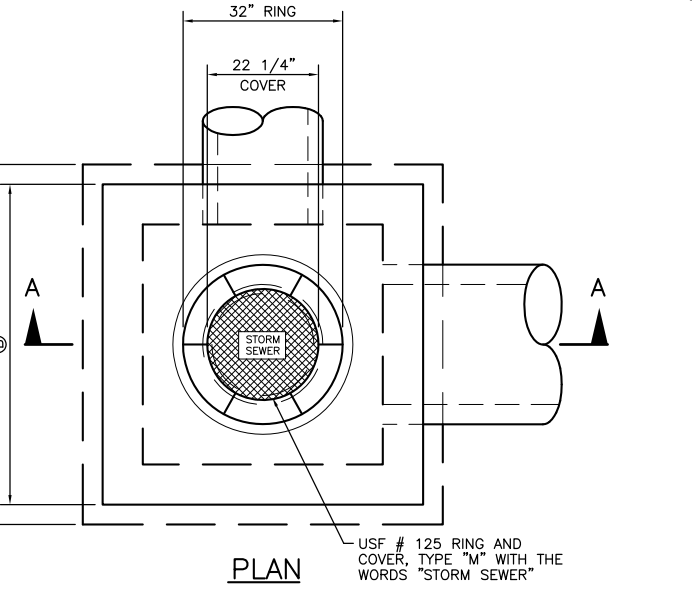

JUNCTION BOX DETAIL N.T.S.

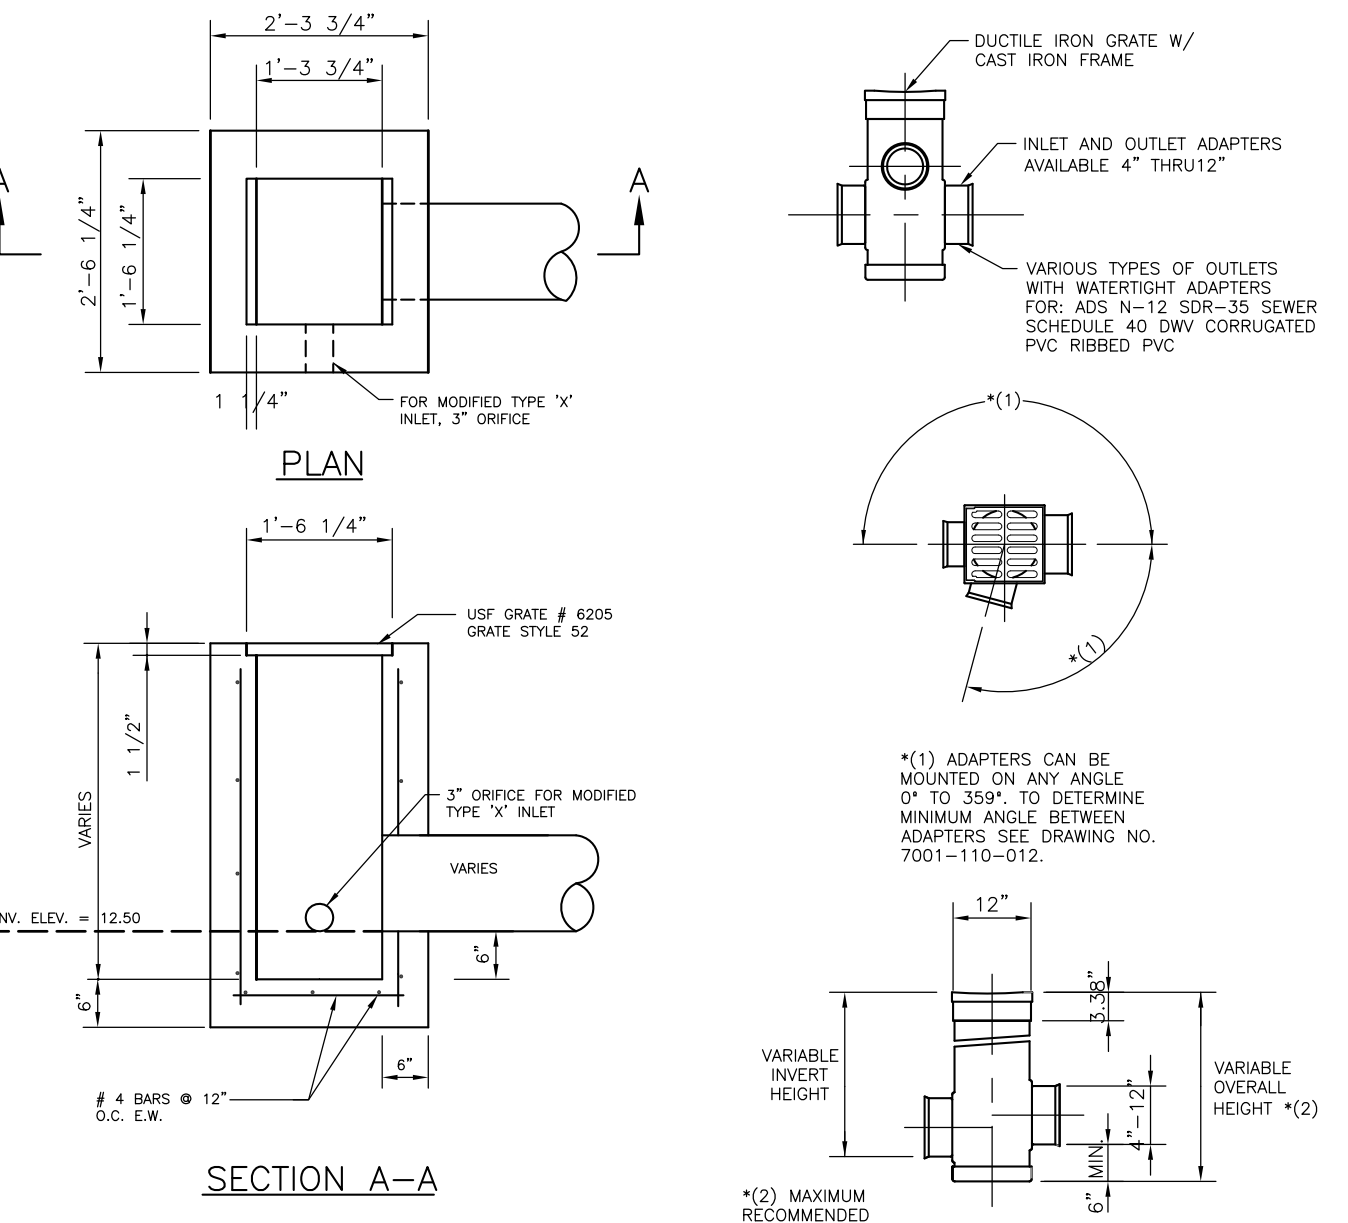

TYPE "X" INLET DETAIL N.T.S.

12" DRAIN BASIN YARD DRAIN BASIN DETAIL N.T.S.

RECORD DRAWINGS

DATE:	8/20/06
THESE RECORD DRAWINGS ARE INTENDED TO DISPLAY THE COMPLETED WORK SUBSTANTIALLY AS CONSTRUCTED. THEY ARE BASED ON DATA PROVIDED TO THE ENGINEER, AND CERTIFIED BY A REGISTERED PROFESSIONAL SURVEYOR AND MAPPER. FIELD VERIFICATION OF CONDITIONS AND LOCATIONS SHOULD BE UNDERTAKEN PRIOR TO ALTERATION OR CONSTRUCTION IN THE PROJECT AREA.	
WATER AND SEWER ONLY (PHASE 2A)	08/20/06
PAVING, GRADING, AND DRAINAGE (PHASE 2A)	10/05/06
WATER AND SEWER ONLY (PHASE 2B)	12/14/06
PAVING, GRADING, AND DRAINAGE (PHASE 2B-1)	12/14/06

REV.	NO.	DATE	DESCRIPTION	DATE	BY	DATE	DESCRIPTION	DATE	BY	DATE	DESCRIPTION
14	RECORD DRAWING REVISION - PAVING, GRADING, AND DRAINAGE - PHASE 2B	12/14/06	MPO/2348				ACTIVITY	INITIALS/EMP. NO.	DATE		
10	REVISED FOR UTILITIES CONVEYANCE	12/14/06	MPO/2348				DESIGNED BY:	LMG/894	4/15/05		
6	REVISED FOR UTILITY DEVIATION	6/20/06	RRM/1482				DRAWN BY:	RRM/1482	4/15/05		
3	REVISED PER FDEP COMMENTS AND PER ENGINEER	3/22/06	RRM/1482				CHECKED BY:				
1	REVISED PER COLLIER COUNTY COMMENTS	9/28/05	RRM/1482				CONTRACT ADMIN. BY:				
Δ PREP NO.	REV936/06, 2008	22:46:02	TDSLVAK\VENO\N0442\150-QuarryPhase2\Rev14-rordPaving&Drainage\044215032.dwg	DATE	DRAWN BY / EMP. NO.	CHECKED BY / EMP. NO.	WM APPROVED BY:				

WilsonMiller, Inc.

Planners • Engineers • Ecologists • Surveyors • Landscape Architects • Transportation Consultants

Naples • Fort Myers • Sarasota • Bradenton • Tampa • Tallahassee

457 Colonial Boulevard Suite 100 • Fort Myers, Florida 33902 • Phone 239-939-1222 • Fax 239-939-3442 • Web Site www.wilsonmiller.com

CLIENT:	CENTEX HOMES	DATE:	FEB 2005	TITLE:	PAVING & DRAINAGE DETAILS	LISA M. GORDANO
PROJECT:	THE QUARRY PHASE 2	HORIZONTAL SCALE:	AS NOTED	INDEX NUMBER:	D-0442-150	
		VERTICAL SCALE:	AS NOTED	SHEET NUMBER:	32 OF 38	
		CROSS REFERENCE FILE NO.:	0442-48	PROJECT NUMBER:	N0442-509-000	



2216 Altamont Avenue
Fort Myers, Florida 33901
Phone: 239.332.5499
Fax: 239.332.2955

www.cphcorp.com

June 6, 2023

Timothy Cantwell
Quarry CDD
c/o Inframark
210 N. University Drive, Suite 702
Coral Springs, FL 33071

Re: Notice to QCA: Stormwater System Modification that are affecting the as built system that require remediation Copper Canyon Ct. Localized Flooding.

Tim:

Per your request, CPH provides the following potential solutions to address the localized flooding issues affecting the properties listed in your Memorandum to the Quarry Homeowner's Association dated May 18, 2023:


- 9381 & 9385 Copper Canyon
 - o Remove existing landscape and re-dig swale to meet original design.
 - o Partial landscape removal with underground stormwater pipe and yard drain installation to move stormwater run-off from these two lots to the existing swale.
- 9389 Copper Canyon
 - o Remove and replace existing brick pathway to match original design swale contours / grades.
 - o Install drainage pipes under existing brick pathway
 - o Re-dig swale to meet original design and construct a bridge type structure / path to cross the swale and connect to boat dock.
- 9405 Copper Canyon
 - o Adjust proposed pathway to meet original swale design contours / elevations.


A copy of the Phase-2 drainage design drawings prepared by Wilson Miller are attached for reference

Please do not hesitate to contact us if you have any questions.

A handwritten signature in blue ink, appearing to read 'Albert Lopez', is written over a light blue horizontal line.

Albert Lopez
Project Manager

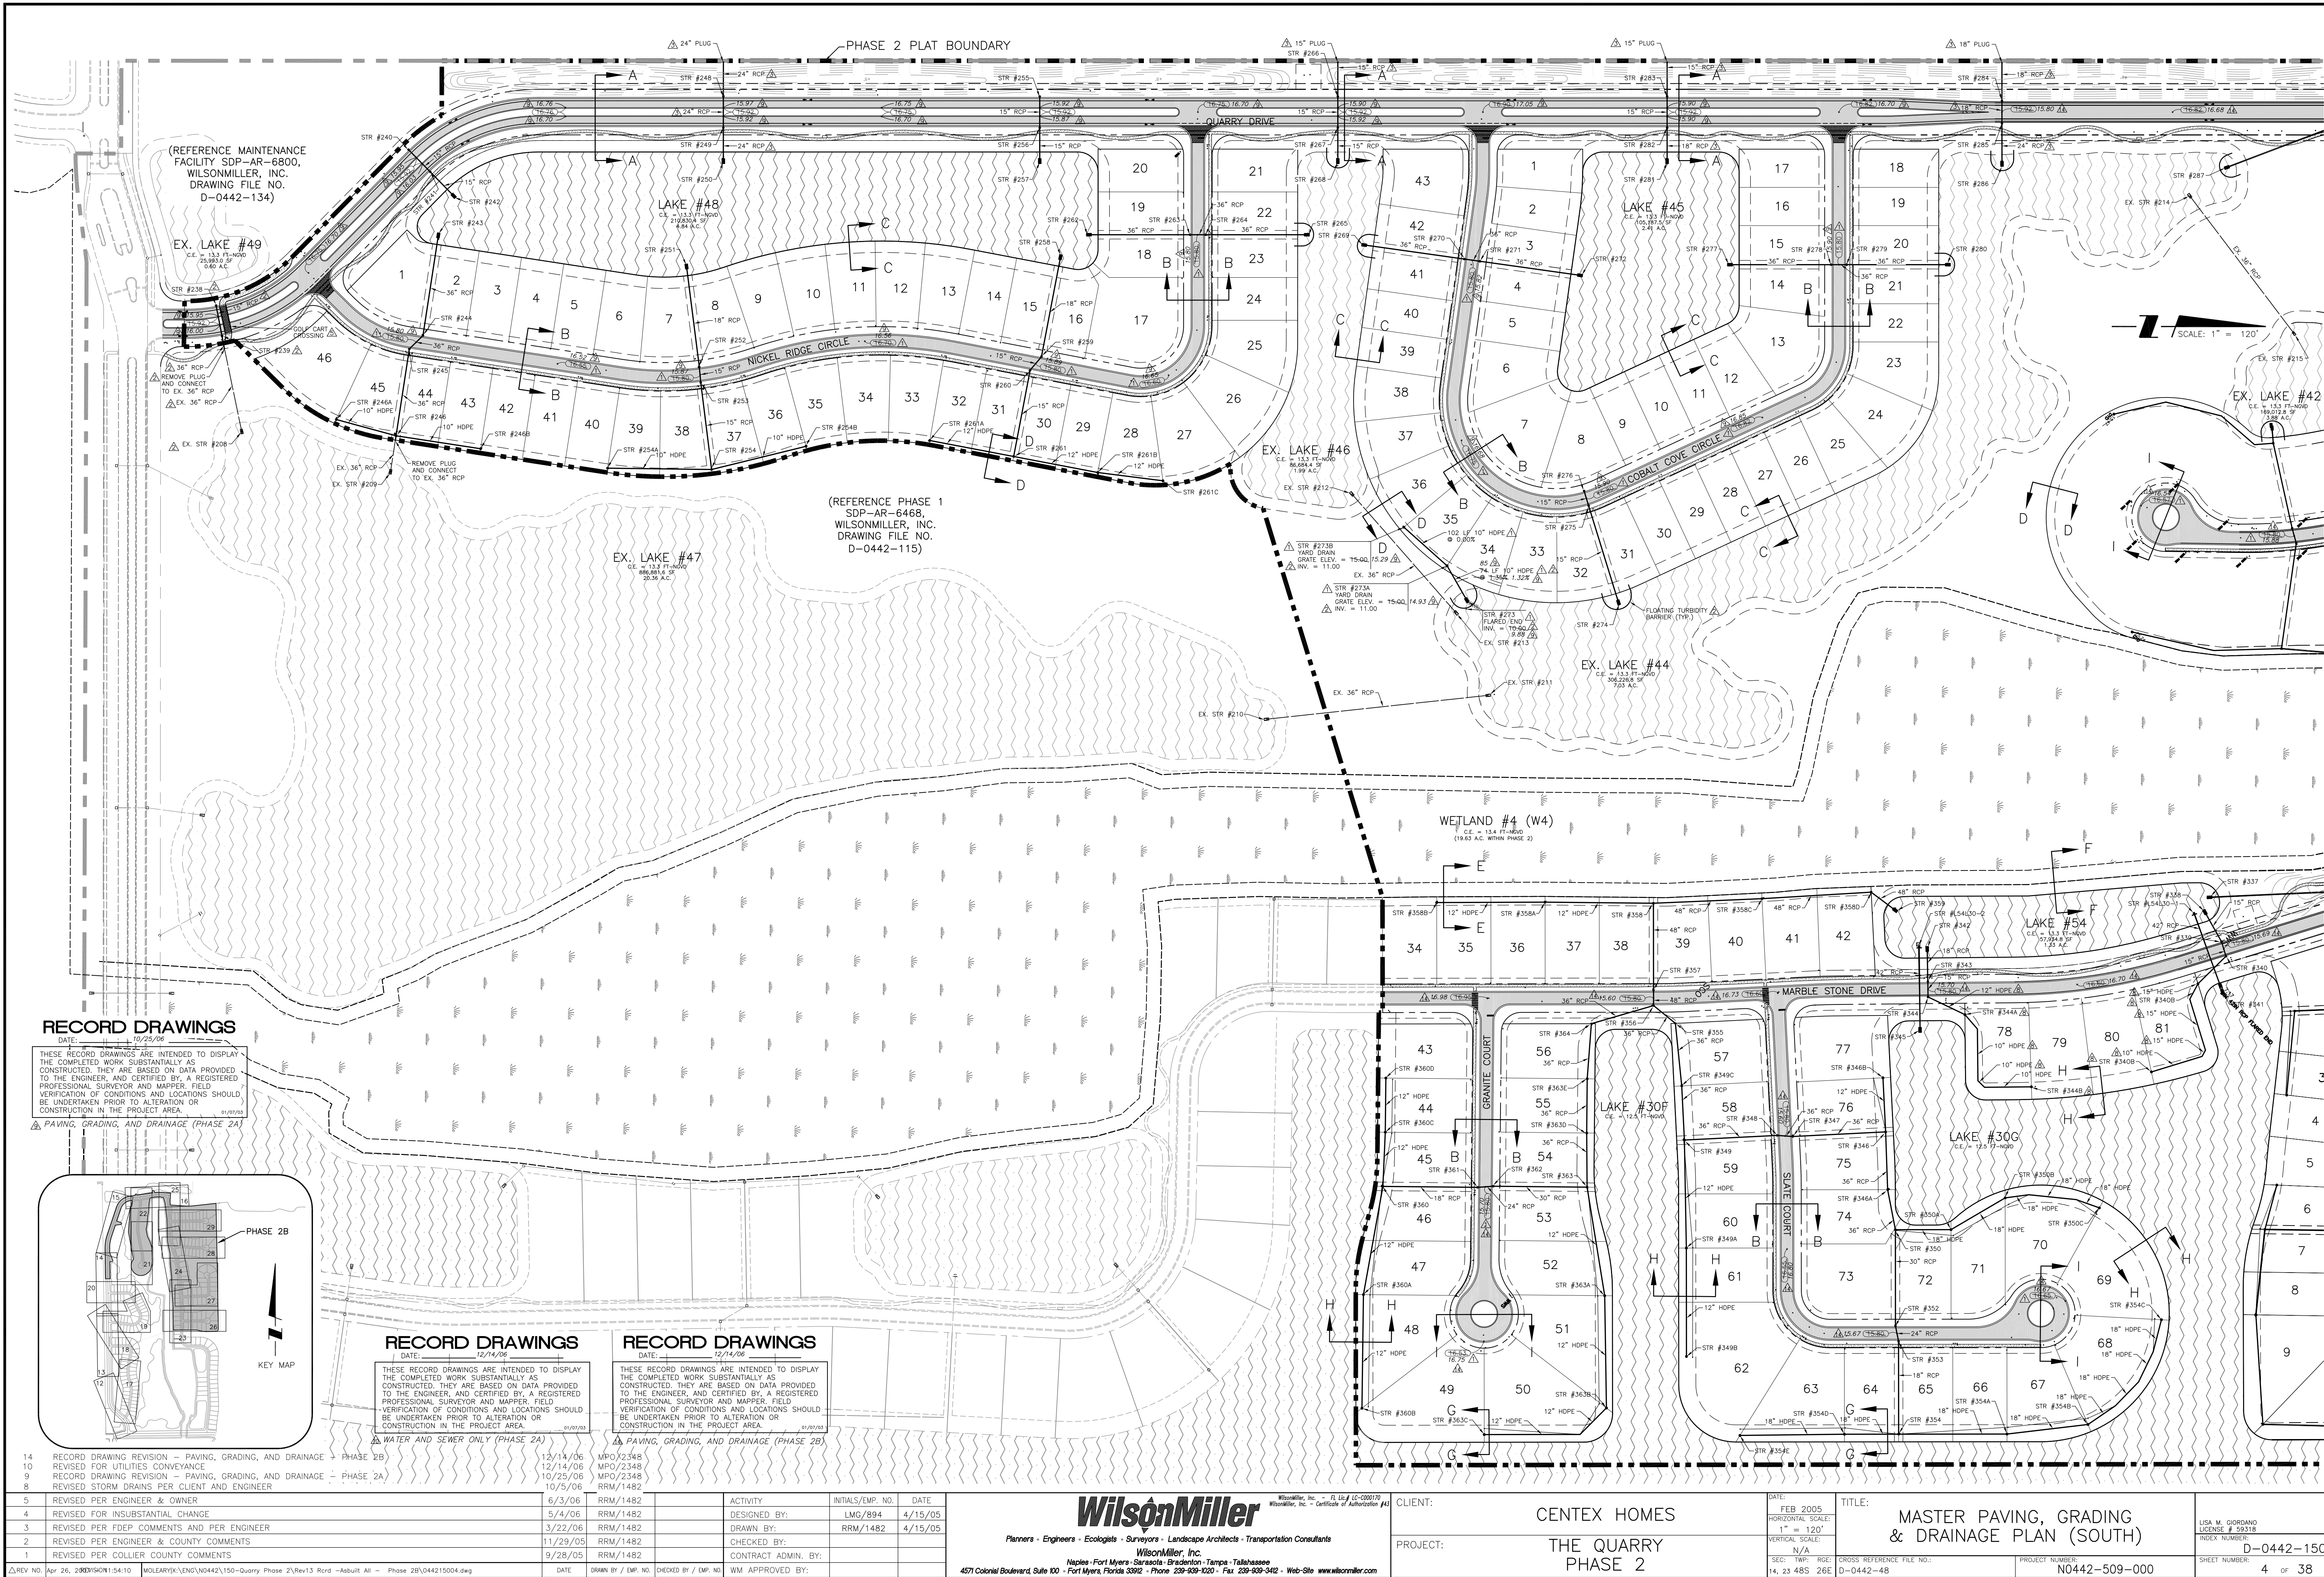

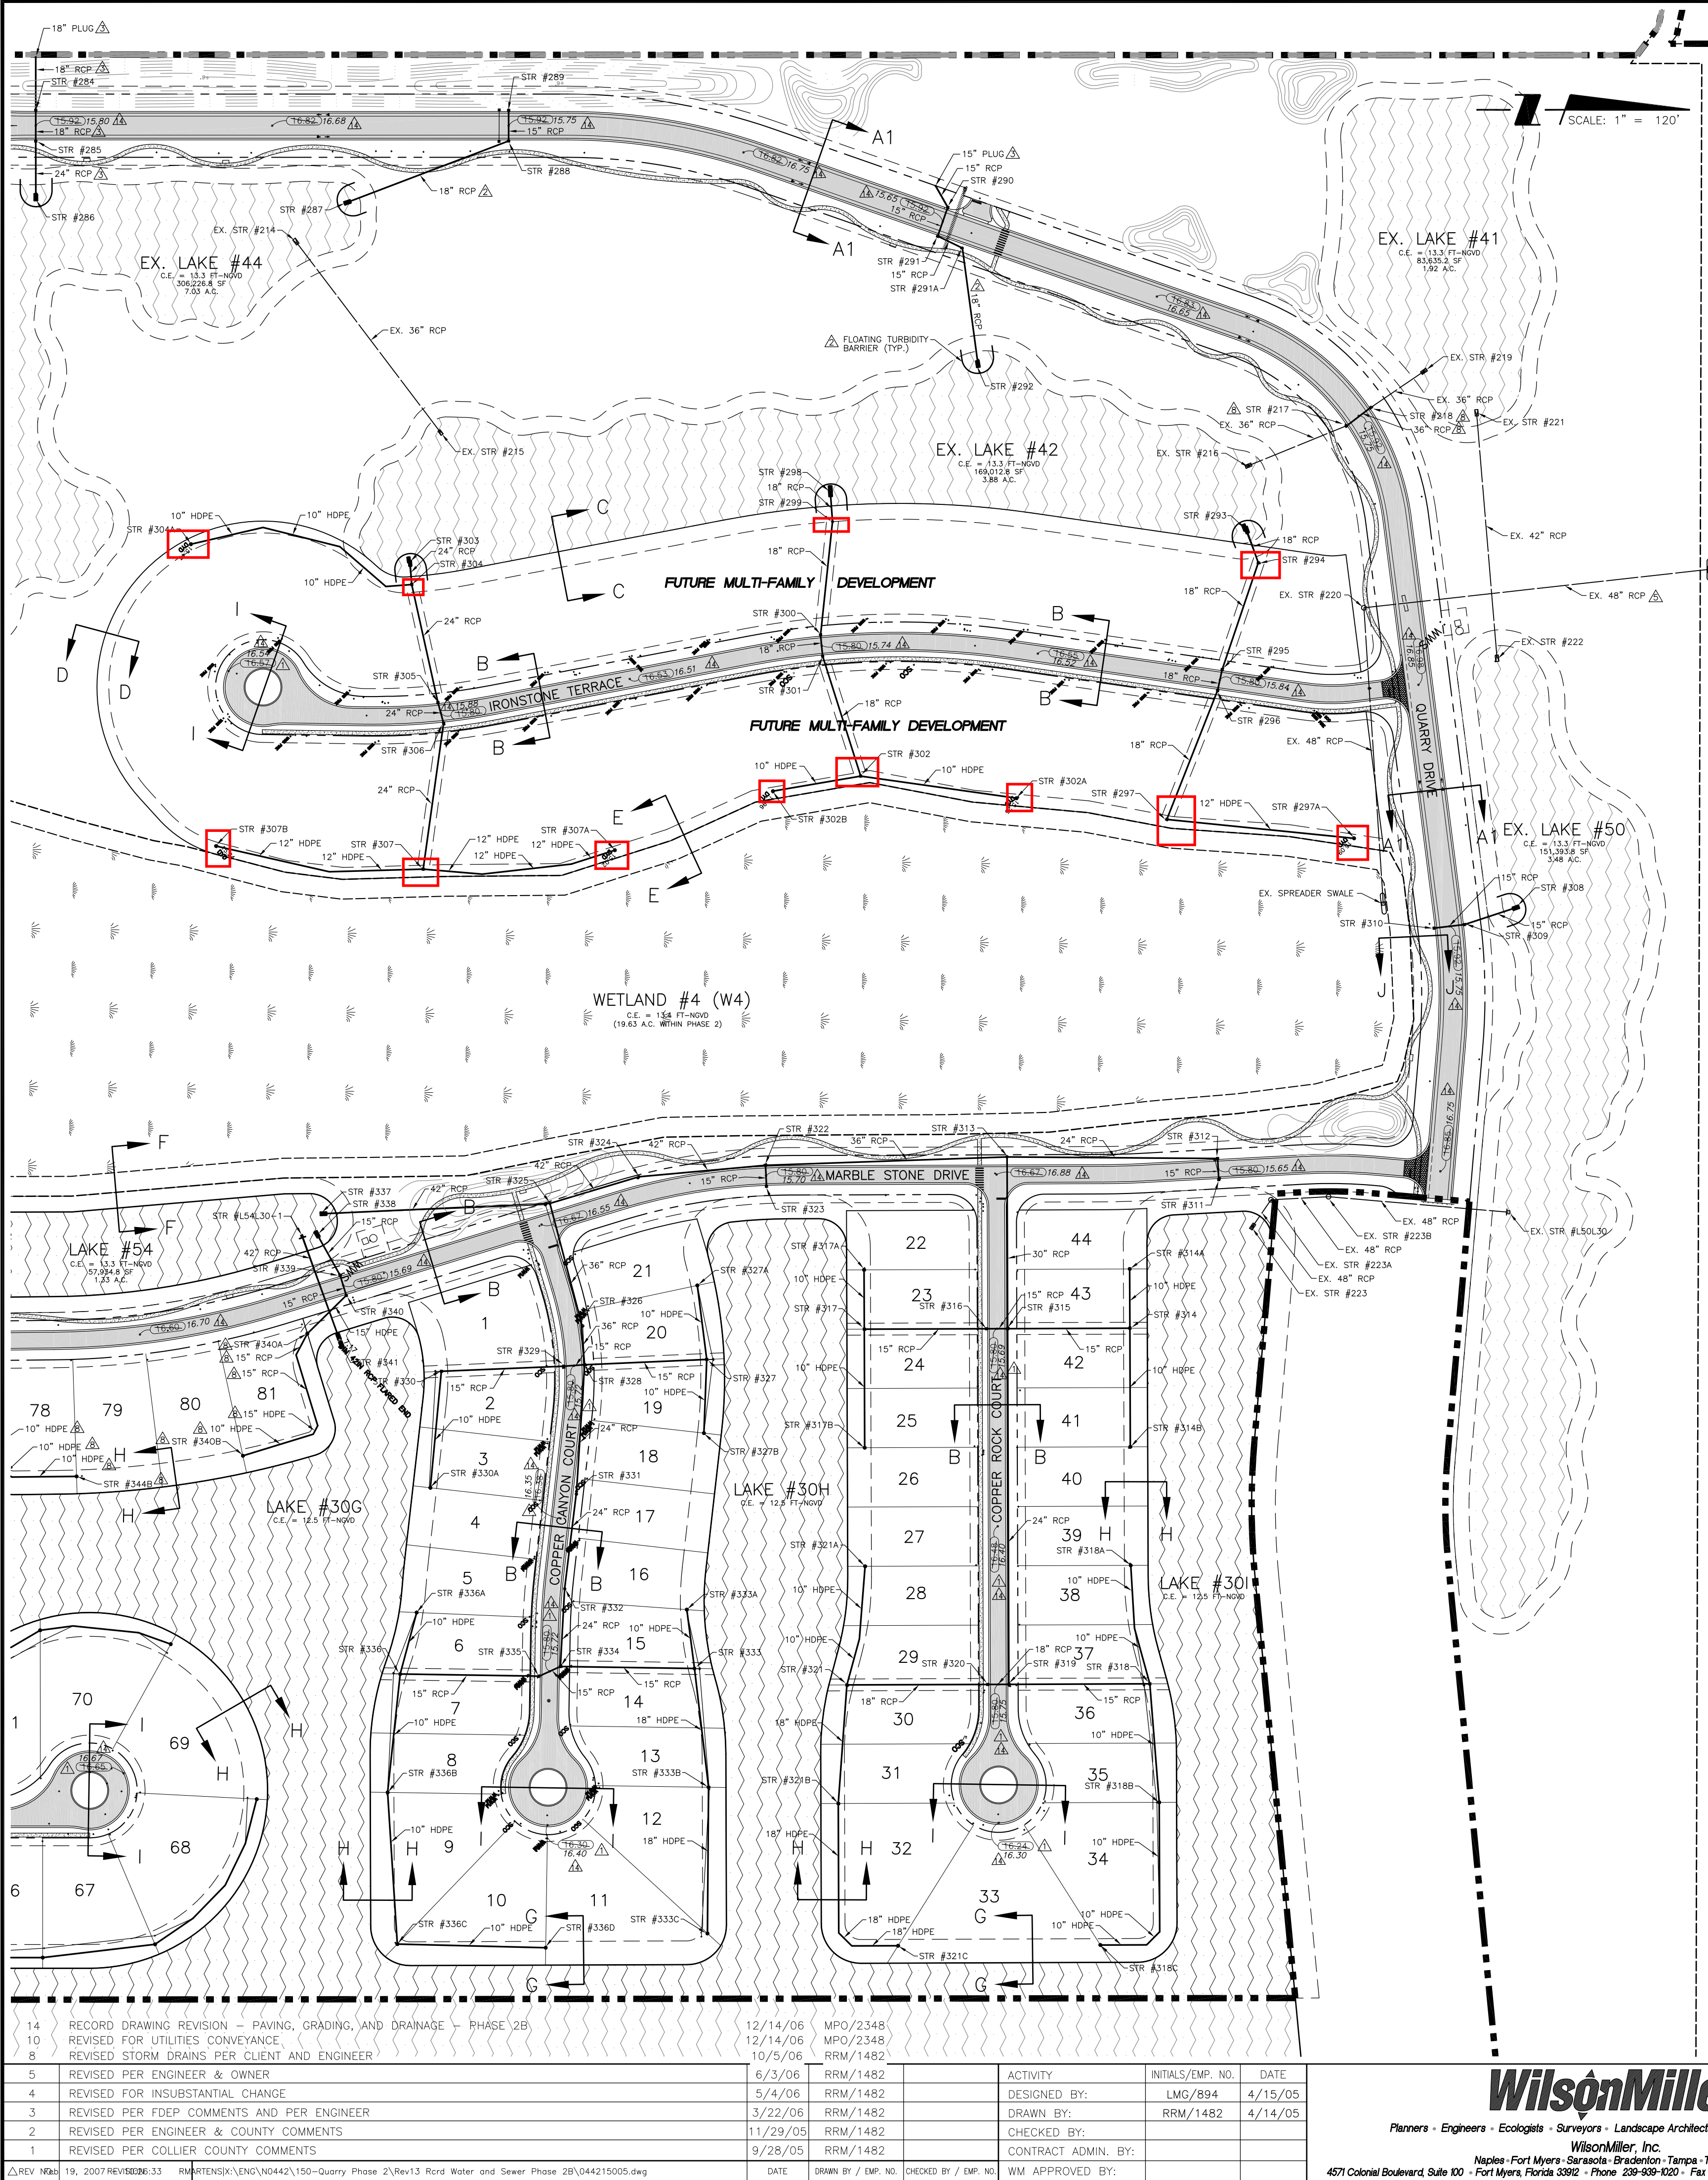

DEVELOPMENT STANDARDS

NOTE: ALL LOTS PROPOSED WITHIN PHASE 2 ARE SINGLE FAMILY DETACHED.

PER THE HERITAGE BAY PLANNED UNIT DEVELOPMENT, ORDINANCE NO. 03-40, THE MINIMUM DIMENSIONS REQUIRED FOR SINGLE FAMILY DETACHED ARE:		
		SINGLE FAMILY DETACHED
MIN. LOT AREA		5,000 SQ. FT.
MIN. LOT WIDTH*		50 FT.
MIN. AVERAGE SITE DEPTH*		100 FT.
FRONT YARD ^{1, 2} SETBACK	PRINCIPAL & ACCESSORY	20 FT.
	GARAGE FRONT/ SIDE ENTRY	23 FT./10 FT.
	GARAGE OR CARPORT ON PARKING LOT ACCESSORY	N/A
REAR YARD SETBACK ^{3, 4}	PRINCIPAL	10 FT.
	ACCESSORY ^{5, 6, 7, 8, 9, 10}	5 FT.
SIDE YARD SETBACK		6 FT.
PRINCIPAL & ACCESSORY ^{2, 4, 7, 8, 9, 10, 11, 12}		
PRESERVE SETBACK	PRINCIPAL	25 FT.
	ACCESSORY	10 FT.
MAX. HEIGHT*		35 FT.
		10 FT.
MIN. FLOOR AREA		1,000 SQ. FT.

NOTES

- FRONT YARDS FOR DRILLINGS AND SIDE-ENTRY GARAGES ARE MEASURED FROM BACK OF CURB OR EDGE OF PAVEMENT (IF NOT CURBED). FRONT YARDS FOR FRONT LOADED GARAGE ARE MEASURED FROM THE FRONT OF THE GARAGE. SIDE-ENTRY GARAGES ARE MEASURED FROM THE SIDE OF THE GARAGE, WHICHEVER IS MOST FAVORABLE TO THE HOMEOWNER.
2. SIDE WALKWAY AND SIDE COURSE, LAKE (MEASURED FROM FRONT OF WALKWAY, OR OPEN SPACE REDUCED TO 0 FEET)
3. DRIVEWAY (SEE SECTION 1.8)
4. ALL ZERO LOT LINE UNITS IN A SERIES SHALL HAVE THE 0-FOOT SIDE SETBACK ON THE SAME LOT LINE. THE 0-FOOT SIDE SETBACK SHALL BE CHANGEOVER TO A MINIMUM OF 5 FEET WHEN WIDE SPACE IS PROVIDED IN THE FORM OF AN EASEMENT, GOLF COURSE CROSSING, OR THE LIKE.
5. MINIMUM LOT LINE SETBACK MAY BE REDUCED BY 25% FOR CUL-DE-SAC LOTS PROVIDED MINIMUM LOT LINE SETBACK IS MAINTAINED FOR THE REMAINDER OF THE LOT.
6. FOR LOT LAY OUTS SERVED BOTH BY A STREET AND AN ALLEY, THE LINE ADJACENT TO THE ALLEY SHALL BE THE SETBACK LINE FOR THE ALLEY. THE SETBACK LINE FOR THE STREET SHALL BE THE LINE OF PAVEMENT.
7. GROUNDWATER OR CANADIAN BEDROCK ARE SUBJECT TO THE SETBACK REQUIREMENTS FOR STRUCTURAL STRUCTURES.
8. SETBACKS FOR STRUCTURAL STRUCTURE SHALL BE THE SAME AS THE REQUIRED SIDE, FRONTAL, STRUCTURE SETBACK.
9. SIDE SETBACK AVERAGE-ESTIMATED BY DIVIDING THE SITE AREA BY THE SITE WIDTH.
10. ACCESSORY POOL, ENCLOSURE/AGREEN LAWN SPACE MAY BE REDUCED TO 0 FEET WHEN THE SETBACK IS MAINTAINED FOR THE REMAINDER OF THE LOT.
11. ACCESSORY POOL, ENCLOSURE/AGREEN LAWN SPACE FOR LAWN MAINTENANCE EASEMENT MAY BE REDUCED TO 0 FEET.
12. STRUCTURES WITH FEATURES SUCH AS PORCHES, AMBROS, AND COURTYARD ENTRY FEATURES SHALL BE EXEMPT FROM THE MINIMUM YARD REQUIREMENTS LISTED ABOVE.
13. THE PURPOSE OF TABLE 2, THE TERM "MULTI-FAMILY BUILDING" INCLUDES ASSISTED LIVING FACILITIES.

LAND USE SUMMARY

SINGLE-FAMILY RESIDENTIAL			
	SQUARE FOOTAGE	ACREAGE	PERCENTAGE OF TOTAL AREA
IMPERVIOUS AREAS:			
* RESIDENTIAL (ROOF/DRIVEWAY)	858,000.00	19.70	9.4%
PAVEMENT & CURB	540,439.81	12.41	5.9%
SIDEWALK	83,495.21	1.92	0.9%
**FUTURE MULTI-FAMILY TRACT	238,000.00	5.46	2.6%
PERVIOUS AREAS:			
*RESIDENTIAL	1,769,907.90	40.63	19.4
LAKE	1,095,333.00	25.15	12.0%
OPEN SPACE	1,208,720.00	27.75	13.2%
GOLF COURSE (PREVIOUSLY PERMITTED)	255,535.70	50.40	24.1%
PRESERVE	895,050.00	19.63	9.4%
**FUTURE MULTI-FAMILY TRACT	284,844.00	6.54	3.1%
TOTAL	9,129,326.50	209.59	100%
* ASSUMED 5,500 SQ. FT. IMPERVIOUS PER SINGLE FAMILY LOT.			
** ASSUMED 8,500 SQ. FT. IMPERVIOUS PER MULTI-FAMILY BUILDING.			

DENSITY

PER SECTION 1.7 OF THE HERITAGE BAY PUD, COLLIER COUNTY ORDINANCE NO. 03-40, A MAXIMUM OF 3,450 DWELLING UNITS AND AN ASSISTED LIVING FACILITY CONTAINING UP TO 200 UNITS MAY BE BUILT ON THE HERITAGE BAY PUD'S 2,562± ACRES. THE GROSS PROJECT DENSITY WILL BE A MAXIMUM OF 1.3 UNITS PER ACRE.

⚠ SURFACE WATER MANAGEMENT SUMMARY *





WATER MANAGEMENT PARAMETERS		B910	W4
CONTROL ELEVATION (FT-NGVD)		13.3	13.4
25-YEAR, 3-DAY RAINFALL (IN)		11.7	11.7
100-YEAR, 3-DAY RAINFALL (IN)		14.7	14.7
PEAK 25-YEAR, 3-DAY STORM DISCHARGE (FT-NGVD)		15.6	14.9
PEAK 100-YEAR, 3-DAY STORM DISCHARGE STORM ELEVATION (FT-NGVD)		16.0	15.5
FEMA ELEVATION (FT-NGVD)	ZONE X		ZONE X
MINIMUM RECOMMENDED ROAD CROWN ELEVATION (FT-NGVD)		15.6	N/A
MINIMUM RECOMMENDED FINISHED FLOOR ELEVATION (FT-NGVD)		17.1	N/A
MINIMUM RECOMMENDED TOP OF PERIMETER BERM ELEVATION (FT-NGVD)		15.6	14.9

REFERENCE HERITAGE BAY SFWMU PERMIT NO. 11-02234-P

GENERAL NOTES:

- 1) ELEVATIONS ARE BASED ON NATIONAL GEODETIC VERTICAL DATUM (NGVD).
- 2) A PRECONSTRUCTION MEETING SHALL TAKE PLACE WITH COLLIER COUNTY ENGINEERING SERVICES PRIOR TO THE START OF CONSTRUCTION.
- 3) THIS PLAN WAS BASED ON FIELD INFORMATION AND AVAILABLE RECORD DRAWING. IT IS THE CONTRACTOR'S RESPONSIBILITY TO DETERMINE THE EXACT LOCATION OF EXISTING INFRASTRUCTURE PRIOR TO CONSTRUCTION AND PROVIDE ADEQUATE PROTECTION THEREOF.
- 4) THIS PLAN IS NOT INTENDED TO BE ALL INCLUSIVE OF EXISTING FACILITIES OR MATERIALS TO BE REMOVED. CONTRACTOR SHALL BE RESPONSIBLE FOR REMOVAL OF EXISTING UTILITIES WITH REGARD TO SITE MODIFICATIONS NECESSARY TO ACCOMMODATE THE PROPOSED IMPROVEMENTS. ALL ITEMS TO BE REMOVED SHALL BE IDENTIFIED BY THE DESIGN ENGINEER. ITEMS NOT TO BE REMOVED AT THE EXPENSE OF THE CONTRACTOR, INCLUDING ALL DUMPING FEES, UNLESS OTHERWISE NOTED.
- 5) CONTRACTOR SHALL OBTAIN UTILITIES, FLORIDA POWER AND LIGHT, UNITED TELEPHONE SERVICE, TEO GAS AND CITY MAY HAVE EXISTING UTILITIES ADJACENT TO THIS PROJECT. PRIOR TO CONSTRUCTION, CONTRACTOR SHALL CONTACT THE RESPECTIVE UTILITIES TO OBTAIN THESE FACILITIES PRIOR TO COMMENCEMENT OF CONSTRUCTION.
- 6) CONTRACTOR SHALL VERIFY ALL DIMENSIONS AND ELEVATIONS PRIOR TO COMMENCEMENT OF CONSTRUCTION. CONTRACTOR SHALL PROVIDE INFORMATION SHALL BE REPORTED TO ENGINEER IMMEDIATELY.
- 7) CONTRACTOR IS REQUIRED TO OBTAIN FROM THE ENGINEER WRITTEN APPROVAL FOR ANY DEVIATION FROM THE SPECIFICATIONS OR FROM THE INFORMATION.
- 8) CONTRACTOR SHALL COMPLY WITH THE REQUIREMENTS OF THE COLLIER COUNTY GROUNDWATER PROTECTION ORDINANCE NO. 91-103, SECTION 4.01.1.01.2A.
- 9) THE CONTRACTOR IS RESPONSIBLE FOR OBTAINING A Dewatering PERMIT FROM COLLIER COUNTY WATER MANAGEMENT DISTRICT AS REQUIRED.
- 10) THE CONTRACTOR IS RESPONSIBLE FOR OBTAINING A NATIONAL POLLUTANT DISCHARGE ELIMINATION SYSTEM (NPDES) GENERAL PERMIT FROM THE UNITED STATES ENVIRONMENTAL PROTECTION AGENCY. CONTRACTOR IS RESPONSIBLE FOR CREATING, IMPLEMENTING AND MAINTAINING A STORM WATER PROTECTION PLAN AS PER THE REQUIREMENTS OF THE NPDES GENERAL PERMIT.
- 11) CONTRACTOR SHALL BE RESPONSIBLE FOR MAINTAINING TRAFFIC AND USAGE OF ADJACENT AREAS. MAINTENANCE SHALL BE IN ACCORDANCE WITH FLORIDA MANUAL OF PRACTICES AND THE FLORIDA DEPARTMENT OF TRANSPORTATION. MAINTENANCE, AND UTILITY OPERATIONS.
- 12) UNDERGROUND CONTRACTOR SHALL MINIMIZE THE WORK AREA AND WIDTH OF EXCAVATION. ALL EXCAVATIONS SHALL BE PROTECTED BY SHIELDING FROM TRENCHES SHALL BE PLACED ONLY ON PREVIOUSLY CLEARED AREAS OR AS DIRECTED BY THE OWNER. CONTRACTOR SHALL NOT REMOVE AND/OR DISTURB ANY UNDER AND/OR SURFACE UTILITIES OR STRUCTURES BY OWNER AND ANY FEDERAL, LOCAL, AND STATE PERMITS AS REQUIRED.
- 13) ALL UNDERGROUND UTILITIES AND INFRASTRUCTURE LOCATED BENEATH THE STABILIZED AND UNSTABILIZED EXISTING PAVEMENT SHALL BE PROTECTED BY COMPACTION OF THE SUBGRADE OR AS OTHERWISE DIRECTED BY OWNER.
- 14) THE CONTRACTOR SHALL REPAIR AND REPLACE ALL AREAS DISTURBED BY CONSTRUCTION OF THIS PROJECT.
- 15) THE CONTRACTOR SHALL PROVIDE 48 HOURS WRITTEN NOTICE TO THE ENGINEER AND COLLIER COUNTY PRIOR TO THE FOLLOWING:
 - A. COMMENCEMENT.
 - B. CONTRACT APPROVED SCHEDULES, SUBCONTRACTORS, OR RESIDENT SUPERINTENDENT.
 - C. GENERAL.
 1. COMPACT.
 2. TRENCH DENSITY.
 3. INFILTRATION.
 - D. WHAT MAY BE REQUIRED BY OWNER, COUNTY AND ENGINEER.
- 16) ALL MATERIALS AND CONSTRUCTION METHODS USED FOR THE PROPOSED IMPROVEMENTS SHALL CONFORM TO THE APPROVED TECHNICAL SPECIFICATIONS, AND ALL FEDERAL, STATE AND LOCAL REGULATIONS.
- 17) DURING CONSTRUCTION, ALL EXISTING UTILITIES WHERE APPROPRIATE, SHALL BE COVERED WITH FILTER FABRIC (MIRAF) 1400R OR APPROVED EQUIV. TO PREVENT DEBRIS AND FILL FROM FALLING INTO THE INLET.
- 18) PRIVATE CITIES, WATER MANAGEMENT DISTRICTS, UTILITIES, OPEN SPACE, AND LANDSCAPES SHALL BE OWNED AND MAINTAINED BY PROPERTY OWNER'S ASSOCIATION, ITS SUCCESSORS AND ASSIGNS.
- 19) THE REVIEW AND APPROVAL OF THESE IMPROVEMENT PLANS DOES NOT AUTHORIZE THE CONTRACTOR TO MAKE ANY IMPROVEMENTS WHICH ARE INCONSISTENT WITH EXISTING EASEMENTS OF RECORD.
- 20) THE PROPERTY OWNER IS RESPONSIBLE FOR PERPETUAL MAINTENANCE OF ALL EXISTING AND SUCH IMPROVEMENTS WHICH ARE OUTLINED BY THE DESIGN ENGINEER IN THESE DRAWINGS.
- 21) THE PROPERTY OWNER IS RESPONSIBLE FOR THE REPLACEMENT OF ALL DEAD OR DAMAGED TREES AND PLANTS TO BE REPLACED BY THE PROPERTY OWNER'S MAINTENANCE SYSTEM.
- 22) THE CONTRACTOR SHALL BE RESPONSIBLE FOR OBTAINING COPIES OF AND COMPLYING WITH ALL CITY ORDINANCES.
- 23) CONTRACTOR SHALL BE RESPONSIBLE FOR COORDINATING WITH THE APPROPRIATE UTILITY COMPANIES FOR SERVICE CONNECTIONS FOR THE PROJECT.

LEGEND

	LAKE
	PROPOSED PAVEMENT
	CONCRETE SIDEWALK
C.E.	CONTROL ELEVATION
	PHASE 2 PLAT BOUNDARY

PRESERVE AREA SUMMARY

	AREA OF PRESERVE (AC)
W1	658.14
W2	110.18
W4	38.06
HERITAGE BAY COMMONS (W3)	54.4
HERITAGE BAY	9.5
TOTAL	870.3

NOTE: PER THE HERITAGE BAY P.U.D., A MINIMUM OF 863.0 ACRES OF PRESERVE ARE TO BE PROVIDED.

RECORD DRAWINGS

DATE: 12/14/06

THESE RECORD DRAWINGS ARE INTENDED TO DISPLAY THE COMPLETED WORK SUBSTANTIALLY AS CONSTRUCTED. THEY ARE BASED ON DATA PROVIDED TO THE ENGINEER, AND CERTIFIED BY, A REGISTERED PROFESSIONAL SURVEYOR AND MAPPER. FIELD VERIFICATION OF CONDITIONS AND LOCATIONS SHOULD BE UNDERTAKEN PRIOR TO ALTERATION OR CONSTRUCTION IN THE PROJECT AREA.

RECORD DRAWINGS

DATE: 12/14/06

THESE RECORD DRAWINGS ARE INTENDED TO DISPLAY THE COMPLETED WORK SUBSTANTIALLY AS CONSTRUCTED. THEY ARE BASED ON DATA PROVIDED TO THE ENGINEER, AND CERTIFIED BY, A REGISTERED PROFESSIONAL SURVEYOR AND MAPPER. FIELD VERIFICATION OF CONDITIONS AND LOCATIONS SHOULD BE UNDERTAKEN PRIOR TO ALTERATION OR CONSTRUCTION IN THE PROJECT AREA.

WATER AND SEWER ONLY (PHASE 2A)

KEY MAP

Wilson Miller

WJ20041618r.doc 57 / 116 4/10/2004 1:30

Planners • Engineers • Ecologists • Surveyors • Landscape Architects • Transportation Consultants

4571 Colonial Boulevard, Suite 100 • Naples • Fort Myers • Sarasota • Bradenton • Tampa • Tallahassee
Fort Myers, Florida 33912 • Phone 239-939-1020 • Fax 239-939-3412 • Web-Site www.wilsonmiller.com

CLIENT:

100

CENTEX HOMES
THE QUARRY
PHASE 2

DATE:

FEB 2005
HORIZONTAL SCAN
$$1'' = 120'$$

VERTICAL SCALE:
N/A

SEC:	TWP:	RC:
------	------	-----

TITLE:

11

100




1

CROSS REF	
-----------	--

MASTER PAVING, GRADING,
& DRAINAGE PLAN (NORTH)

LISA M. GIORDANO
LICENSE # 59318
INDEX NUMBER:

5 OF 38

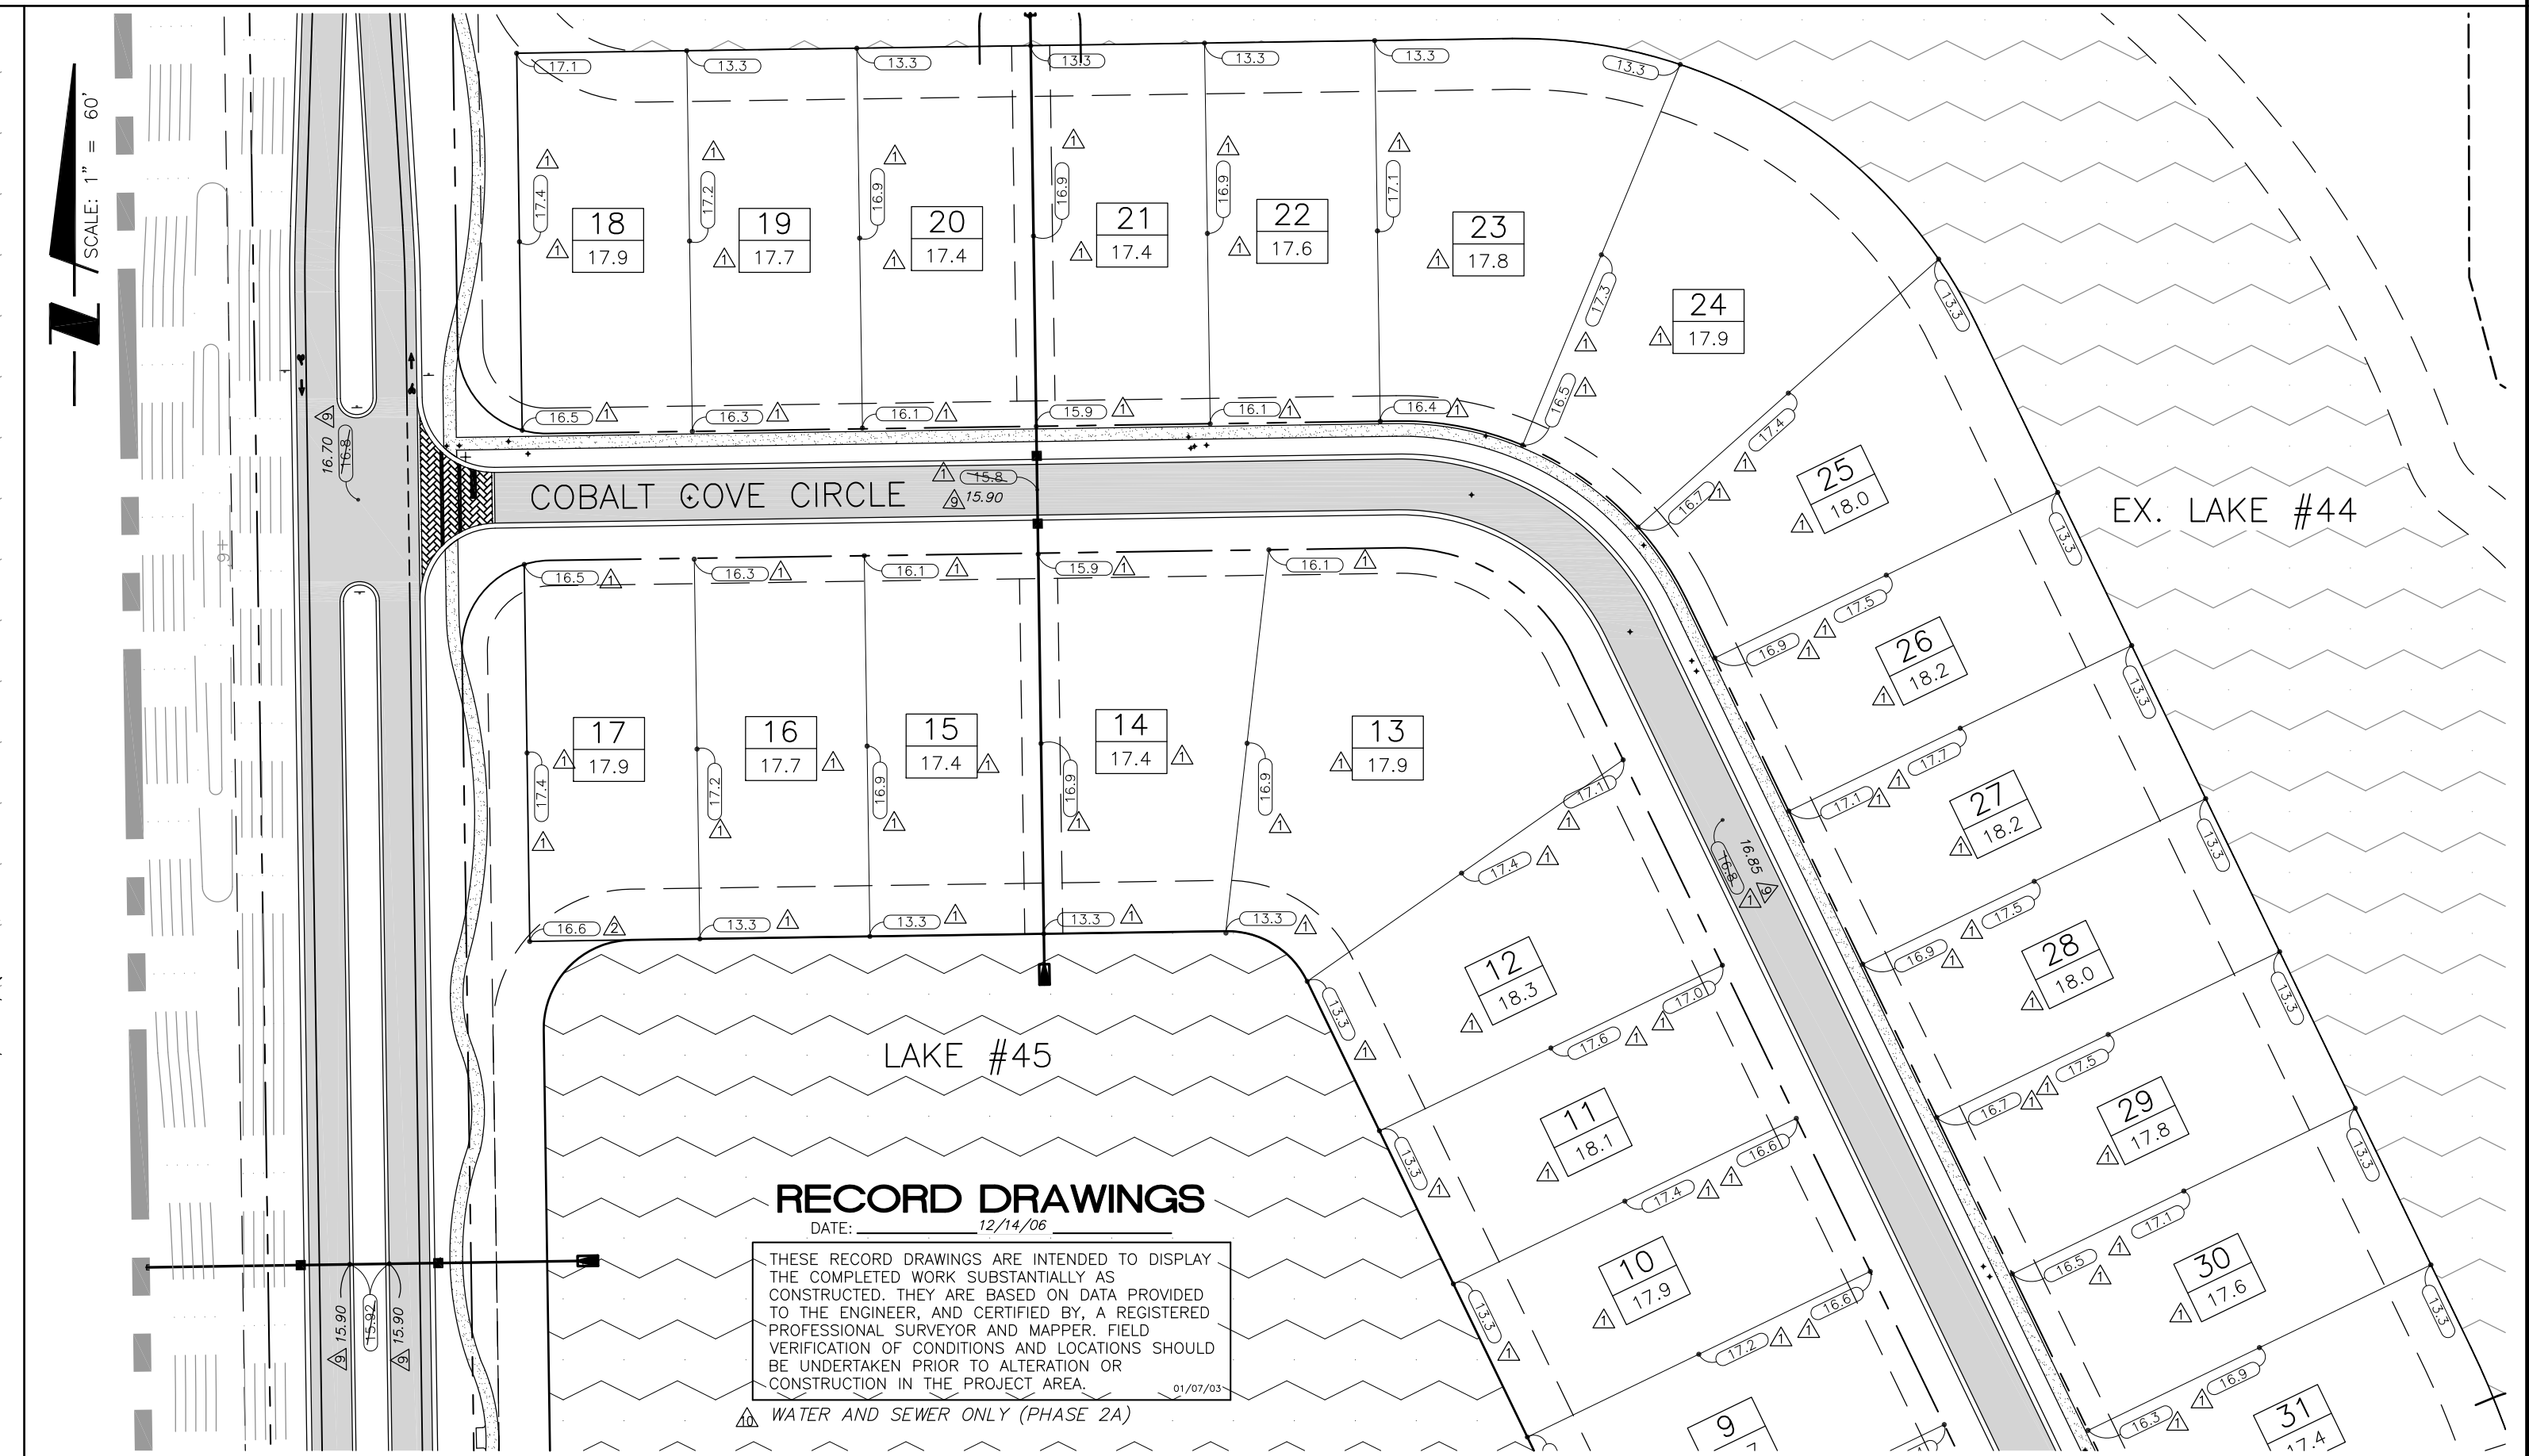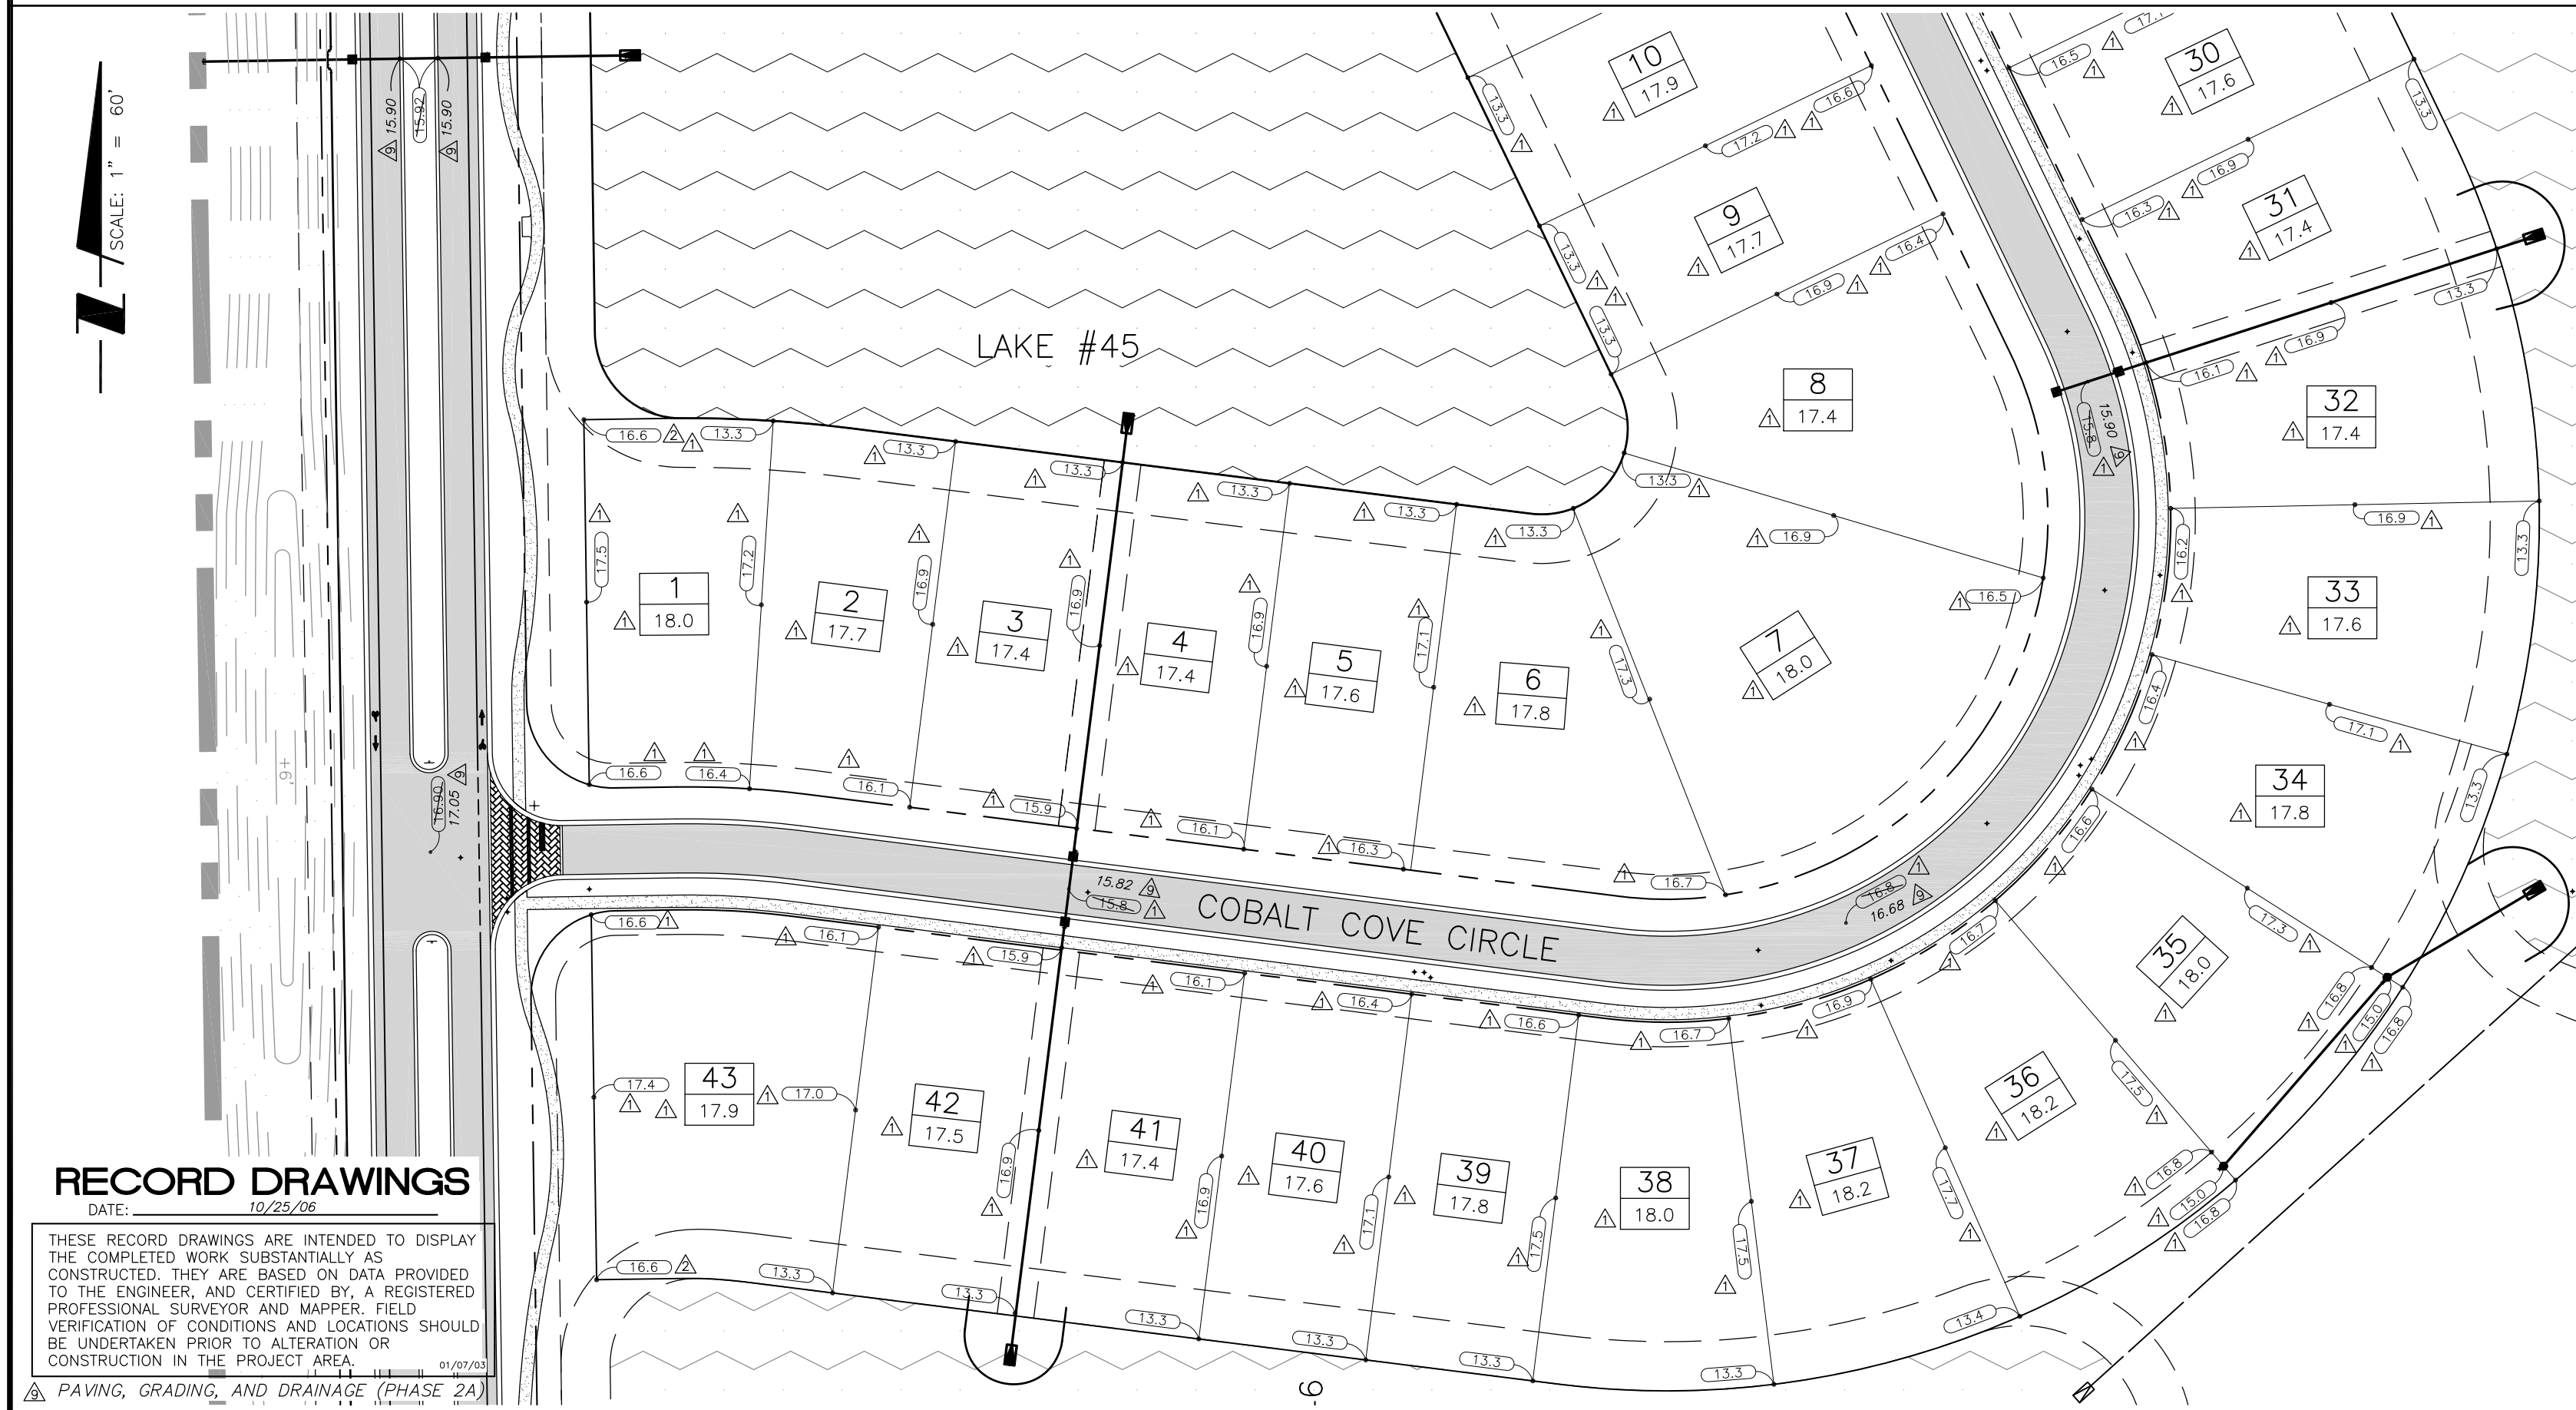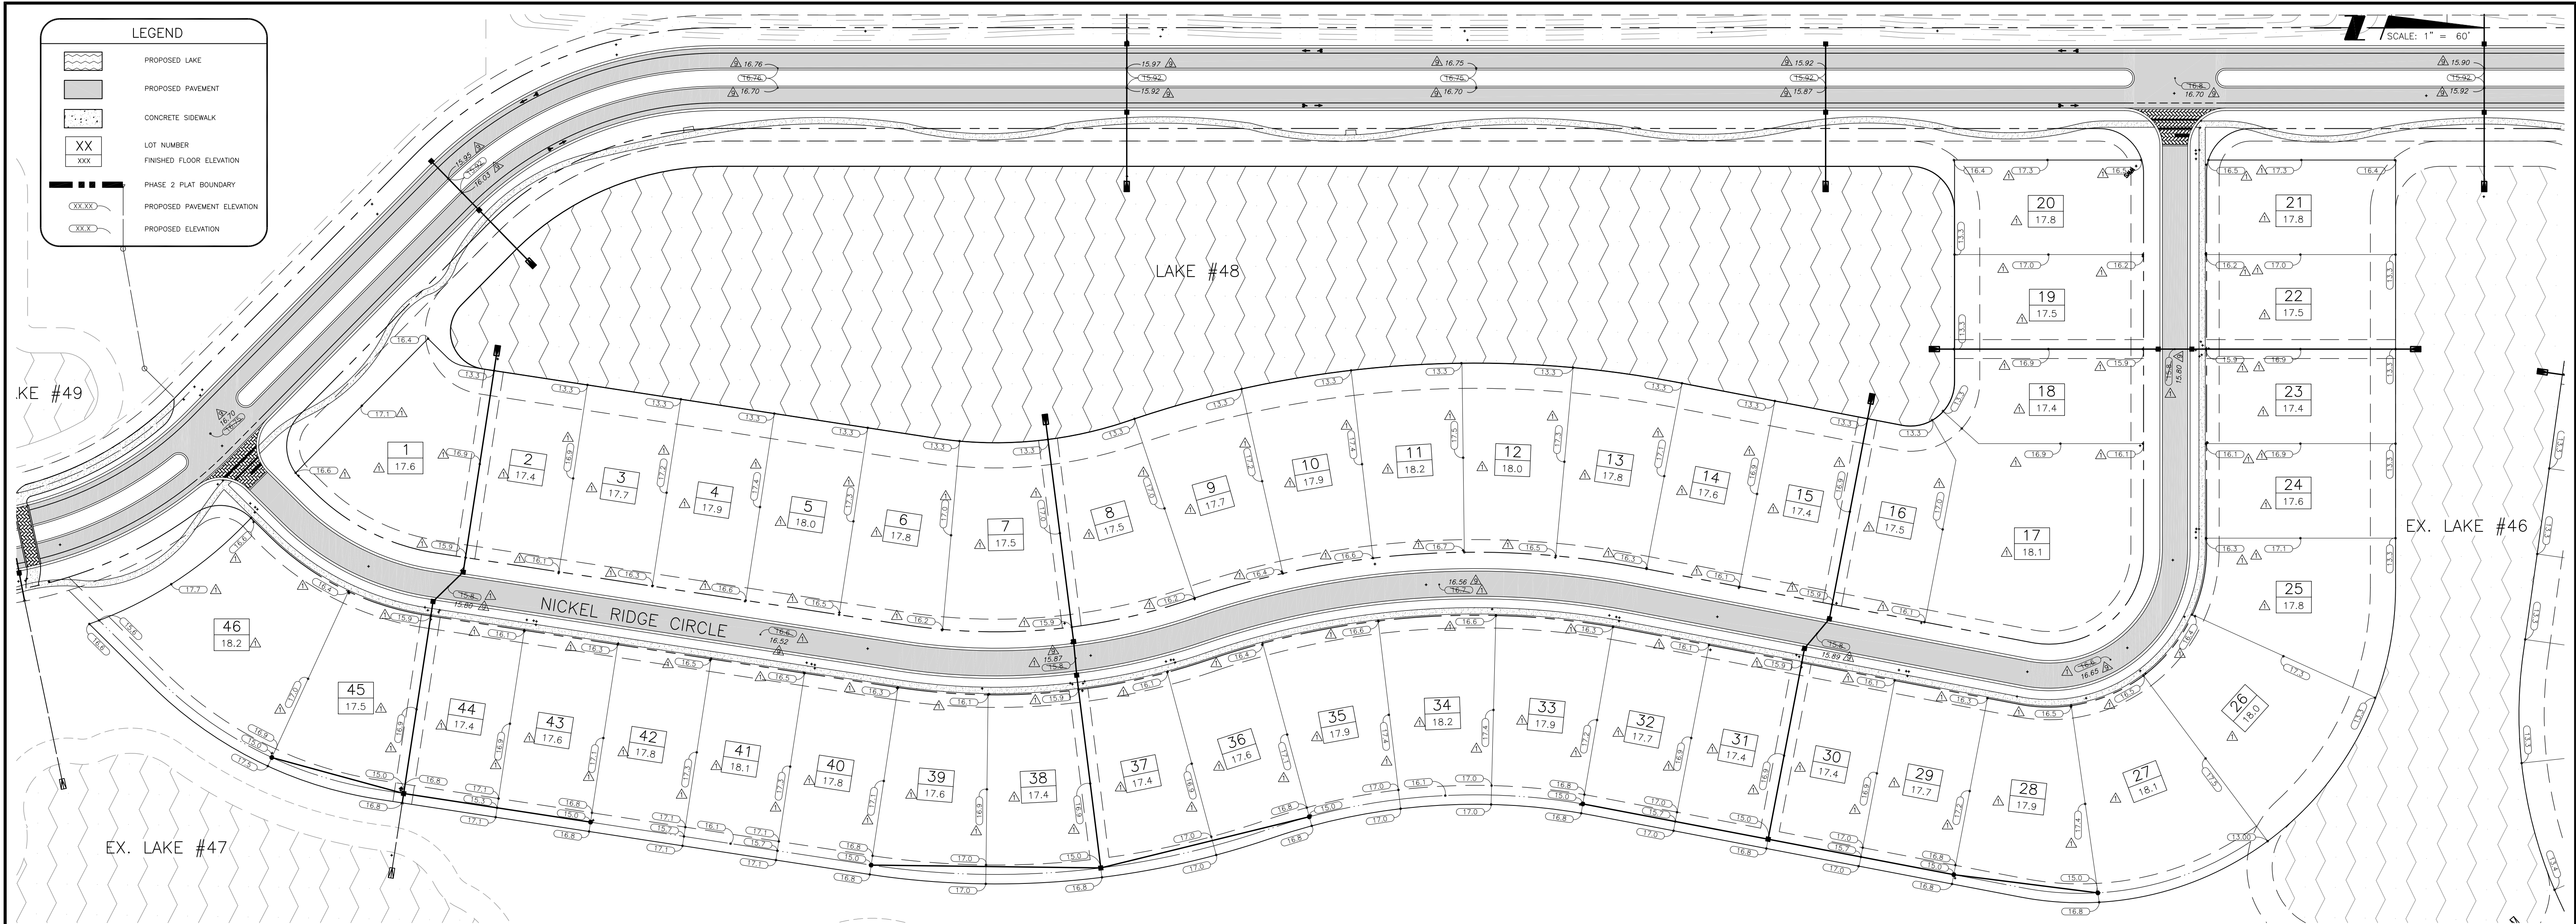

RECORD DRAWINGS

DATE: 10/23/06

THESE RECORD DRAWINGS ARE INTENDED TO DISPLAY THE COMPLETED WORK SUBSTANTIALLY AS CONSTRUCTED. THEY ARE BASED ON DATA PROVIDED TO THE ENGINEER, AND CERTIFIED BY, A REGISTERED PROFESSIONAL SURVEYOR AND MAPPER. FIELD VERIFICATION OF CONDITIONS AND LOCATIONS SHOULD BE UNDERTAKEN PRIOR TO ALTERATION OR CONSTRUCTION IN THE PROJECT AREA.

PAVING, GRADING, AND DRAINAGE (PHASE 2A)

RECORD DRAWINGS

DATE: 12/14/06

THESE RECORD DRAWINGS ARE INTENDED TO DISPLAY THE COMPLETED WORK SUBSTANTIALLY AS CONSTRUCTED. THEY ARE BASED ON DATA PROVIDED TO THE ENGINEER, AND CERTIFIED BY, A REGISTERED PROFESSIONAL SURVEYOR AND MAPPER. FIELD VERIFICATION OF CONDITIONS AND LOCATIONS SHOULD BE UNDERTAKEN PRIOR TO ALTERATION OR CONSTRUCTION IN THE PROJECT AREA.

WATER AND SEWER ONLY (PHASE 2A)

10	REVISED FOR UTILITIES CONVEYANCE	12/14/06	MPO/2348	ACTIVITY	INITIALS/EMP. NO.	DATE	WilsonMiller Planners • Engineers • Ecologists • Surveyors • Landscape Architects • Transportation Consultants WilsonMiller, Inc. Naples • Fort Myers • Sarasota • Bradenton • Tampa • Tallahassee 4571 Colonial Boulevard, Suite 100 • Fort Myers, Florida 33912 • Phone 239-939-1020 • Fax 239-939-3442 • Web-Site: www.wilsonmiller.com
9	RECORD DRAWING REVISION - PAVING, GRADING, AND DRAINAGE - PHASE 2A	10/25/06	MPO/2348	DESIGNED BY:	LMG/894	4/15/05	
4	REVISED FOR INSUBSTANTIAL CHANGE	5/4/06	RRM/1482	DRAWN BY:	RRM/1482	4/15/05	
2	REVISED PER ENGINEER & COUNTY COMMENTS	11/29/05	RRM/1482	CHECKED BY:			
1	REVISED PER COLLIER COUNTY COMMENTS	9/28/05	RRM/1482	CONTRACT ADMIN. BY:			
DATE	DESIGNED BY / EMP. NO.	CHECKED BY / EMP. NO.	WM. APPROVED BY:				
Δ REV. NO.	29, 200/REV/06/MS-35	Δ LEAD/PL/ENG/NO442/150-Quarry Phase 2/Rev13 Road Water and Sewer Phase 2B/044215010.dwg	DATE	DESIGNED BY / EMP. NO.	CHECKED BY / EMP. NO.	WM. APPROVED BY:	
CLIENT:	CENTEX HOMES THE QUARRY PHASE 2						
PROJECT:							
DATE:	FEB 2005	TITLE:	LOT GRADING PLAN (NICKEL RIDGE AND COBALT COVE)				
HORIZONTAL SCALE:	1" = 60'	INDEX NUMBER:	D-0442-150				
VERTICAL SCALE:	N/A	CROSS REFERENCE FILE NO.:	N0442-509-000				
SEC. TWP. RGE.:	14, 23 48S 20E	PROJECT NUMBER:	N0442-509-000				
		SHEET NUMBER:	10 OF 38				






RECORD DRAWINGS
DATE: 8/20/06
THESE RECORD DRAWINGS ARE INTENDED TO DISPLAY THE COMPLETED WORK SUBSTANTIALLY AS CONSTRUCTED. THEY ARE BASED ON DATA PROVIDED TO THE ENGINEER, AND CERTIFIED BY, A REGISTERED PROFESSIONAL SURVEYOR AND MAPPER. FIELD VERIFICATION OF CONDITIONS AND LOCATIONS SHOULD BE UNDERTAKEN PRIOR TO ALTERATION OR CONSTRUCTION IN THE PROJECT AREA.
01/21/03
WATER AND SEWER ONLY (PHASE 2A) 08/20/06
PAVING, GRADING, AND DRAINAGE (PHASE 2A) 10/05/06
WATER AND SEWER ONLY (PHASE 2B) 12/14/06
PAVING, GRADING, AND DRAINAGE (PHASE 2B-1) 12/14/06

LEGEND

- PROPOSED LAKE
- PROPOSED PAVEMENT
- CONCRETE SIDEWALK
- LOT NUMBER
- FINISHED FLOOR ELEVATION
- PHASE 2 PLAT BOUNDARY
- PROPOSED PAVEMENT ELEVATION
- PROPOSED ELEVATION

NICKEL RIDGE				LOT DIMENSIONS																				QUARRY SHORES NORTH																				
LOT#	LOT WIDTH	LOT DEPTH	AREA	LOT#	LOT WIDTH	LOT DEPTH	AREA	LOT#	LOT WIDTH	LOT DEPTH	AREA	LOT#	LOT WIDTH	LOT DEPTH	AREA	LOT#	LOT WIDTH	LOT DEPTH	AREA	LOT#	LOT WIDTH	LOT DEPTH	AREA																					
1	104.8 LF.	150 LF.	0.37 AC.	18	75 LF.	150 LF.	0.26 AC.	36	79.2 LF.	150 LF.	0.27 AC.	6	86.9 LF.	150 LF.	0.31 AC.	24	91.6 LF.	150 LF.	0.36 AC.	42	67 LF.	150 LF.	0.23 AC.	48	138.3 LF.	165 LF.	0.55 AC.	66	95 LF.	165 LF.	0.36 AC.	101	LOT WIDTH	LOT DEPTH	AREA	18	75 LF.	165 LF.	0.28 AC.	36	75 LF.	165 LF.	0.33 AC.	
2	75 LF.	150 LF.	0.26 AC.	19	75 LF.	150 LF.	0.26 AC.	37	82.1 LF.	150 LF.	0.28 AC.	7	110 LF.	150 LF.	0.48 AC.	25	81.5 LF.	150 LF.	0.28 AC.	43	122.8 LF.	150 LF.	0.42 AC.	49	141.9 LF.	165 LF.	0.66 AC.	67	115.7 LF.	165 LF.	0.44 AC.	11	111 LF.	165 LF.	0.42 AC.	19	83.8 LF.	165 LF.	0.32 AC.	37	75 LF.	165 LF.	0.31 AC.	
3	75 LF.	150 LF.	0.26 AC.	20	75 LF.	150 LF.	0.26 AC.	38	82.1 LF.	150 LF.	0.28 AC.	8	93 LF.	150 LF.	0.35 AC.	26	67 LF.	150 LF.	0.23 AC.	44	QUARRY SHORES NORTH	QUARRY SHORES NORTH	QUARRY SHORES NORTH	50	141.9 LF.	165 LF.	0.66 AC.	68	151.1 LF.	165 LF.	0.60 AC.	2	82.4 LF.	165 LF.	0.31 AC.	20	84.3 LF.	165 LF.	0.32 AC.	38	75 LF.	165 LF.	0.29 AC.	
4	75 LF.	150 LF.	0.26 AC.	21	75 LF.	150 LF.	0.26 AC.	39	82.8 LF.	150 LF.	0.28 AC.	9	67 LF.	150 LF.	0.23 AC.	27	67 LF.	150 LF.	0.23 AC.	45	LOT#	LOT WIDTH	LOT DEPTH	AREA	51	137.4 LF.	165 LF.	0.55 AC.	69	151.1 LF.	165 LF.	0.60 AC.	3	75 LF.	165 LF.	0.28 AC.	21	78.4 LF.	165 LF.	0.30 AC.	39	75 LF.	165 LF.	0.28 AC.
5	75 LF.	150 LF.	0.26 AC.	22	75 LF.	150 LF.	0.26 AC.	40	73.6 LF.	150 LF.	0.26 AC.	10	67 LF.	150 LF.	0.23 AC.	28	67 LF.	150 LF.	0.23 AC.	46	34	95 LF.	153 LF.	0.33 AC.	52	95 LF.	165 LF.	0.42 AC.	70	135.5 LF.	165 LF.	0.53 AC.	4	75 LF.	165 LF.	0.28 AC.	22	75 LF.	165 LF.	0.28 AC.	40	75 LF.	165 LF.	0.28 AC.
6	75 LF.	150 LF.	0.26 AC.	23	75 LF.	150 LF.	0.26 AC.	41	75 LF.	150 LF.	0.26 AC.	11	67 LF.	150 LF.	0.23 AC.	29	68.5 LF.	150 LF.	0.24 AC.	35	95 LF.	153 LF.	0.33 AC.	53	95 LF.	165 LF.	0.38 AC.	71	95 LF.	165 LF.	0.43 AC.	5	79.4 LF.	165 LF.	0.30 AC.	23	75 LF.	165 LF.	0.28 AC.	41	75 LF.	165 LF.	0.28 AC.	
7	78.3 LF.	150 LF.	0.27 AC.	24	75 LF.	150 LF.	0.26 AC.	42	75 LF.	150 LF.	0.26 AC.	12	67 LF.	150 LF.	0.23 AC.	30	68.5 LF.	150 LF.	0.24 AC.	36	95 LF.	153 LF.	0.33 AC.	54	95 LF.	165 LF.	0.36 AC.	72	97.5 LF.	165 LF.	0.43 AC.	6	77.9 LF.	165 LF.	0.31 AC.	24	75 LF.	165 LF.	0.28 AC.	42	75 LF.	165 LF.	0.28 AC.	
8	86.4 LF.	150 LF.	0.30 AC.	25	94.7 LF.	154.8 LF.	0.34 AC.	43	75 LF.	150 LF.	0.26 AC.	13	119.7 LF.	150 LF.	0.48 AC.	31	85 LF.	150 LF.	0.26 AC.	37	95 LF.	153 LF.	0.33 AC.	55	95 LF.	165 LF.	0.36 AC.	73	148.5 LF.	165 LF.	0.51 AC.	7	75 LF.	165 LF.	0.33 AC.	25	75 LF.	165 LF.	0.28 AC.	43	75 LF.	165 LF.	0.28 AC.	
9	85.4 LF.	150 LF.	0.29 AC.	26	102.2 LF.	161.9 LF.	0.39 AC.	44	75 LF.	150 LF.	0.26 AC.	14	68.5 LF.	150 LF.	0.24 AC.	32	82.1 LF.	150 LF.	0.28 AC.	38	95 LF.	153 LF.	0.33 AC.	56	94.9 LF.	165 LF.	0.36 AC.	74	95 LF.	165 LF.	0.36 AC.	8	75 LF.	165 LF.	0.30 AC.	26	75 LF.	165 LF.	0.28 AC.	44	75 LF.	165 LF.	0.28 AC.	
10	80.4 LF.	150 LF.	0.28 AC.	27	102.1 LF.	160.9 LF.	0.38 AC.	45	89.4 LF.	150 LF.	0.31 AC.	15	68.5 LF.	150 LF.	0.24 AC.	33	81.9 LF.	150 LF.	0.28 AC.	39	98.6 LF.	153 LF.	0.34 AC.	57	110.3 LF.	165 LF.	0.42 AC.	75	98 LF.	165 LF.	0.37 AC.	9	124 LF.	165 LF.	0.53 AC.	27	75 LF.	165 LF.	0.28 AC.					
11	80.4 LF.	150 LF.	0.28 AC.	28	92.2 LF.	153.8 LF.	0.32 AC.	46	138.9 LF.	150 LF.	0.46 AC.	16	67 LF.	150 LF.	0.23 AC.	34	81.9 LF.	150 LF.	0.28 AC.	40	95 LF.	153 LF.	0.33 AC.	58	95 LF.	165 LF.	0.36 AC.	76	95 LF.	165 LF.	0.36 AC.	10	123.5 LF.	165 LF.	0.52 AC.	28	75 LF.	165 LF.	0.28 AC.					
12	80.4 LF.	150 LF.	0.28 AC.	29	75 LF.	150 LF.	0.26 AC.	COBALT COVE				17	67 LF.	150 LF.	0.23 AC.	35	81.9 LF.	150 LF.	0.28 AC.	41	95 LF.	153 LF.	0.34 AC.	59	97.8 LF.	165 LF.	0.37 AC.	77	111 LF.	165 LF.	0.42 AC.	11	136 LF.	165 LF.	0.59 AC.	29	75 LF.	165 LF.	0.31 AC.					
13	80.4 LF.	150 LF.	0.28 AC.	30	75 LF.	150 LF.	0.26 AC.	LOT#	LOT WIDTH	LOT DEPTH	AREA	18	67 LF.	150 LF.	0.23 AC.	36	81.9 LF.	150 LF.	0.28 AC.	42	95.8 LF.	153 LF.	0.34 AC.	60	95 LF.	165 LF.	0.36 AC.	78	113.9 LF.	170 LF.	0.44 AC.	12	122.8 LF.	165 LF.	0.51 AC.	30	75 LF.	165 LF.	0.33 AC.					
14	80.5 LF.	150 LF.	0.28 AC.	31	75 LF.	150 LF.	0.26 AC.	1	71.1 LF.	150 LF.	0.27 AC.	19	67 LF.	150 LF.	0.23 AC.	37	81.9 LF.	150 LF.	0.28 AC.	43	94.7 LF.	165 LF.	0.36 AC.	61	95 LF.	165 LF.	0.36 AC.	79	100.4 LF.	170 LF.	0.39 AC.	13	75 LF.	165 LF.	0.31 AC.	31	75 LF.	165 LF.	0.29 AC.					
15	75 LF.	150 LF.	0.26 AC.	32	77.5 LF.	150 LF.	0.26 AC.	2	70.2 LF.	150 LF.	0.24 AC.	20	68.5 LF.	150 LF.	0.24 AC.	38	79.6 LF.	150 LF.	0.28 AC.	44	95 LF.	165 LF.	0.36 AC.	62	121.9 LF.	189.6 LF.	0.87 AC.	80	100.4 LF.	170 LF.	0.39 AC.	14	75 LF.	165 LF.	0.33 AC.	32	127.6 LF.	165 LF.	0.65 AC.					
16	75 LF.	150 LF.	0.26 AC.	33	82.6 LF.	150 LF.	0.28 AC.	3	67 LF.	150 LF.	0.23 AC.	21	68.5 LF.	150 LF.	0.24 AC.	39	68.5 LF.	150 LF.	0.24 AC.	45	95 LF.	165 LF.	0.36 AC.	63	135 LF.	188.5 LF.	0.53 AC.	81	113.9 LF.	170 LF.	0.46 AC.	15	78.3 LF.	165 LF.	0.31 AC.	33	173.4 LF.	165 LF.	0.69 AC.					
17	75 LF.	150 LF.	0.26 AC.	34	82.7 LF.	150 LF.	0.29 AC.	4	67 LF.	150 LF.	0.23 AC.	22	67 LF.	150 LF.	0.23 AC.	40	68.5 LF.	150 LF.	0.24 AC.	46	95 LF.	165 LF.	0.36 AC.	64	95 LF.	165 LF.	0.36 AC.					16	76.4 LF.	165 LF.	0.29 AC.	34	127.6 LF.	165 LF.	0.65 AC.					
18	224 LF.	150 LF.	0.55 AC.	35	82.6 LF.	150 LF.	0.28 AC.	5	68.5 LF.	150 LF.	0.24 AC.	23	88.8 LF.	150 LF.	0.32 AC.	41	67 LF.	150 LF.	0.23 AC.	47	95 LF.	165 LF.	0.42 AC.	65	95 LF.	165 LF.	0.36 AC.					17	75 LF.	165 LF.	0.28 AC.	35	75 LF.	165 LF.	0.29 AC.					

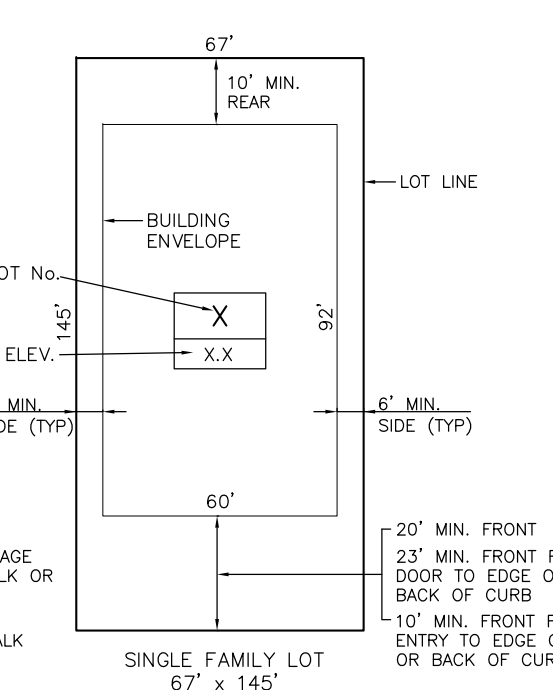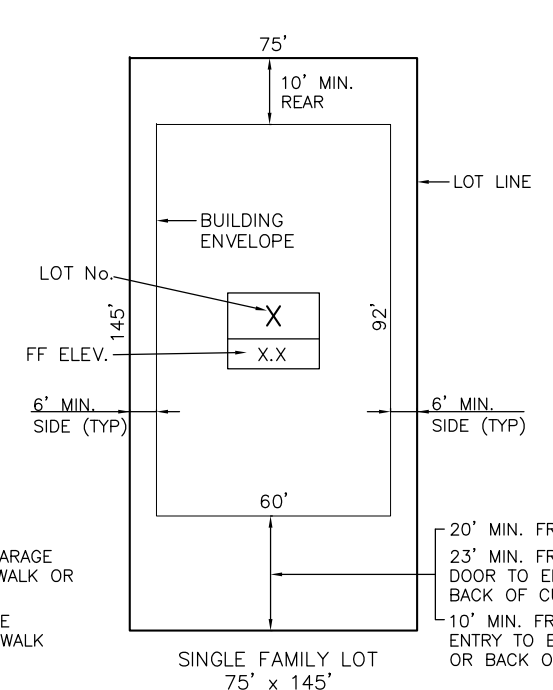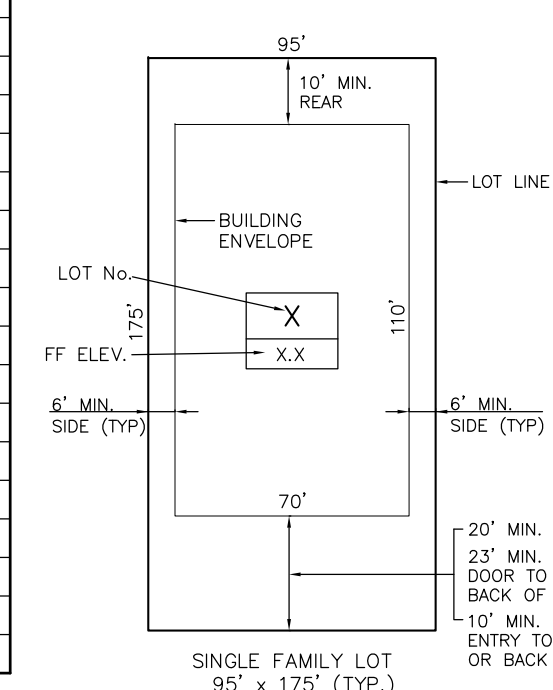

14 RECORD DRAWING REVISION - PAVING, GRADING, AND DRAINAGE - PHASE 2B
10 REVISED FOR UTILITIES CONVEYANCE

5 REVISED DRAINAGE PER CLIENT AND ENGINEER
4 REVISED PER ENGINEER & OWNER
4 REVISED FOR INSUBSTANTIAL CHANGE
2 REVISED PER ENGINEER & COUNTY COMMENTS
1 REVISED PER COLLIER COUNTY COMMENTS

DATE: 09/5/02
DRAWN BY: TOSI LVA/C/ENR/0442/150-QuarryPhase2/Rev14-corrPaving&Drainage/044215011.dwg

12/14/06 MPO/2348
12/14/06 MPO/2348

10/5/06 RRM/1482
6/3/06 RRM/1482
5/4/06 RRM/1482
11/29/05 RRM/1482
9/28/05 RRM/1482

DATE: 09/5/02
DRAWN BY: TOSI LVA/C/ENR/0442/150-QuarryPhase2/Rev14-corrPaving&Drainage/044215011.dwg

ACTIVITY
DESIGNED BY: LMG/894
DRAWN BY: RRM/1482
CHECKED BY: RRM/1482
CONTRACT ADMIN. BY:

INITIALS/EMP. NO.
LMG/894
RRM/1482
RRM/1482

DATE
4/15/05
4/15/05

WM APPROVED BY:

WilsonMiller
Planners • Engineers • Ecologists • Surveyors • Landscape Architects • Transportation Consultants
WilsonMiller, Inc. - FL Lic # LC-000170
WilsonMiller, Inc. - Certificate of Authorization #01



Naples • Fort Myers • Sarasota • Bradenton • Tampa • Tallahassee
4571 Colonial Boulevard, Suite 100 • Fort Myers, Florida 33912 • Phone 239-939-1020 • Fax 239-939-3412 • Web Site www.wilsonmiller.com




CLIENT: CENTEX HOMES
PROJECT: THE QUARRY PHASE 2

DATE: FEB. 2005
HORIZONTAL SCALE: 1" = 80'
VERTICAL SCALE: N/A
SEC: TWP: RGE: 14, 23 48S 26E

TITLE: LOT GRADING PLAN (QUARRY SHORES)
CROSS REFERENCE FILE NO.: D-0442-48
PROJECT NUMBER: N0442-509-000

LISA M. GORGANO
LICENSE # 59318
INDEX NUMBER: D-0442-150
SHEET NUMBER: 11 OF 38

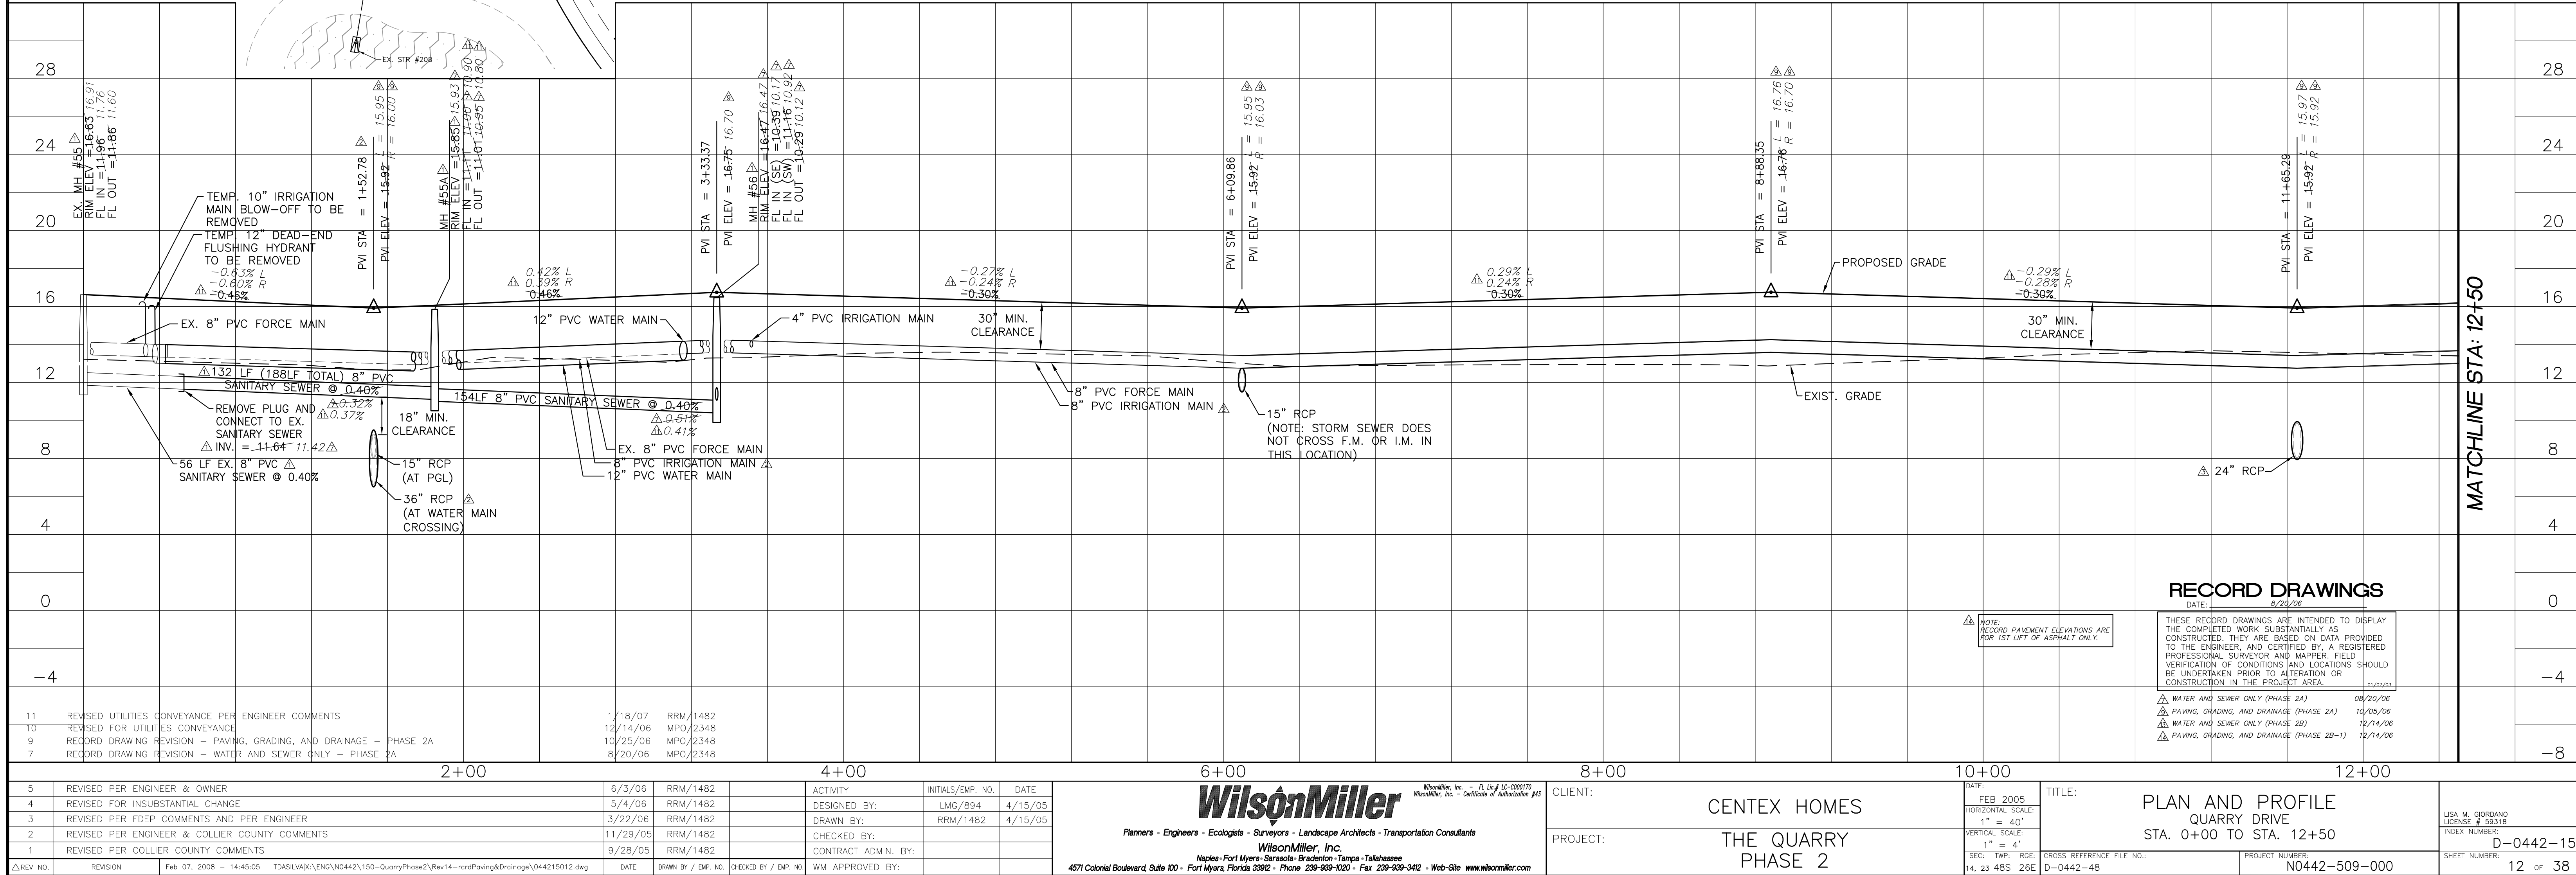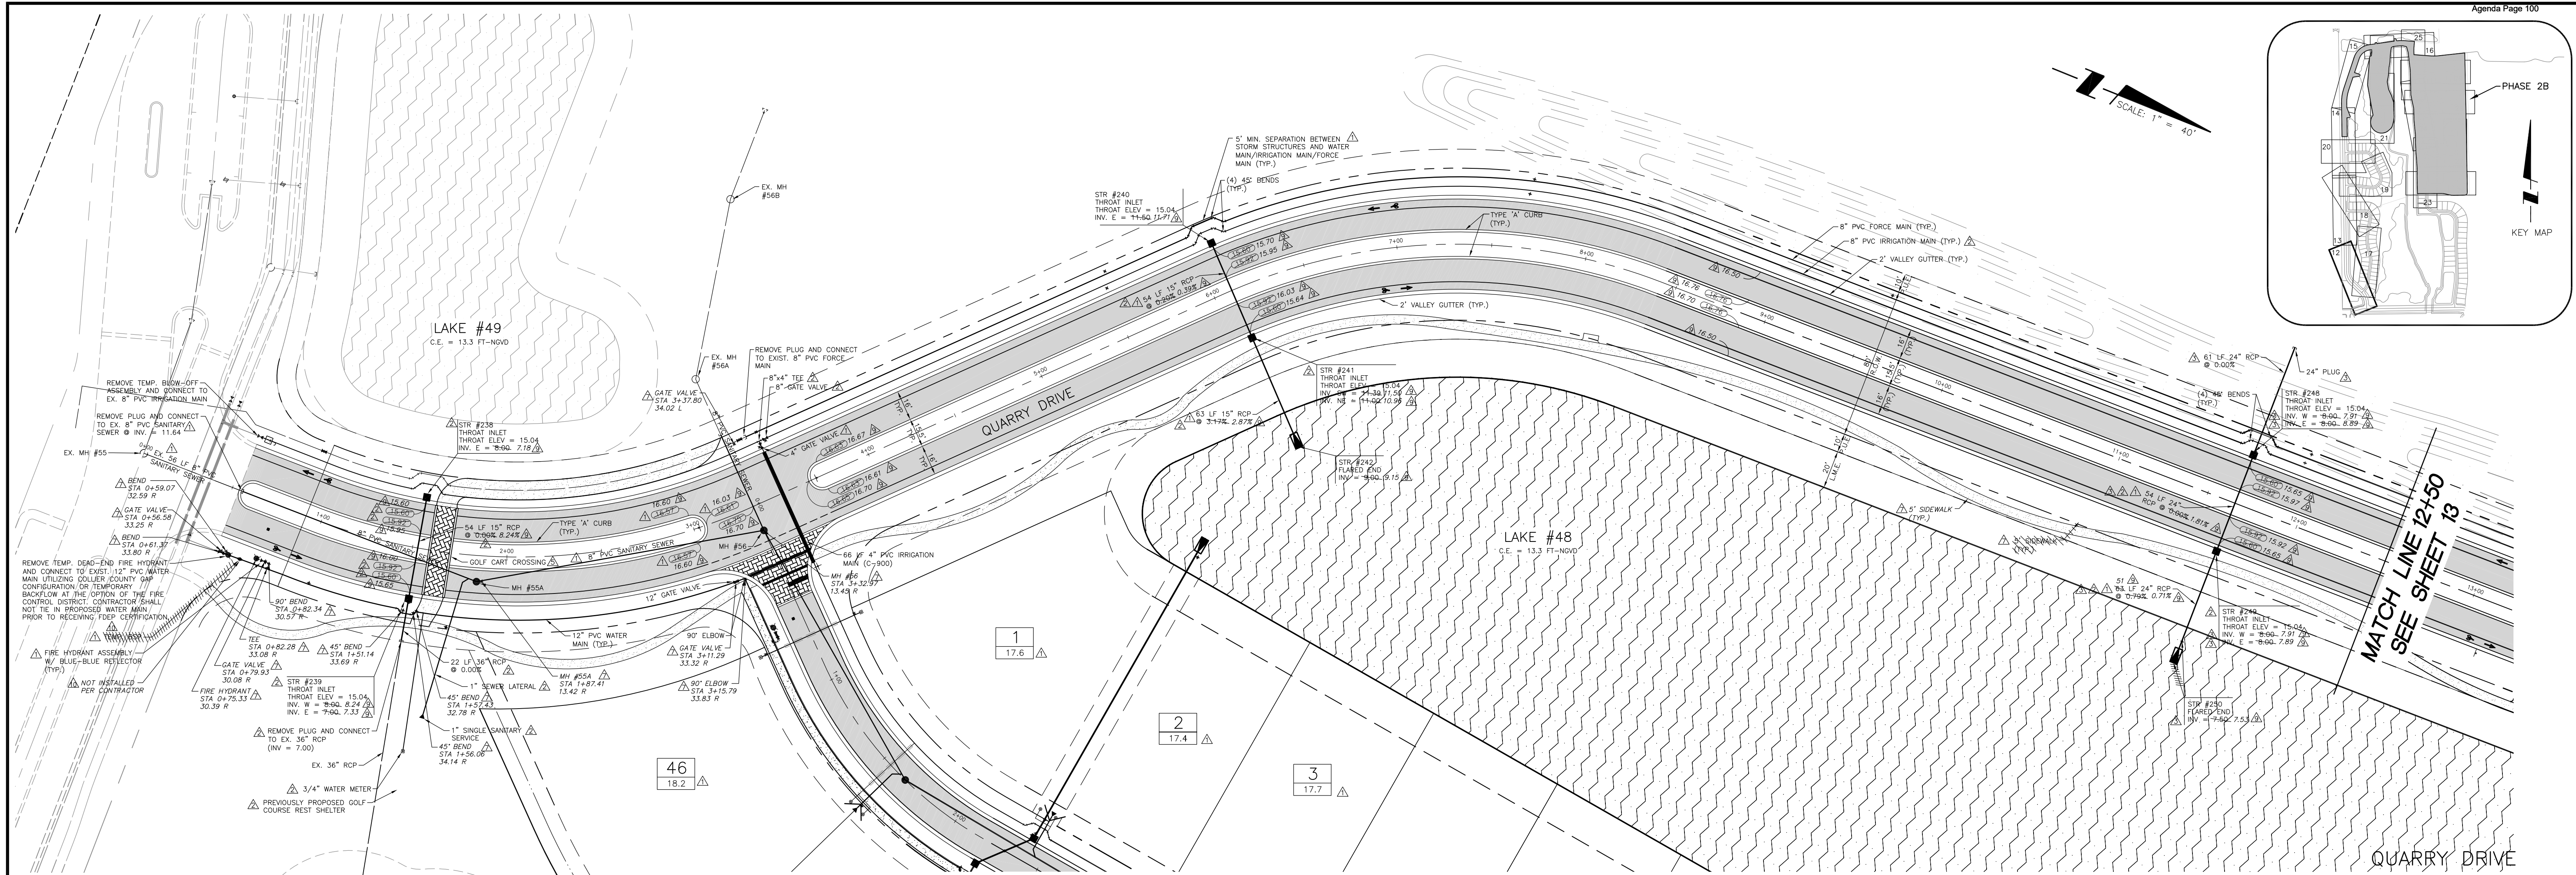

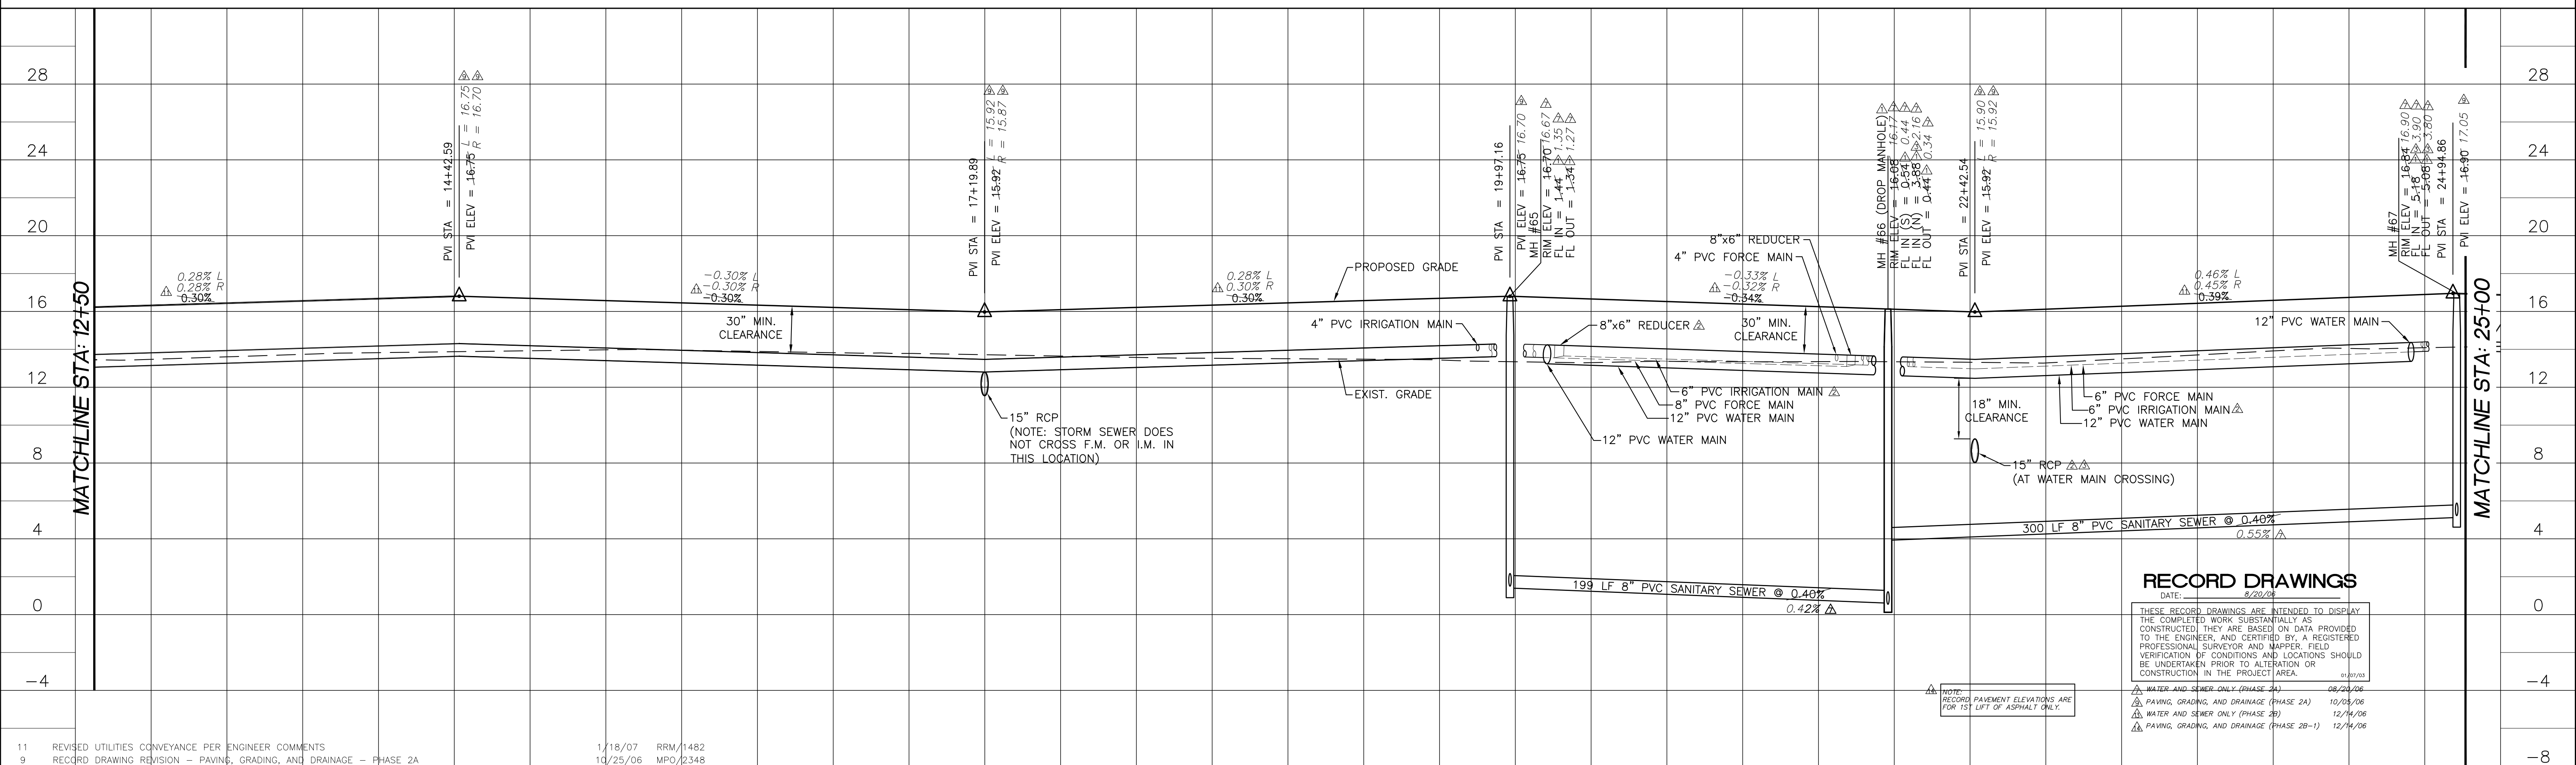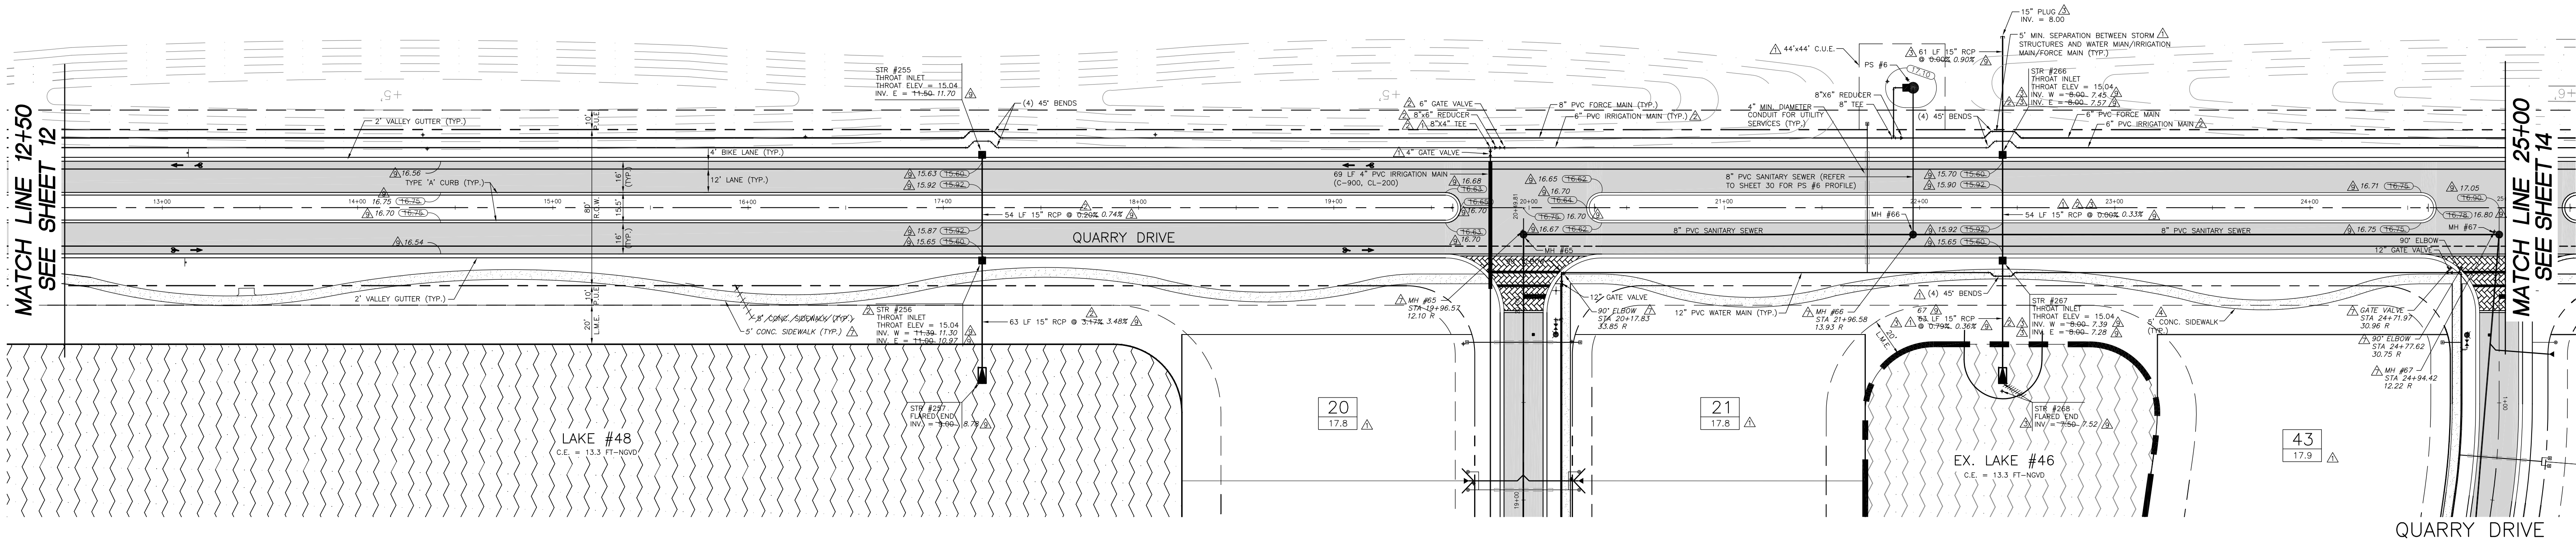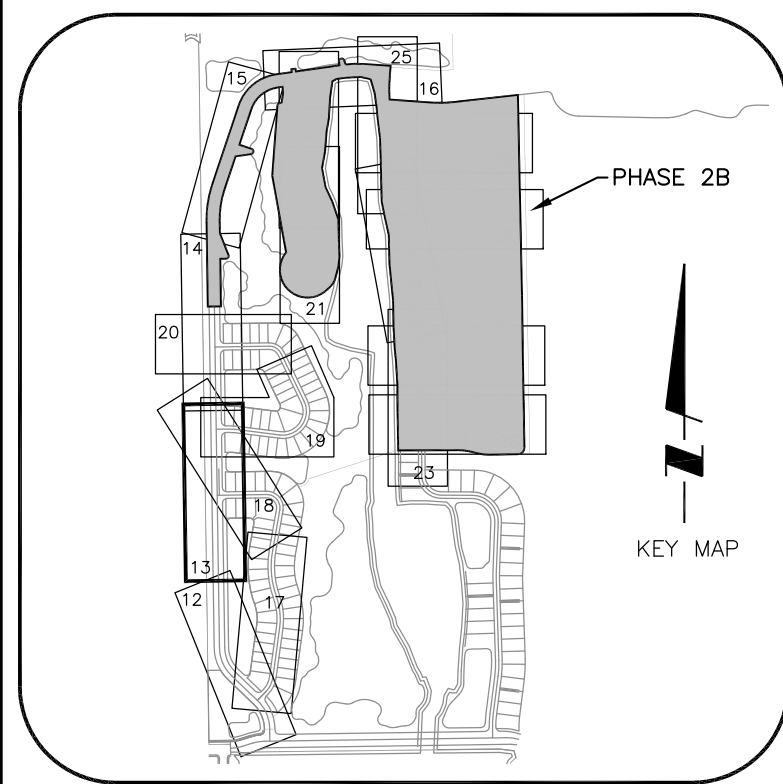

RECORD DRAWINGS

DATE: 8/20/06

THESE RECORD DRAWINGS ARE INTENDED TO DISPLAY THE COMPLETED WORK SUBSTANTIALLY AS CONSTRUCTED. THEY ARE BASED ON DATA PROVIDED TO THE ENGINEER, AND CERTIFIED BY A REGISTERED PROFESSIONAL SURVEYOR AND MAPPER. FIELD VERIFICATION OF CONDITIONS AND LOCATIONS SHOULD BE UNDERTAKEN PRIOR TO ALTERATION OR CONSTRUCTION IN THE PROJECT AREA.

DATE: 8/20/06	08/20/06
PAVING, GRADING, AND DRAINAGE (PHASE 2A)	10/03/06
WATER AND SEWER ONLY (PHASE 2B)	12/14/06
PAVING, GRADING, AND DRAINAGE (PHASE 2B-1)	12/14/06




NOTE: RECORD PAVEMENT ELEVATIONS ARE FOR 15' LIFT OF ASPHALT ONLY.


11	REVISED UTILITIES CONVEYANCE PER ENGINEER COMMENTS	1/18/07	RRM/1482
9	RECORD DRAWING REVISION - PAVING, GRADING, AND DRAINAGE - PHASE 2A	10/25/06	MPO/2348


7	RECORD DRAWING REVISION - WATER AND SEWER ONLY - PHASE 2A	8/14/06	MPO/2348	ACTIVITY	INITIALS/EMP. NO.	DATE
4	REVISED FOR INSUBSTANTIAL CHANGE	5/4/06	RRM/1482	DESIGNED BY:	LMG/894	4/15/05
3	REVISED PER FDEP COMMENTS AND PER ENGINEER	3/22/06	RRM/1482	DRAWN BY:	RRM/1482	4/15/05
2	REVISED PER ENGINEER & COUNTY COMMENTS	11/29/05	RRM/1482	CHECKED BY:		
1	REVISED PER COLLIER COUNTY COMMENTS	9/28/05	RRM/1482	CONTRACT ADMIN. BY:		
ΔREV NO.	REVISION	Feb 07, 2008 - 15:04:39	TDAS\VA\X\ENG\N0442\150-QuarryPhase2\Rev14-rndPaving&Drainage\044215013.dwg	DATE	DRAWN BY / EMP. NO.	CHECKED BY / EMP. NO.



WilsonMiller
Planners • Engineers • Ecologists • Surveyors • Landscape Architects • Transportation Consultants
WilsonMiller, Inc.
Naples • Fort Myers • Sarasota • Bradenton • Tampa • Tallahassee
457 Colonial Boulevard Suite 100 • Fort Myers, Florida 33902 • Phone 239-939-1222 • Fax 239-939-3412 • Web Site www.wilsonmiller.com

CLIENT:	CENTEX HOMES
PROJECT:	THE QUARRY PHASE2
DATE:	FEB 2005
HORIZONTAL SCALE:	1" = 40'
VERTICAL SCALE:	1" = 4'
SEC. TWP. RGE:	14, 23 48S 26E
CROSS REFERENCE FILE NO.:	D-0442-48
TITLE:	PLAN AND PROFILE QUARRY DRIVE 12+50 TO 25+00
PROJECT NUMBER:	N0442-509-000
LISA M. GORDANO LICENSE # 59318 INDEX NUMBER:	D-0442-150
SHEET NUMBER:	13 OF 38

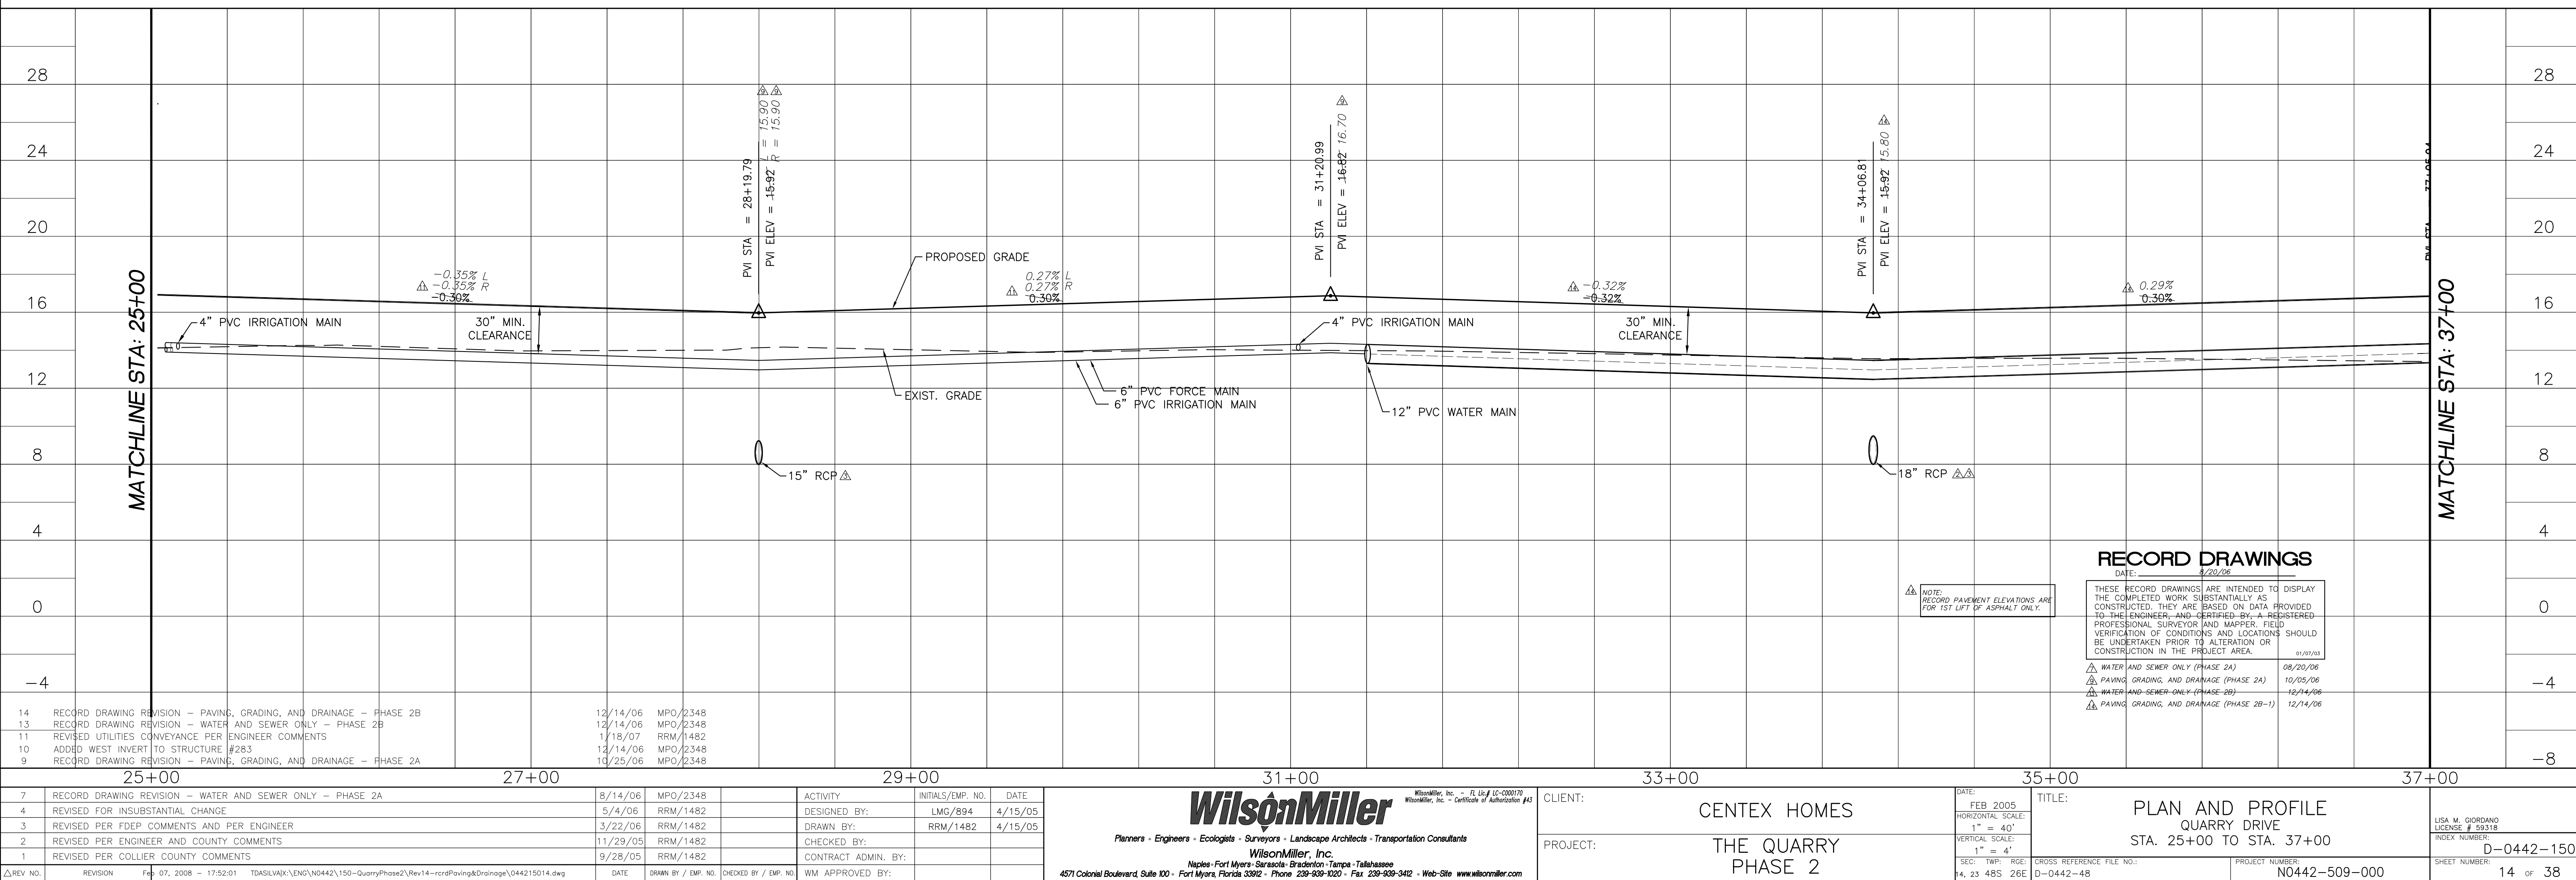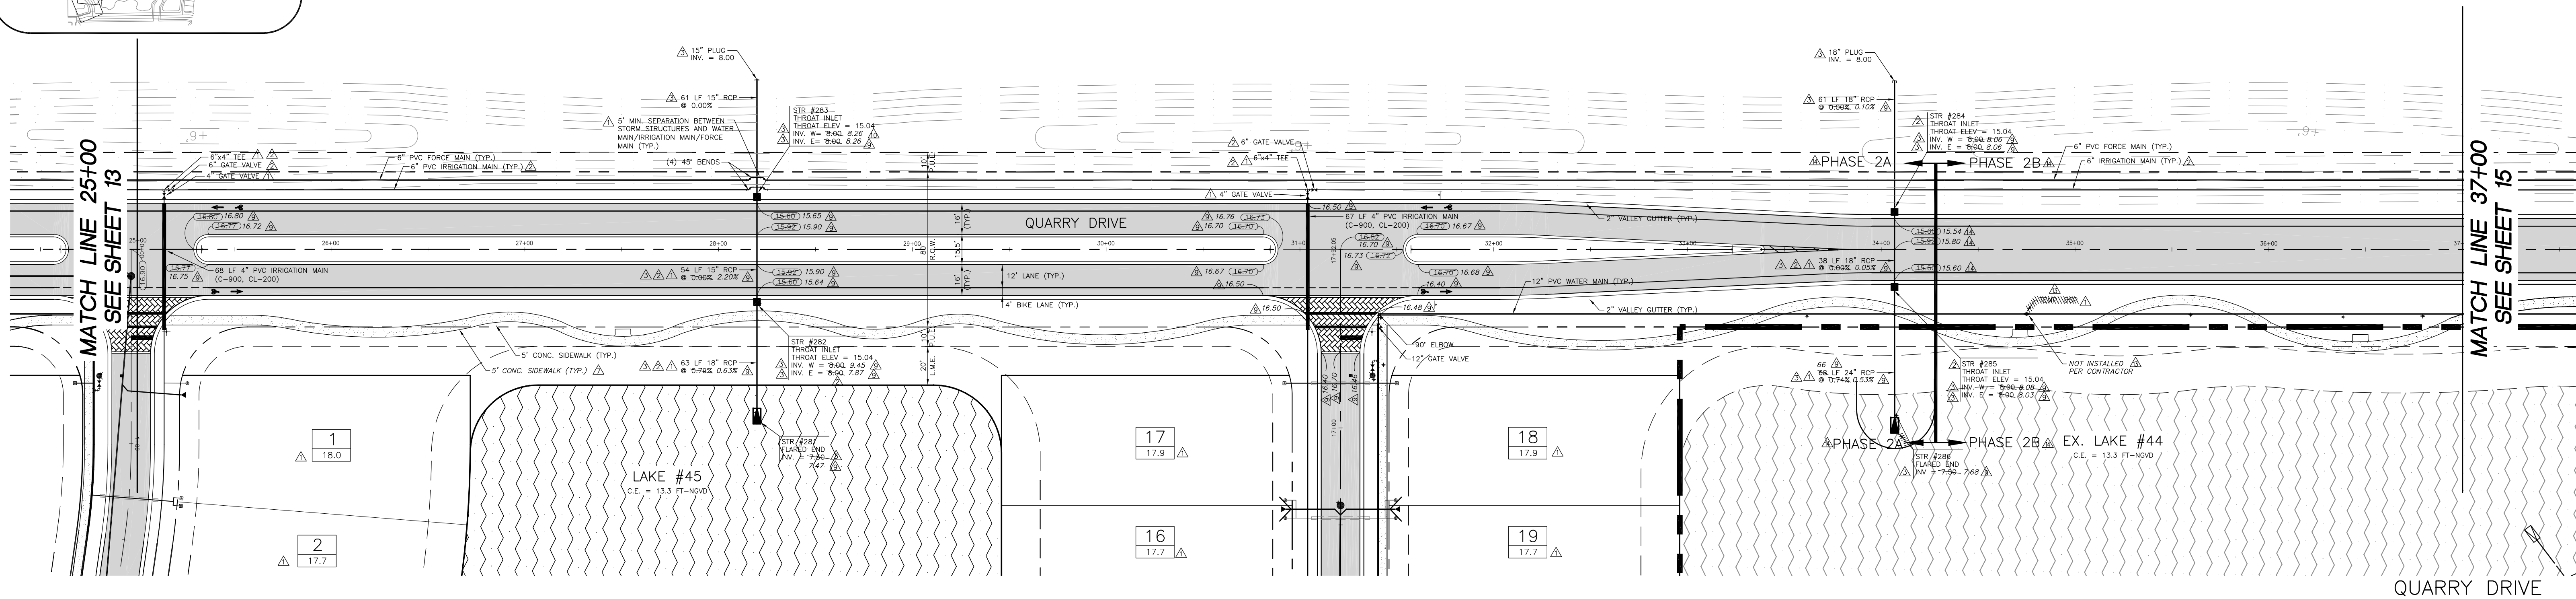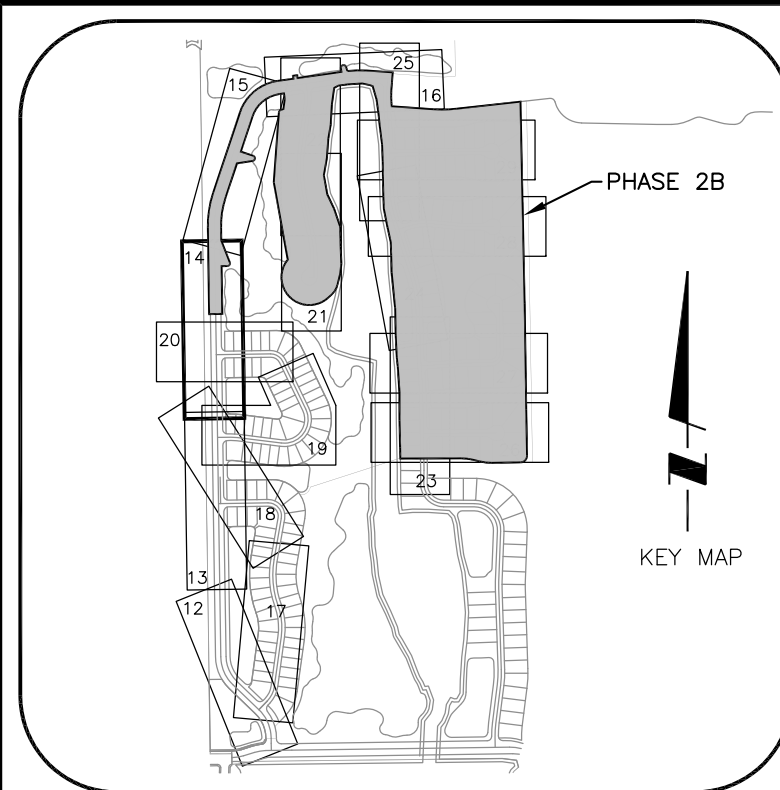


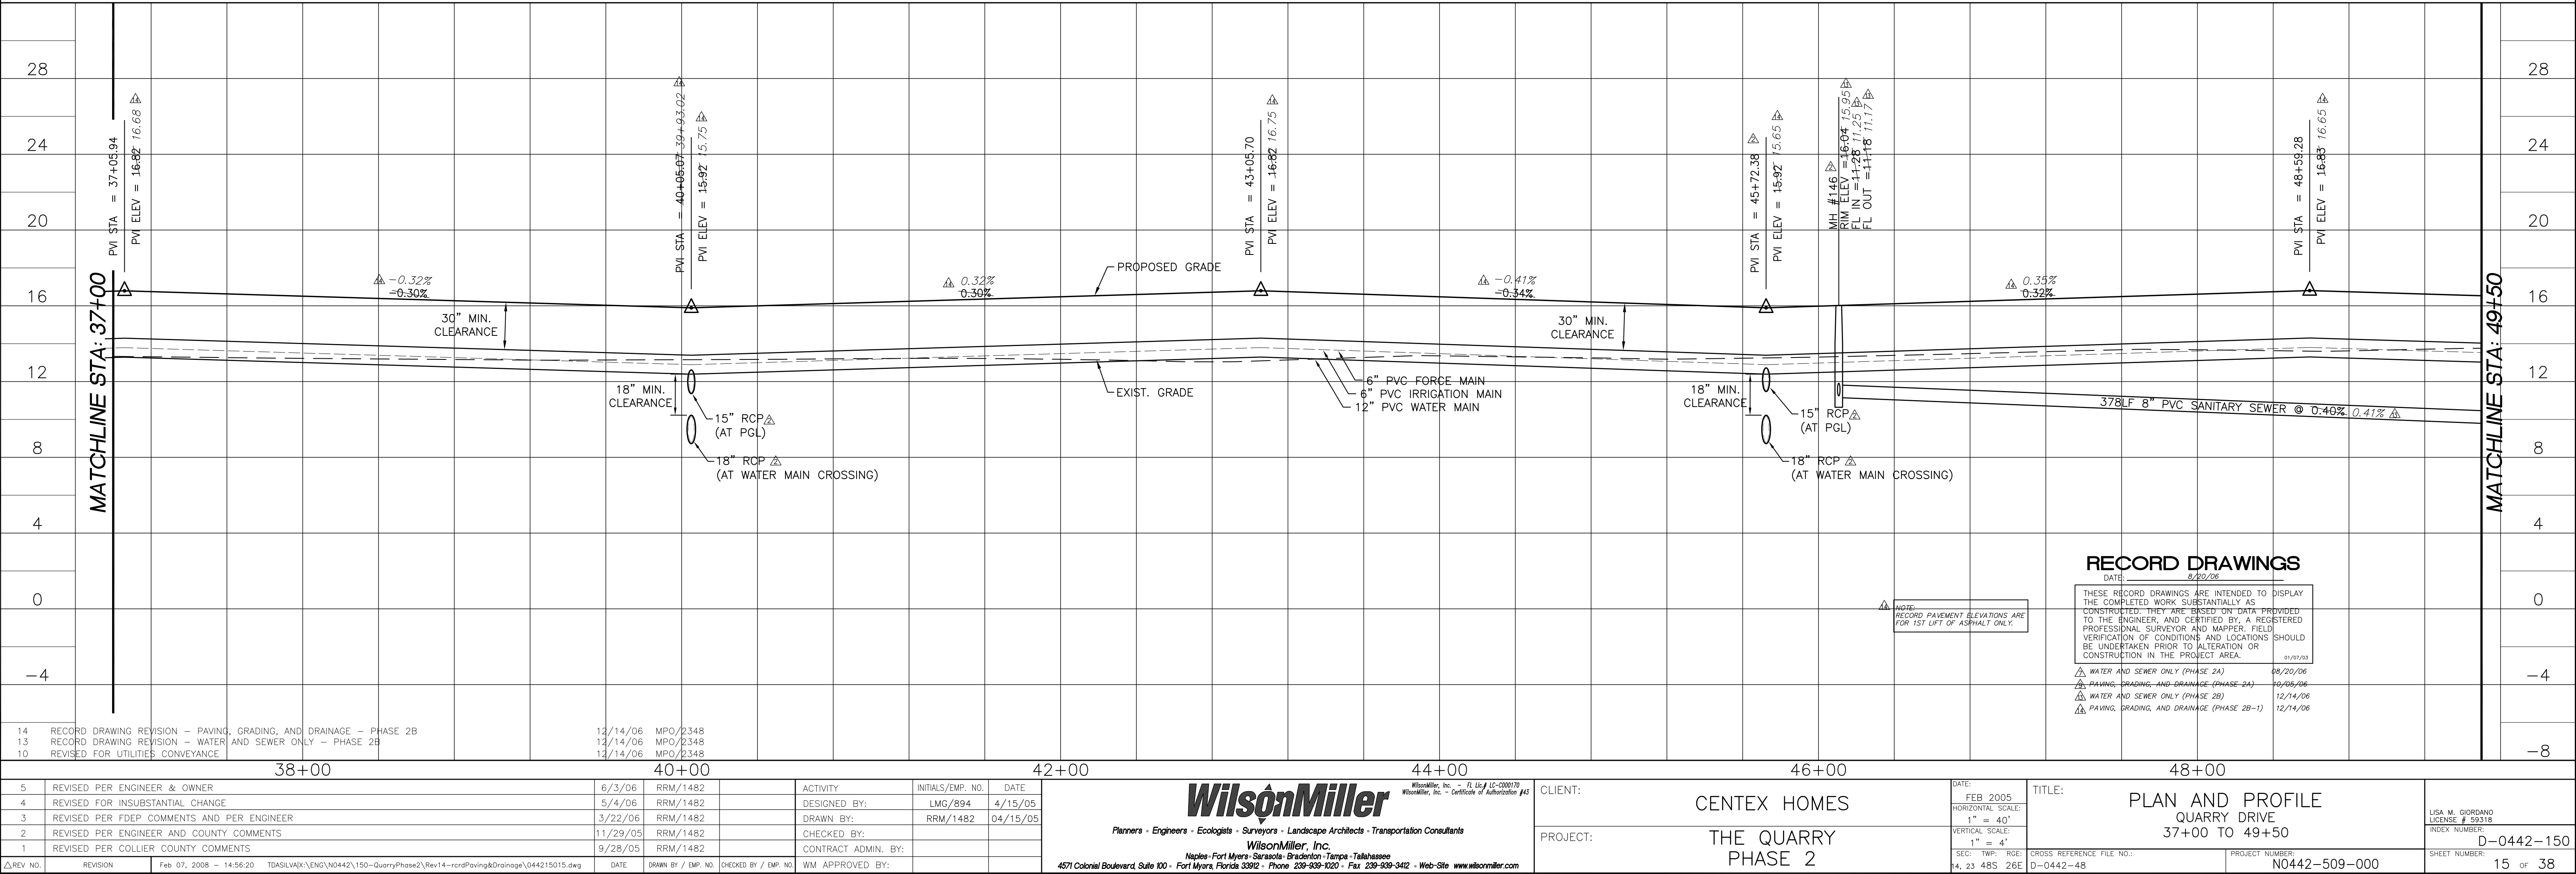

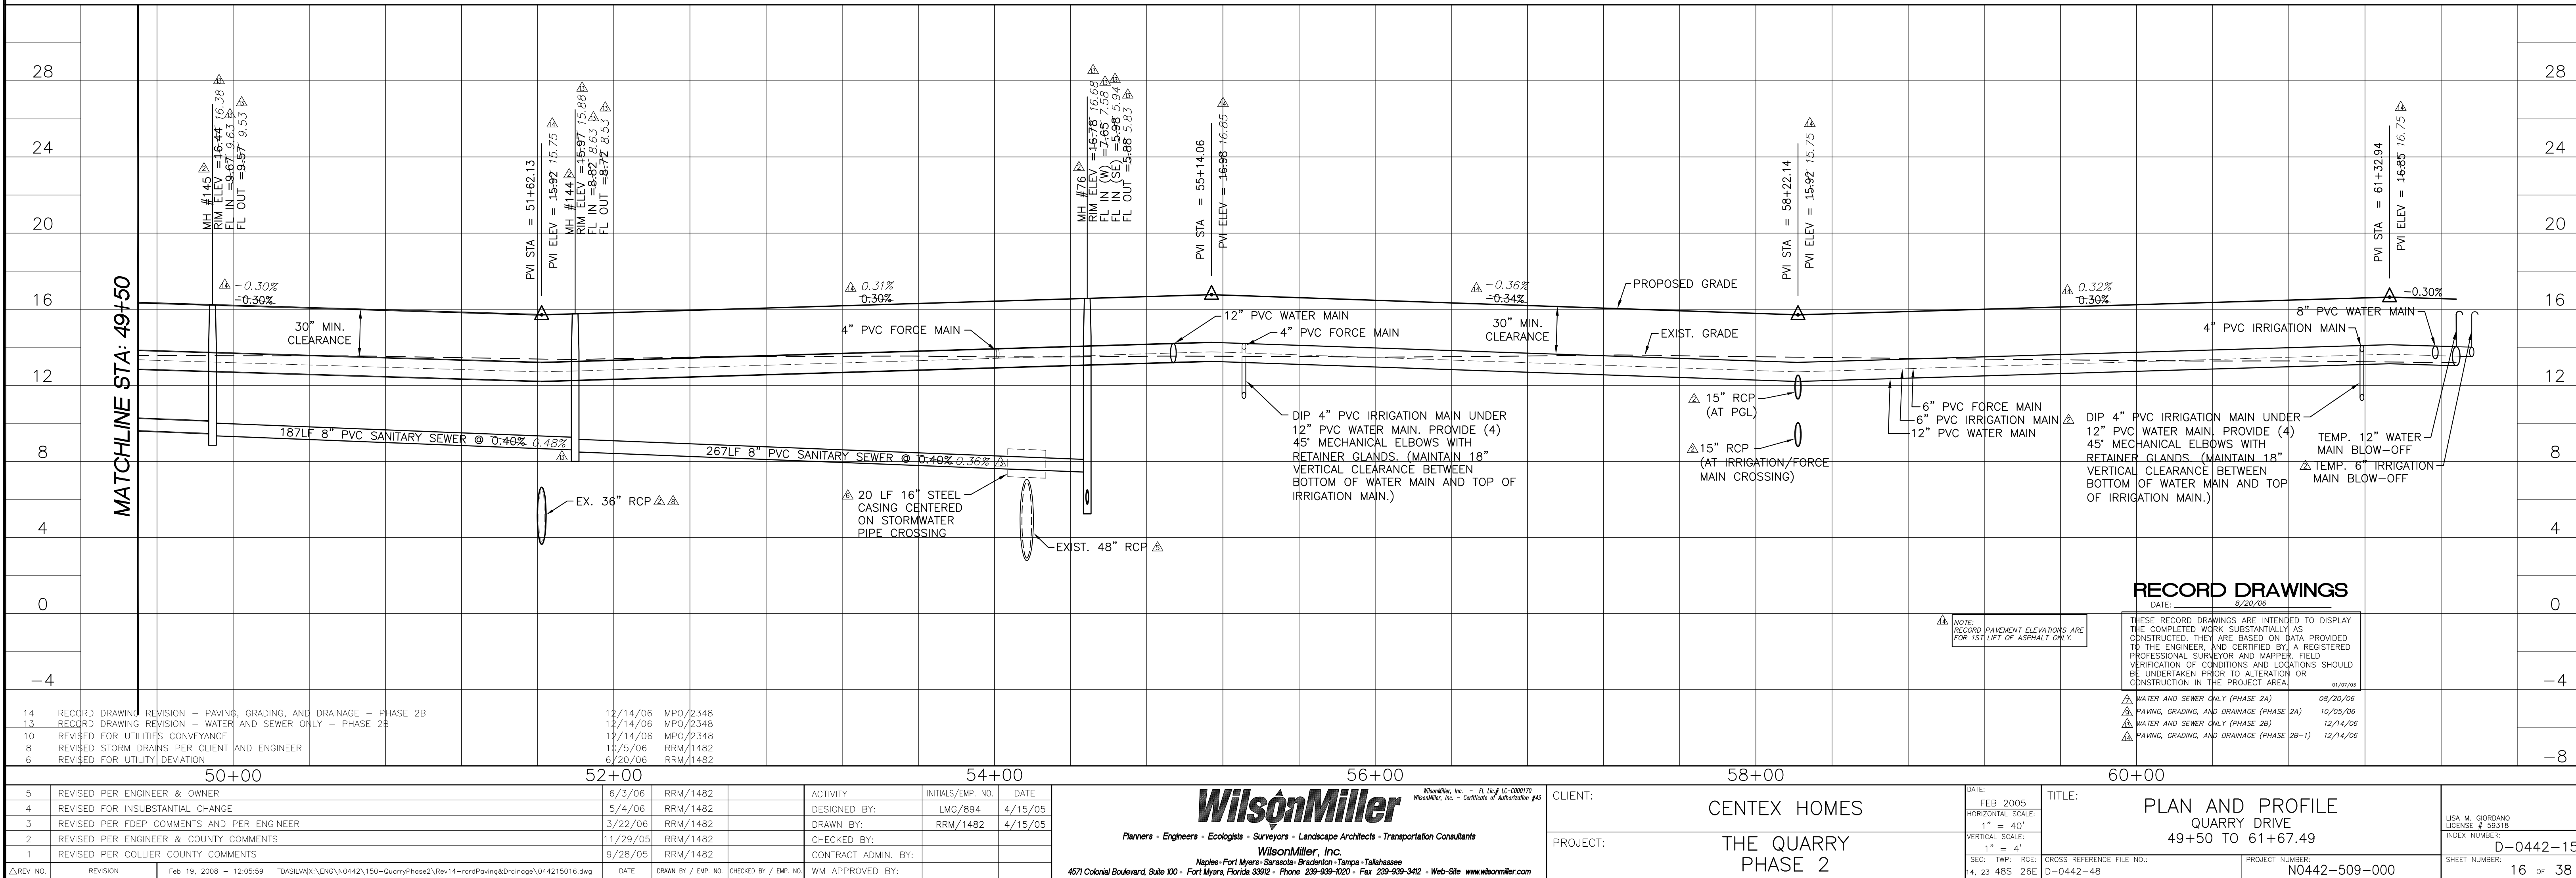

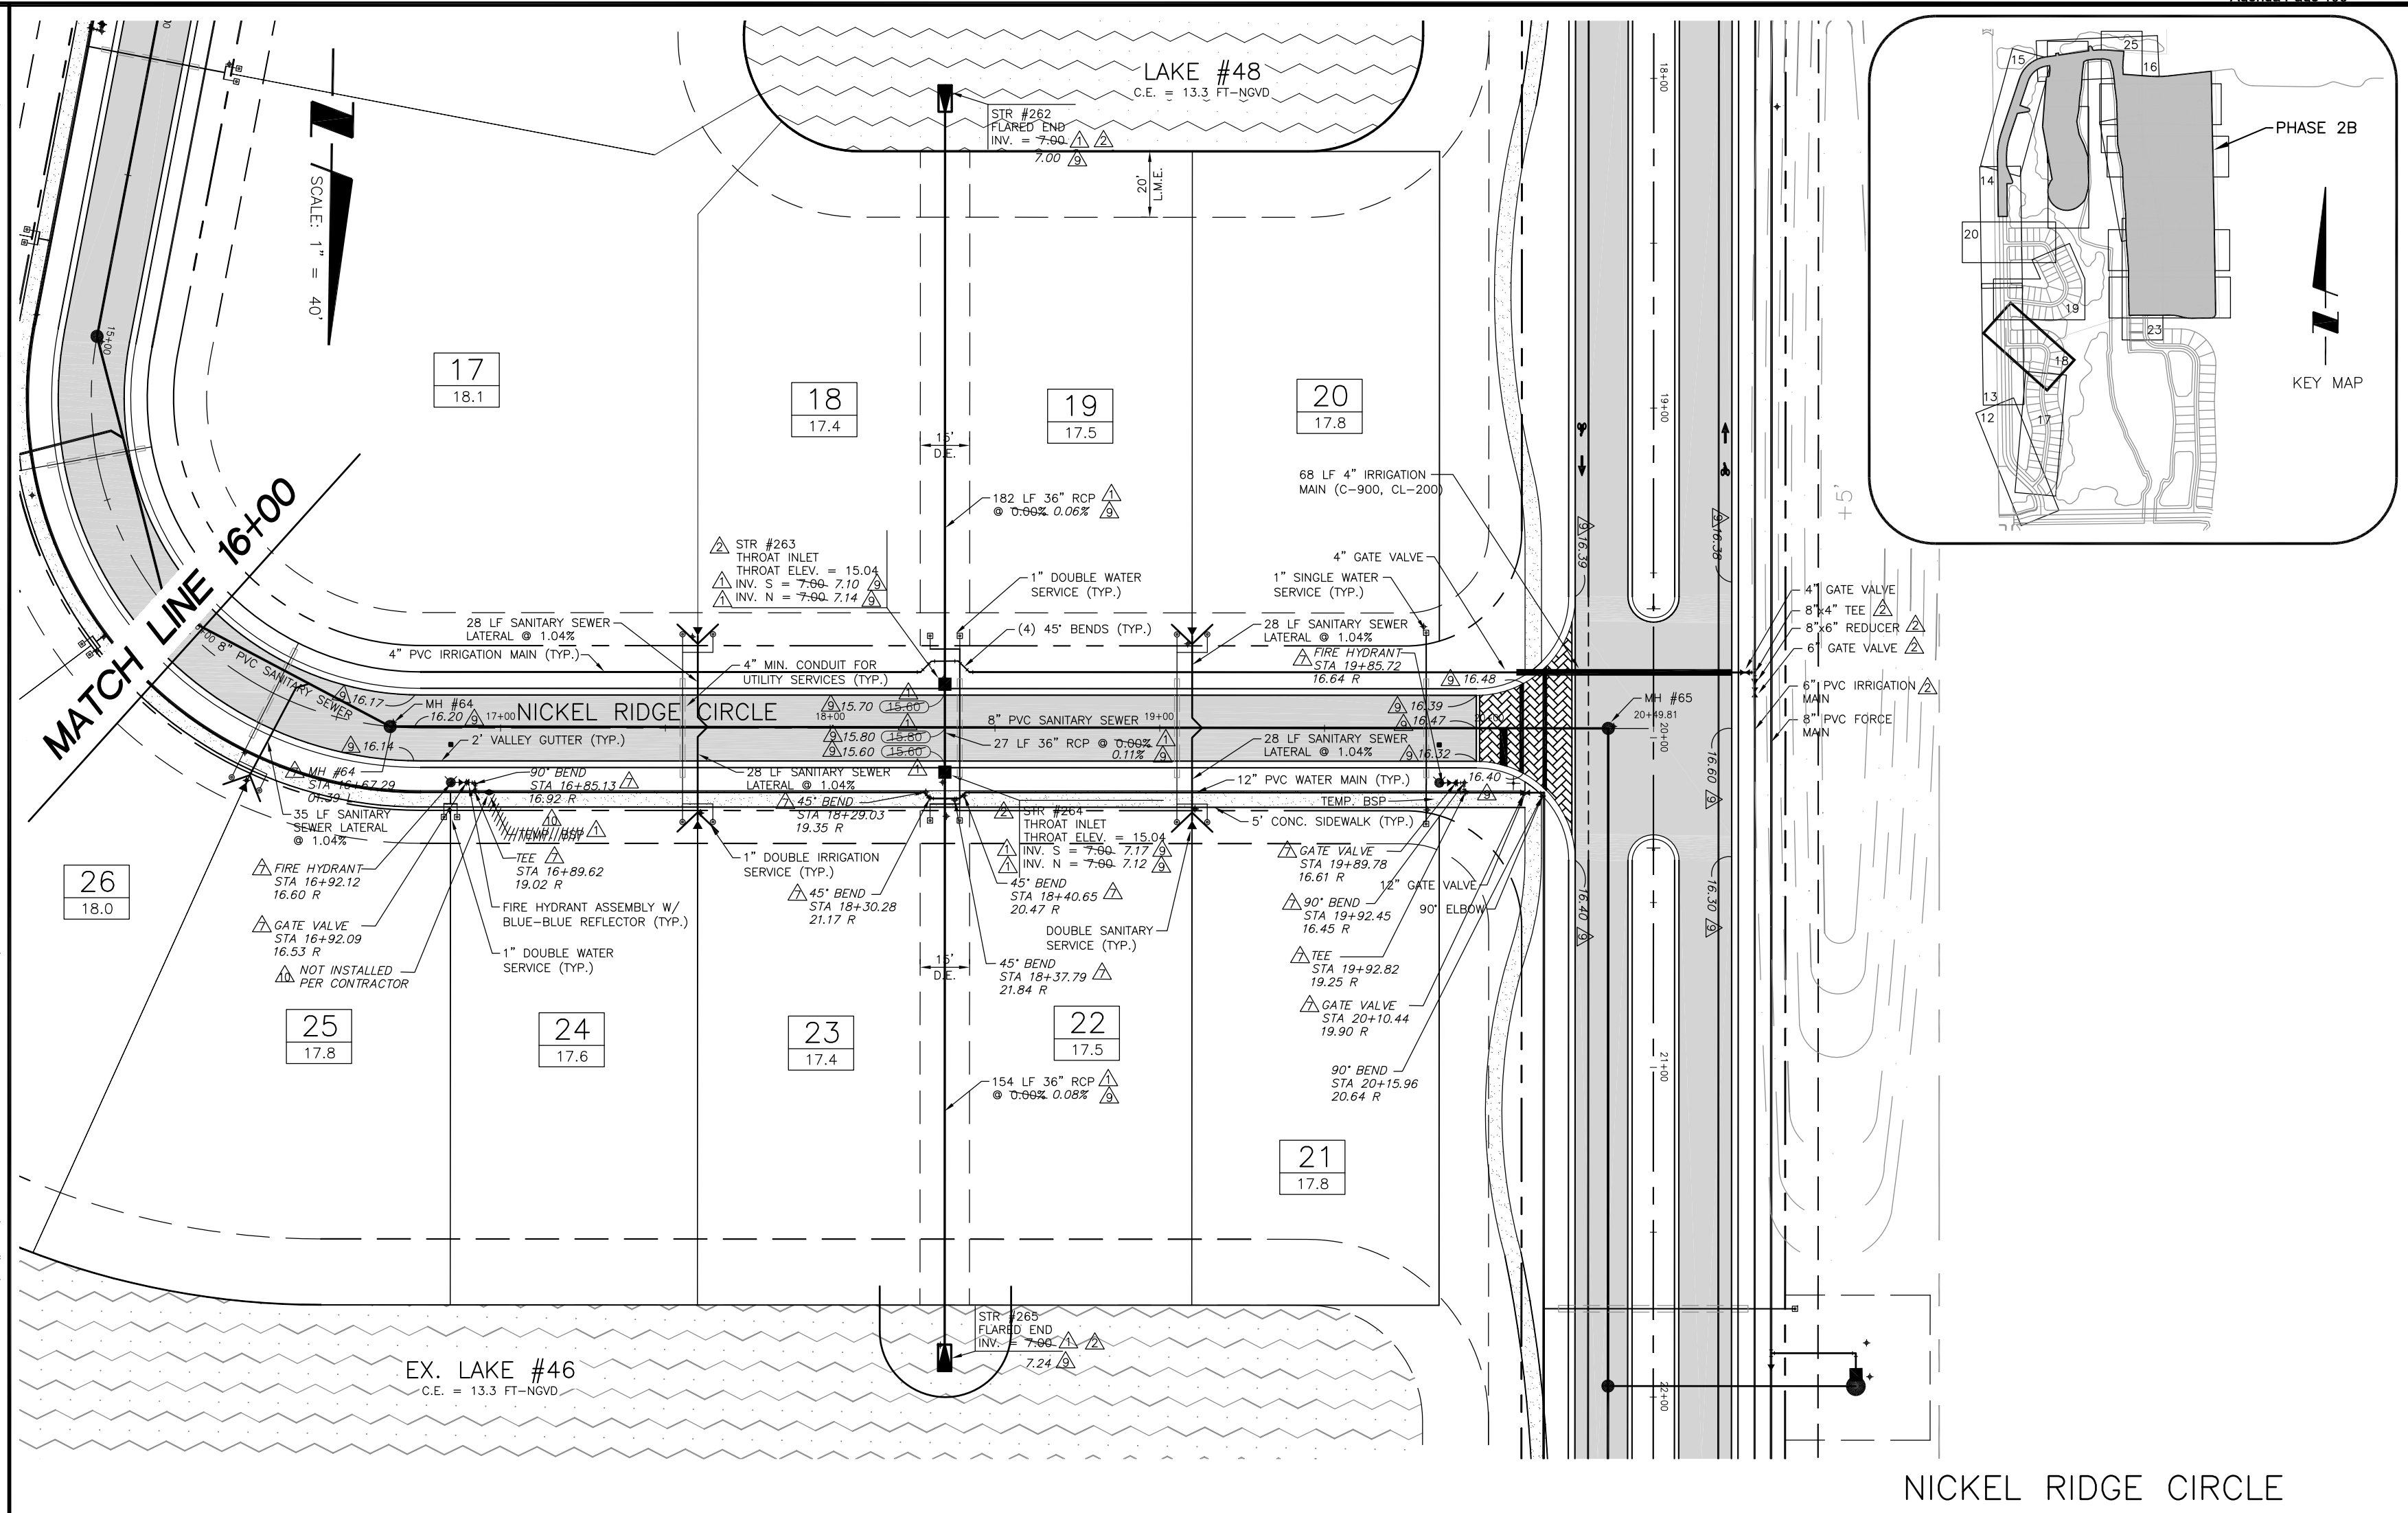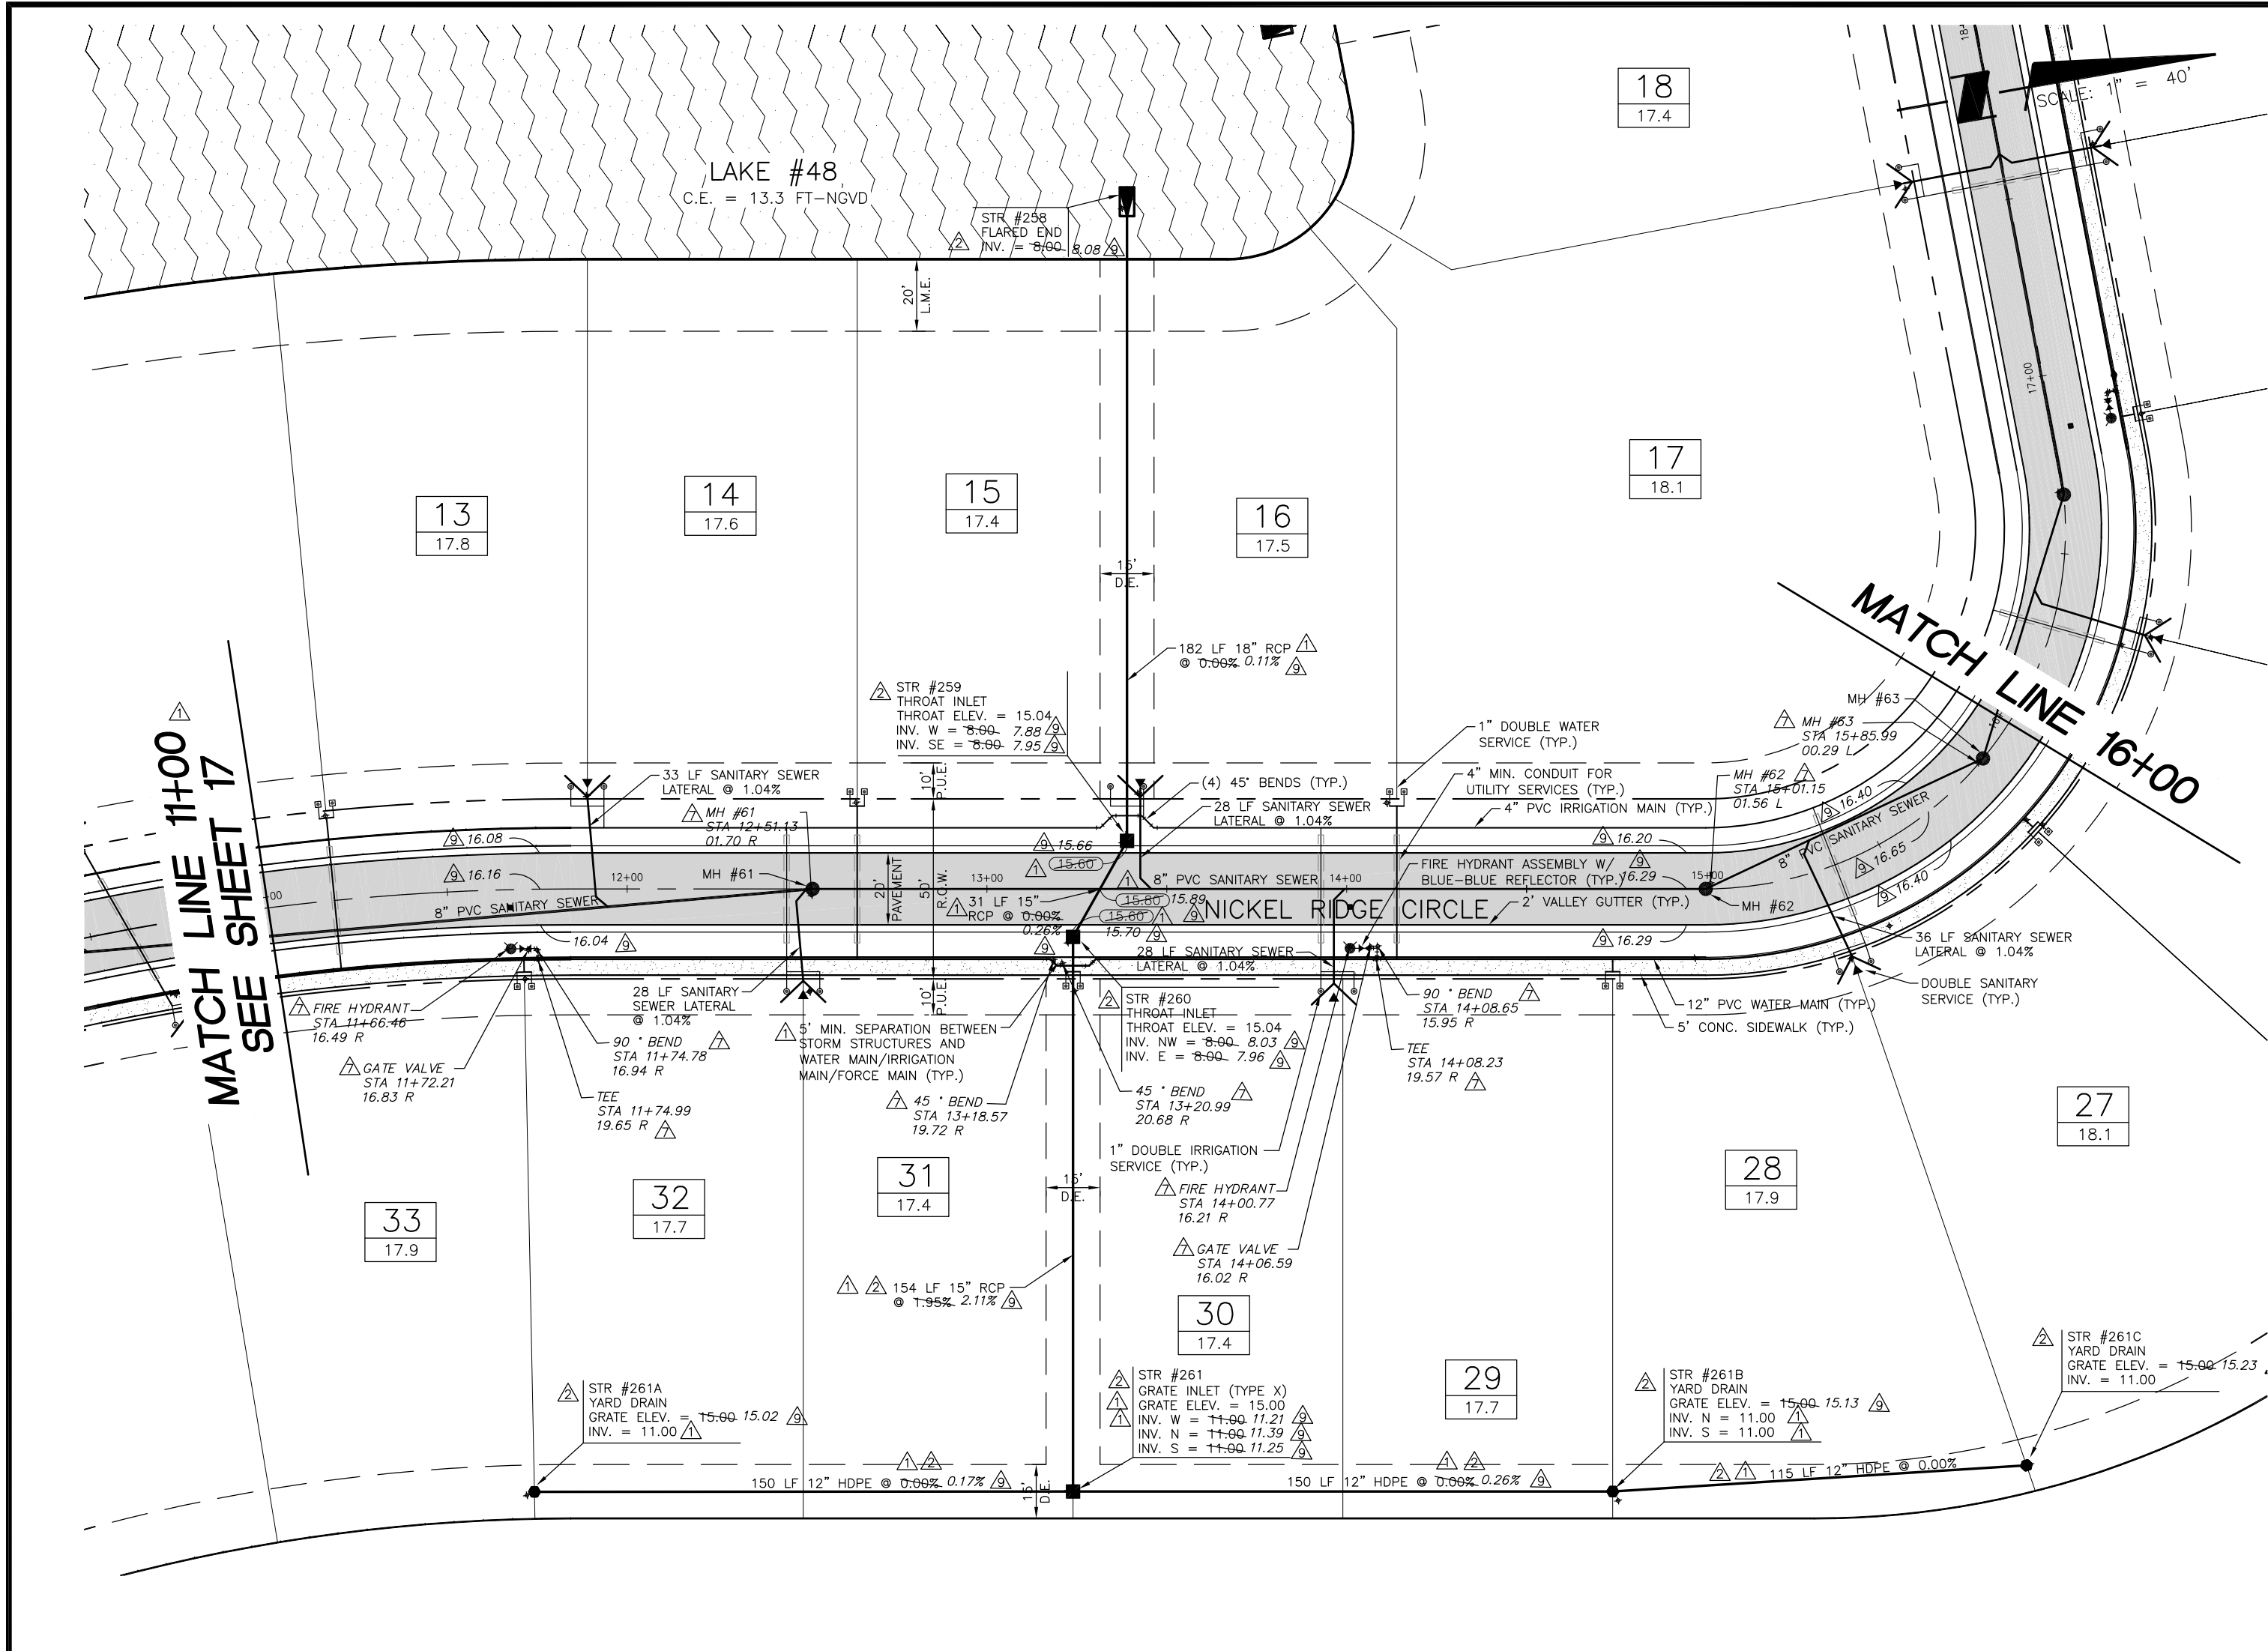

NICKEL RIDGE CIRCLE

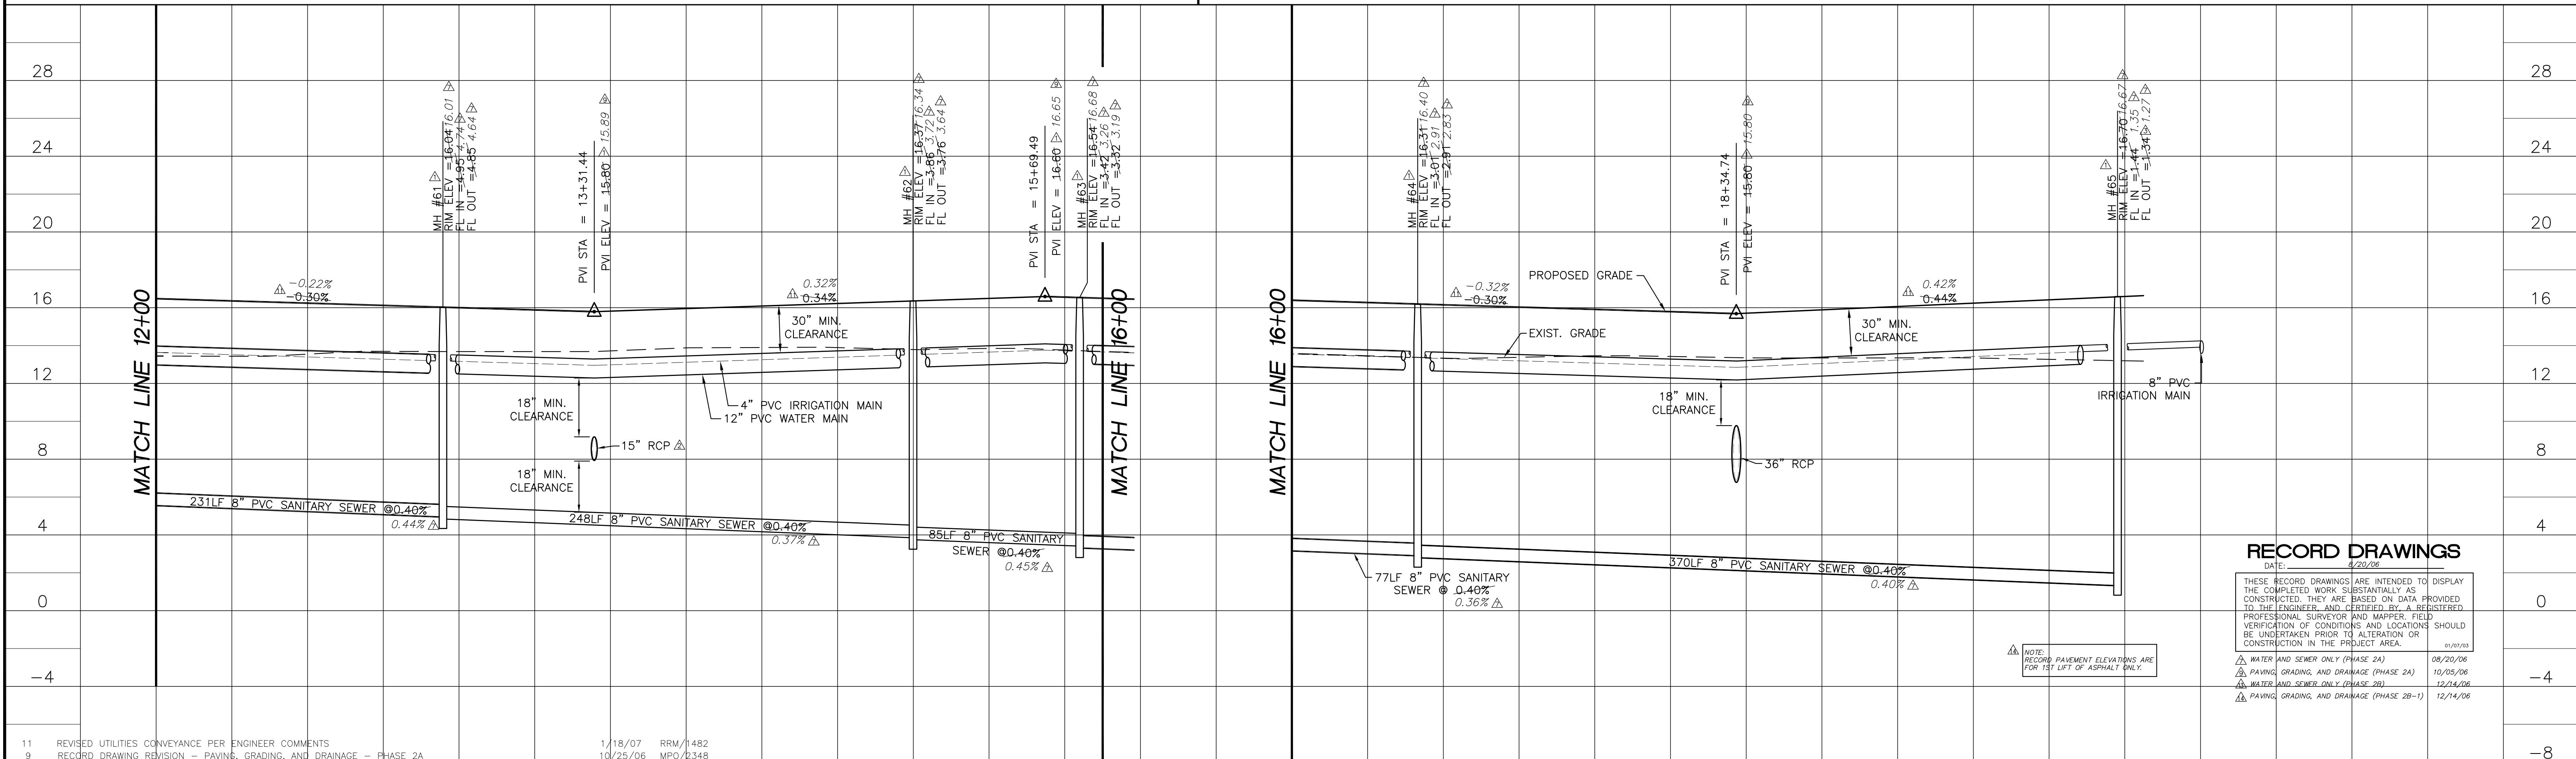

RECORD DRAWINGS

DATE: 8/20/06
 THESE RECORD DRAWINGS ARE INTENDED TO DISPLAY THE COMPLETED WORK SUBSTANTIALLY AS CONSTRUCTED. THEY ARE BASED ON DATA PROVIDED TO THE ENGINEER AND CERTIFIED BY A REGISTERED PROFESSIONAL SURVEYOR AND MAPPER. FIELD VERIFICATION OF CONDITIONS AND LOCATIONS SHOULD BE UNDERTAKEN PRIOR TO ALTERATION OR CONSTRUCTION IN THE PROJECT AREA.


NOTE: RECORD PAVEMENT ELEVATIONS ARE FOR 1ST LIFT OF ASPHALT ONLY.

11	REVISED UTILITIES CONVEYANCE PER ENGINEER COMMENTS	1/19/07	RRM/1482
9	RECORD DRAWING REVISION - PAVING, GRADING, AND DRAINAGE - PHASE 2A	10/25/06	MPO/2348
7	RECORD DRAWING REVISION - WATER AND SEWER ONLY - PHASE 2A	8/14/06	MPO/2348
4	REVISED FOR INSUBSTANTIAL CHANGE	5/4/06	RRM/1482
3	REVISED PER FDEP COMMENTS AND PER ENGINEER	3/22/06	RRM/1482
2	REVISED PER ENGINEER & COUNTY COMMENTS	11/29/05	RRM/1482
1	REVISED PER COLLIER COUNTY COMMENTS	9/28/05	RRM/1482
ΔREV NO.	REVISION	Feb. 07, 2008 - 14:48:37	TDASILVA\K\END\N0442\150-QuarryPhase2\Rev14-rordPaving&Drainage\044215018.dwg
DATE	DRAWN BY / EMP. NO.	CHECKED BY / EMP. NO.	WM APPROVED BY:
DATE	DESIGNED BY: LMG/894	4/15/04	
DATE	DRAWN BY: RRM/1482	4/15/05	
DATE	CHECKED BY:		
DATE	CONTRACT ADMIN. BY:		
DATE	WM APPROVED BY:		


WilsonMiller

Planners • Engineers • Ecologists • Surveyors • Landscape Architects • Transportation Consultants
 WilsonMiller, Inc.
 Naples • Fort Myers • Sarasota • Bradenton • Tampa • Tallahassee
 4571 Colonial Boulevard Suite 100 • Fort Myers, Florida 33922 • Phone: 239-939-1200 • Fax: 239-939-3412 • Web Site: www.wilsonmiller.com

CLIENT:	CENTEX HOMES
PROJECT:	THE QUARRY PHASE 2
DATE:	FEB 2005
HORIZONTAL SCALE:	1" = 40'
VERTICAL SCALE:	1" = 4'
SEC. INVS. RGE.	CROSS REFERENCE FILE NO.:
14, 23, 48S, 26E	D-0442-48
TITLE:	PLAN AND PROFILE NICKEL RIDGE CIRCLE STA. 11+00 TO END
PROJECT NUMBER:	N0442-509-000
INDEX NUMBER:	D-0442-150
SHEET NUMBER:	18 OF 38
USA M. GORDANO LICENSE # 59318	

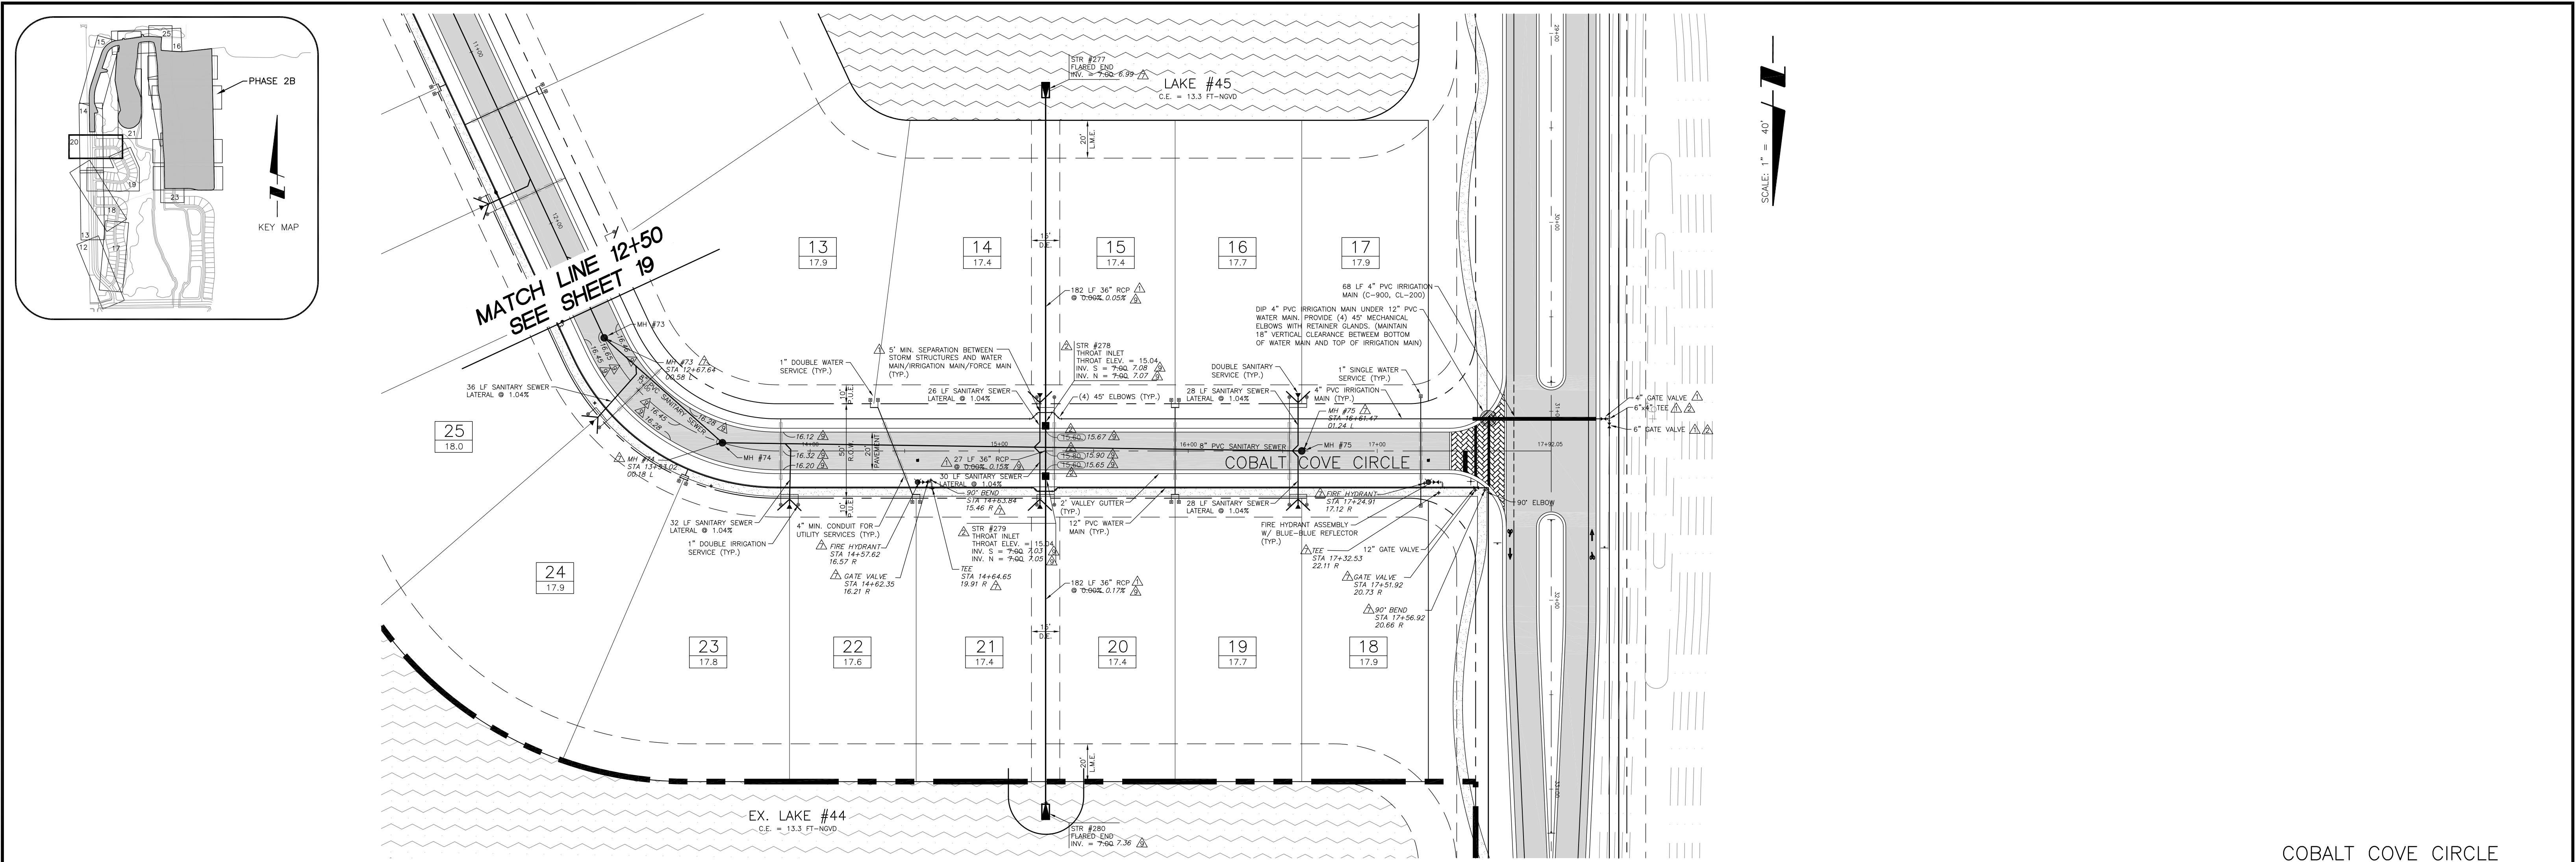

COBALT COVE CIRCLE

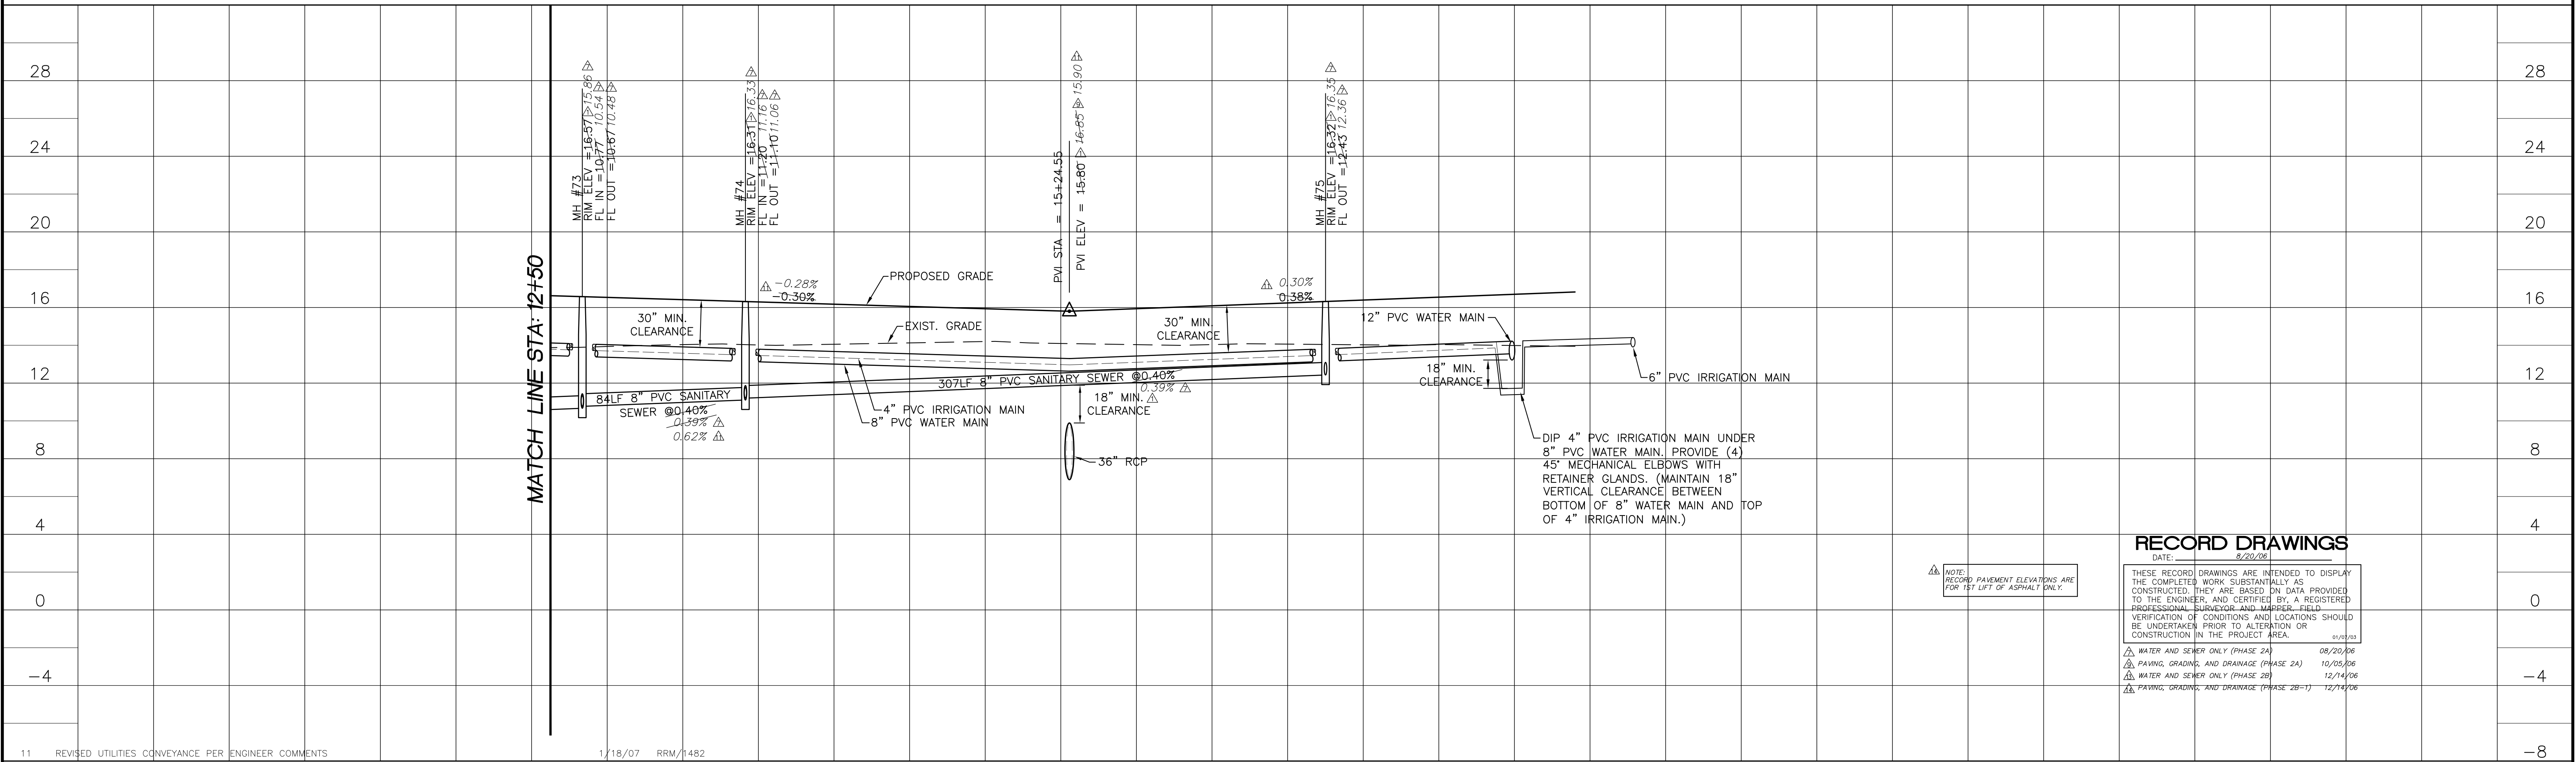



RECORD DRAWINGS

DATE: 8/20/06


THESE RECORD DRAWINGS ARE INTENDED TO DISPLAY THE COMPLETED WORK SUBSTANTIALLY AS CONSTRUCTED. THEY ARE BASED ON DATA PROVIDED TO THE ENGINEER, AND CERTIFIED BY A REGISTERED PROFESSIONAL SURVEYOR AND MAPMAKER. FIELD VERIFICATION OF CONDITIONS AND LOCATIONS SHOULD BE UNDERTAKEN PRIOR TO ALTERATION OR CONSTRUCTION IN THE PROJECT AREA.

DATE	REVISION
08/20/06	WATER AND SEWER ONLY (PHASE 2A)
10/05/06	PAVING, GRADING, AND DRAINAGE (PHASE 2A)
12/14/06	WATER AND SEWER ONLY (PHASE 2B)
12/14/06	PAVING, GRADING, AND DRAINAGE (PHASE 2B-1)

11	REVISED UTILITIES CONVEYANCE PER ENGINEER COMMENTS	1/18/07	RRM/1482	12+00	14+00	16+00	18+00
9	RECORD DRAWING REVISION - PAVING, GRADING, AND DRAINAGE - PHASE 2A	10/25/06	MPO/2348	ACTIVITY	INITIALS/EMP. NO.	DATE	
7	RECORD DRAWING REVISION - WATER AND SEWER ONLY	8/14/06	MPO/2348	DESIGNED BY:	LMG/894	4/15/05	
4	REVISED FOR INSUBSTANTIAL CHANGE	5/4/06	RRM/1482	DRAWN BY:	RRM/1482	4/15/05	
2	REVISED PER ENGINEER & COUNTY COMMENTS	11/29/05	RRM/1482	CHECKED BY:			
1	REVISED PER COLLIER COUNTY COMMENTS	9/28/05	RRM/1482	CONTRACT ADMIN. BY:			
Δ REV NO.	REVISION	Feb 07, 2008 - 17:55:37	TDASILVA\X\ENG\N0442\150-QuarryPhase2\Rev14-corrPaving&Drainage\044215020.dwg	DATE	DRWN BY / EMP. NO.	CHECKED BY / EMP. NO.	WM APPROVED BY:
				WilsonMiller Planners • Engineers • Ecologists • Surveyors • Landscape Architects • Transportation Consultants WilsonMiller, Inc. Naples • Fort Myers • Sarasota • Bradenton • Tampa • Tallahassee 4571 Colonial Boulevard, Suite 100 • Fort Myers, Florida 33912 • Phone 239-939-1020 • Fax 239-939-3442 • Web-Site www.wilsonmiller.com			
				CLIENT: CENTEX HOMES PROJECT: THE QUARRY PHASE 2			
				TITLE: PLAN AND PROFILE COBALT COVE CIRCLE STA. 12+50 TO END			
				DATE: FEB 2005 HORIZONTAL SCALE: 1" = 40' VERTICAL SCALE: 1" = 4' SEC: TWP: RGE: 14, 23 48S 20E CROSS REFERENCE FILE NO.: D-0442-48 PROJECT NUMBER: N0442-509-000 SHEET NUMBER: 20 OF 38			
				USA M. GIORGIO LICENSE # 59319 D-0442-150			

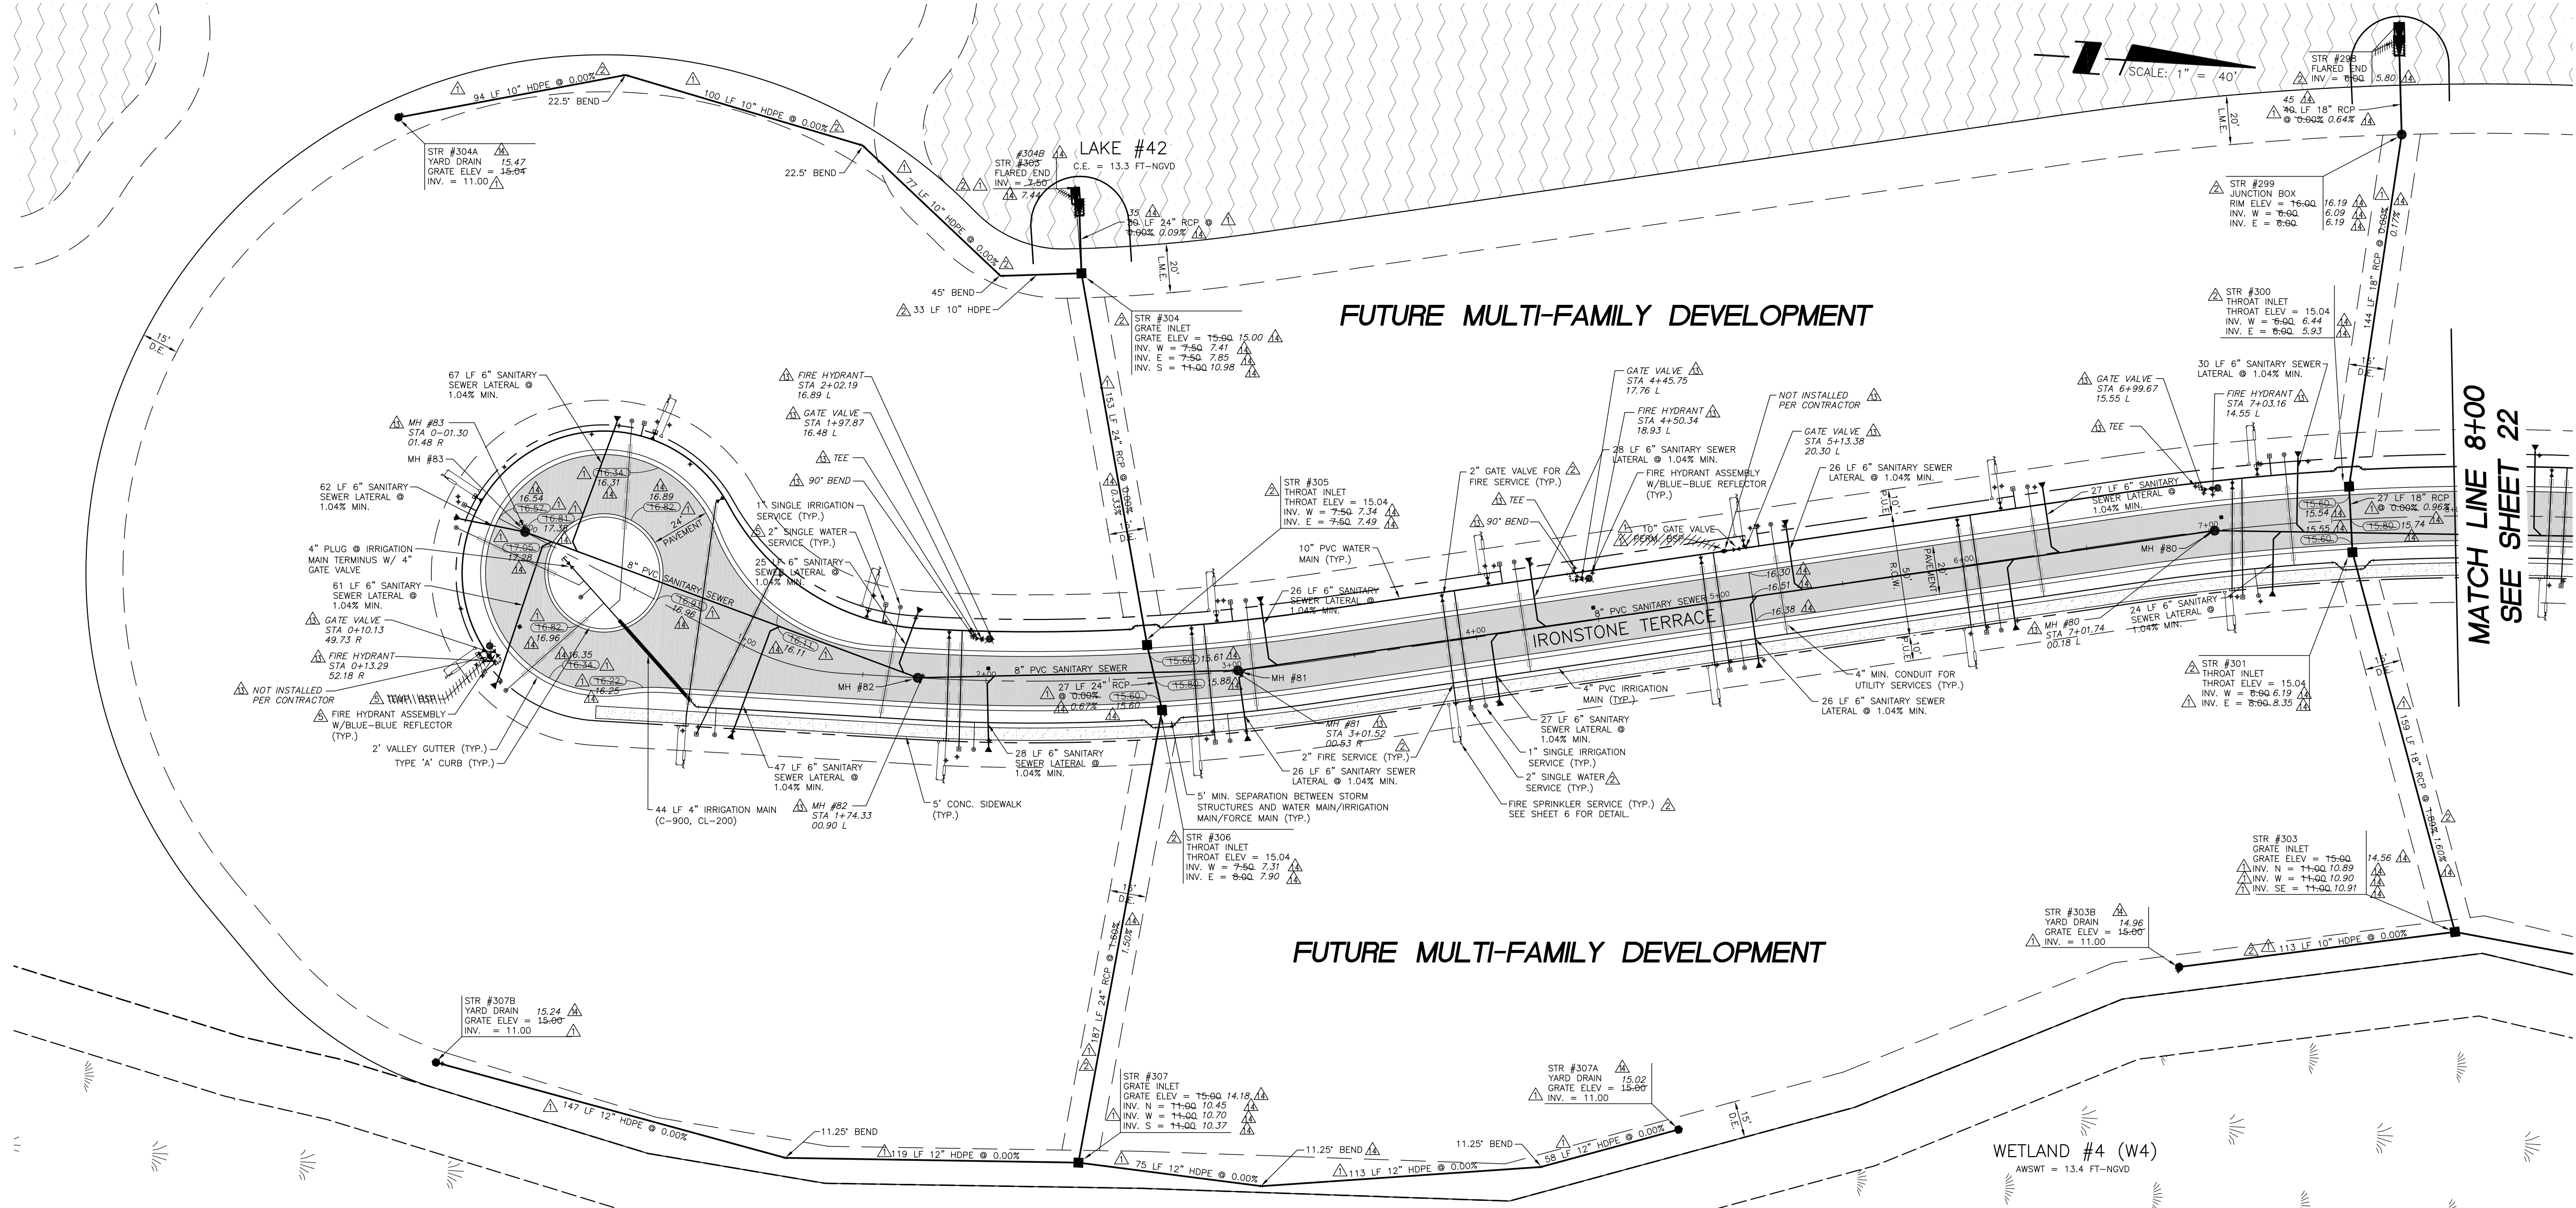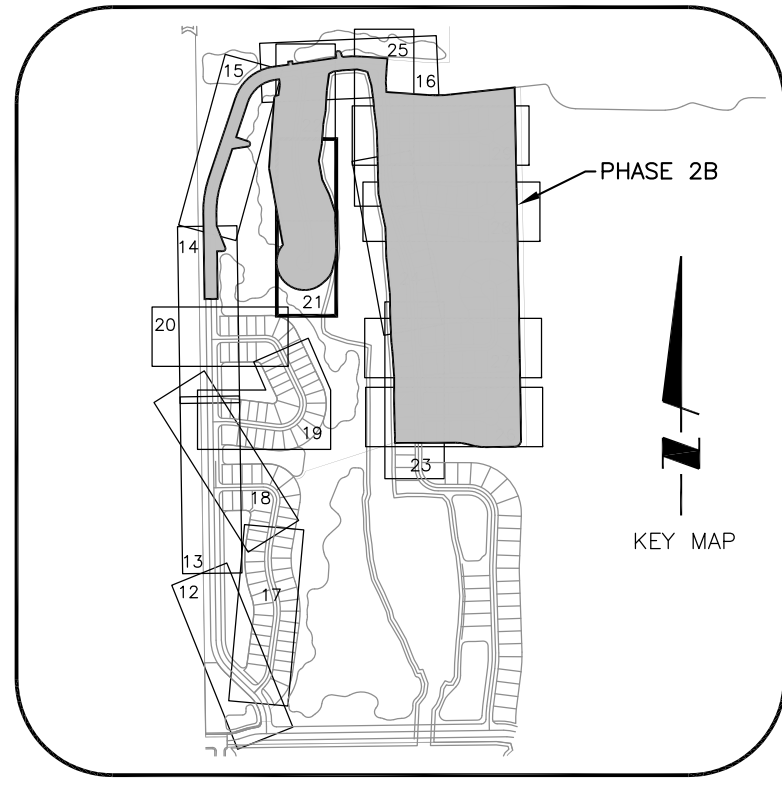

MATCH LINE 8+00
SEE SHEET 22

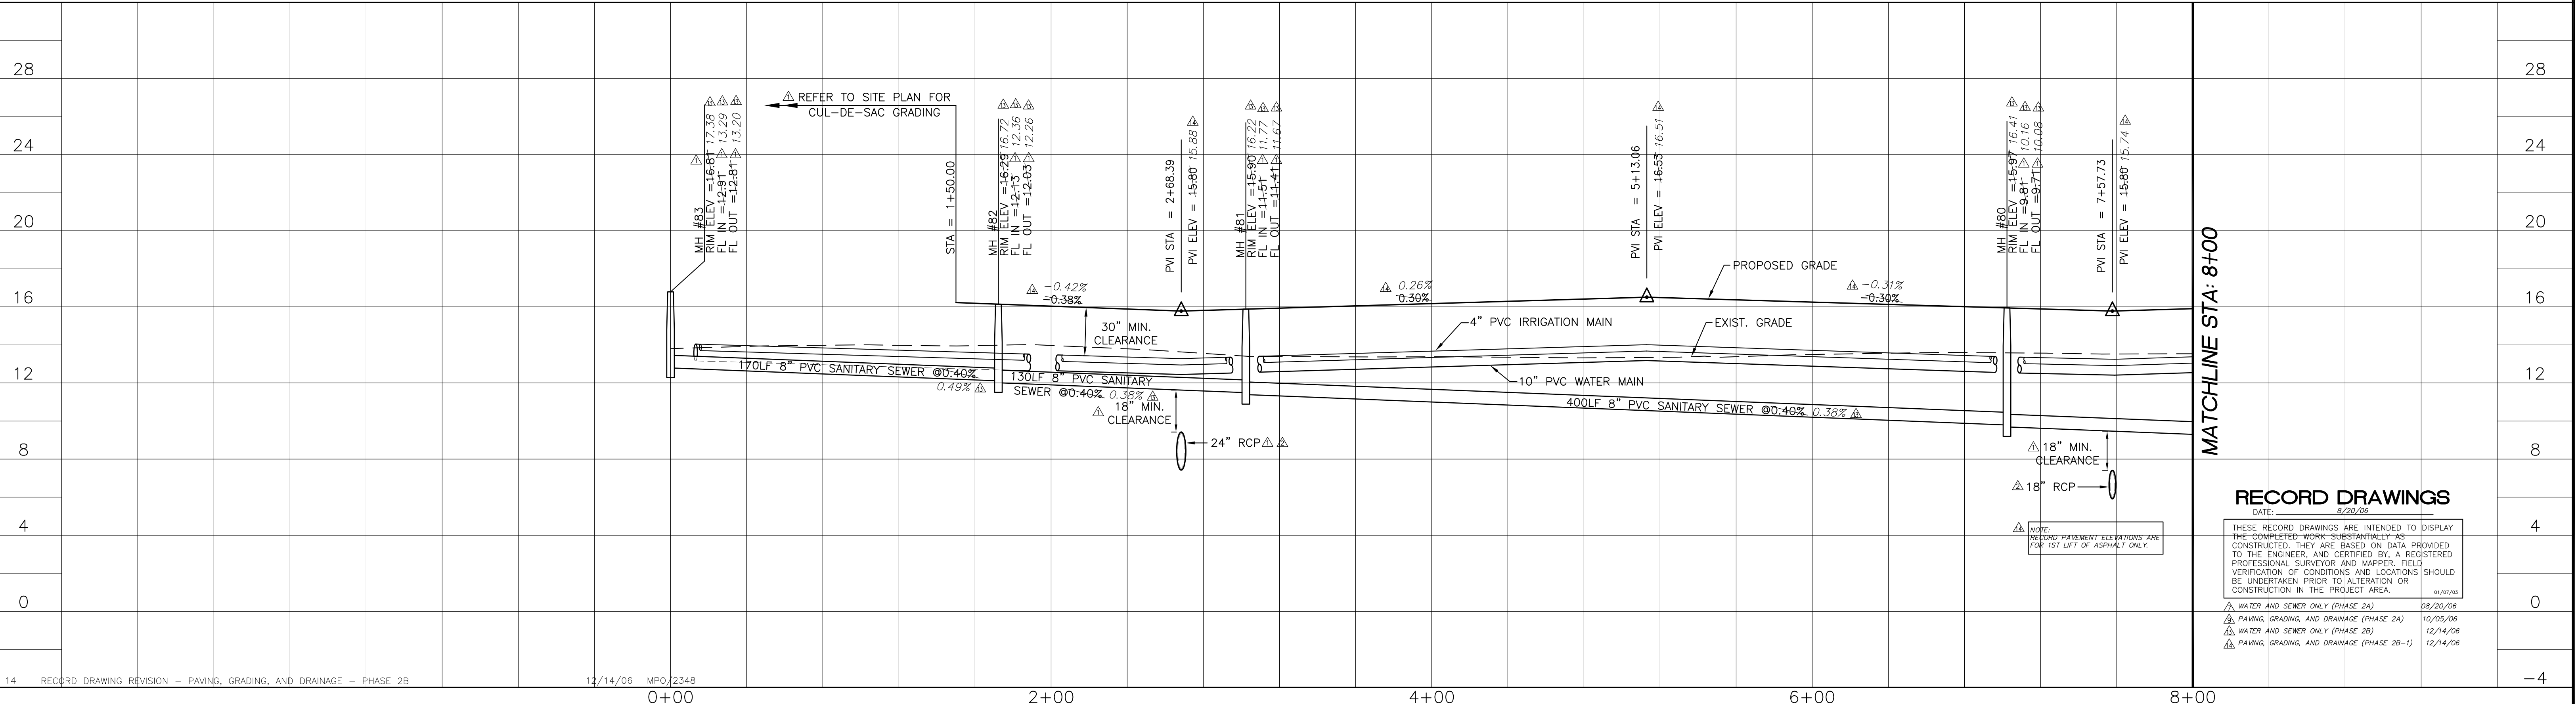




MATCHLINE STA: 8+00

RECORD DRAWINGS


DATE: 8/20/06
THESE RECORD DRAWINGS ARE INTENDED TO DISPLAY THE "COMPLETED WORK" SUBSTANTIALLY AS CONSTRUCTED. THEY ARE BASED ON DATA PROVIDED TO THE ENGINEER, AND CERTIFIED BY, A REGISTERED PROFESSIONAL SURVEYOR AND MAPPER. FIELD VERIFICATION OF CONDITIONS AND LOCATIONS SHOULD BE UNDERTAKEN PRIOR TO ALTERATION OR CONSTRUCTION IN THE PROJECT AREA.

WATER AND SEWER ONLY (PHASE 2A)	08/20/06
PAVING, GRADING, AND DRAINAGE (PHASE 2A)	10/05/06
WATER AND SEWER ONLY (PHASE 2B)	12/14/06
PAVING, GRADING, AND DRAINAGE (PHASE 2B-1)	12/14/06



13	RECORD DRAWING REVISION - WATER AND SEWER ONLY - PHASE 2B	12/14/06	MPO/2348	ACTIVITY	INITIALS/EMP. NO.	DATE	WilsonMiller Planners • Engineers • Ecologists • Surveyors • Landscape Architects • Transportation Consultants WilsonMiller, Inc. Naples • Fort Myers • Sarasota • Bradenton • Tampa • Tallahassee 4571 Colonial Boulevard, Suite 100 • Fort Myers, Florida 33912 • Phone 239-939-1020 • Fax 239-939-3412 • Web Site www.wilsonmiller.com	PROJECT: CENTEX HOMES THE QUARRY PHASE 2	TITLE: PLAN AND PROFILE IRONSTONE TERRACE STA. 0+00 TO STA. 8+00	LISA M. GORDANO LICENSE # 29318 D-0442-150	SHEET NUMBER: 21 OF 38
10	REVISED FOR UTILITIES CONVEYANCE	12/14/06	MPO/2348	DESIGNED BY:	LMG/894	4/15/05					
5	REVISED PER ENGINEER & OWNER	6/3/06	RRM/1482	DRAWN BY:	RRM/1482	4/15/05					
2	REVISED PER ENGINEER & COUNTY COMMENTS	11/29/05	RRM/1482	CHECKED BY:							
1	REVISED PER COLLIER COUNTY COMMENTS	9/28/05	RRM/1482	CONTRACT ADMIN. BY:							
ΔREV NO.	REVISION	DATE	DRAWN BY / EMP. NO.	CHECKED BY / EMP. NO.	WM APPROVED BY:						

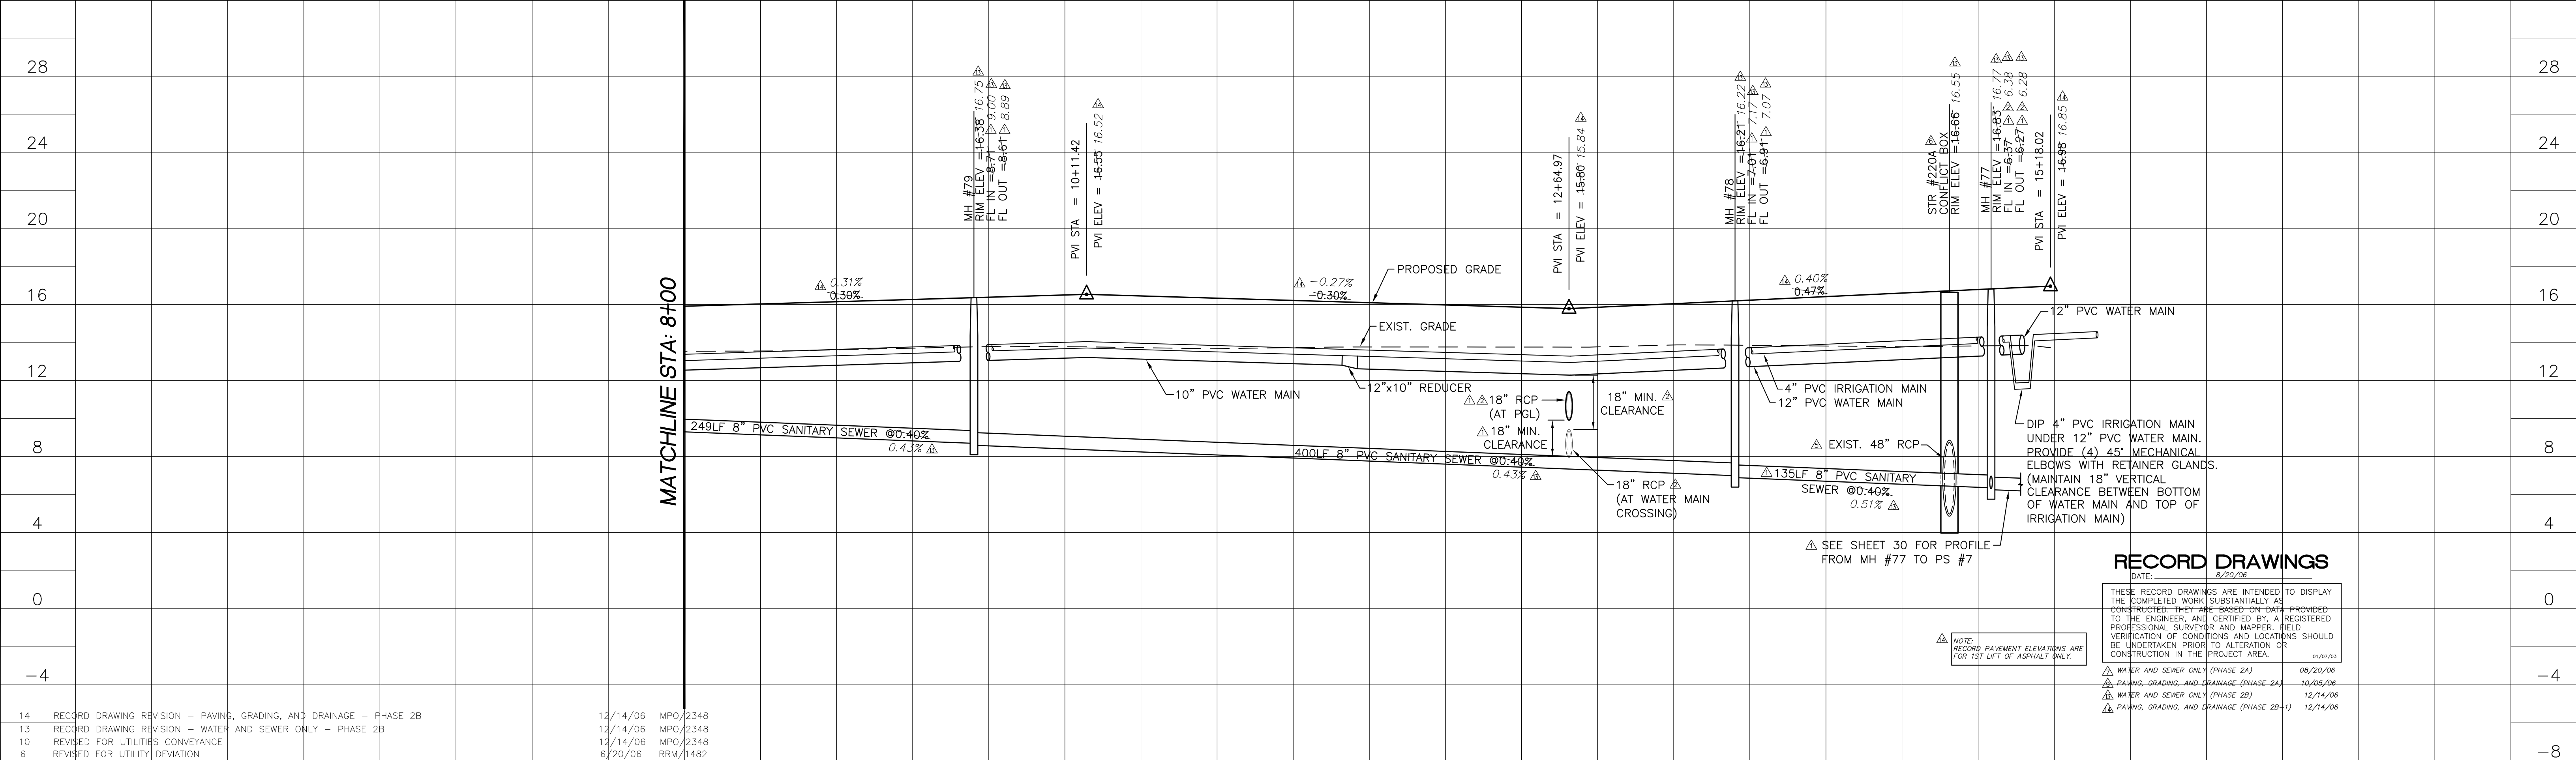
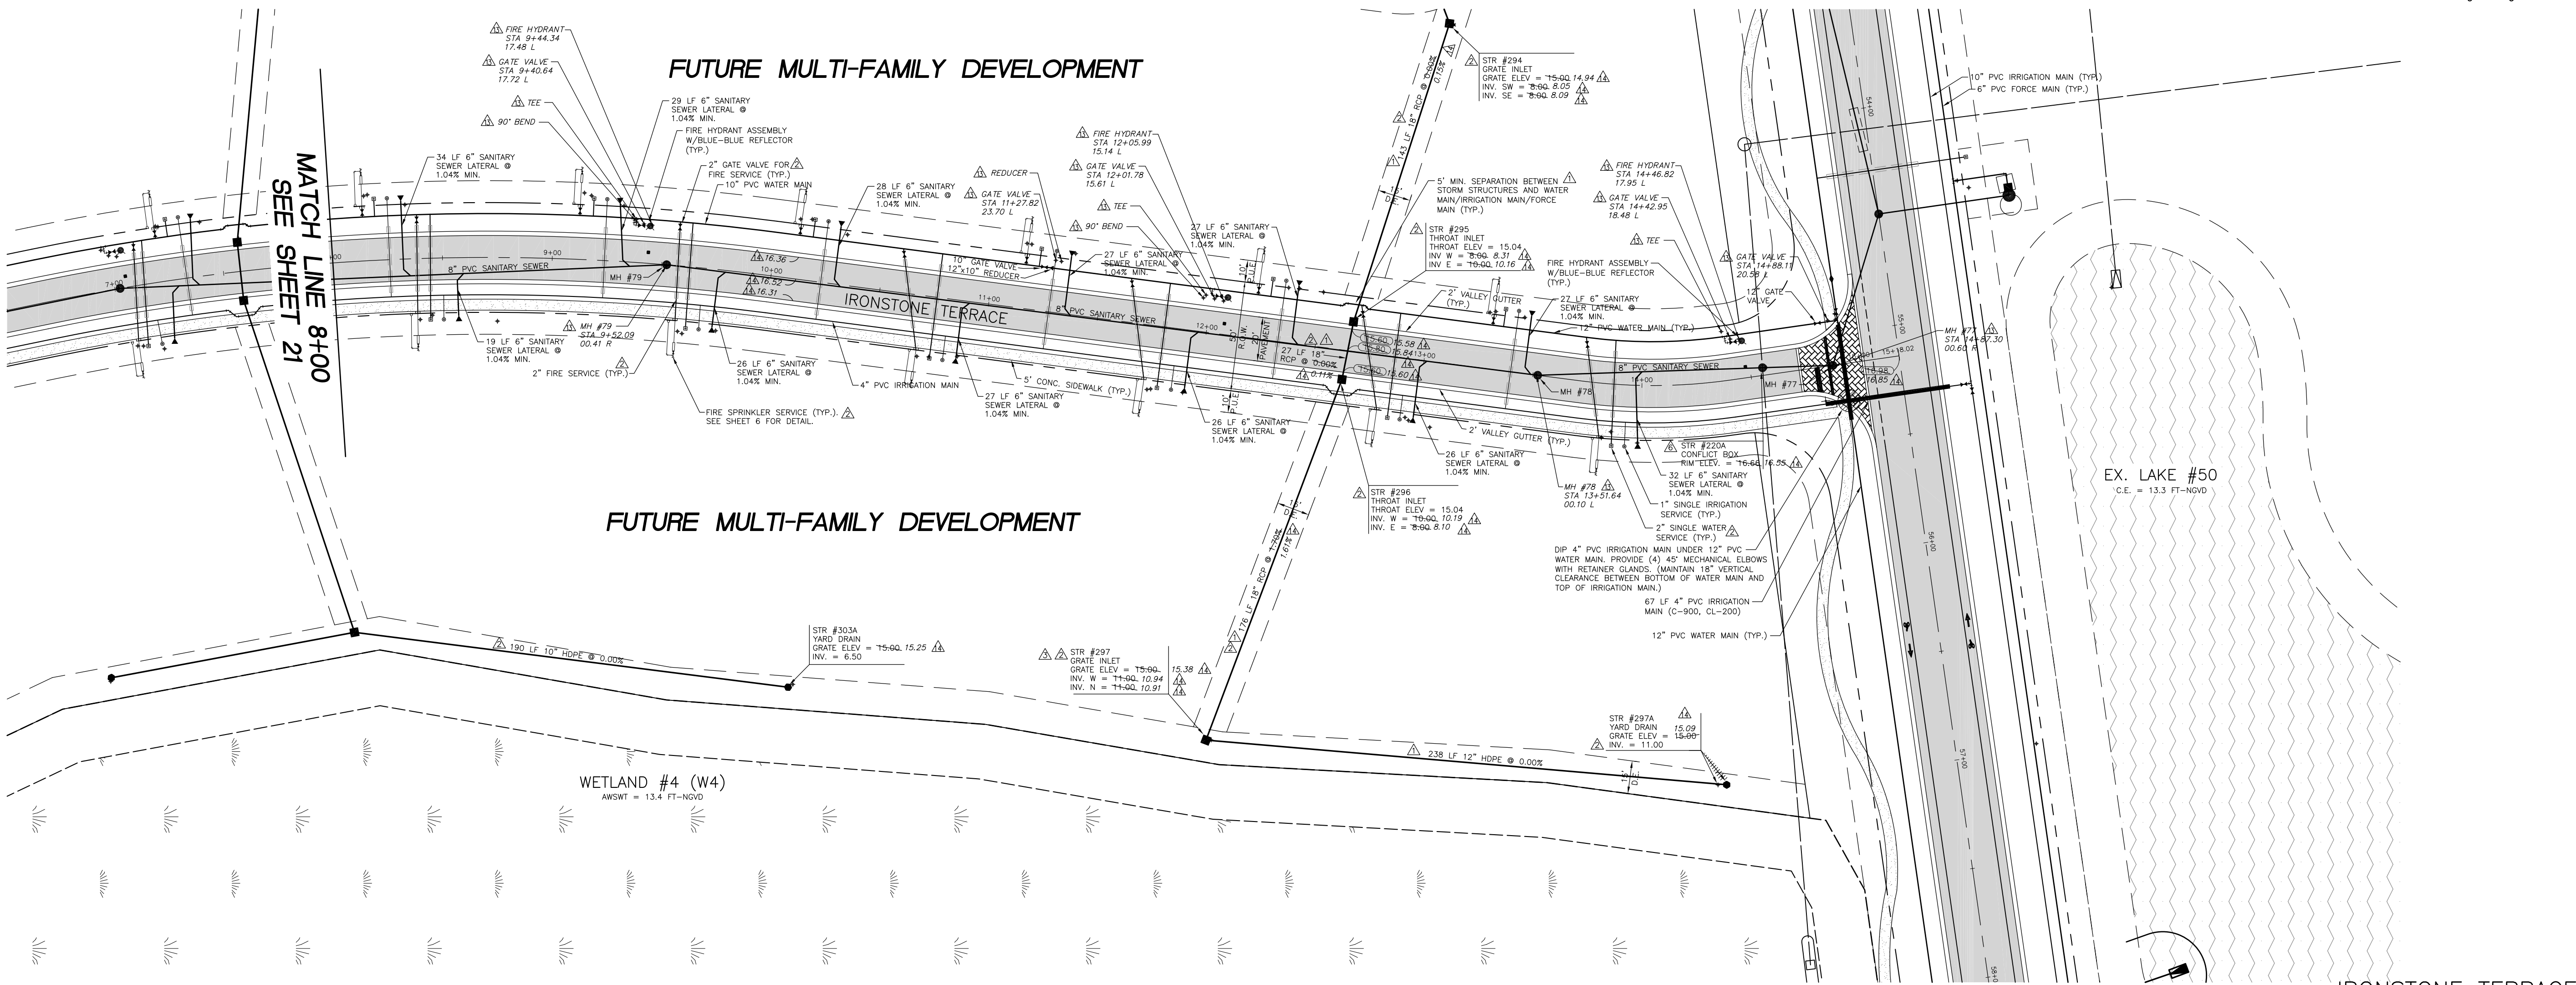
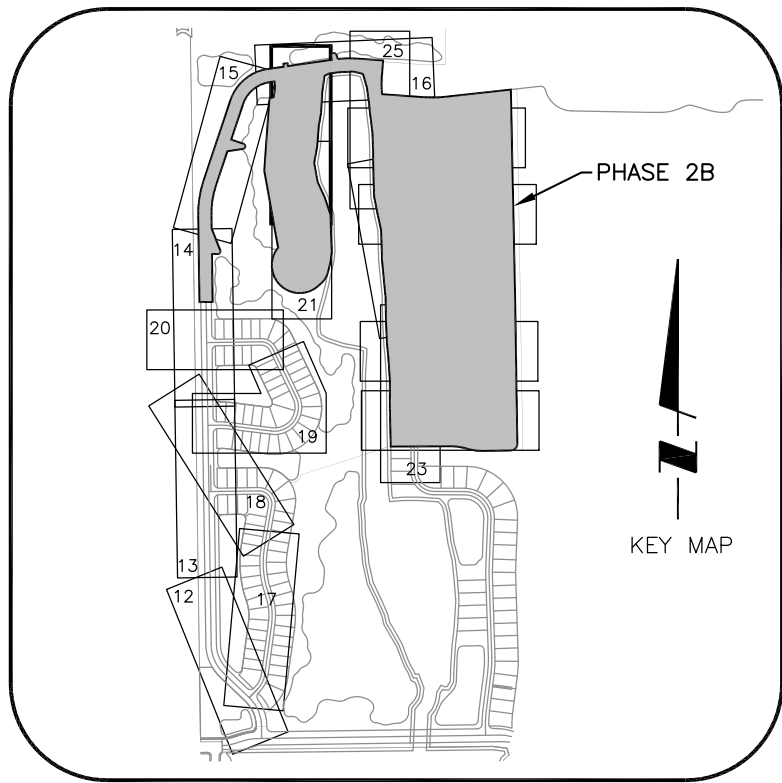



5	REVISED PER ENGINEER & OWNER	6/3/06	RRM/1482	ACTIVITY	INITIALS/EMP. NO.	DATE	<div><div>WilsonMiller, Inc. - FL Lic# LC-000070 WilsonMiller, Inc. - Certificate of Authorization #43</div><div>Planners • Engineers • Ecologists • Surveyors • Landscape Architects • Transportation Consultants</div><div>WilsonMiller, Inc. Naples • Fort Myers • Sarasota • Bradenton • Tampa • Tallahassee 4571 Colonial Boulevard, Suite 100 • Fort Myers, Florida 33912 • Phone 239-939-1020 • Fax 239-939-3412 • Web-Site www.wilsonmiller.com</div></div>	CLIENT: <div>CENTEX HOMES</div>	DATE: FEB 2004	TITLE: <div>PLAN AND PROFILE IRONSTONE TERRACE STA: 8+00 TO END</div>	LISA M. GIORGANO LICENSE # 59318		
4	REVISED FOR INSUBSTANTIAL CHANGE	5/4/06	RRM/1482	DESIGNED BY:	LMG/894	4/15/05							
3	REVISED PER FDP COMMENTS AND PER ENGINEER	3/22/06	RRM/1482	DRAWN BY:	RRM/1482	4/15/05							
2	REVISED PER ENGINEER & COUNTY COMMENTS	11/29/05	RRM/1482	CHECKED BY:									
1	REVISED PER COLLIER COUNTY COMMENTS	9/28/05	RRM/1482	CONTRACT ADMIN. BY:									
ΔREV NO.	REVISION	Feb 19, 2008 - 14:04:35	TDASLVA\X\EN\N0442\150-QuarryPhase2\Rev14-rctPaving&Drainage\044215022.dwg	DATE	DRAWN BY / DWP. NO.	CHECKED BY / DWP. NO.	WM APPROVED BY:		PROJECT: <div>THE QUARRY PHASE 2</div>	VERTICAL SCALE: 1" = 4'	CROSS REFERENCE FILE NO.:	PROJECT NUMBER:	SHEET NUMBER:
										SEC: TWP. RGE: 14, 23 485 26E	D-0442-48	N0442-509-000	22 OF 38

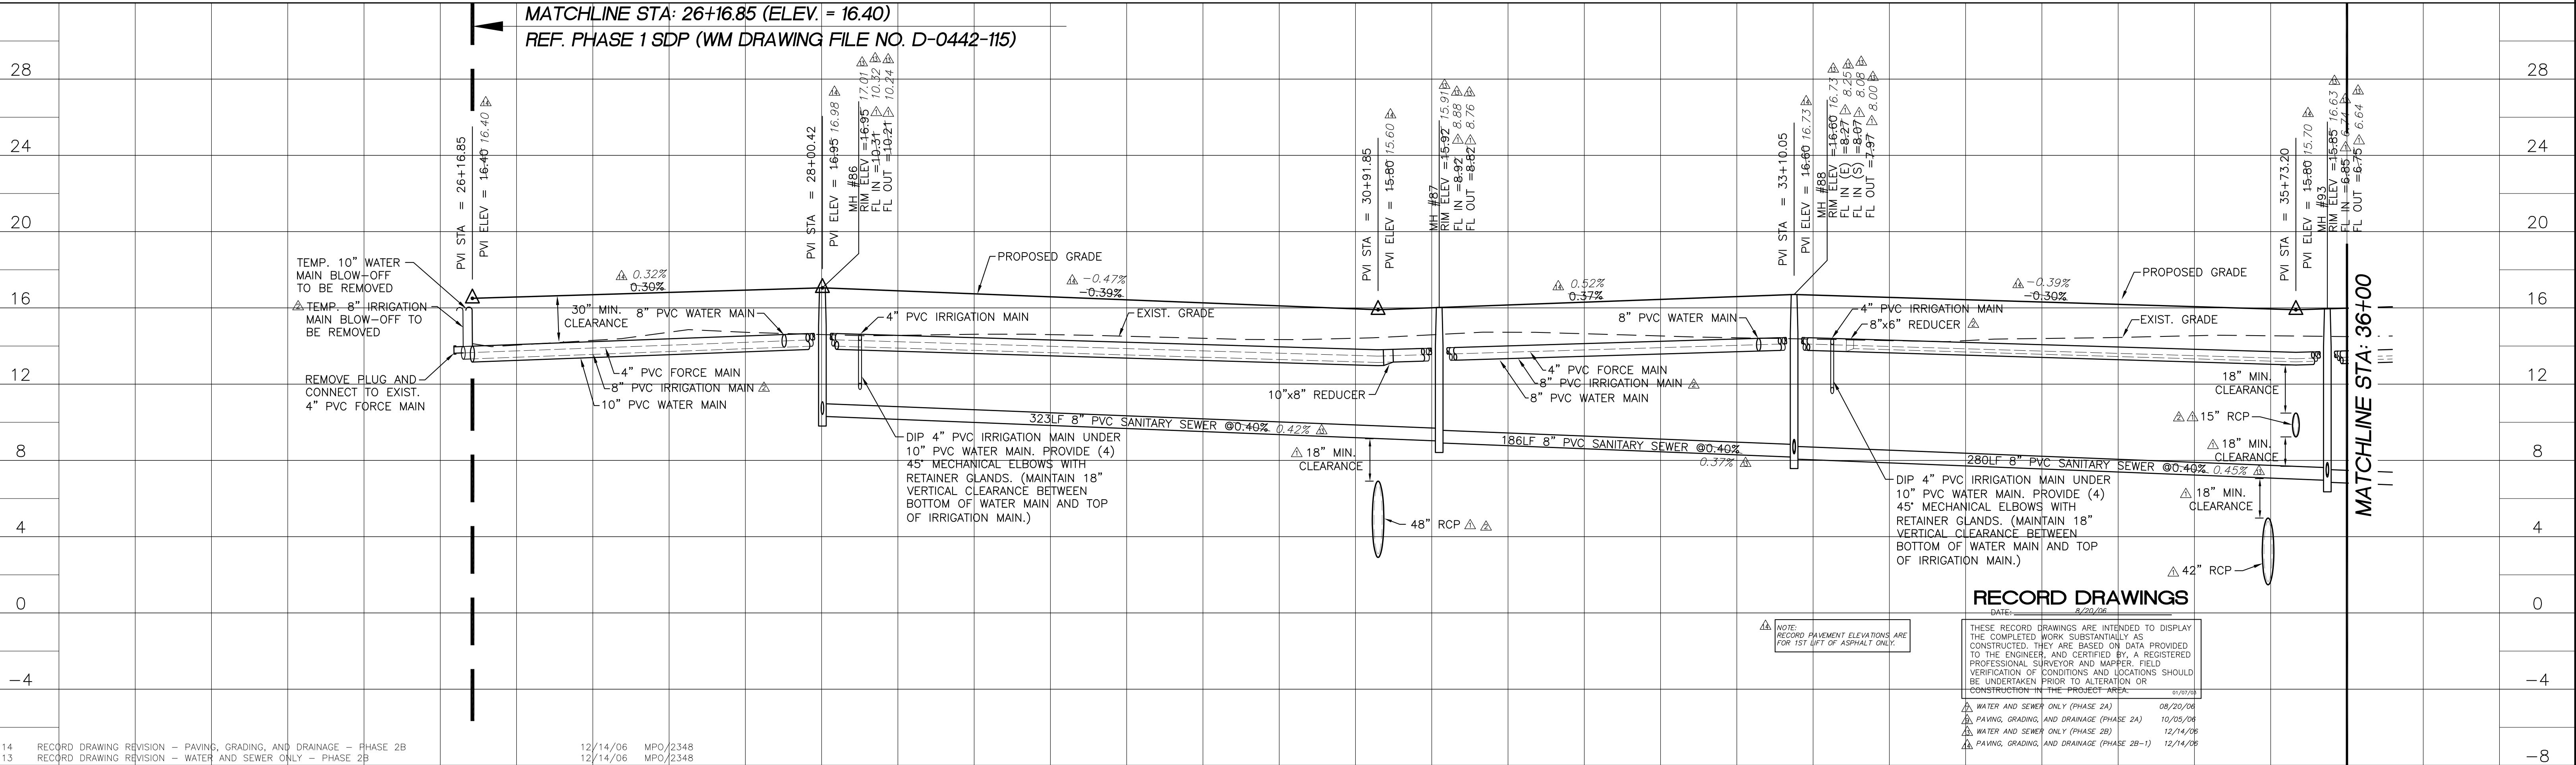



3	REVISED FOR UTILITIES CONVEYANCE	12/14/06	MPG/2348	ACTIVITY	INITIALS/EMP. NO.	DATE	<div><p>Wilson Miller, Inc. - FL Lic # LC-000070 Wilson Miller, Inc. - Certificate of Authorization #3</p><p>CENTEX HOMES</p><p>Planners • Engineers • Ecologists • Surveyors • Landscape Architects • Transportation Consultants</p><p>Wilson Miller, Inc. Naples • Fort Myers • Sarasota • Bradenton • Tampa • Tallahassee 4571 Colonial Boulevard, Suite 100 • Fort Myers, Florida 33912 • Phone 239-939-0020 • Fax 239-939-3442 • Web-Site www.wilsonmiller.com</p></div>	CLIENT:	DATE: FEB 2005	TITLE: PLAN AND PROFILE MARBLE STONE DRIVE STA. 26+16.85 TO STA. 36+00	LISA M. GORGANO LICENSE # 593316			
4	REVISED FOR INSUBSTANTIAL CHANGE	5/4/06	RRM/1482	DESIGNED BY:	LMG/894	4/15/05		<div><p>THE QUARRY</p><p>PHASE 2</p></div>	PROJECT:	HORIZONTAL SCALE: 1" = 40'	<div><p>INDEX NUMBER: D-0442-150</p></div>			
3	REVISED PER FDP COMMENTS AND PER ENGINEER	3/22/06	RRM/1482	DRAWN BY:	RRM/1482	4/15/05			VERTICAL SCALE: 1" = 4'	SEC. TWP. RGE: 14, 28, 48S 26E		CROSS REFERENCE FILE NO.: D-0442-48	PROJECT NUMBER: N0442-509-000	SHEET NUMBER: 23 OF 38
2	REVISED PER ENGINEER & COUNTY COMMENTS	11/29/05	RRM/1482	CHECKED BY:										
1	REVISED PER COLLIER COUNTY COMMENTS	9/29/05	RRM/1482	CONTRACT ADMIN. BY:										
REV. NO.	REVISION	Feb 19, 2008	14-27-04	TDASLVA(X)\C\ENG\N0442\150-QuarryPhase2\Rev14-rcrdPaving&Drainage\044215023.dwg	DATE	DRAWN BY / EMP. NO.	CHECKED BY / EMP. NO.	WM APPROVED BY:						

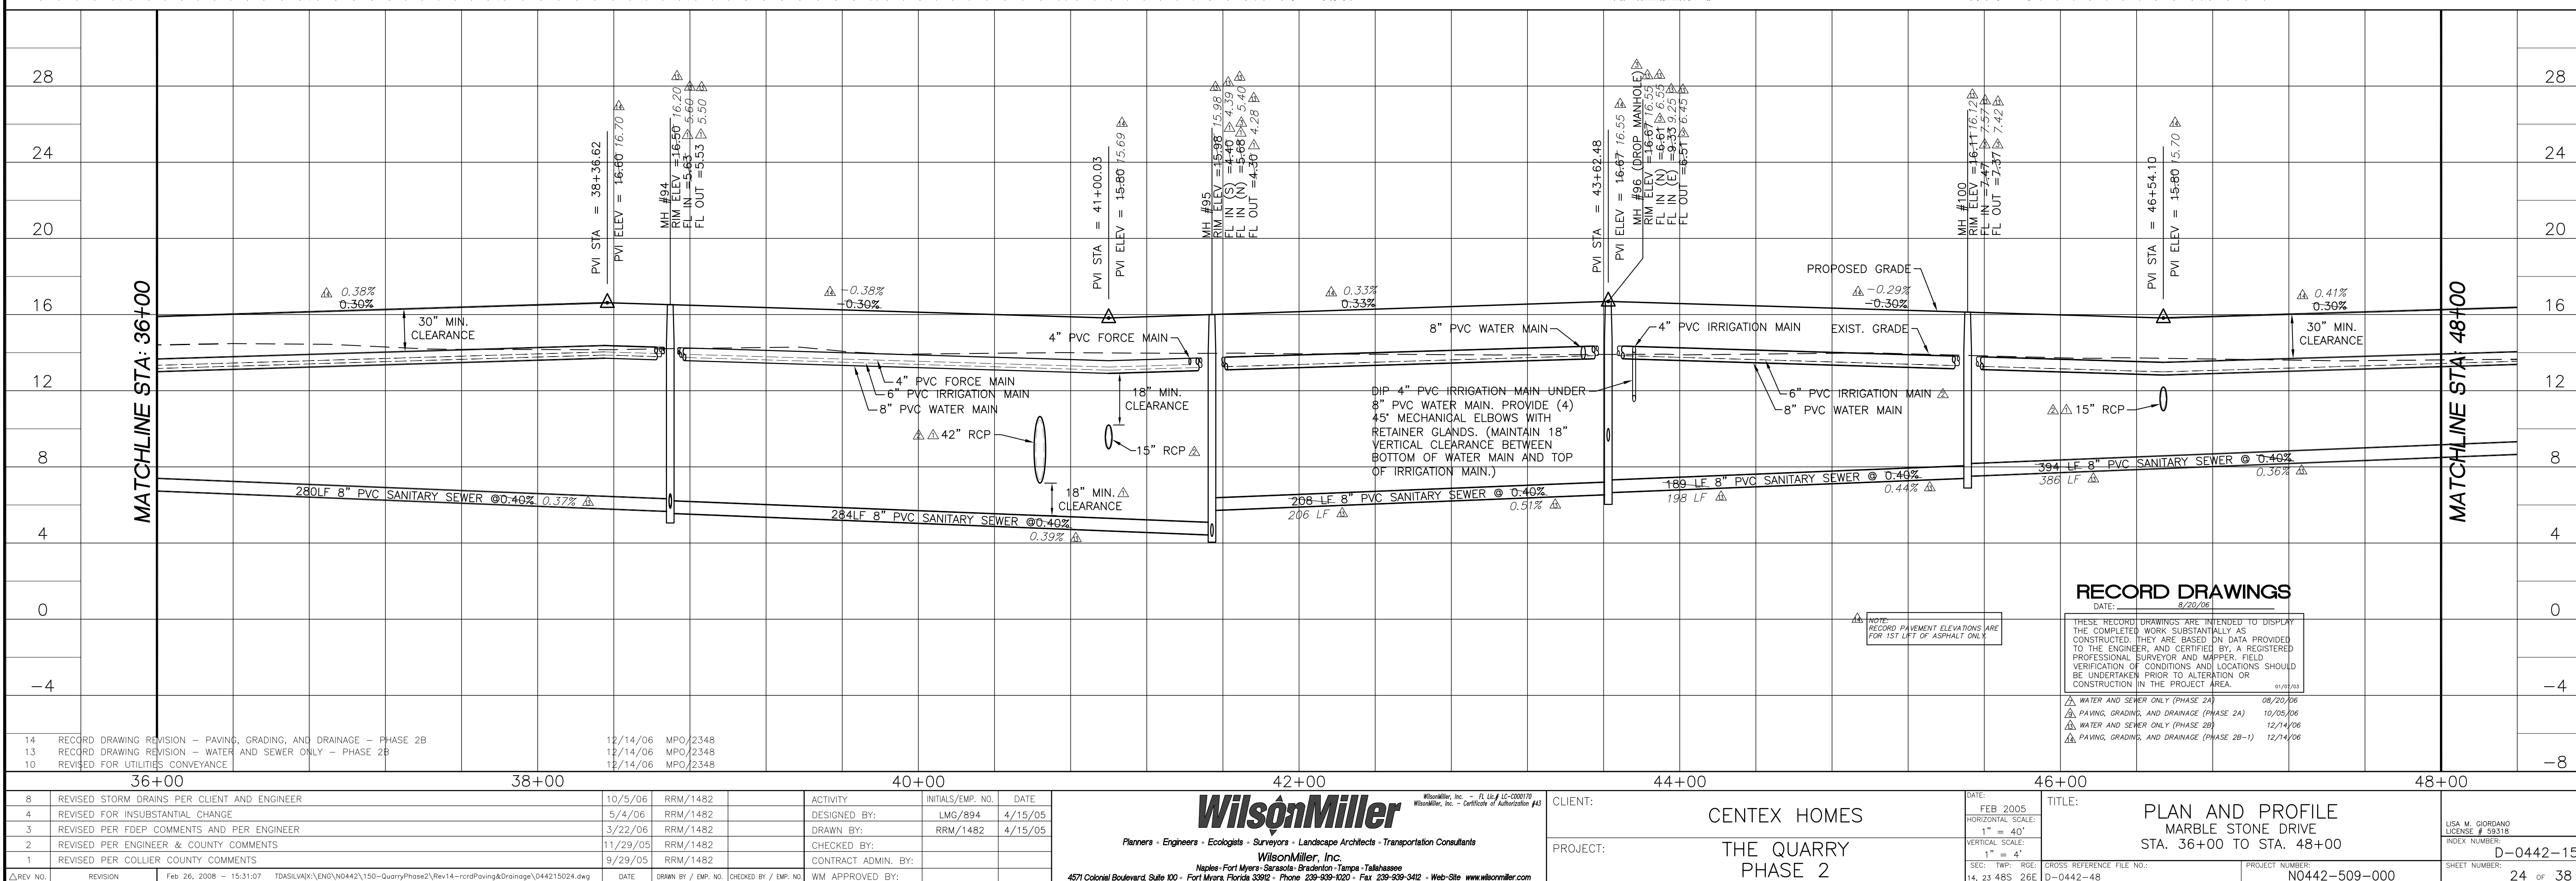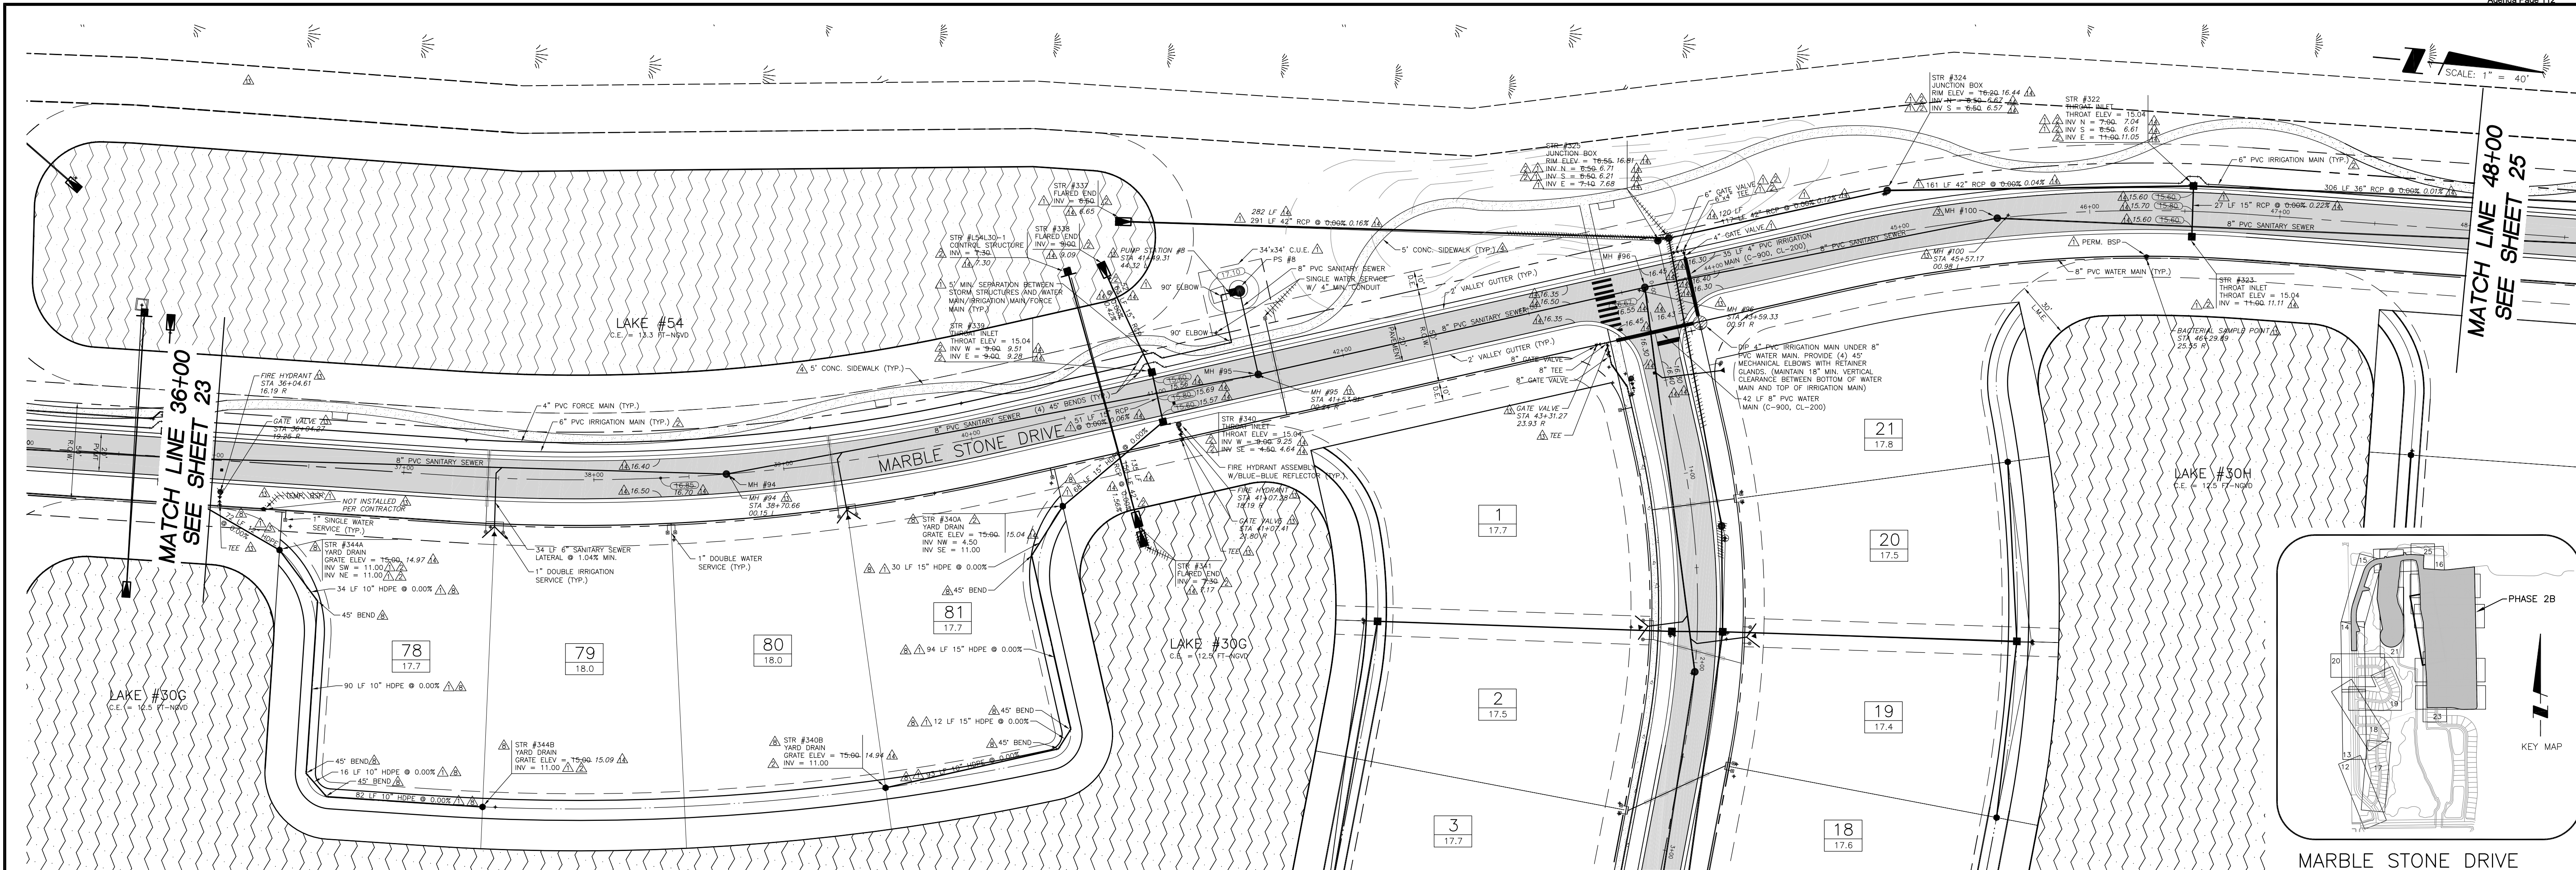

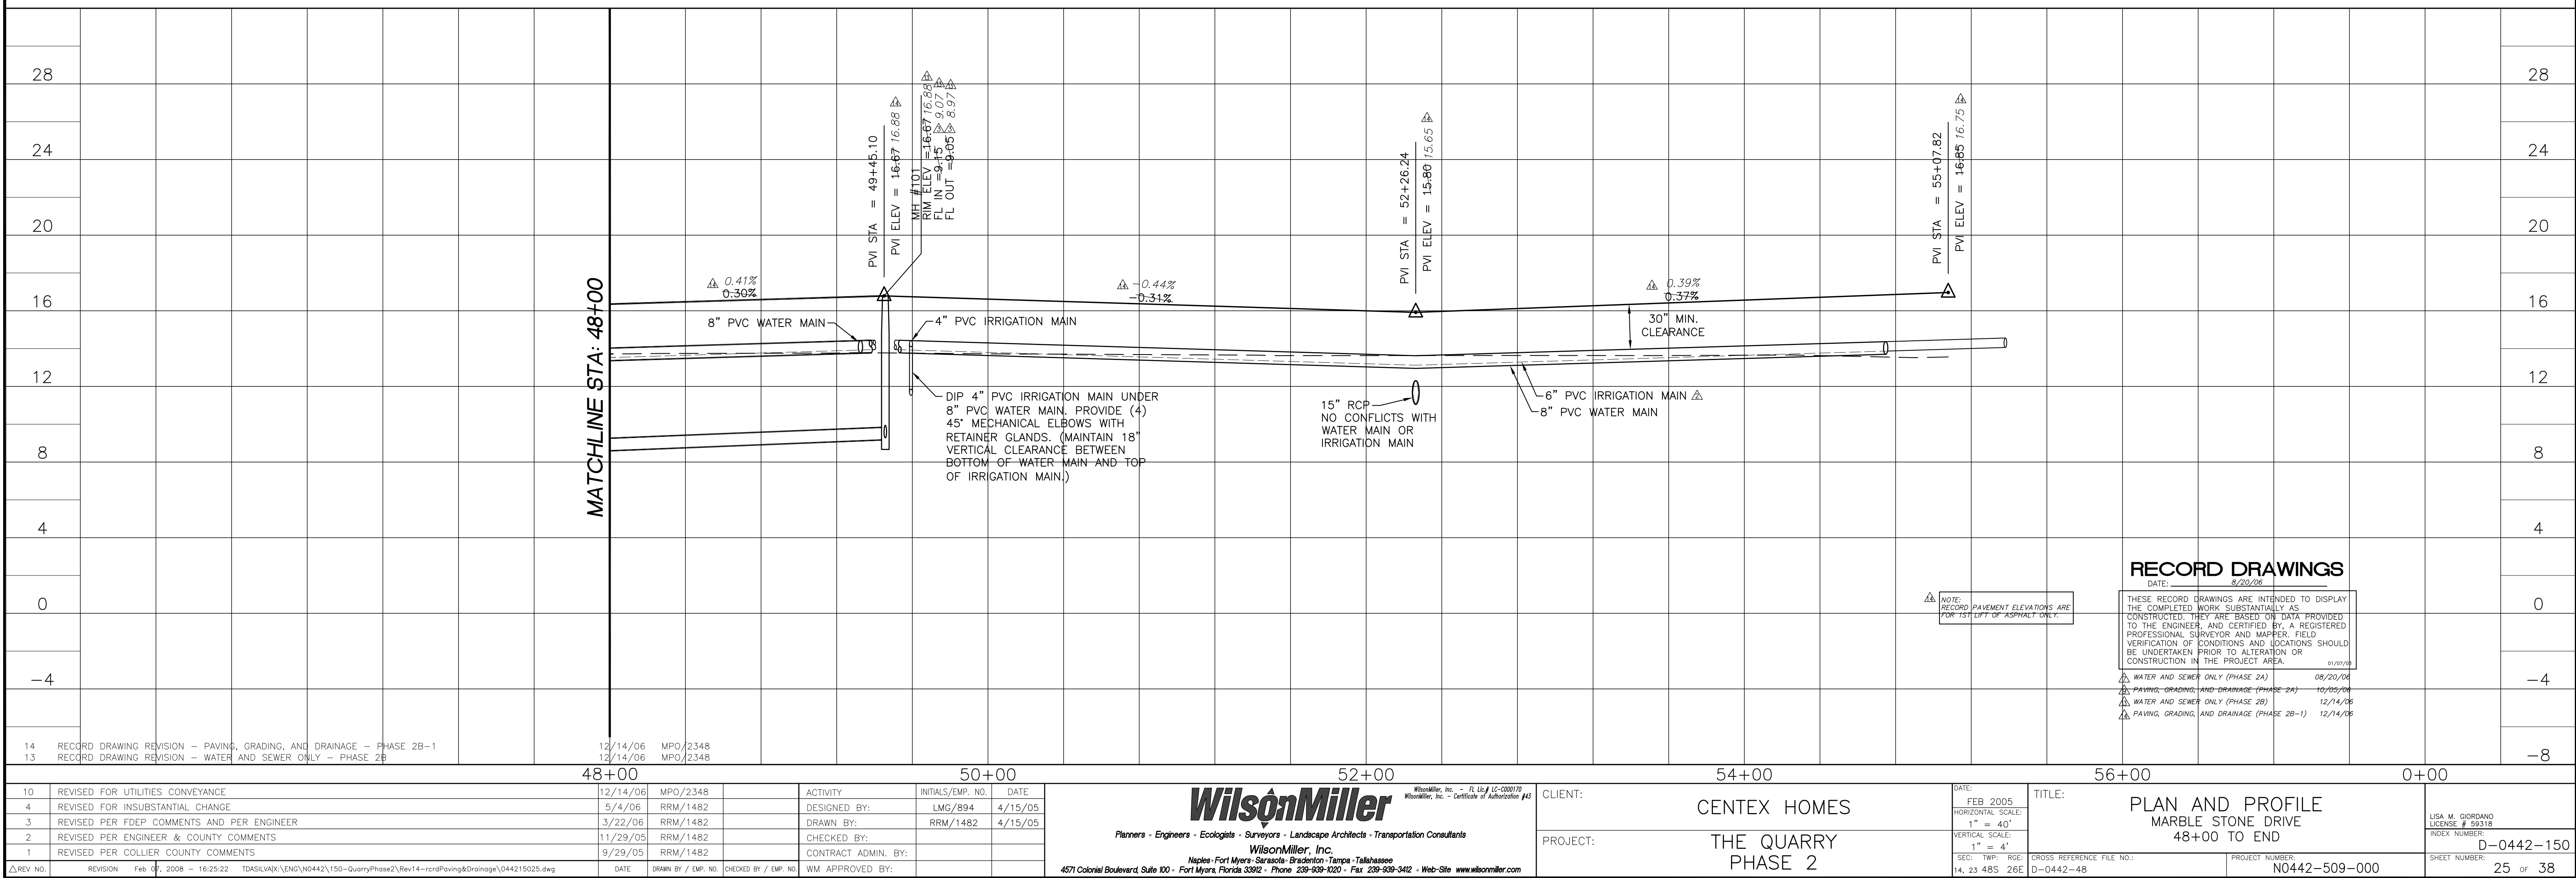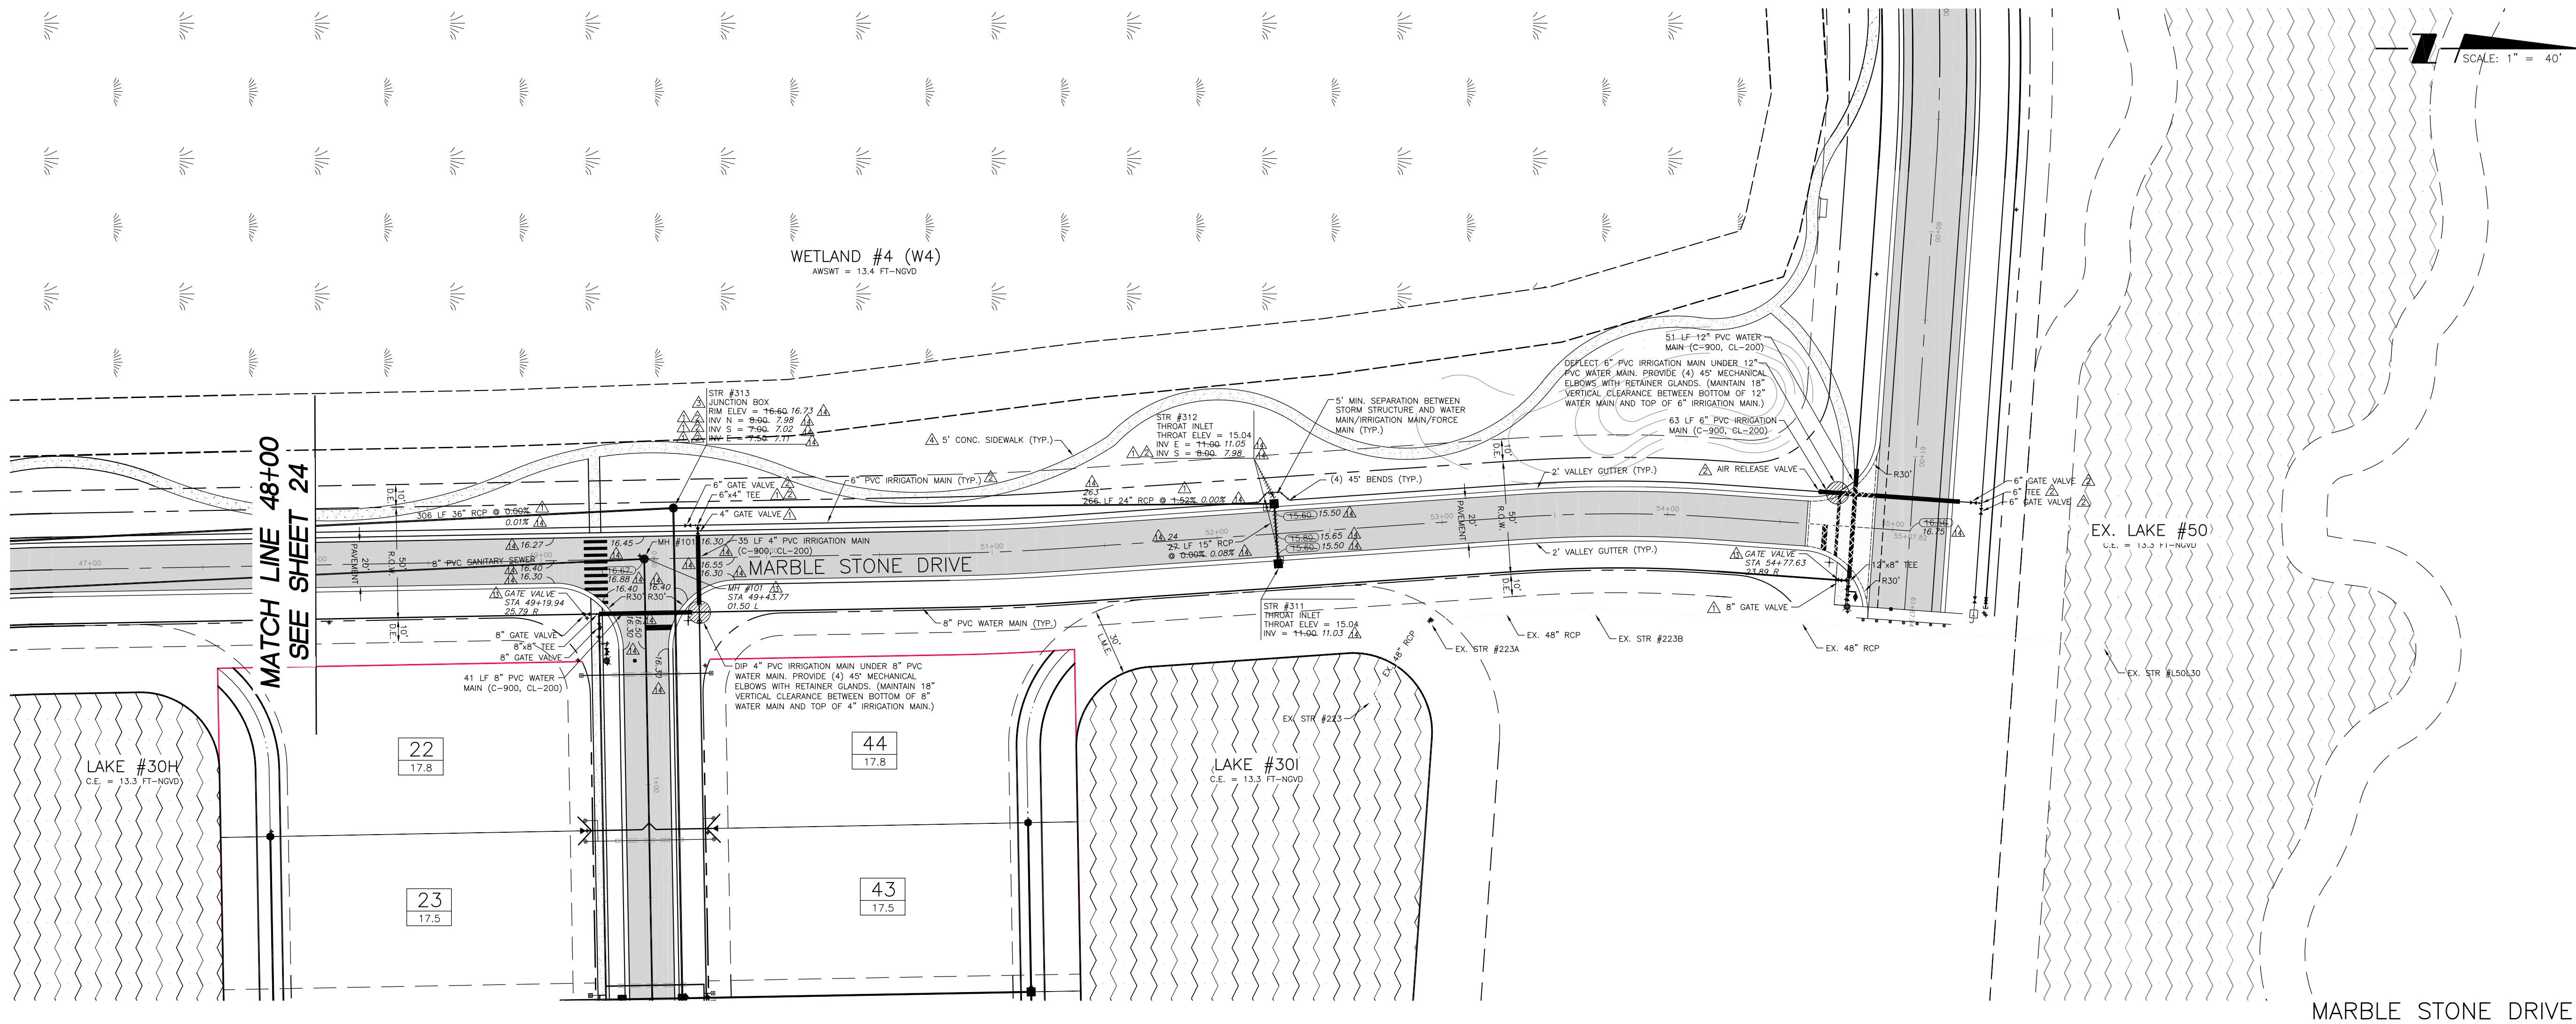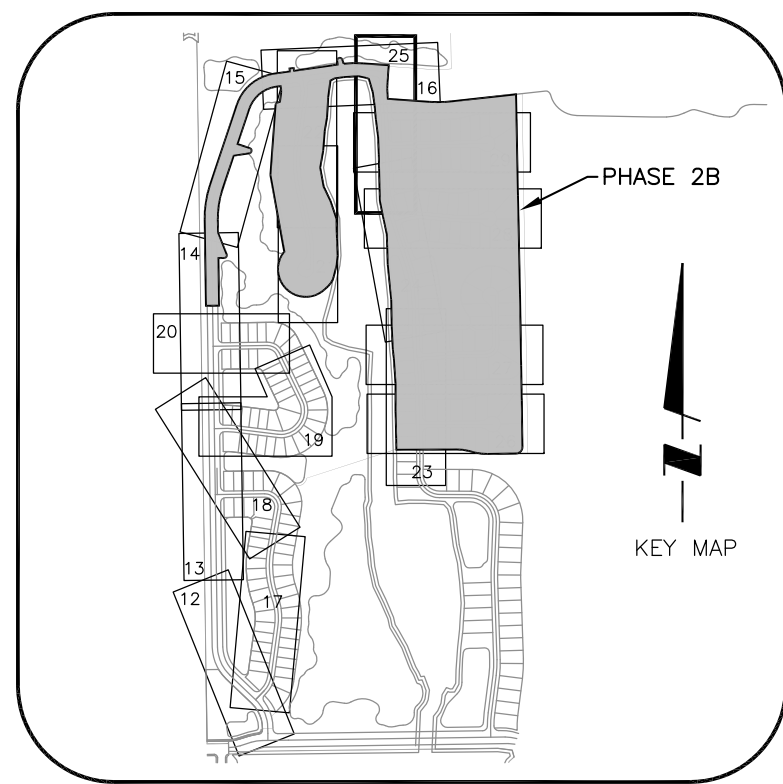


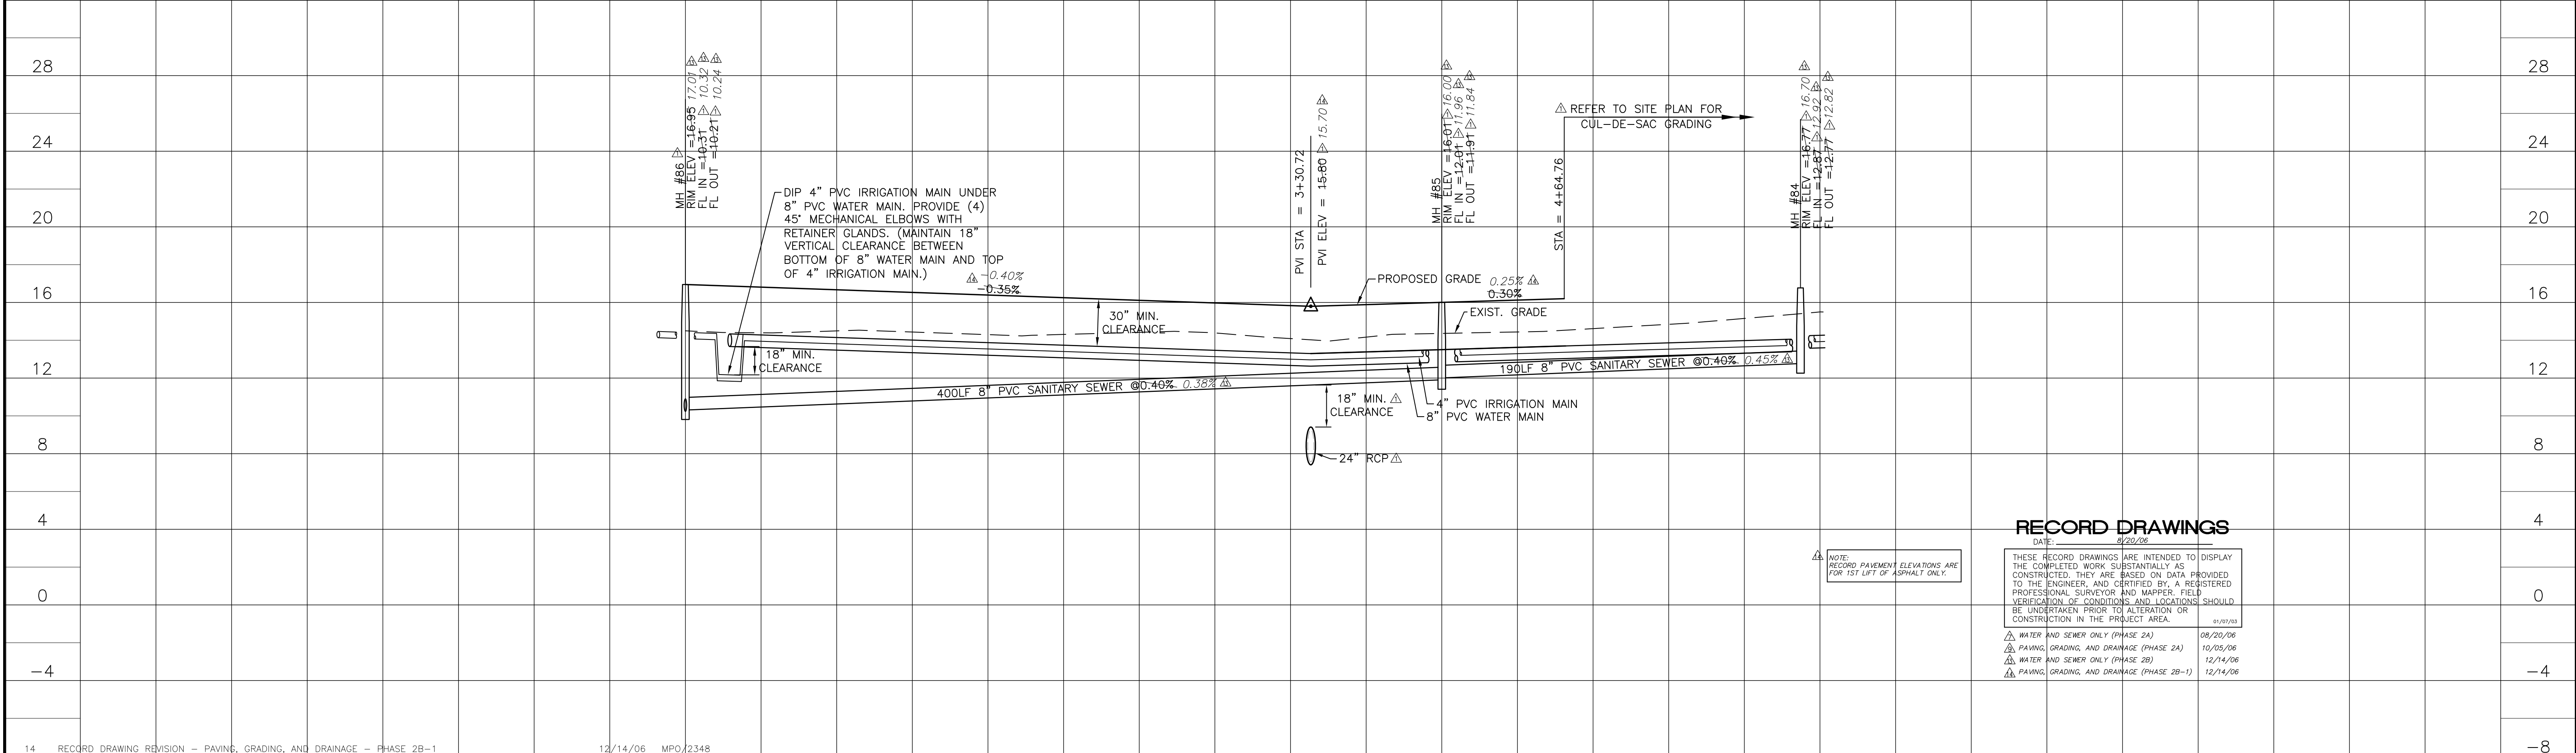











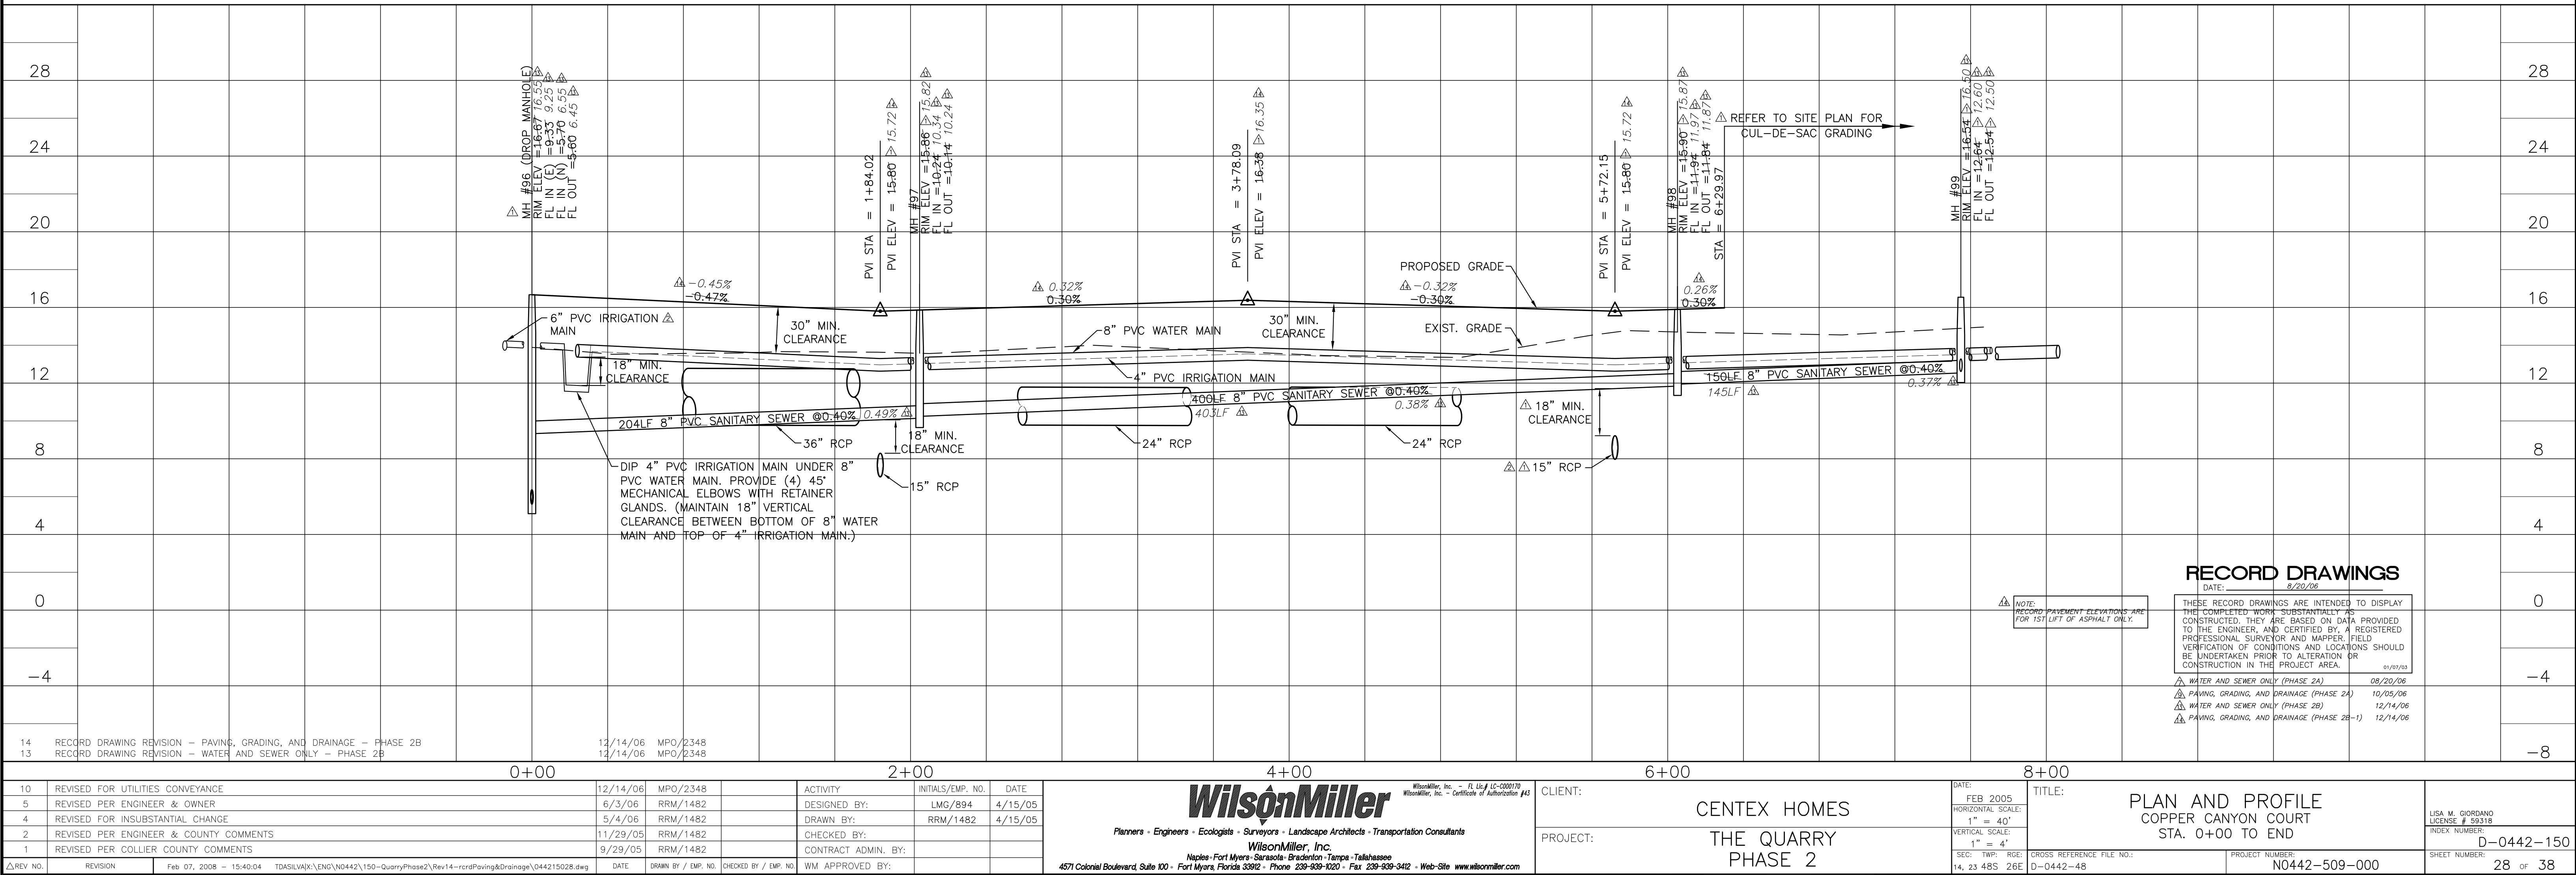


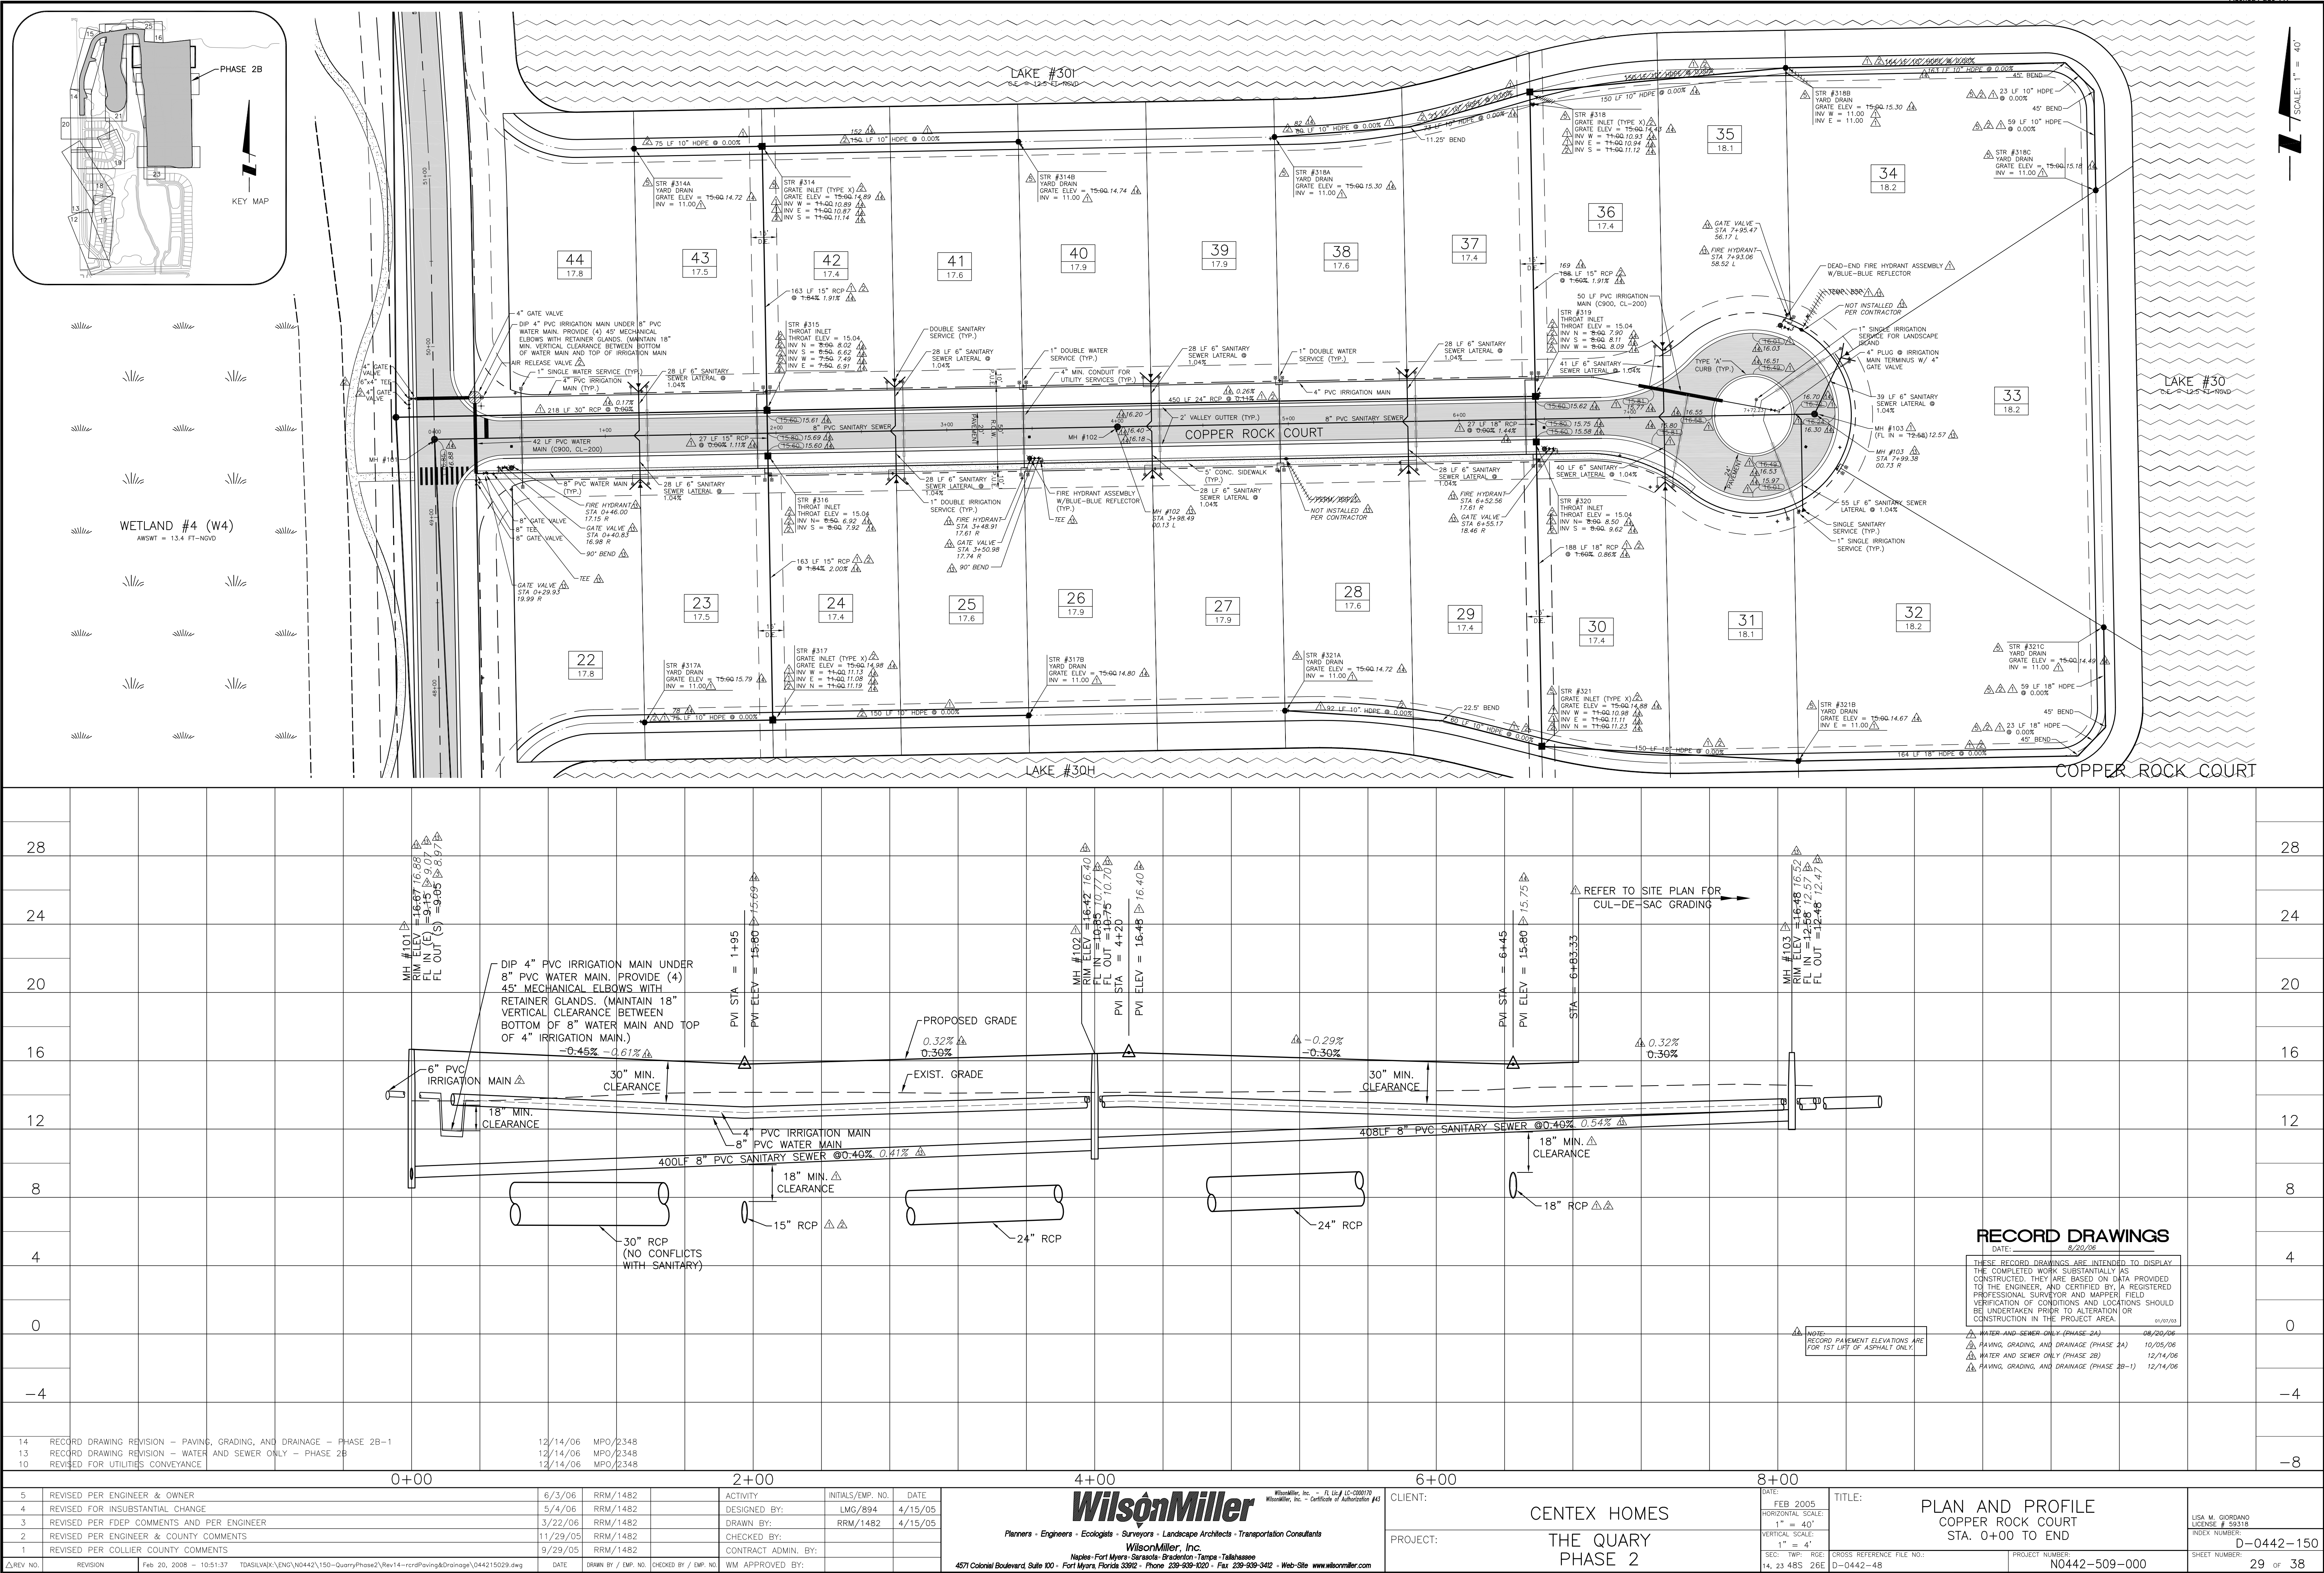

14	RECORD DRAWING REVISION - PAVING, GRADING, AND DRAINAGE - PHASE 2B-1	12/14/06	MPO/2348
13	RECORD DRAWING REVISION - WATER AND SEWER ONLY - PHASE 2B	12/14/06	MPO/2348
10	REVISED FOR UTILITIES CONVEYANCE	12/14/06	MPO/2348
5	REVISED PER ENGINEER & OWNER	6/3/06	RRM/1482
4	REVISED FOR INSUBSTANTIAL CHANGE	5/4/06	RRM/1482
3	REVISED PER FDEP COMMENTS AND PER ENGINEER	3/22/06	RRM/1482
2	REVISED PER ENGINEER & COUNTY COMMENTS	11/29/05	RRM/1482
1	REVISED PER COLLIER COUNTY COMMENTS	9/29/05	RRM/1482
ΔREV NO.	REVISION	Feb. 20, 2008 - 10:51:37	TDASILVA\K\ENG\N0442\150-QuarryPhase2\Rev14-rondPaving&Drainage\044215029.dwg
DATE	DRAWN BY / EMP. NO.	CHECKED BY / EMP. NO.	WM APPROVED BY:
6/3/06	RRM/1482		ACTIVITY
5/4/06	RRM/1482		INITIALS/EMP. NO. DATE
3/22/06	RRM/1482		DESIGNED BY: LMG/894 4/15/05
11/29/05	RRM/1482		DRAWN BY: RRM/1482 4/15/05
9/29/05	RRM/1482		CHECKED BY:
			CONTRACT ADMIN. BY:
			WM APPROVED BY:
WilsonMiller, Inc. - R. L. #1 (C-200710)			
WilsonMiller, Inc. - Certificate of Authorization #43			
Planners - Engineers - Ecologists - Surveyors - Landscape Architects - Transportation Consultants			
WilsonMiller, Inc.			
Naples-Fort Myers-Sarasota-Bretonville-Tampa-Tallahassee			
4571 Colonial Boulevard Suite 100 - Fort Myers, Florida 33907 - Phone 239-939-1020 - Fax 239-939-3412 - Web Site www.wilsonmiller.com			
CLIENT: CENTEX HOMES			
PROJECT: THE QUARRY PHASE 2			
DATE: FEB 2005	TITLE: PLAN AND PROFILE	LISA M. GORDANO	
HORIZONTAL SCALE: 1" = 40'	COPPER ROCK COURT	LICENSE # 59318	
VERTICAL SCALE: 1" = 4'	STA. 0+00 TO END	INDEX NUMBER: D-0442-150	
SEC. 16P - RGE.	CROSS REFERENCE FILE NO.:	PROJECT NUMBER: N0442-509-000	
14, 23 48S 26E	D-0442-48	SHEET NUMBER: 29 OF 38	

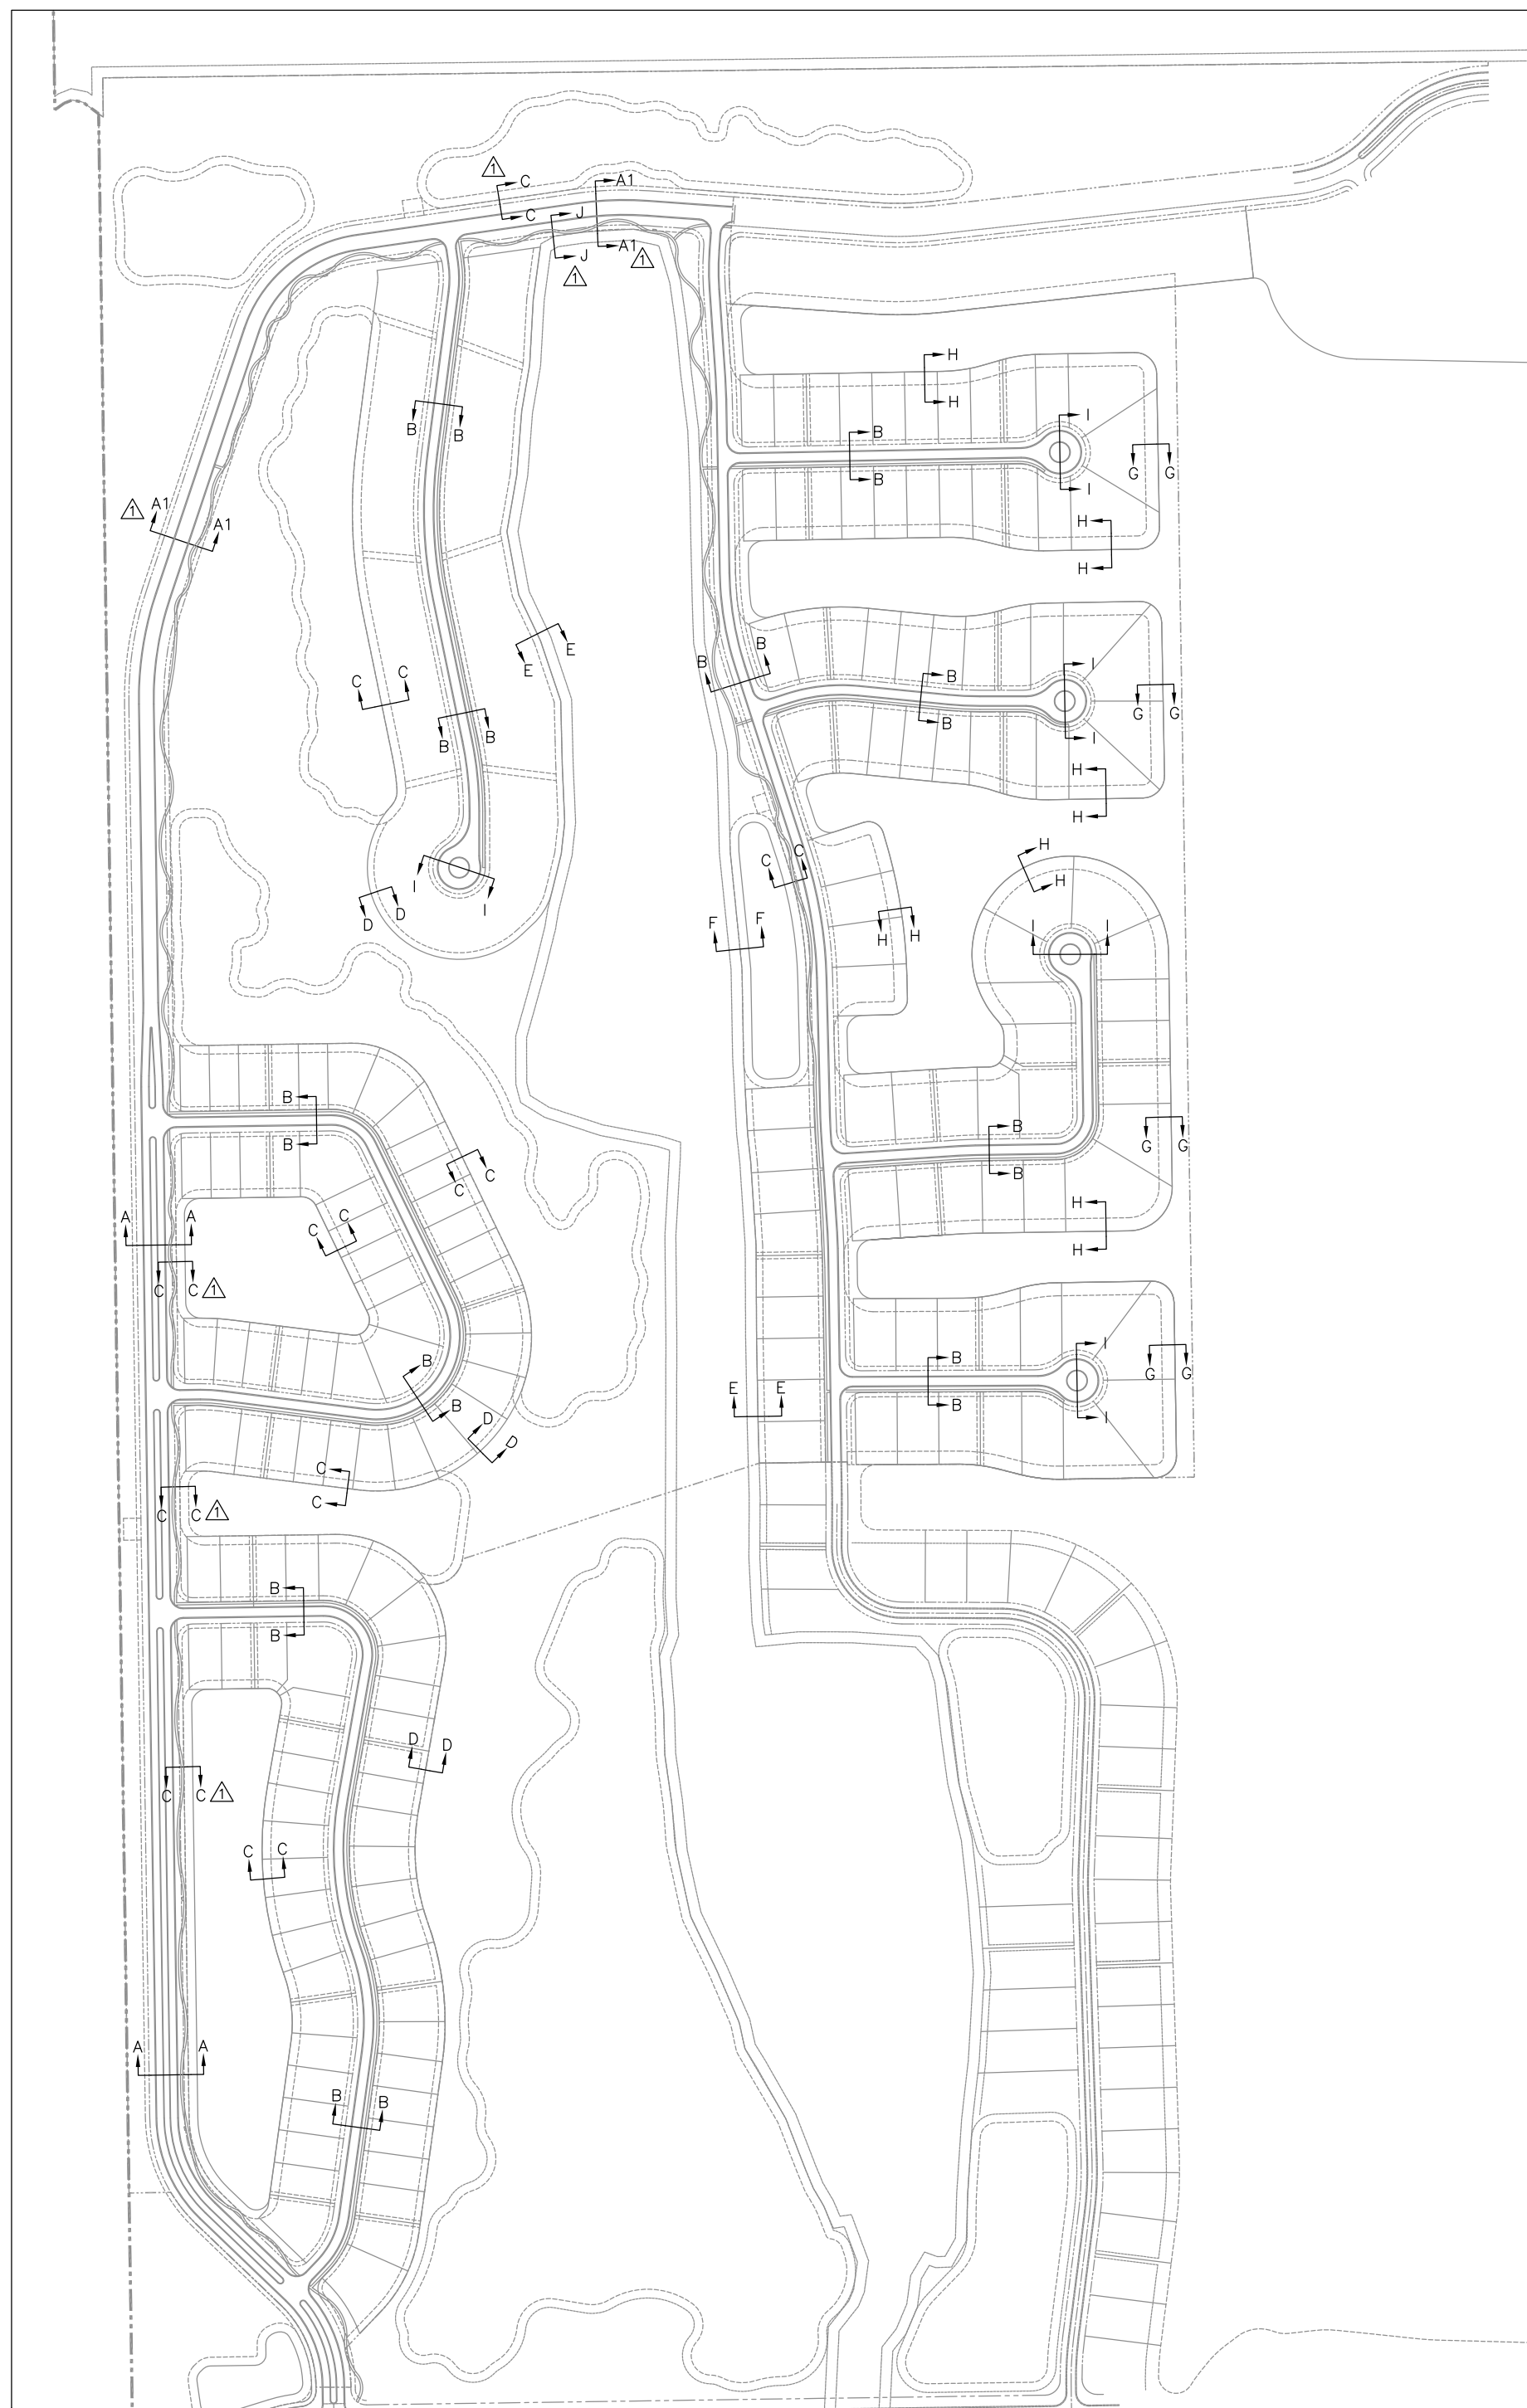


CROSS SECTION MAP

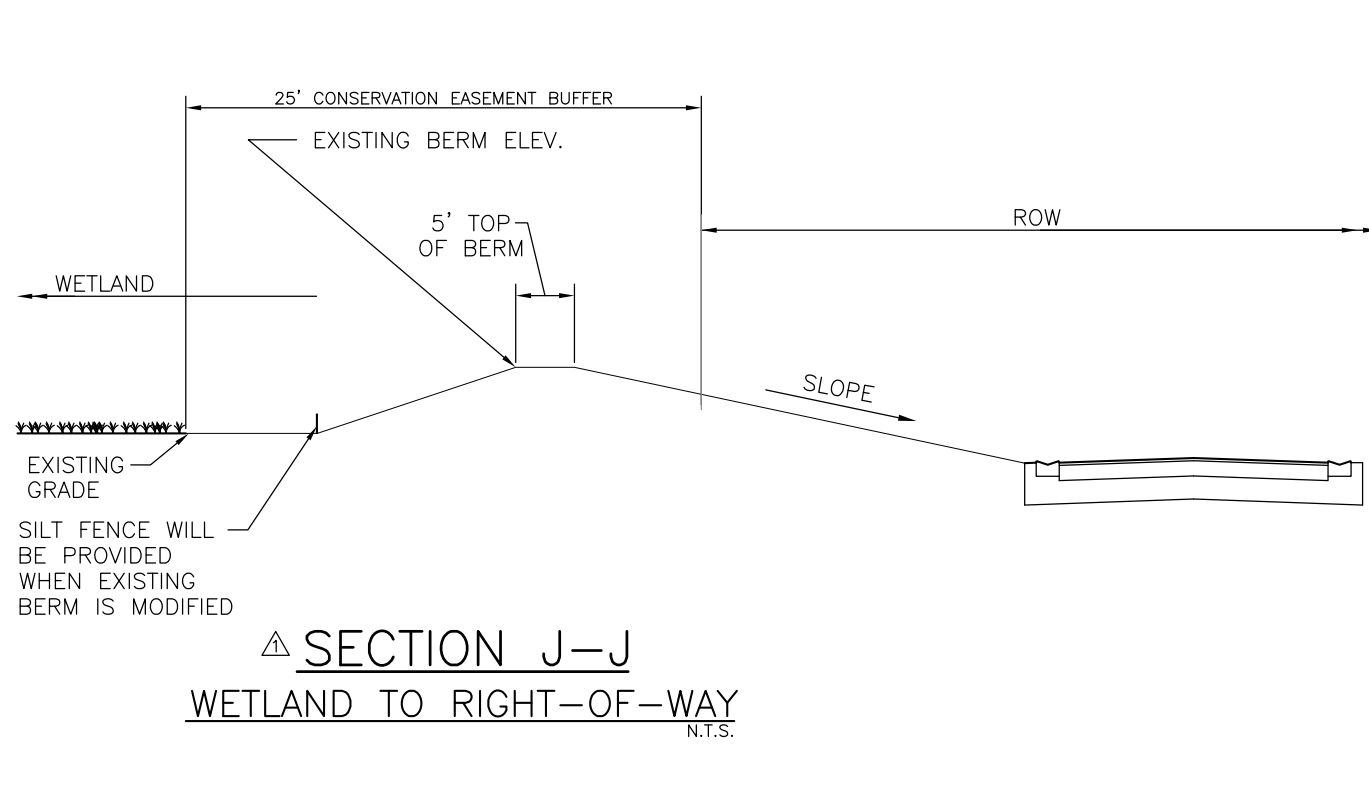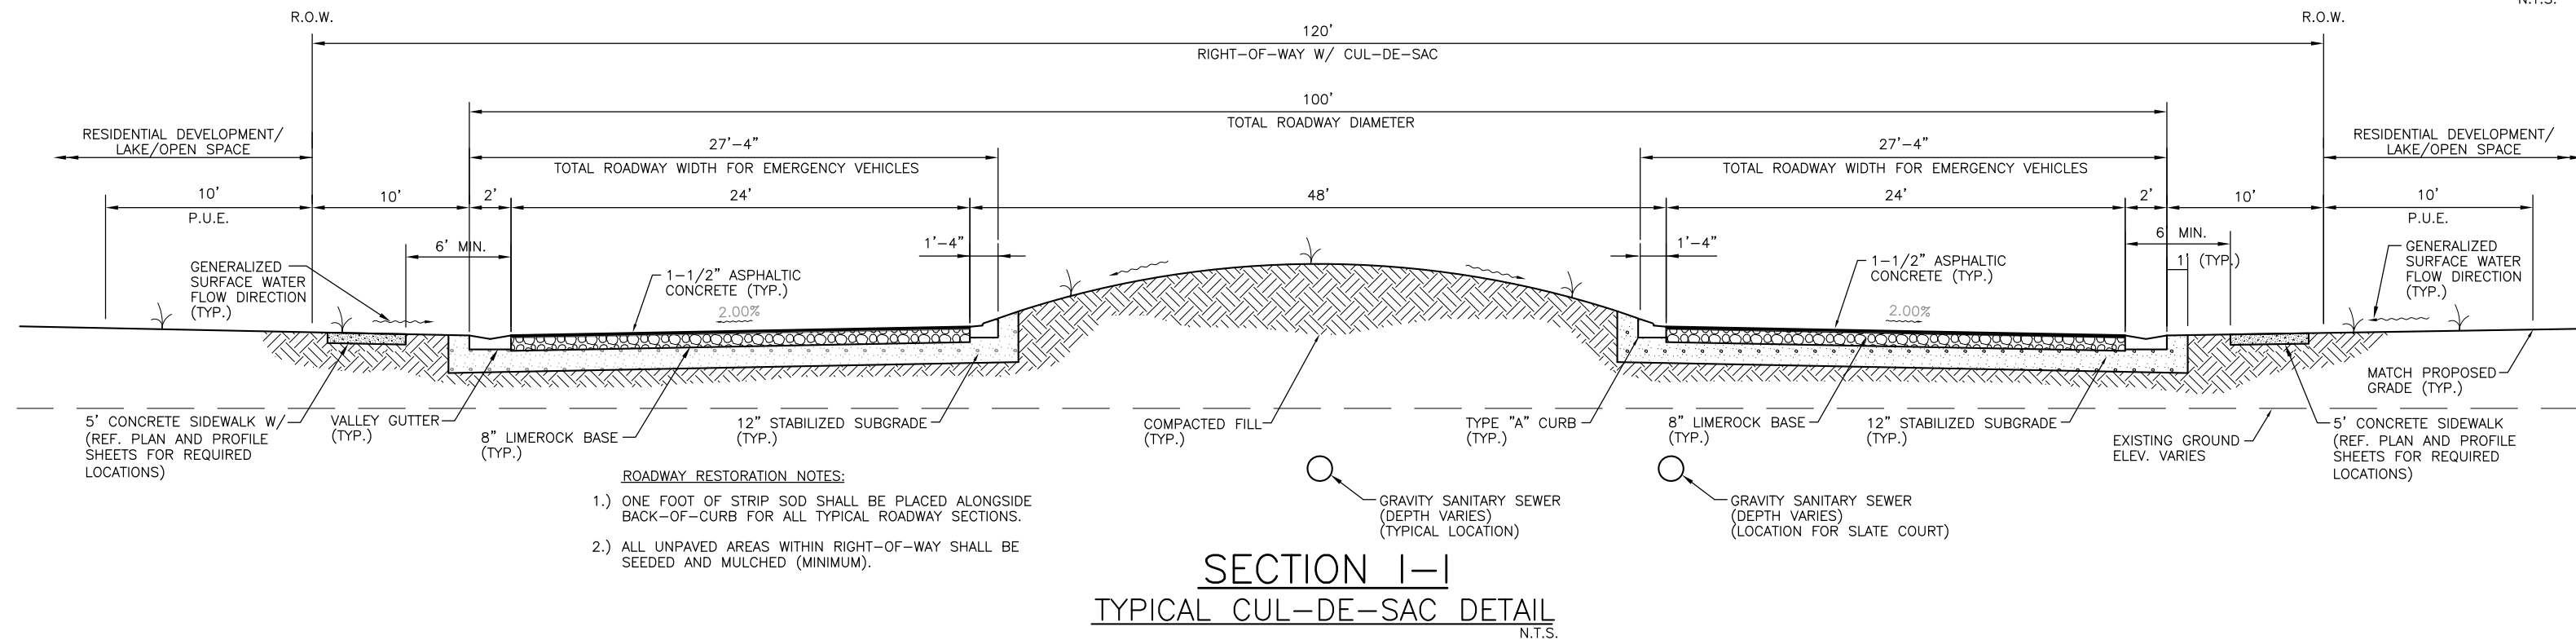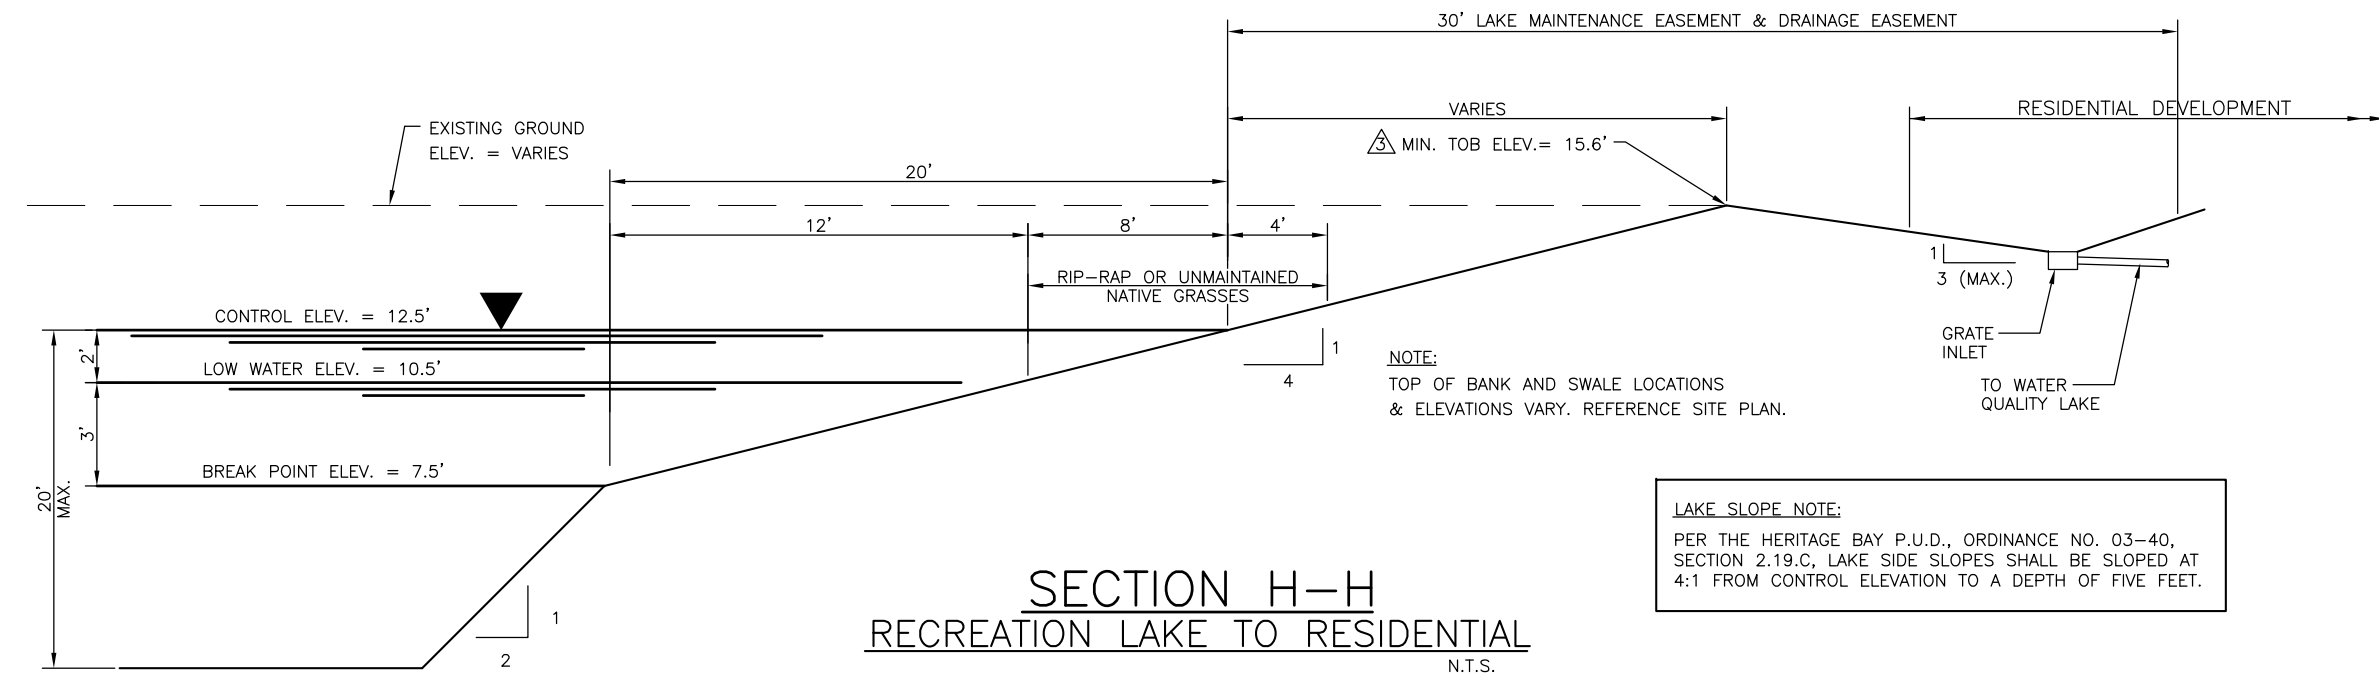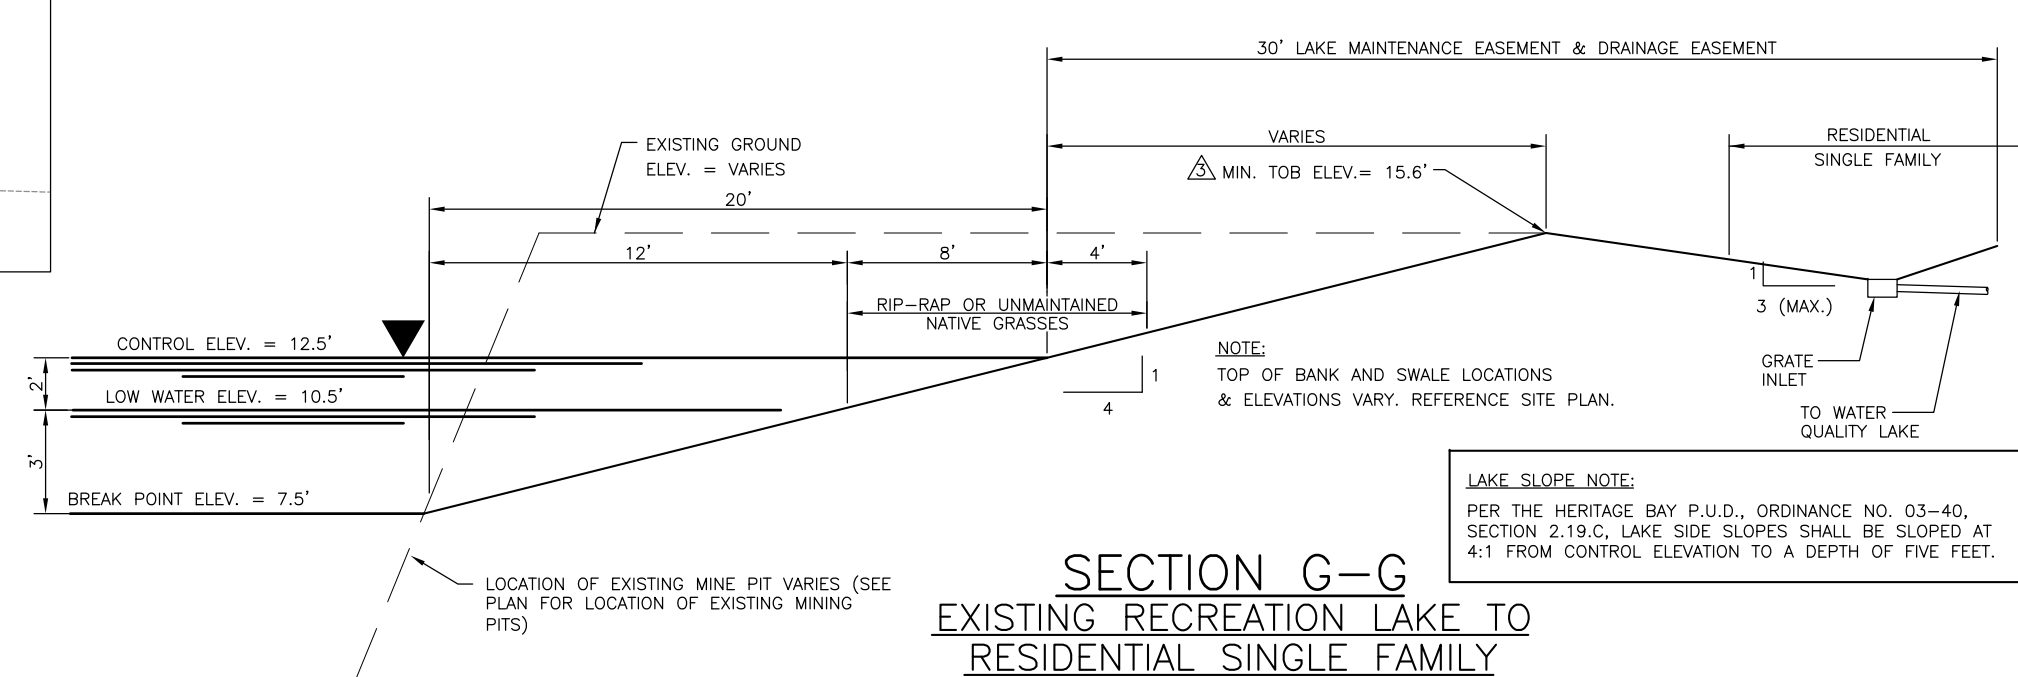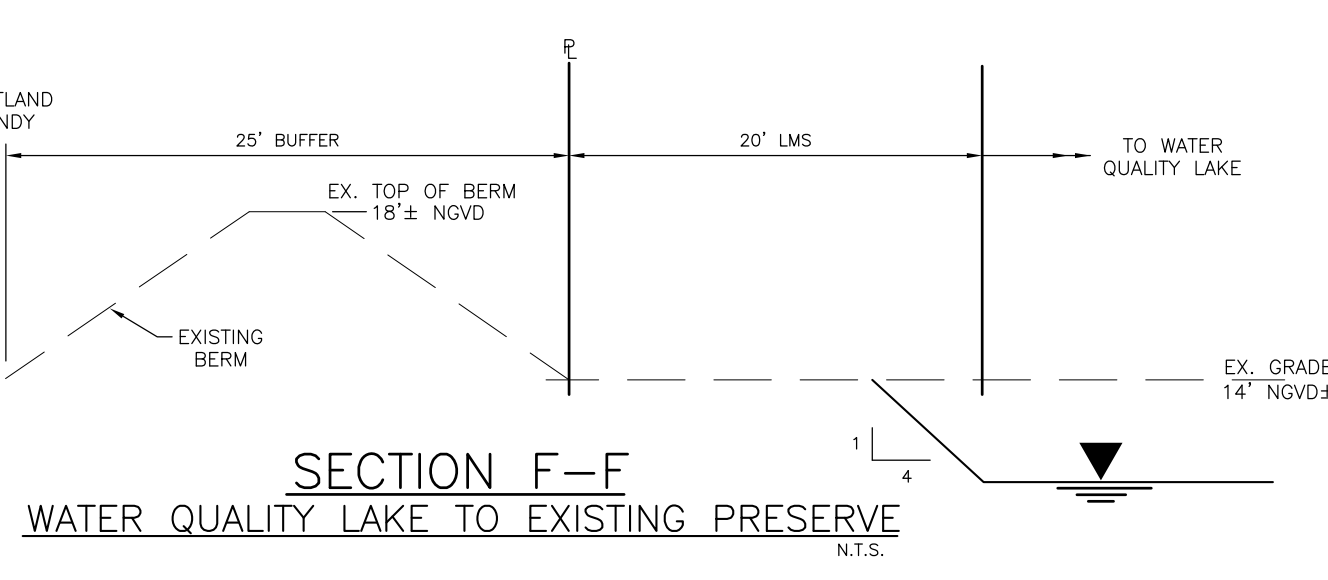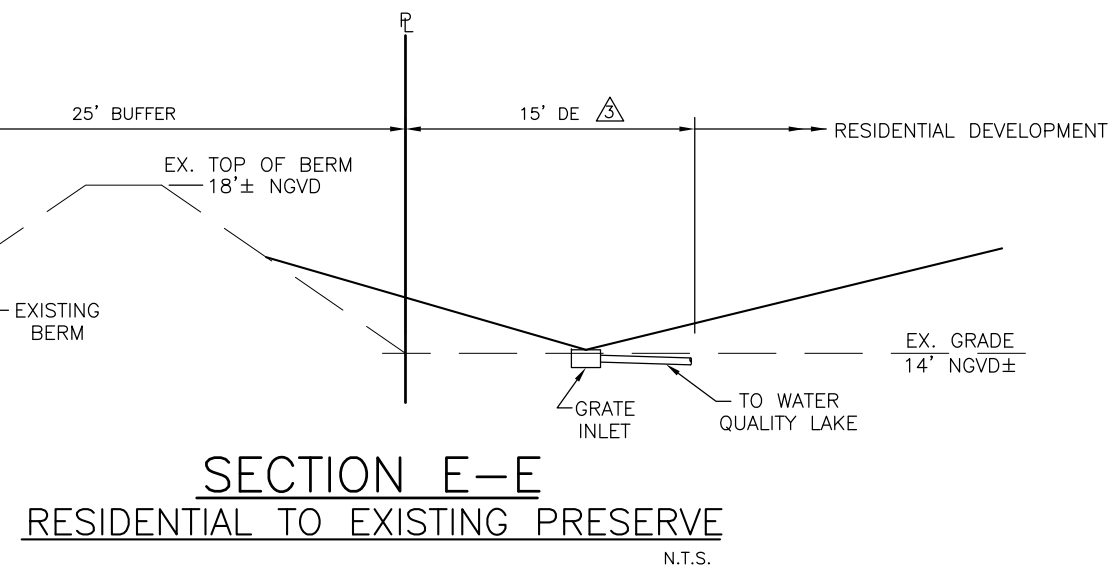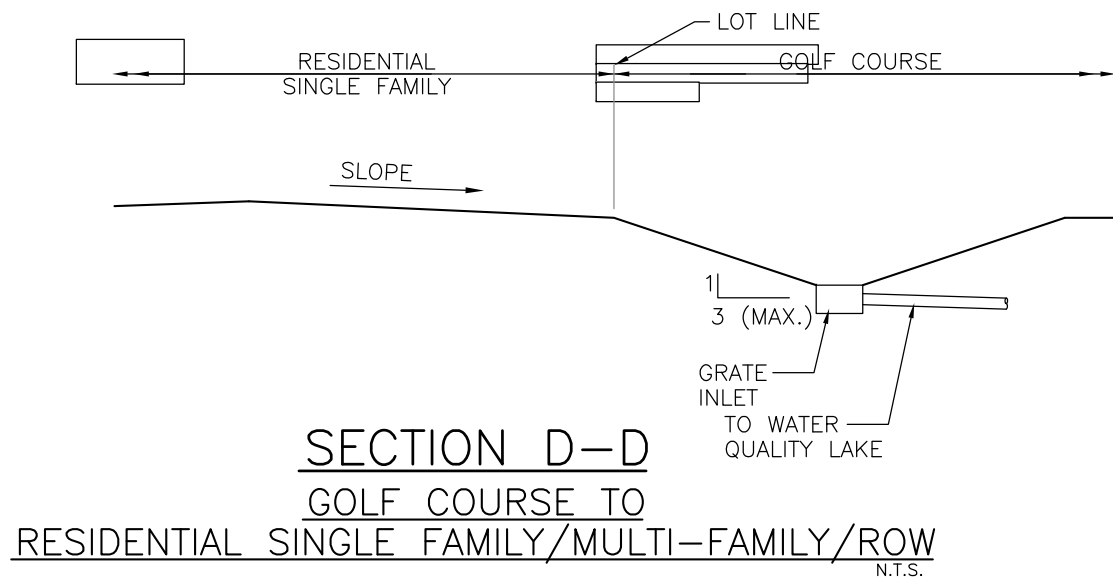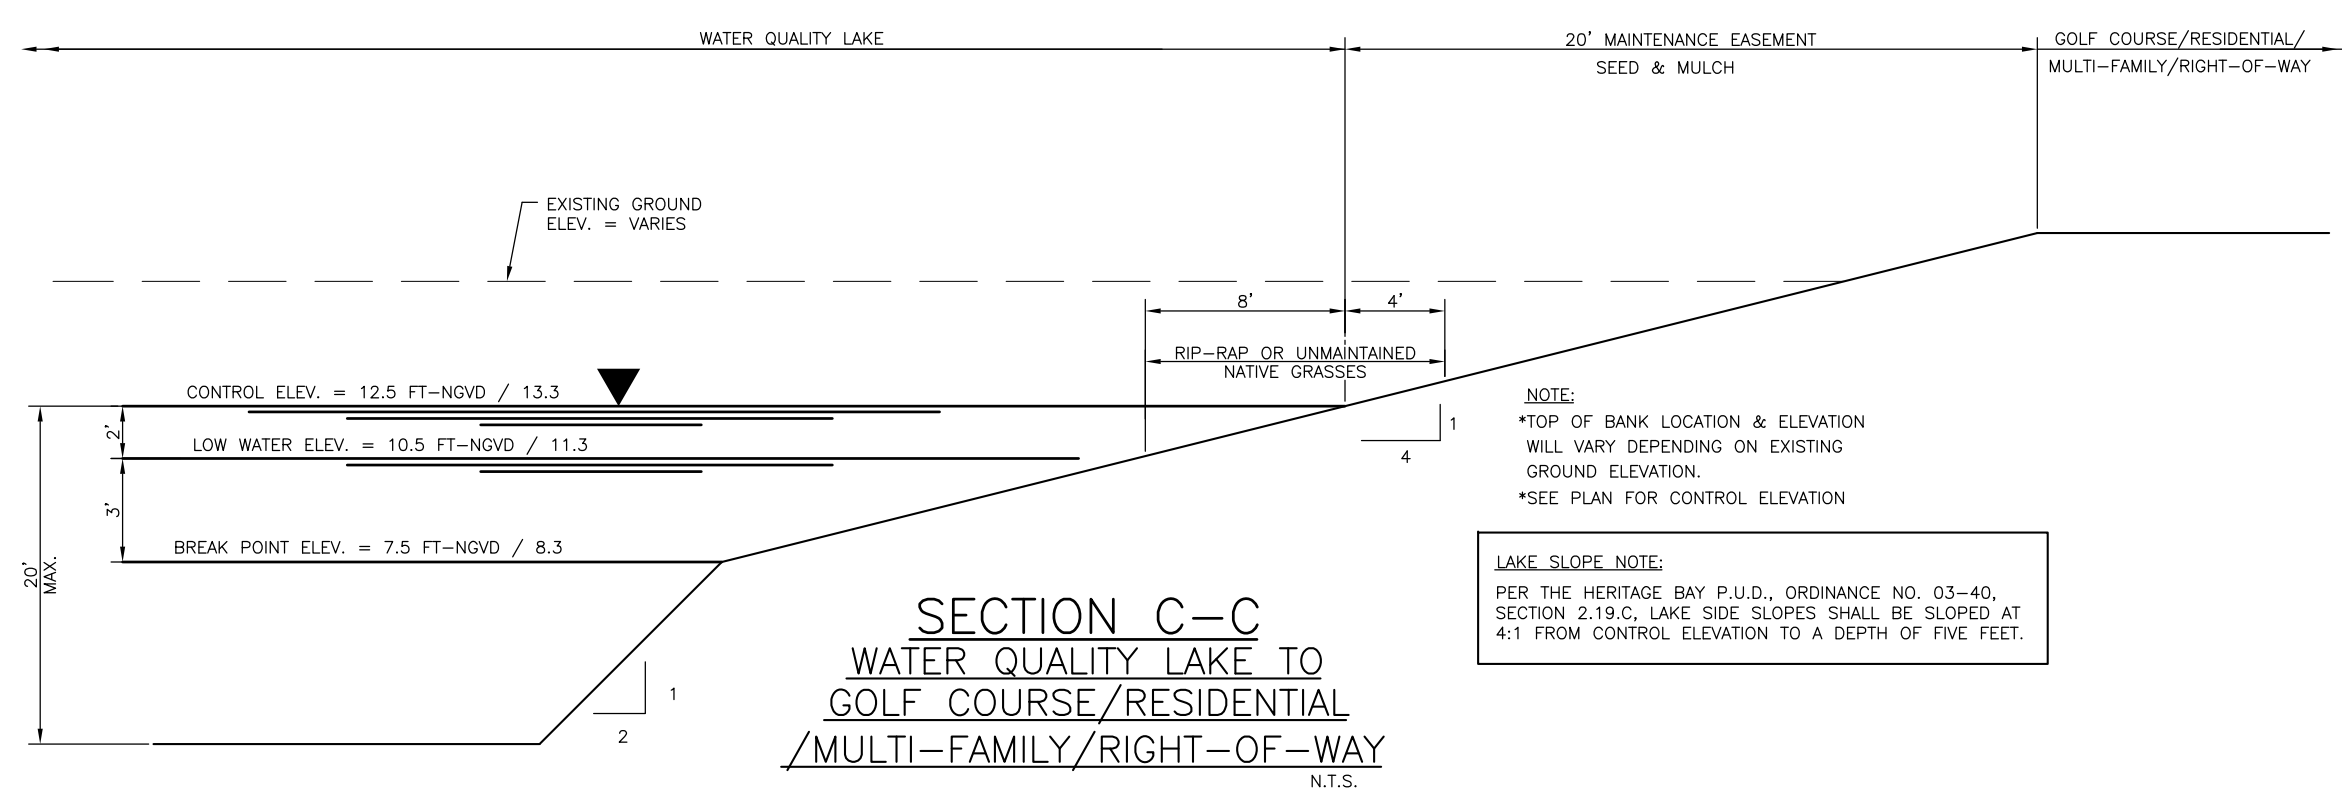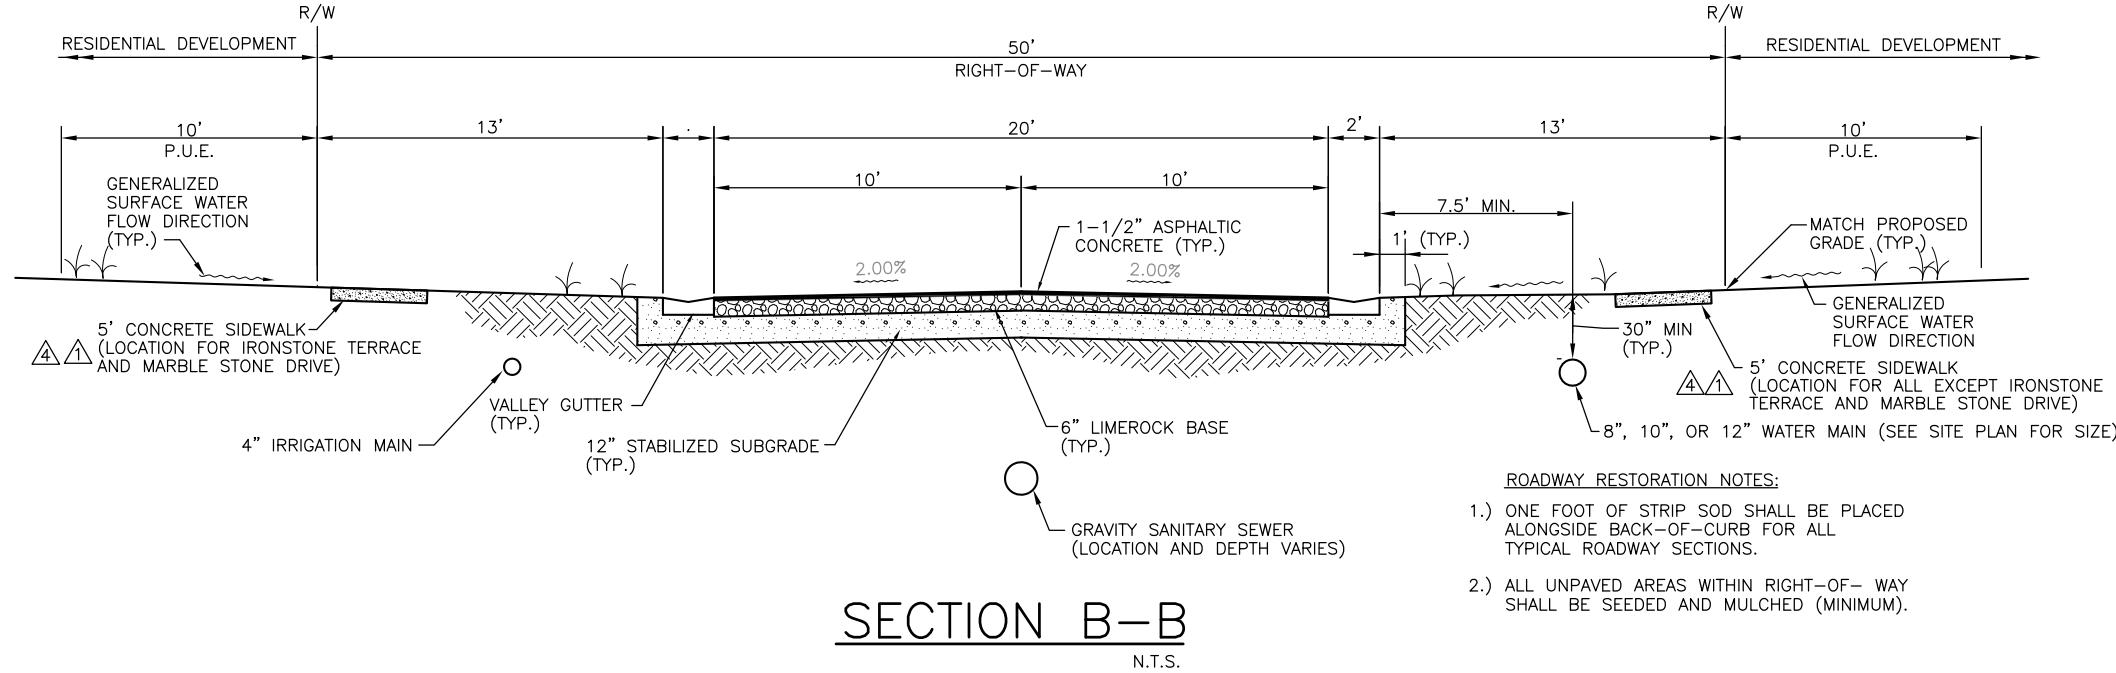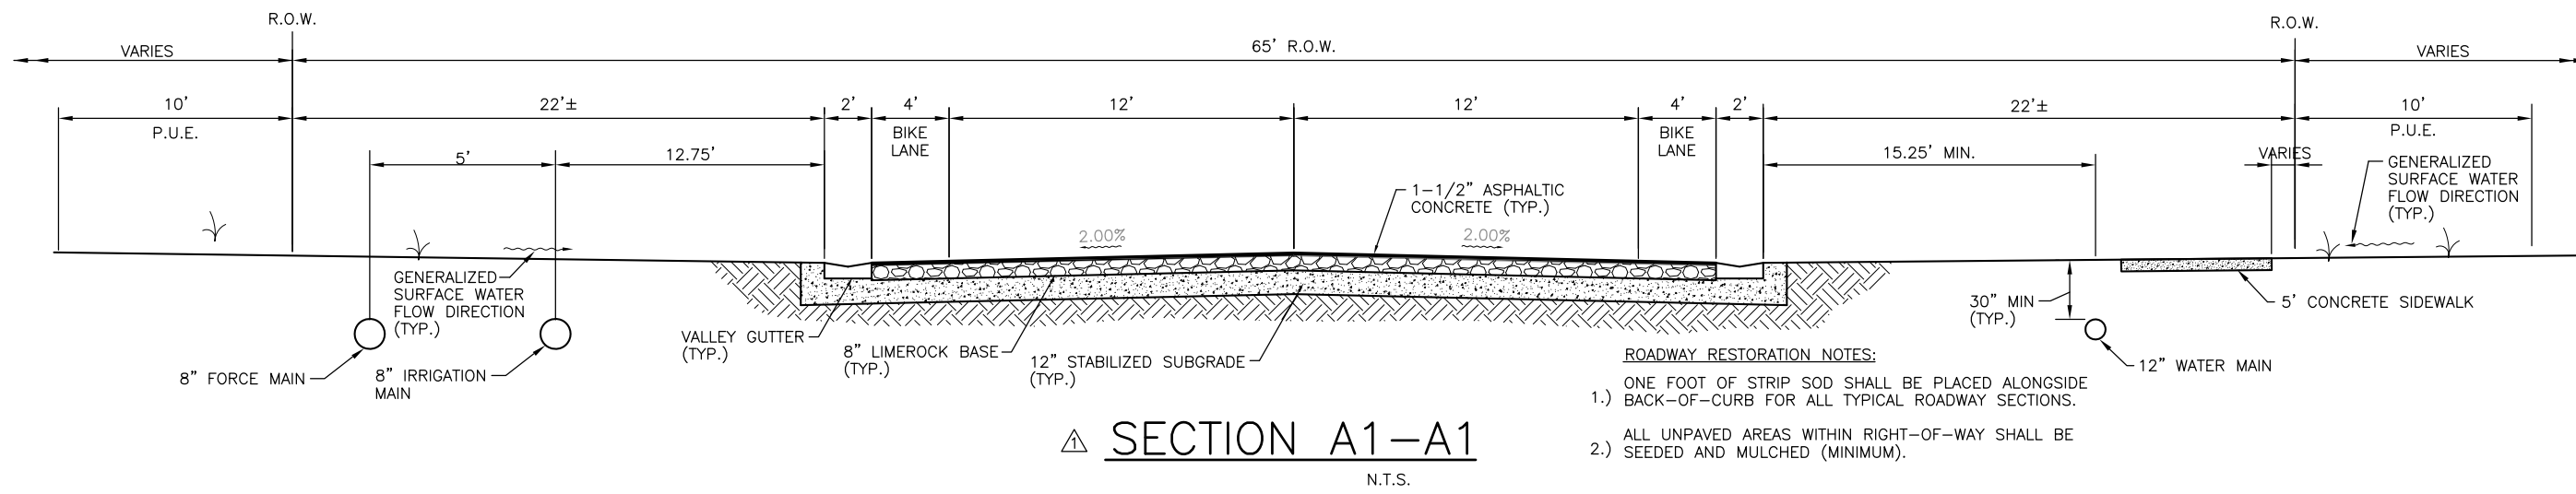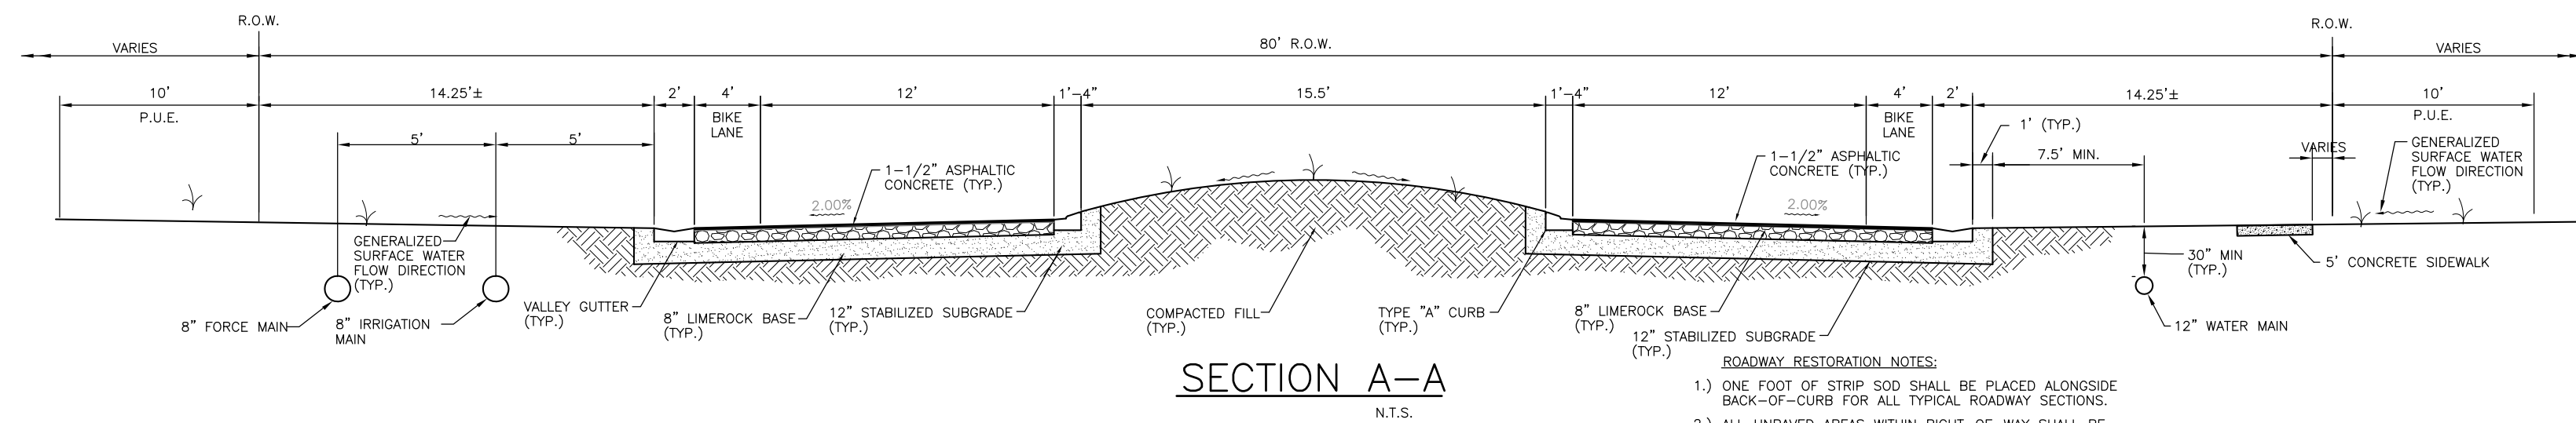


RECORD DRAWINGS

DATE: 8/21/08
THESE RECORD DRAWINGS ARE INTENDED TO DISPLAY THE COMPLETED WORK SUBSTANTIALLY AS CONSTRUCTED. THEY ARE BASED ON DATA PROVIDED TO THE ENGINEER, AND CERTIFIED BY A REGISTERED PROFESSIONAL SURVEYOR AND MAPPER. FIELD VERIFICATION OF CONDITIONS AND LOCATIONS SHOULD BE UNDERTAKEN PRIOR TO ALTERATION OR CONSTRUCTION IN THE PROJECT AREA.
DATE: 01/07/09
WATER AND SEWER ONLY (PHASE 2A) 08/20/08
PAVING, GRADING, AND DRAINAGE (PHASE 2A) 10/05/08
WATER AND SEWER ONLY (PHASE 2B) 12/14/08
PAVING, GRADING, AND DRAINAGE (PHASE 2B-1) 12/14/08


10	REVISED FOR UTILITIES CONVEYANCE	12/14/06	MPO/2348	ACTIVITY	INITIALS/EMP. NO.	DATE	WilsonMiller, Inc. - FL Lic# LC-000170	CLIENT:	CENTEX HOMES	DATE:	FEB 2005	TITLE:	CROSS SECTIONS	LISA M. GORDANO
4	REVISED FOR INSUBSTANTIAL CHANGE	5/4/06	RRM/1482	DESIGNED BY:	LMG/894	4/15/05	WilsonMiller, Inc. - Certificate of Authorization #43	PROJECT:	THE QUARRY PHASE 2	HORIZONTAL SCALE:	AS NOTED	CROSS REFERENCE FILE NO.:	D-0442-48	LICENSE # 59318
3	REVISED PER FDEP COMMENTS AND PER ENGINEER	3/22/06	RRM/1482	DRAWN BY:	RRM/1482	4/15/05	Planners • Engineers • Ecologists • Surveyors • Landscape Architects • Transportation Consultants			VERTICAL SCALE:	AS NOTED	PROJECT NUMBER:	N0442-509-000	INDEX NUMBER:
1	REVISED PER COLLIER COUNTY COMMENTS	9/28/05	RRM/1482	CHECKED BY:			Naples • Fort Myers • Sarasota • Bradenton • Tampa • Tallahassee			SEC. TWO - RGE:	14, 23 48S 26E	SHEET NUMBER:	31 OF 38	D-0442-150
ΔREV NO.	REVISION	Feb 06, 2008 -- 22:48:15	TDASILVAK\END\N0442\150-QuarryPhase2\Rev14-rordPaving&Drainage\044215031.dwg	DATE	DRAWN BY / EMP. NO.	CHECKED BY / EMP. NO.	WM APPROVED BY:							

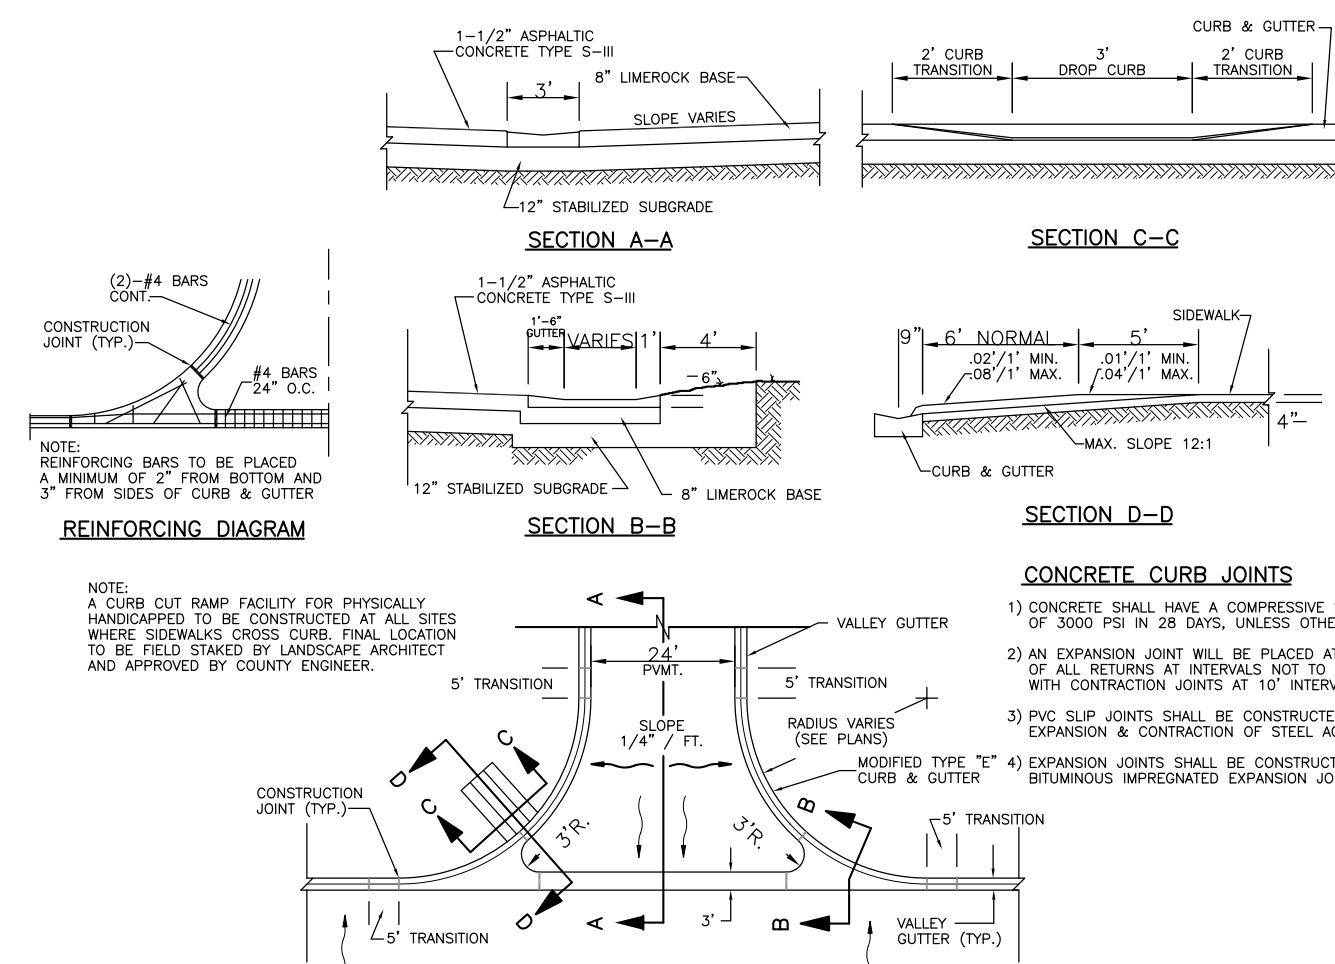


TYPICAL VALLEY CROSSING DETAIL (VALLEY GUTTER)
N.T.S.

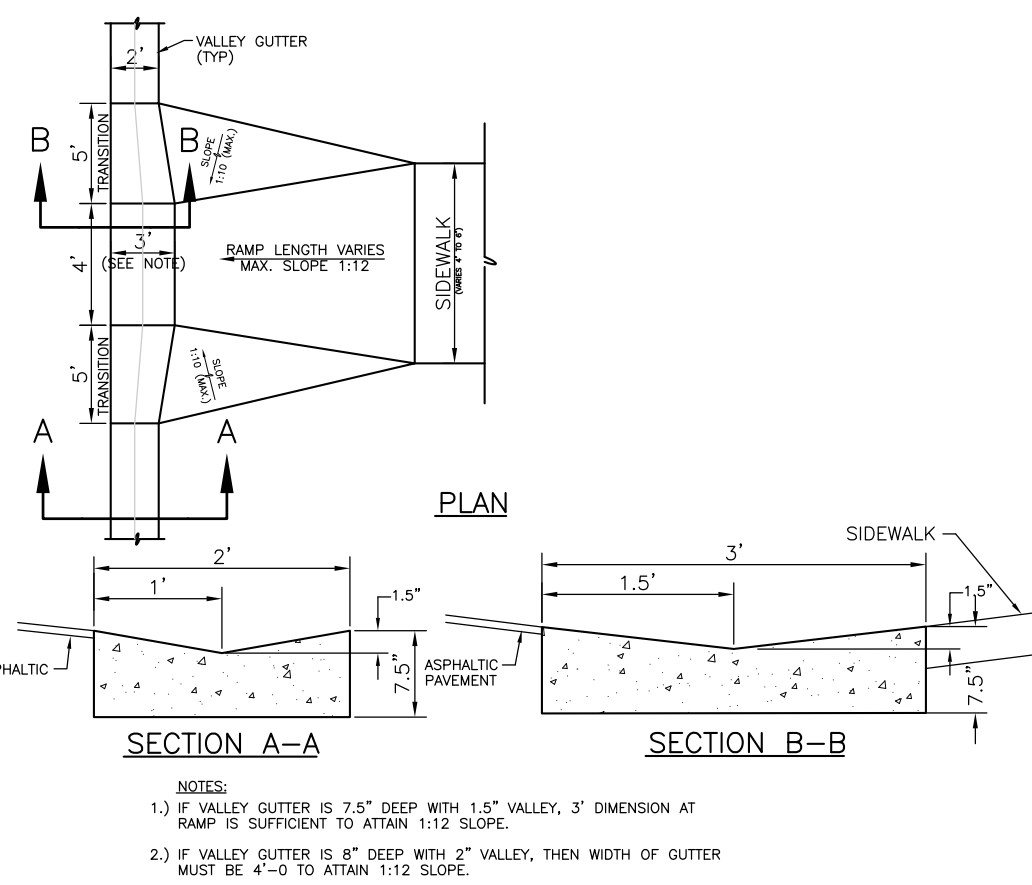


ADA COMPLIANT CURB RAMP CONFIGURATION FOR VALLEY GUTTER
N.T.S.

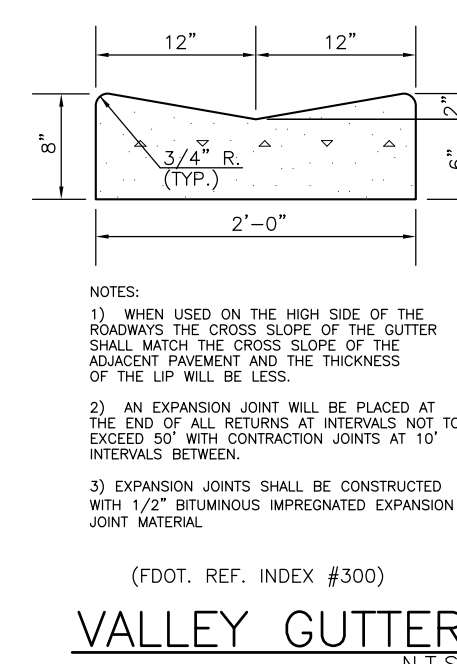


VALLEY GUTTER
N.T.S.

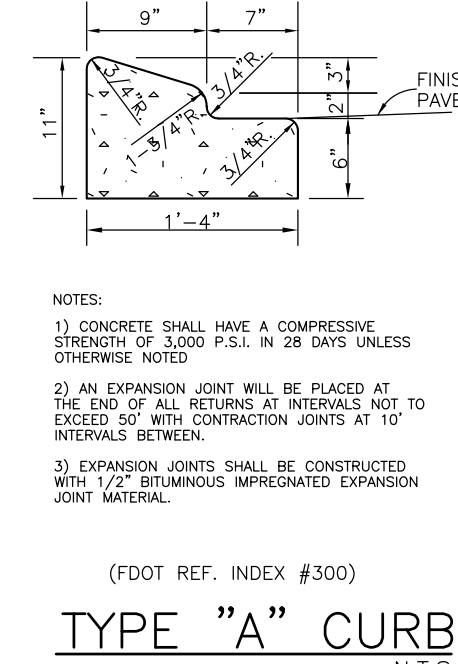


TYPE "A" CURB
N.T.S.

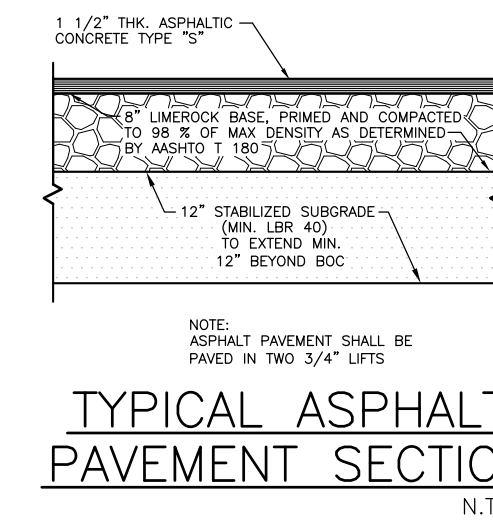


TYPICAL ASPHALT PAVEMENT SECTION
N.T.S.

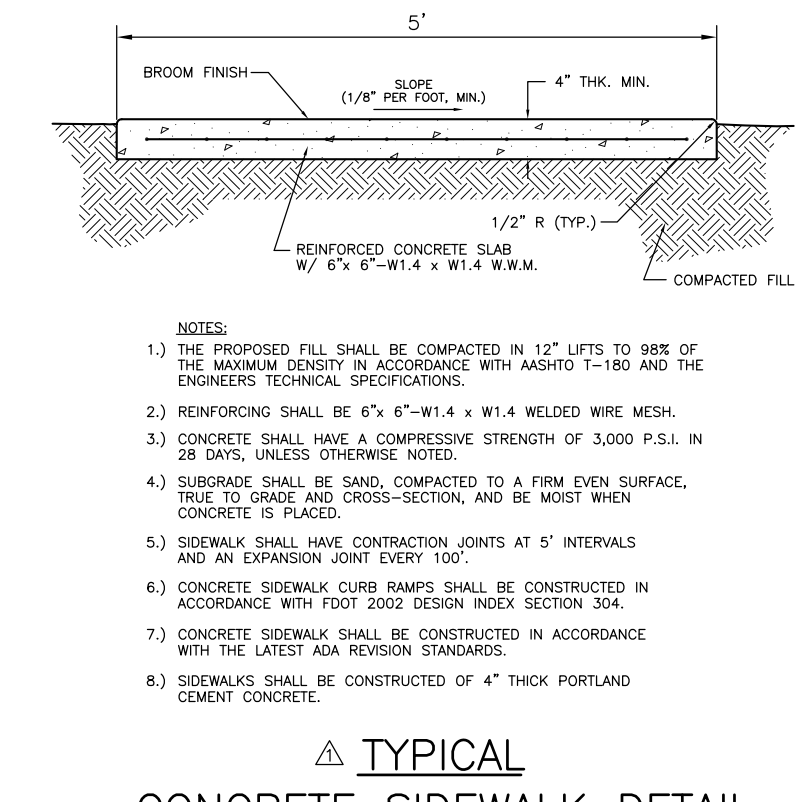


TYPICAL CONCRETE SIDEWALK DETAIL
N.T.S.

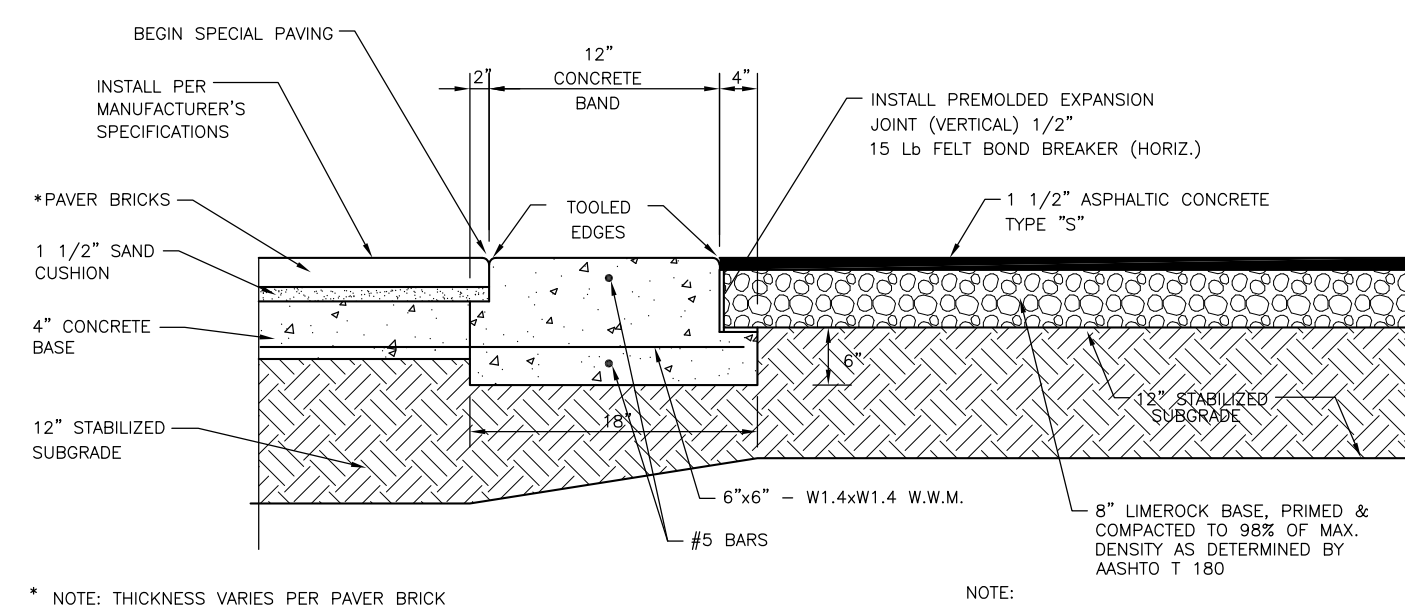


CONCRETE RIBBON AND PAVER BRICK INTERFACE EDGE RESTRAINT DETAIL
N.T.S.

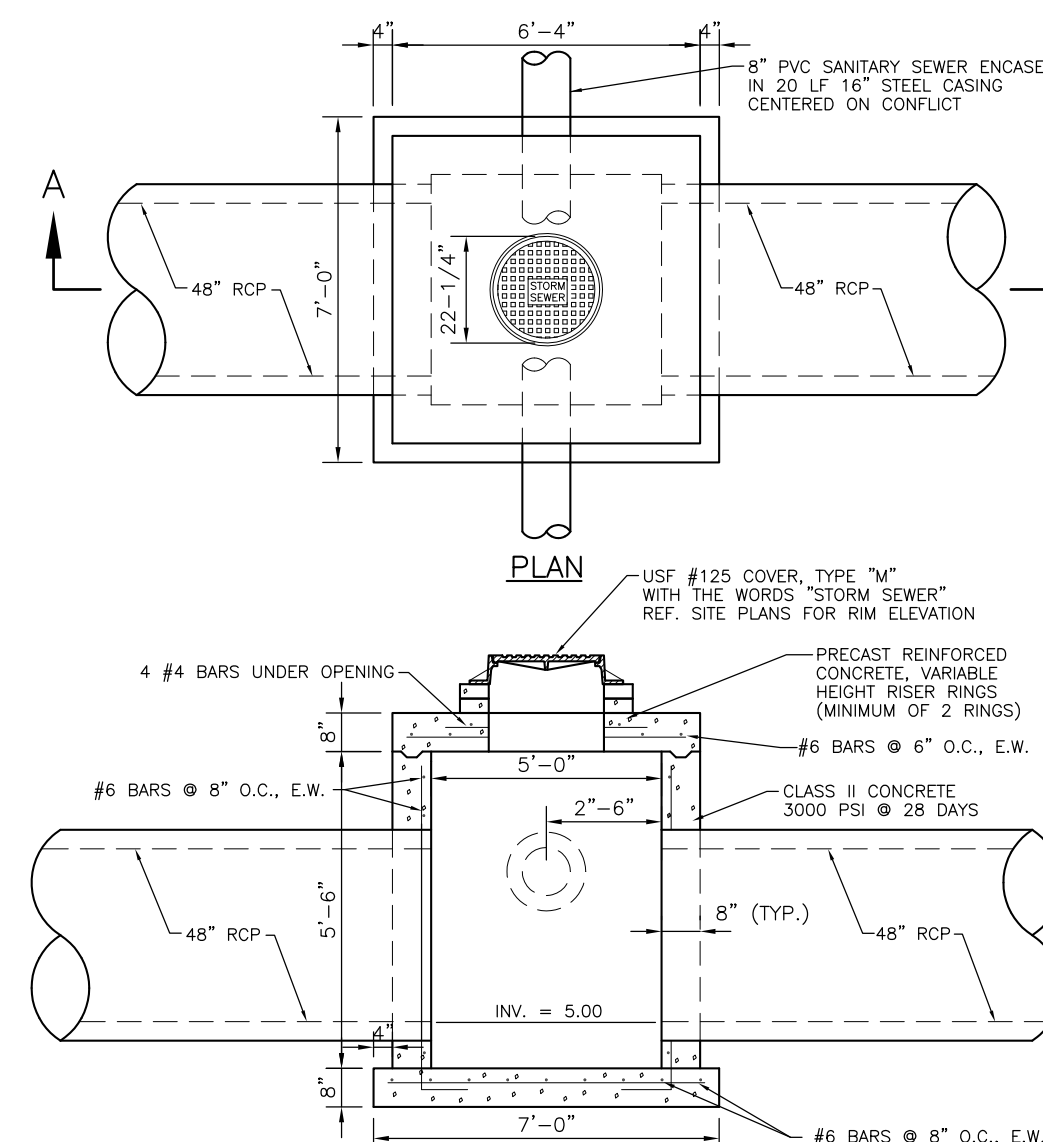


CONFLICT BOX
N.T.S.

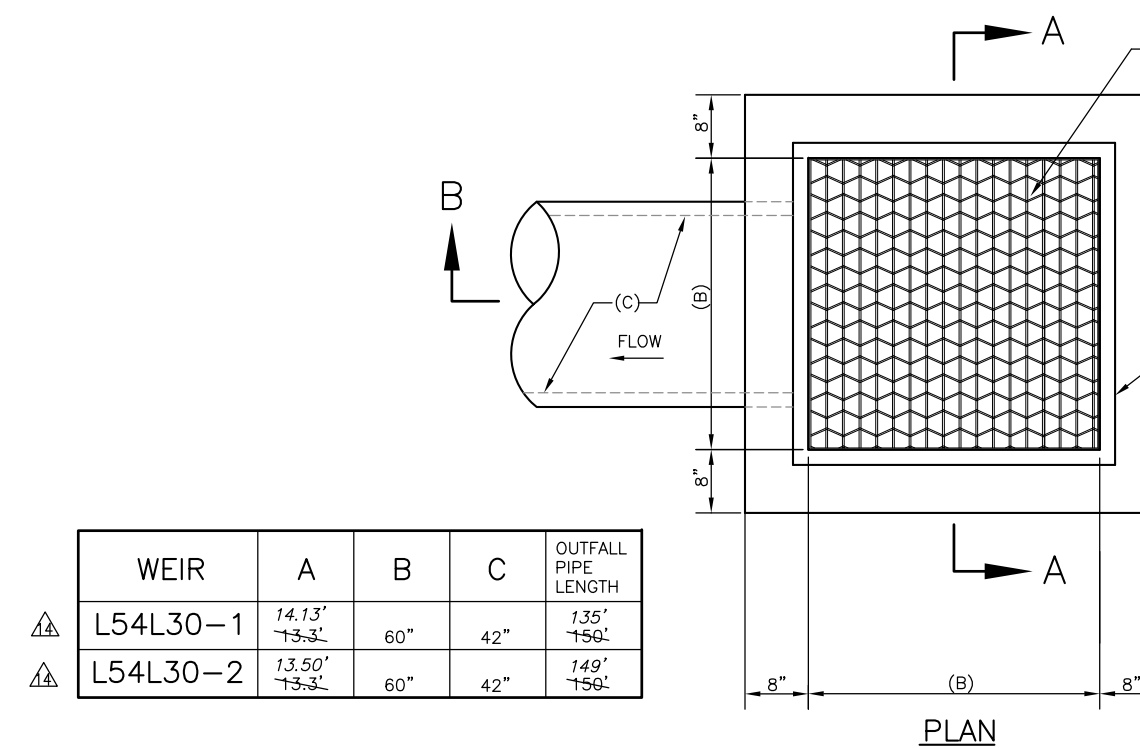

WEIR	A	B	C	OUTFALL PIPE LENGTH
L54L30-1	14.13" 73.3%	60"	42"	155"
L54L30-2	13.50" 73.3%	60"	42"	149"

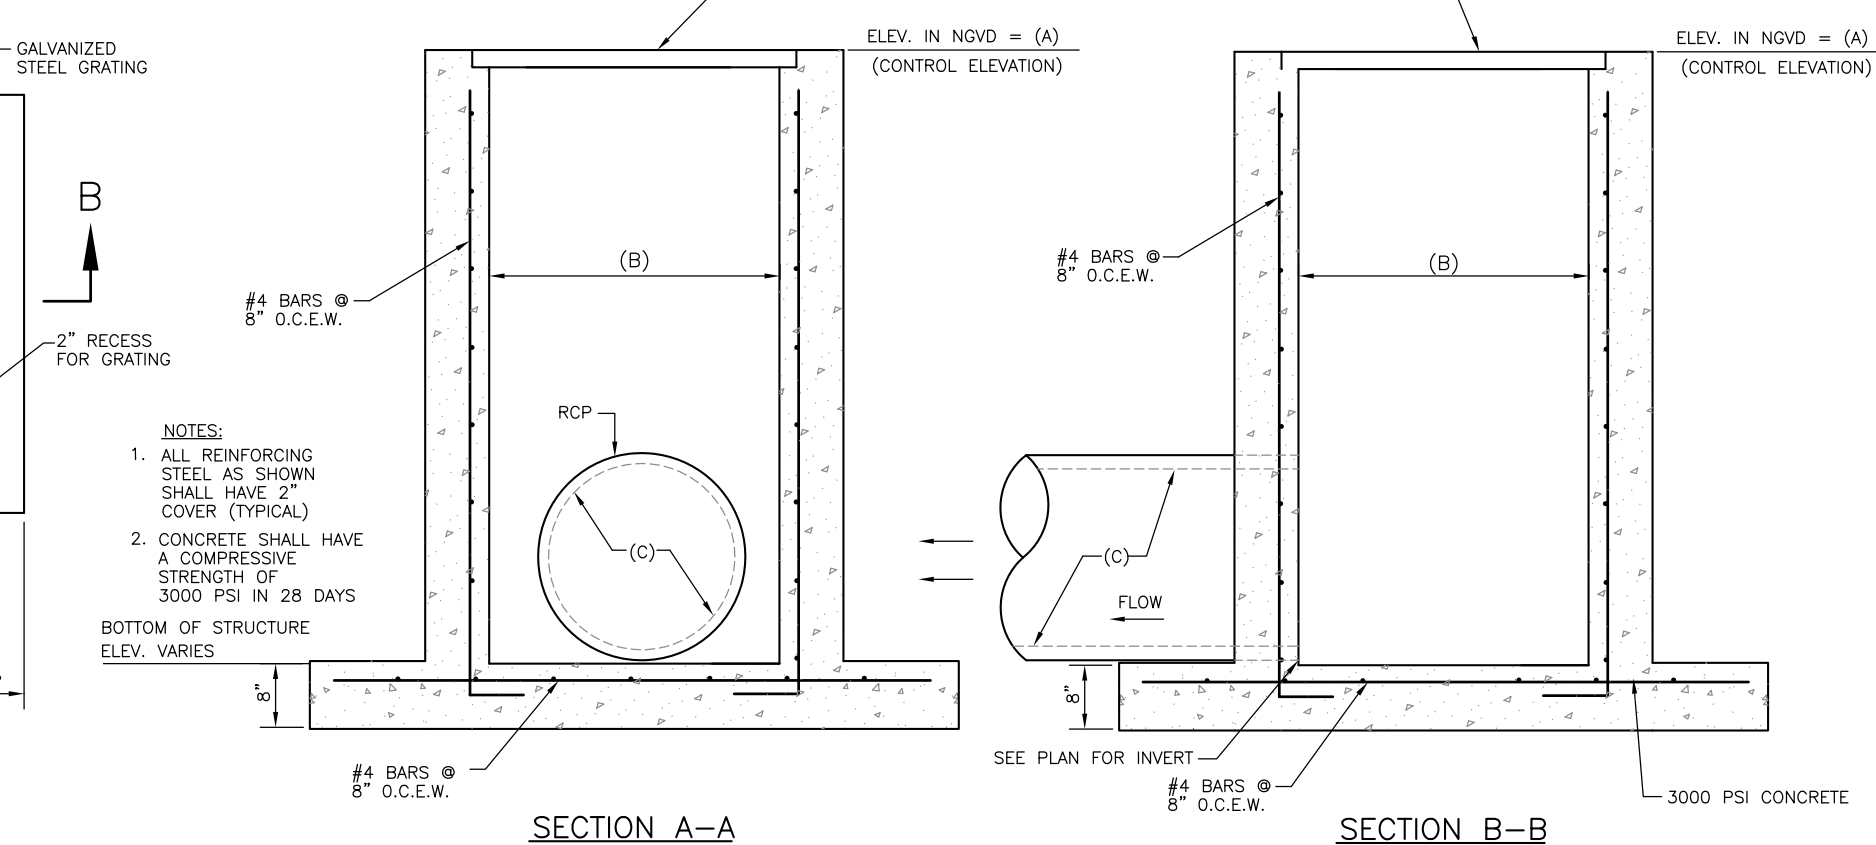

CONTROL STRUCTURES
(SEE TABLE)

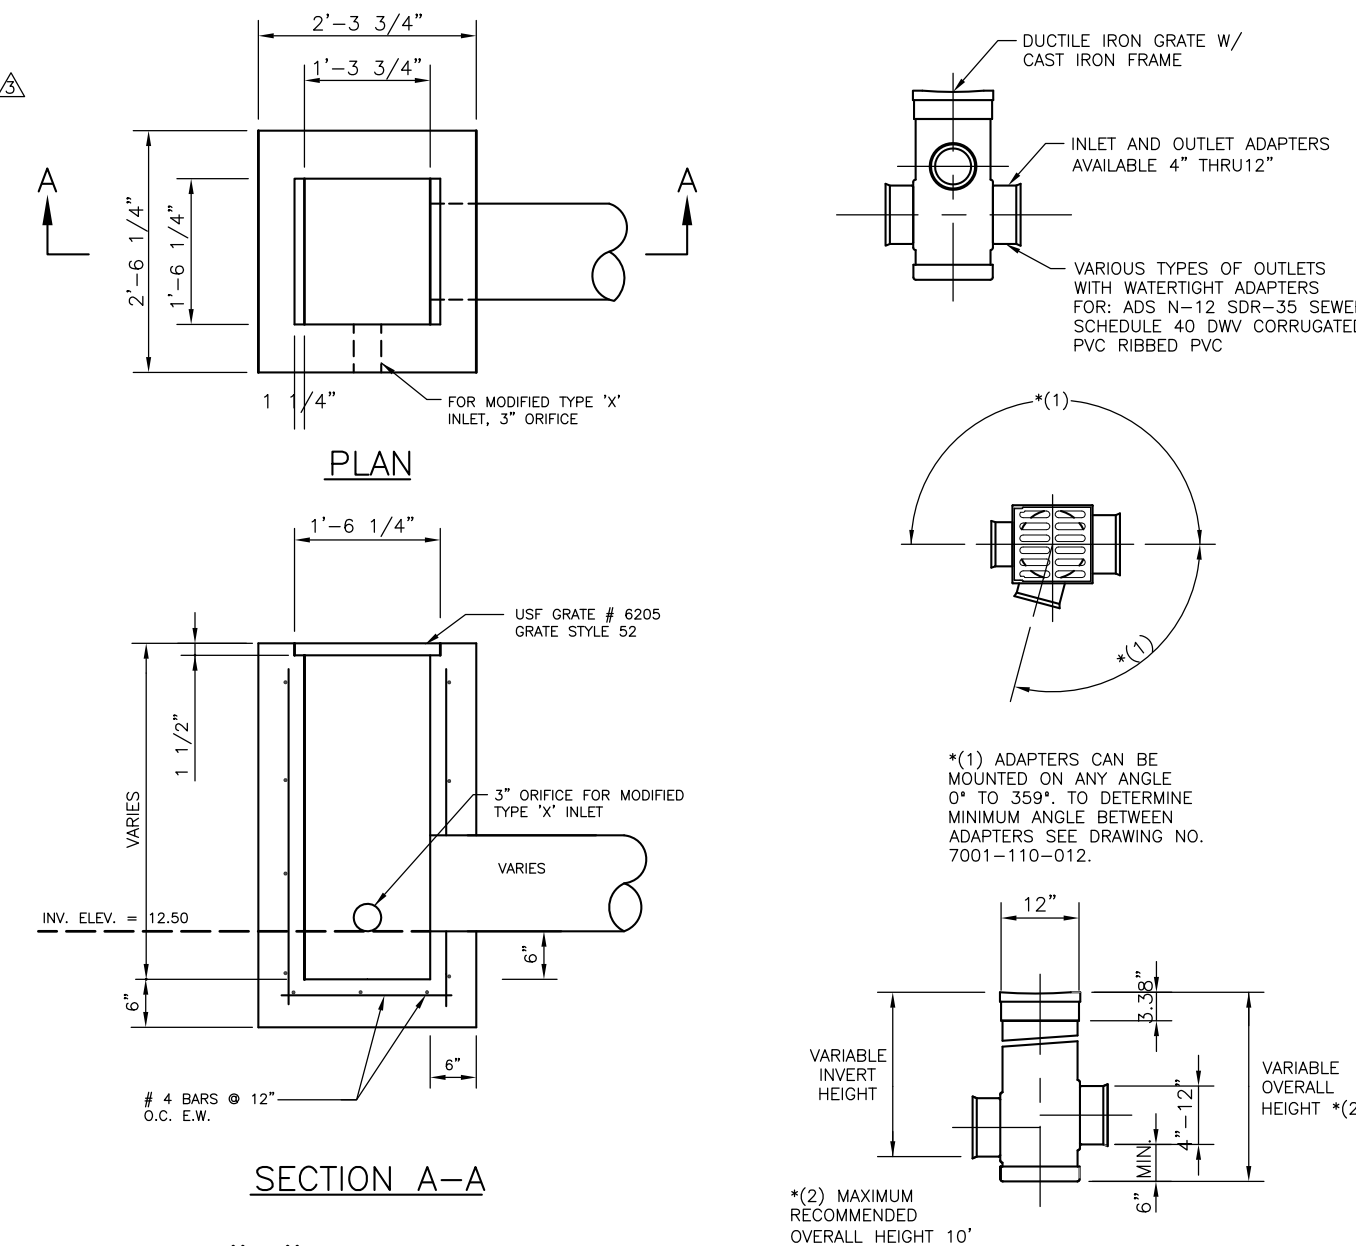

TYPE "X" INLET DETAIL
(AND MODIFIED TYPE 'X' INLET DETAIL)

12" DRAIN BASIN YARD DRAIN BASIN DETAIL
N.T.S.

RECORD DRAWINGS
DATE: 8/20/06

THESE RECORD DRAWINGS ARE INTENDED TO DISPLAY THE COMPLETED WORK SUBSTANTIALLY AS CONSTRUCTED. THEY ARE BASED ON DATA PROVIDED TO THE ENGINEER, AND CERTIFIED BY A REGISTERED PROFESSIONAL SURVEYOR AND MAPPER. FIELD VERIFICATION OF CONDITIONS AND LOCATIONS SHOULD BE UNDERTAKEN PRIOR TO ALTERATION OR CONSTRUCTION IN THE PROJECT AREA.


DATE: 8/20/06

WATER AND SEWER ONLY (PHASE 2A) 08/20/06

PAVING, GRADING, AND DRAINAGE (PHASE 2A) 10/05/06

WATER AND SEWER ONLY (PHASE 2B) 12/14/06

PAVING, GRADING, AND DRAINAGE (PHASE 2B-1) 12/14/06

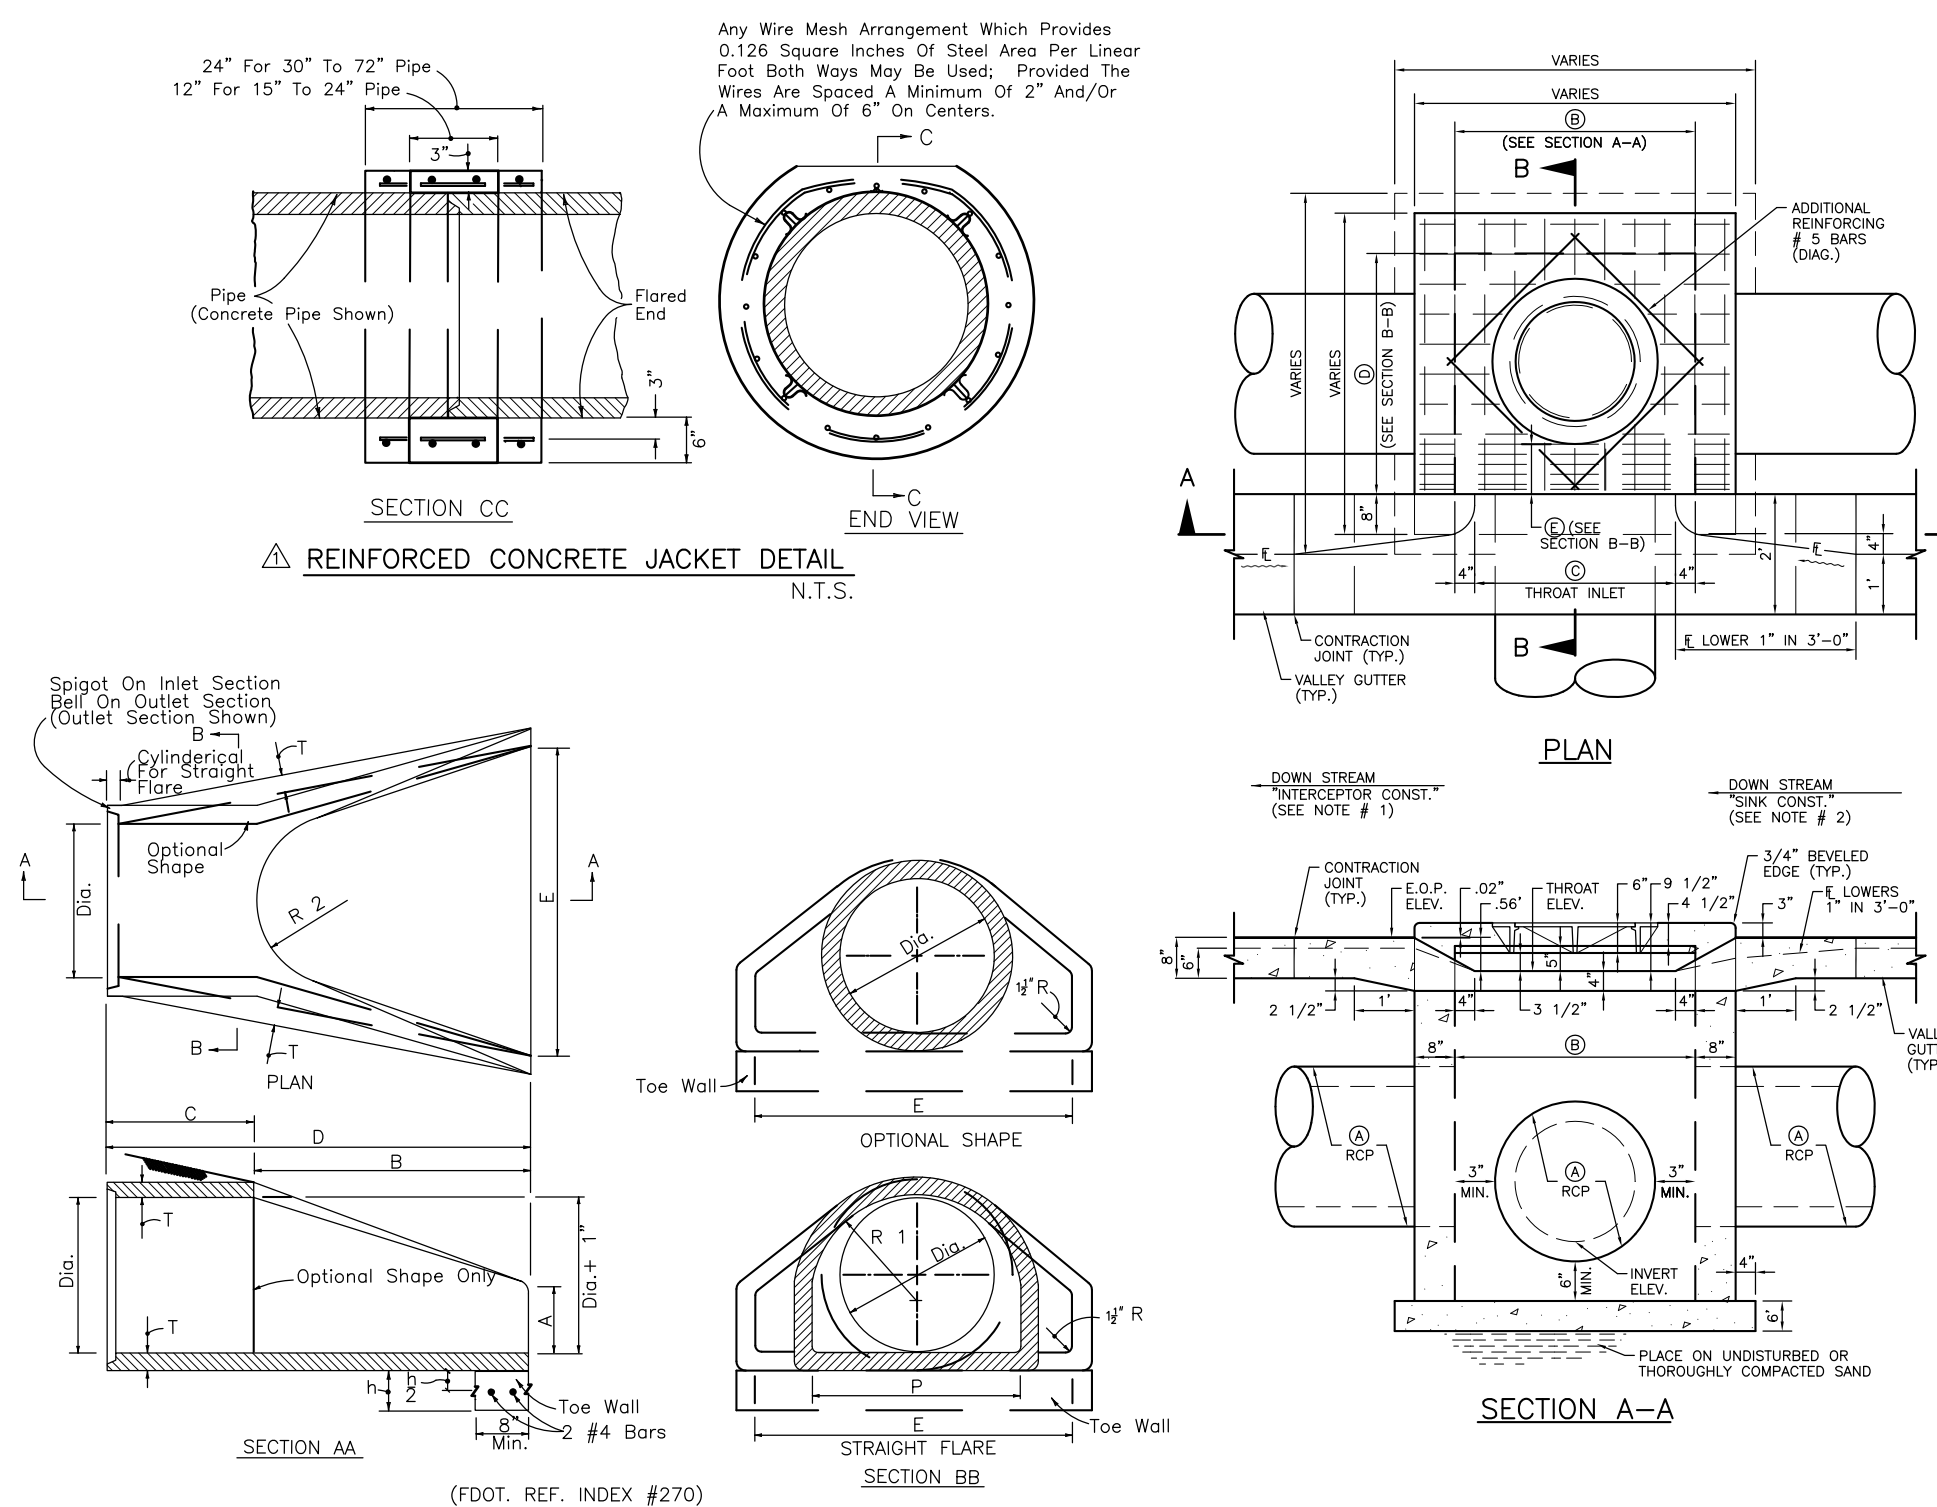


FLARED END SECTION
N.T.S.


DESIGN NOTES:

1. SUBSECTOR CONSTRUCTION: WHEN INLET FUNCTIONS AS AN INTERCEPTOR, THE DOWNSTREAM PART OF VALLEY GUTTER SHALL BE CONSTRUCTED AS SHOWN ON THE LEFT OF PLAN VIEW AND SECTION A-A. STRUCTURE AND VALLEY GUTTER ARE SYMMETRICAL.
2. WHEN INLET FUNCTIONS AS A SINK, THE VALLEY GUTTER FLOW SHALL COVER THE INLET. THE THREE FEET (3') AND TRANSITION AS SHOWN ON RIGHT OF PLAN VIEW AND SECTION A-A. (CONSTRUCTION & VALLEY GUTTER ARE SYMMETRICAL).
3. WHEN INLET IS USED ON CURVED CURB SECTIONS, FRONT FACE OF BOX SHALL BE POURED AGAIN TO CURB.
4. ALL REINFORCING STEEL AS SHOWN SHALL HAVE TWO INCH (2") MINIMUM COVER.
5. ALL CONCRETE SHALL HAVE A COMPRESSIVE STRENGTH OF 3000 PSI @ 28 DAYS.


Ø	Ø	Ø	Ø	Ø
15"	48"	48"	48"	10' MIN.
18"	48"	48"	48"	10' MIN.
24"	48"	48"	48"	10' MIN.
30"	48"	48"	48"	10' MIN.
36"	48"	48"	48"	10' MIN.
42"	48"	48"	48"	10' MIN.
48"	54"	48"	54"	10' MIN.
54"	60"	48"	60"	12' MIN.

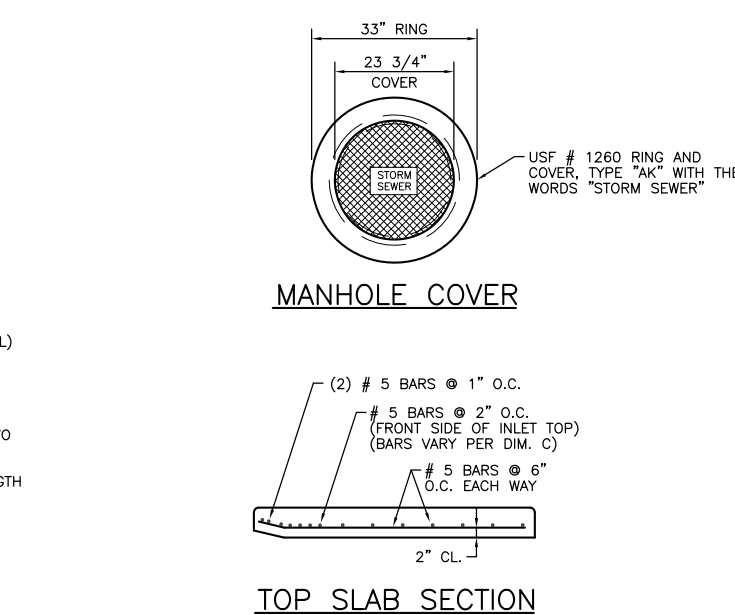

TOP SLAB SECTION

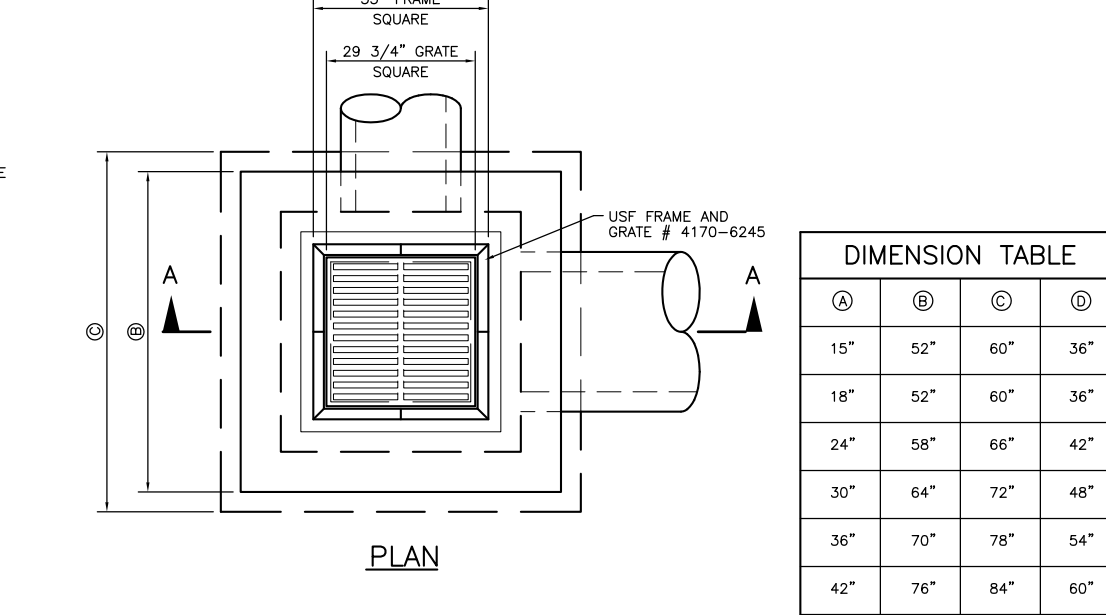

GRATE INLET DETAIL
N.T.S.

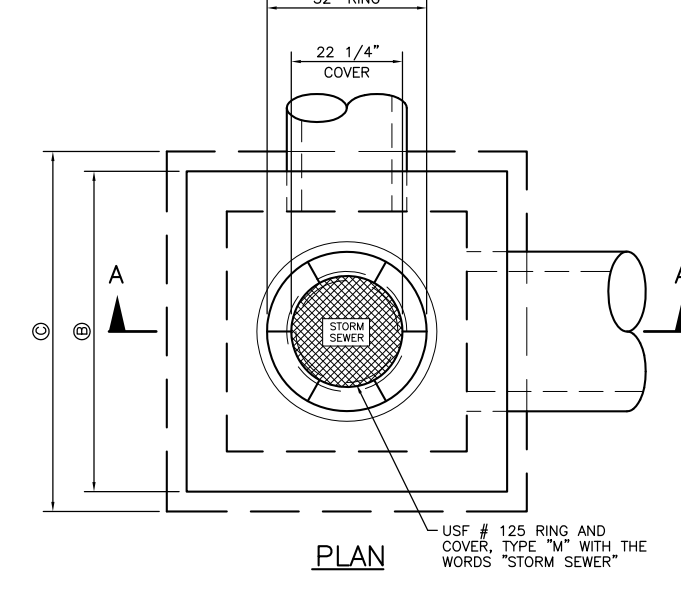

JUNCTION BOX DETAIL
N.T.S.

THROAT INLET DETAIL (WITH VALLEY GUTTER)
N.T.S.

14	RECORD DRAWING REVISION - PAVING, GRADING, AND DRAINAGE - PHASE 2B
10	REVISED FOR UTILITIES CONVEYANCE
6	REVISED FOR UTILITY DEVIATION
3	REVISED PER FDEP COMMENTS AND PER ENGINEER
1	REVISED PER COLLIER COUNTY COMMENTS

DATE	DRAWN BY / EMP. NO.	CHECKED BY / EMP. NO.	WM APPROVED BY:
12/14/06	MPO/2348		
12/14/06	MPO/2348		
6/20/06	RRM/1482		
3/22/06	RRM/1482		
9/28/05	RRM/1482		

ACTIVITY	INITIALS/EMP. NO.	DATE
DESIGNED BY:	LMG/894	4/15/05
DRAWN BY:	RRM/1482	4/15/05
CHECKED BY:		
CONTRACT ADMIN. BY:		
WM APPROVED BY:		

WilsonMiller, Inc.	WilsonMiller, Inc. - FL Lic # LC-000170
Planners • Engineers • Ecologists • Surveyors • Landscape Architects • Transportation Consultants	WilsonMiller, Inc. - Certificate of Authorization #03
Naples • Fort Myers • Sarasota • Bradenton • Tampa • Tallahassee	
457 Colonial Boulevard Suite 100 • Fort Myers, Florida 33902 • Phone 239-939-1222 • Fax 239-939-3442 • Web Site www.wilsonmiller.com	

CLIENT:	CENTEX HOMES
PROJECT:	THE QUARRY PHASE 2
DATE:	FEB 2005
HORIZONTAL SCALE:	AS NOTED
VERTICAL SCALE:	AS NOTED
CROSS REFERENCE FILE NO.:	D-0442-48
PROJECT NUMBER:	N0442-509-000
SHEET NUMBER:	32 OF 38
LISA M. GORDANO	LISA M. GORDANO
LICENSE # 59318	LICENSE # 59318
INDEX NUMBER:	D-0442-150

5F.

VARIANCE EASEMENTS							
PENDING APPLICATIONS							
Applicant		Property Address	Email	Scope of Work	Application Received by Inframark	Application sent to Albert	Pending Further Review
Surname	First Name						
	Quartz Cove at the Quarry Condominium Association, Inc	5435 Jaeger Road #4		Fountain installation request			
Haidet	Andrew & Whitney	9253 Quarry Drive	haidetmd@gmail.com	floating dock and lift	25-May-22	6-Jun-22	

APPROVED APPLICATIONS								
Applicant		Property Address	Email	Scope of Work	Application Received by Inframark	Application sent to Albert	Application Approved	Recorded
Surname	First Name							
Friday	Tamara & Charles	9337 Quarry Drive	charles.Friday@icloud.com	Install dock, firepit and walkway from the driveway to the dock	11-Mar-22	11-Mar-22	4/18/2022 & 4/17/2023	17-Jun-22
Stowell	Matt	9324 Granite Ct	mjstowell@gmail.com	dock lift	11-Mar-22	11-Mar-22	18-Apr-22	20-Jun-22
		9416 Copper Rock Court		encroachment into the 7.5' drainage easement			21-Mar-22	
Hofkes	John & Mary	9051 Breakwater Drive	lamal@charter.net	3' x 6 1/2 landing outside west lanai door at grade (2' x 6 1/2) in easement	16-Aug-21	16-Aug-21	23-Feb-22	17-Jun-22
Mulvey	Andy	9403 Copper Rock Court	awmndp@yahoo.com	installation of boat dock behind home	6-Oct-21	11-Oct-21	15-Nov-21	
Beatty	Dustin	9179 Flint Ct	dustinbeatty@icloud.com	floating dock and 4400# lift	22-Jul-21		15-Nov-21	
Hill	D. Kent	9407 Quarry Dr	hillkent@hotmail.com	H shaped dock with boat lift and canopy	11-Oct-21		15-Nov-21	withdrawn
Martins	Richard & Elaine	9075 Graphite Circle	REJMM5@aol.com	install J design dock	25-Aug-21	25-Aug-21	20-Sep-21	17-Nov-21
Turnman	Timothy & Linda	9237 Gypsum Way	lturnman@aol.com	moved dock from 9172 Flint Ct	6-Jan-21	11-Jan-21	4-Feb-21	15-Nov-21

Curry	Kevin	9176 Flint Ct	kevincurry.55@gmail.com	Boat lift and repair	15-Oct-20	12-Nov-20	Yes	
DaBaene	Kenneth	9043 Graphite Circle	kendabaene@yahoo.com	Repair walkway	15-Oct-20	12-Nov-20	Yes	
Forster	Barbara	9286 Marblestone Dr	m@forsterusa.com	Boat dock installation	Yes		13-Jul-20	
Gober	Douglas & Linda	9830 Slate Ct	dgobe1@comcast.net lindagobermk@comcast.net	Remove and replace installation	7-Aug-20	7-Aug-20	Yes	
Kramer	Adrian L	9396 Slate Ct	akramer@hollyconst.com	boat deck	11-Dec-19	11-Dec-19	Yes	
McFarlene	Tracy	9273 Quarry Drive	audiotracy@gmail.com	installing floating dock 15 x 20 w/6' walkway	22-Jan-21	26-Jan-21	25-Feb-21	
Moore	Geoffrey A. (Trust)	9719 Nickel Ridge Circle	deborahbmoore@yahoo.com	Brick paver, walkway	22-Jan-21	26-Jan-21	19-Apr-21	22-Jul-21
Omland	Stan & Nanci	9293 Quarry Dr	somland@omland.com	install paver walk through LME of existing elevations	22-Jun-20	22-Jun-20	Yes	Yes
Parker	Donald G.	8822 Spinner Cove Ln	dgparker1047@yahoo.com	Dock Repair	10-Sep-20	8-Oct-20	Yes	
Taylor	Scott J and Rhonda M.	9332 Granite Ct	sitoneup@gmail.com	paver walkway to dock with paver landing in front of deck and	6-Nov-19	11-Dec-19	Yes	20-Mar-23
Haidet	Andrew & Whitney	9253		floating dock & lift	25-May-22	6-Jun-22	Yes	13-Jul-22
Peterson	Mark & Jane - Trustees JMP Investment Holdings	9262 Marble Stone Drive	mpp@mrrhino.com jmp@mrrhino.com	Dock and boat lift	17-May-22	6-Jun-22	Yes	20-Mar-23

5Fvi.

QUARRY COMMUNITY DEVELOPMENT DISTRICT
APPLICATION FORM
FOR VARIANCE FROM EASEMENT

This form should be completed by homeowners who are applying to the Quarry Community Association ("HOA") to install improvements on a lot, where such installation may impact the easement rights of the Quarry Community Development District ("CDD"). Notably, the CDD is responsible for the stormwater system and conservation areas serving the community, and, accordingly, holds certain rights in, among other lands, all "Drainage Easements," "Lake Maintenance Easements," and "Conservation Easements." It is the homeowner's responsibility to carefully review all property records and ensure that the homeowner and his or her contractor do not construct improvements (e.g., fences, landscaping, sprinklers, patios, decks, air conditioners, pools, etc.) within any such easement areas. (Note that such easements are identified on the community plats, but the plats may or may not correctly identify the CDD as the responsible party. Please contact the CDD if you are in doubt about any such easements.)

While the CDD discourages such requests, the CDD may in its sole discretion elect to grant limited variances in order to allow improvements to be placed in an easement area where the improvements will not materially affect the CDD's stormwater system. To obtain such a variance, a homeowner must:

1. Complete this Application Form.
2. Provide a copy of any application materials submitted to the HOA, including but not limited to:
 - a. Site Plan,
 - b. Sketch of Work, and
 - c. Design Plans
3. Submit a check for \$500.00 to the CDD for the CDD's cost to review the application. Additional fees may be charged as well at cost, in the event that the CDD is required to spend additional monies on engineering and/or other consultants to review the application.
4. Complete and execute a Variance Agreement for Installation of Improvements within CDD Easement ("Variance Agreement").
5. Provide a Certificate of Insurance showing: 1) bodily injury and property damage liability insurance in the amount of \$1,000,000 per occurrence, 2) statutory worker's compensation insurance, 3) employer's liability insurance, and 4) automobile liability insurance in the amount of \$1,000,000 per occurrence, all of which shall be maintained in force for the duration of the work. The Certificate shall name the CDD as an additional insured.

Once the information is provided, it will be reviewed by the CDD Staff, and your property will be inspected to determine whether a variance is appropriate. Then, a final determination will be made by either CDD Staff and/or the CDD's Board of Supervisors, and a notice will be sent indicating whether your application was approved or denied.

If your application is approved, the Owner shall notify the CDD prior to commencing work and upon completing work, so that the CDD may inspect the applicable easement area. Any such inspection shall not be deemed an approval by the CDD of any work, and the CDD shall retain all rights to enforce the terms of the Variance Agreement.

Please provide the following information:

1. Property Owner Name(s): Craig & Debra Nikrant

2. Property Address: 9388 Slate Ct.
3. Cell Phone of Owner: 440-320-4270
4. Email Address of Owner: CNIKRANT@GMAIL.COM
5. Describe Scope of Work: Floating Boat Dock & Lift Installation
6. Estimated Start Date: As soon as approved
7. Estimated Completion Date: _____
8. Name and Contact Information for Contractor(s): J&M Boat Dock

Acknowledged and agreed to by:

OWNER		OWNER	
<u>CRAIG M. NIKRANT</u>		<u>Deborah K. NIKRANT</u>	
SIGNATURE	DATE	SIGNATURE	DATE
<u>Craig M. Nikrant</u>	<u>5/23/23</u>	<u>Deborah K. Nikrant</u>	<u>5/23/23</u>

PLEASE RETURN THIS COMPLETED FORM TO:

Quarry Community Development District
 c/o District Manager
Inframark Management Services
 210 N University Drive, Suite 702
 Coral Springs, FL 33071

PLEASE NOTE THAT ANY INSPECTION DONE BY THE CDD IS FOR CDD PURPOSES ONLY AND MAY NOT BE RELIED UPON BY THE HOMEOWNER FOR ANY PURPOSE.

NOTE TO STAFF: This form may contain confidential information. Please do not disclose its contents without first consulting the District Manager.

PRIVACY NOTICE: Under Florida's Public Records Law, Chapter 119, Florida Statutes, the information you submit on this form may become part of a public record. This means that, if a citizen makes a public records request, we may be required to disclose the information you submit to us. Under certain circumstances, we may only be required to disclose part of the information submitted to us. If you believe that your records may qualify for an exemption under Chapter 119, Florida Statutes, please notify the District Manager, Bob Koncar by e-mail at bkoncar@quarrycdd.com or by phone at 904-626-0593

After recording, please return to:

Quarry Community Development District
Inframark Management Services
 210 N University Drive, Suite 702
 Coral Springs, FL 33071

VARIANCE AGREEMENT FOR INSTALLATION OF IMPROVEMENTS WITHIN CDD EASEMENT

This *Variance Agreement* for Installation of Improvements within CDD Easement ("**Agreement**") is entered into as of this 22nd day of February, 2023, by and among Craig Nikrant and Debra Nikrant (together, "**Owner**") and the Quarry Community Development District ("**CDD**"), a local unit of special purpose government created pursuant to Chapter 190, Florida Statutes.

WITNESSETH:

WHEREAS, Owner is the owner of Lot 73, Block E, as per the plat ("**Plat**") of The Quarry Community Phase 2 recorded in Plat Book 50, Pages 50-53 et seq., of the Public Records of Collier County, Florida ("**Property**"); and

WHEREAS, Owner desires to erect certain improvements described as Floating Boat Dock & Lift Installation ("**Improvements**") within a CDD Lake Maintenance easement ("**Easement**") located 9388 Slate Ct. ("**License Area**"), as shown on the Plat; and

WHEREAS, due to the CDD's legal interests in the Easement, among other reasons, Owner requires the CDD's consent before constructing improvements within any portion of the Surface Water Management System, including the Easement; and

WHEREAS, the CDD has agreed to consent to the installation of the Improvements within the License Area, subject to the terms and conditions set forth in this Agreement.

NOW, THEREFORE, in consideration of Ten and No/100 Dollars (\$10.00) and other good and valuable consideration, the receipt and sufficiency of which are hereby acknowledged, it is understood and agreed as follows:

1. **Recitals.** The recitals set forth above are acknowledged as true and correct and are incorporated herein by reference.
2. **License for Improvements Installation & Maintenance; Limitation.** Subject to the terms of this Agreement, the CDD hereby grants Owner the right, privilege, and permission to install and maintain removable Improvements on the License Area.

3. **Owner Responsibilities.** The Owner has the following responsibilities:

- a. The Owner shall be fully responsible for the installation and maintenance of the Improvements.
- b. The Owner shall use only licensed and insured contractors to install the Improvements. Further, the Owner shall be responsible for ensuring that the installation and maintenance of the Improvements are conducted in compliance with all applicable laws (including but not limited to building codes, set back requirements, etc.).
- c. CDD, by entering into this Agreement, does not represent that CDD has authority to provide all necessary approvals for the installation of the Improvements. Instead, the Owner shall be responsible for obtaining any and all applicable permits and approvals relating to the work (including but not limited to any approvals of the Quarry Community Association, Inc. ("Association"), as well as any other necessary legal interests and approvals).
- d. The Owner shall ensure that the installation and maintenance of the Improvements does not damage any property of CDD or any third party's property, and, in the event of any such damage, the Owner shall immediately repair the damage or compensate the CDD for such repairs, at the CDD's option.
- e. Owner's exercise of rights hereunder shall not interfere with CDD's rights under the Easement. For example, if the Improvements include a fence, such fence shall be installed within the Easement a few inches higher than ground level, so as not to impede the flow of water, or shall otherwise be constructed so as not to impede the flow of water. Further, the Improvements shall be installed in such a manner as to not interfere with or damage any culvert pipe or utilities that may be located within the Easement. It shall be Owner's responsibility to locate and identify any such stormwater improvements and/or utilities. Further, the Owner shall pay a licensed and insured professional contractor to mark any existing improvements and/or utilities prior to installation of the Improvements.
- f. Upon completion of the installation, the Improvements will be owned by the Owner. Owner shall be responsible for the maintenance and repair of any such Improvements, and agrees to maintain the Improvements in good condition.
- g. Additionally, the Owner shall keep the License Area free from any materialmen's or mechanic's liens and claims or notices in respect to such liens and claims, which arise by reason of the Owner's exercise of rights under this Agreement, and the Owner shall immediately discharge any such claim or lien.
- h. The Owner shall notify the CDD prior to commencing work and upon completing work, so that the CDD may inspect the License Area. Any such inspection shall not be deemed an approval by the CDD of any work, and the CDD shall retain all rights to enforce the terms of this Agreement.

4. **Removal and/or Replacement of Improvements.** The permission granted herein is given to Owner as an accommodation and is revocable at any time. Owner acknowledges the legal interest of the CDD in the Easement described above and agrees never to deny such interest or to interfere in any way with CDD's use. Owner will exercise the privilege granted herein at Owner's own risk, and agrees that Owner will never claim any damages against CDD for any injuries or damages suffered on account of the exercise of such privilege, regardless of the fault or negligence of the CDD. Owner further acknowledges that, without notice, the CDD may remove all, or any portion or portions, of the Improvements installed upon the License Area at Owner's

expense, and that the CDD is not obligated to return or re-install the Improvements to their original location and is not responsible for any damage to the Improvements, or their supporting structure as a result of the removal.

5. **Indemnification.** Owner agrees to indemnify, defend and hold harmless Collier County, the South Florida Water Management District, and the CDD as well as any officers, supervisors, staff, agents and representatives, and successors and assigns, of the foregoing, against all liability for damages and expenses resulting from, arising out of, or in any way connected with, this Agreement or the exercise of the privileges granted hereunder.

6. **Covenants Run with the Land.** This Agreement, and all rights and obligations contained herein, shall run with the land and shall be binding upon and inure to the benefit of the parties hereto and their respective heirs, successors and assigns, including, but without limitation, all subsequent owners of any portions of the property described herein and all persons claiming under them. Whenever the word "Owner" is used herein, it shall be deemed to mean the current owner of the Property and its successors and assigns.

7. **Sovereign Immunity.** Nothing in this Agreement shall be deemed as a waiver of immunity or limits of liability of the CDD beyond any statutory limited waiver of immunity or limits of liability which may have been adopted by the Florida Legislature in Section 768.28, Florida Statutes, or other statute, and nothing in this Agreement shall inure to the benefit of any third party for the purpose of allowing any claim which would otherwise be barred under the doctrine of sovereign immunity or by operation of law.


8. **Default.** A default by either party under this Agreement – including but not limited to Owner's failure to meet its obligations under Section 3 above – shall entitle the other to all remedies available at law or in equity, which may include, but not be limited to, the right of damages and/or specific performance.


9. **Attorney's Fees & Costs.** The prevailing party in any litigation to enforce the terms of this Agreement shall be entitled to reasonable attorney's fees and costs.

10. **Counterparts.** This Agreement may be executed in counterparts. Any party hereto may join into this Agreement by executing any one counterpart. All counterparts when taken together shall constitute one agreement.


[THIS SPACE INTENTIONALLY LEFT BLANK]

WITNESSES:


MIKE HOWLER


Austin Swanson

OWNER



Craig M. Nikrant

Collier

Craig M Nikrant

20

March 2023

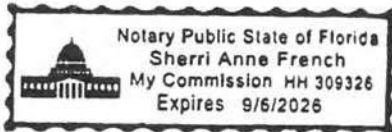



Sherri Anne French

[SIGNATURE PAGE TO LICENSE AGREEMENT FOR INSTALLATION OF IMPROVEMENTS]

WITNESSES:

By: [Signature]
MIKE HOLTER
 Print Name

By: [Signature]
Austin Swanson
 Print Name


OWNER

By: [Signature]
CRIG M. NIKRANT
 Print Name

STATE OF FLORIDA
 COUNTY OF Collier)

The foregoing instrument was acknowledged before me this 20 day of March, 2008 by Craig M. Nikrant. She He (X) is personally known to me or (X) produced as identification.

[Signature]
 NOTARY PUBLIC

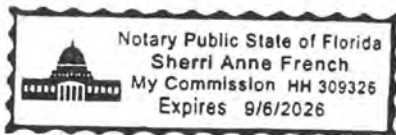

Sherri Anne French
 (Print, Type or Stamp Commissioned Name of Notary Public)

[signatures continue on following page]

[SIGNATURE PAGE TO LICENSE AGREEMENT FOR INSTALLATION OF IMPROVEMENTS]

WITNESSES:

**QUARRY
COMMUNITY DEVELOPMENT DISTRICT**

By: _____

Print Name _____

By: _____
Chairman, Board of Supervisors

By: _____

Print Name _____

STATE OF FLORIDA)
COUNTY OF _____)

The foregoing instrument was acknowledged before me this ____ day of _____, 2021, by _____, as _____ of the Board of Supervisors of the Quarry Community Development District, on behalf of said district. She/He [] is personally known to me or [] produced as identification.

NOTARY PUBLIC

Justin Faircloth
(Print, Type or Stamp Commissioned Name of Notary Public)

[End of signature pages]



CERTIFICATE OF LIABILITY INSURANCE

DATE (MM/DD/YYYY)

3/20/2023

THIS CERTIFICATE IS ISSUED AS A MATTER OF INFORMATION ONLY AND CONFERS NO RIGHTS UPON THE CERTIFICATE HOLDER. THIS CERTIFICATE DOES NOT AFFIRMATIVELY OR NEGATIVELY AMEND, EXTEND OR ALTER THE COVERAGE AFFORDED BY THE POLICIES BELOW. THIS CERTIFICATE OF INSURANCE DOES NOT CONSTITUTE A CONTRACT BETWEEN THE ISSUING INSURER(S), AUTHORIZED REPRESENTATIVE OR PRODUCER, AND THE CERTIFICATE HOLDER.

IMPORTANT: If the certificate holder is an ADDITIONAL INSURED, the policy(ies) must have ADDITIONAL INSURED provisions or be endorsed. If SUBROGATION IS WAIVED, subject to the terms and conditions of the policy, certain policies may require an endorsement. A statement on this certificate does not confer rights to the certificate holder in lieu of such endorsement(s).

PRODUCER Arthur J. Gallagher Risk Management Services, LLC 1395 Panther Lane Suite 100 Naples FL 34109		CONTACT NAME: Kaely Maldonado PHONE (A/C, No, Ext): 12392627171 E-MAIL ADDRESS: Kaely_Maldonado@ajg.com FAX (A/C, No): 239-262-5360	
INSURED J & M Boatlift & Repair Inc. Jeff Maroon 2496 Kirkwood Ave. Naples FL 34112		INSURER(S) AFFORDING COVERAGE INSURER A: Navigators Insurance Company INSURER B: Benchmark Insurance Company INSURER C: INSURER D: INSURER E: INSURER F:	
		NAIC # 42307	

COVERAGES

CERTIFICATE NUMBER: 1310426951

REVISION NUMBER:

THIS IS TO CERTIFY THAT THE POLICIES OF INSURANCE LISTED BELOW HAVE BEEN ISSUED TO THE INSURED NAMED ABOVE FOR THE POLICY PERIOD INDICATED. NOTWITHSTANDING ANY REQUIREMENT, TERM OR CONDITION OF ANY CONTRACT OR OTHER DOCUMENT WITH RESPECT TO WHICH THIS CERTIFICATE MAY BE ISSUED OR MAY PERTAIN, THE INSURANCE AFFORDED BY THE POLICIES DESCRIBED HEREIN IS SUBJECT TO ALL THE TERMS, EXCLUSIONS AND CONDITIONS OF SUCH POLICIES. LIMITS SHOWN MAY HAVE BEEN REDUCED BY PAID CLAIMS.

INSR LTR	TYPE OF INSURANCE	ADDL INSD	SUBR WVD	POLICY NUMBER	POLICY EFF (MM/DD/YYYY)	POLICY EXP (MM/DD/YYYY)	LIMITS
A	<input checked="" type="checkbox"/> COMMERCIAL GENERAL LIABILITY <input type="checkbox"/> CLAIMS-MADE <input checked="" type="checkbox"/> OCCUR GEN'L AGGREGATE LIMIT APPLIES PER: <input checked="" type="checkbox"/> POLICY <input type="checkbox"/> PRO-JECT <input type="checkbox"/> LOC <input type="checkbox"/> OTHER:	Y	Y	NY23MPKZ0DNCV01	3/5/2023	3/5/2024	EACH OCCURRENCE \$ 1,000,000 DAMAGE TO RENTED PREMISES (Ea occurrence) \$ 50,000 MED EXP (Any one person) \$ 5,000 PERSONAL & ADV INJURY \$ 1,000,000 GENERAL AGGREGATE \$ 2,000,000 PRODUCTS - COMP/OP AGG \$ 1,000,000 \$
	AUTOMOBILE LIABILITY <input type="checkbox"/> ANY AUTO <input type="checkbox"/> OWNED AUTOS ONLY <input type="checkbox"/> SCHEDULED AUTOS <input type="checkbox"/> HIRED AUTOS ONLY <input type="checkbox"/> NON-OWNED AUTOS ONLY <input type="checkbox"/> AUTOS ONLY						COMBINED SINGLE LIMIT (Ea accident) \$ BODILY INJURY (Per person) \$ BODILY INJURY (Per accident) \$ PROPERTY DAMAGE (Per accident) \$ \$
	UMBRELLA LIAB <input type="checkbox"/> OCCUR EXCESS LIAB <input type="checkbox"/> CLAIMS-MADE <input type="checkbox"/> DED <input type="checkbox"/> RETENTION \$						EACH OCCURRENCE \$ AGGREGATE \$ \$
B	WORKERS COMPENSATION AND EMPLOYERS' LIABILITY ANY PROPRIETOR/PARTNER/EXECUTIVE OFFICER/MEMBER EXCLUDED? (Mandatory in NH) If yes, describe under DESCRIPTION OF OPERATIONS below	Y/N	N/A	MWC230011101	3/5/2023	3/5/2024	<input type="checkbox"/> PER STATUTE <input checked="" type="checkbox"/> OTH-ER Includes USL&H E.L. EACH ACCIDENT \$ 1,000,000 E.L. DISEASE - EA EMPLOYEE \$ 1,000,000 E.L. DISEASE - POLICY LIMIT \$ 1,000,000
A	Equipment Floater - Inland Marine			NY23MPKZ0DNCV01	3/5/2023	3/5/2024	Limit \$ 175,000

DESCRIPTION OF OPERATIONS / LOCATIONS / VEHICLES (ACORD 101, Additional Remarks Schedule, may be attached if more space is required)
 Installs and repairs docks and boatlifts. Blanket Additional insured and Waiver of Subrogation when agreed by written contract including primary and non-contributory in regards to General Liability. Workers Compensation - Blanket Waiver of Subrogation Applies when required by written contract per form WC000313. Quarry Community Development District are noted as additional insured when agreed in written contract.

CERTIFICATE HOLDER

CANCELLATION

Quarry Community Development District
 2501-A Burns Road
 Palm Beach Gardens FL 33410

SHOULD ANY OF THE ABOVE DESCRIBED POLICIES BE CANCELLED BEFORE THE EXPIRATION DATE THEREOF, NOTICE WILL BE DELIVERED IN ACCORDANCE WITH THE POLICY PROVISIONS.

AUTHORIZED REPRESENTATIVE

[Signature]

THIS ENDORSEMENT CHANGES THE POLICY. PLEASE READ IT CAREFULLY
BLANKET ADDITIONAL ASSURED / BLANKET WAIVER OF SUBROGATION

This endorsement modifies coverage provided under the following:

MARINE GENERAL LIABILITY COVERAGE POLICY - NAVG-MGL01 (Ed. 08/13)

Premium: **Included**

I. Section II - Who Is An Assured is amended to include as an additional assured any person or organization to whom the Named Assured is obligated by virtue of a written contract or agreement to provide insurance such as is afforded by this policy or who is added by endorsement, but only with respect to liability for "bodily injury", "property damage" or "personal and advertising injury" caused, in whole or in part, by your acts or omissions or the acts or omissions of those acting on your behalf:

A. In the performance of your ongoing operations; or

B. In connection with your premises owned by or rented to you.

II. The following is added to Paragraph 9. Transfer Of Rights Of Recovery Against Others To Us of Section IV - Conditions:

We waive any right of recovery we may have against the person or organization because of payments we make for injury or damage arising out of your ongoing operations or "your work" done under a contract with that person or organization and included in the "products-completed operations hazard". This waiver applies only to the person or organization for whom the Named Assured is required to waive subrogation.

This waiver of subrogation will apply only when the waiver is issued prior to an "Occurrence".

III. Coverage under this endorsement only applies if:

A. An "occurrence" and the "bodily injury" or "property damage" it causes occur; or

B. An "offense" occurs, on or after the effective date of the endorsement, but before the end of the policy period,

ALL OTHER TERMS AND CONDITIONS OF THIS POLICY REMAIN UNCHANGED.

NAVG-MGL26 (Ed. 08/13)

Collier County * City of Marco * City of Naples *
City of Everglades * Contractor Licensing

MARINE SEAWALL & DOCK CONSTRUCTION

Cert Nbr:	Exp:	Issuance Nbr:
C20179	09/30/2023	20179
State Nbr:	State Exp:	


J & M BOAT LIFT & REPAIR, INC.
JEFFREY E. MAROON
259 BURNT PINE DR.
NAPLES, FL 34119

This Collier County Certificate of Competency's status and expiration date
may change on July 1, 2023 due to the State of Florida House Bill
No.735. Please visit our website at
www.colliercountyfl.gov for more information as it becomes available.

Signed: _____

J & M Boatlift & Repair


(239) 353-7326

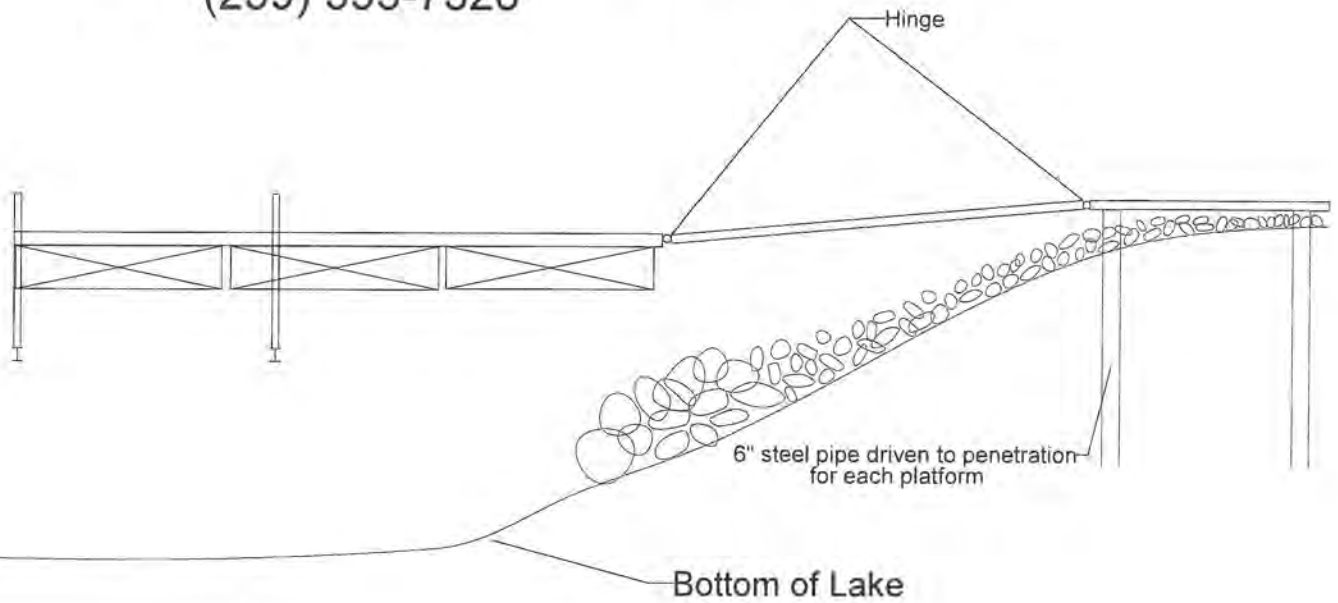

Typical side view of Floating Dock

J & M Boatlift & Repair


(239) 353-7326

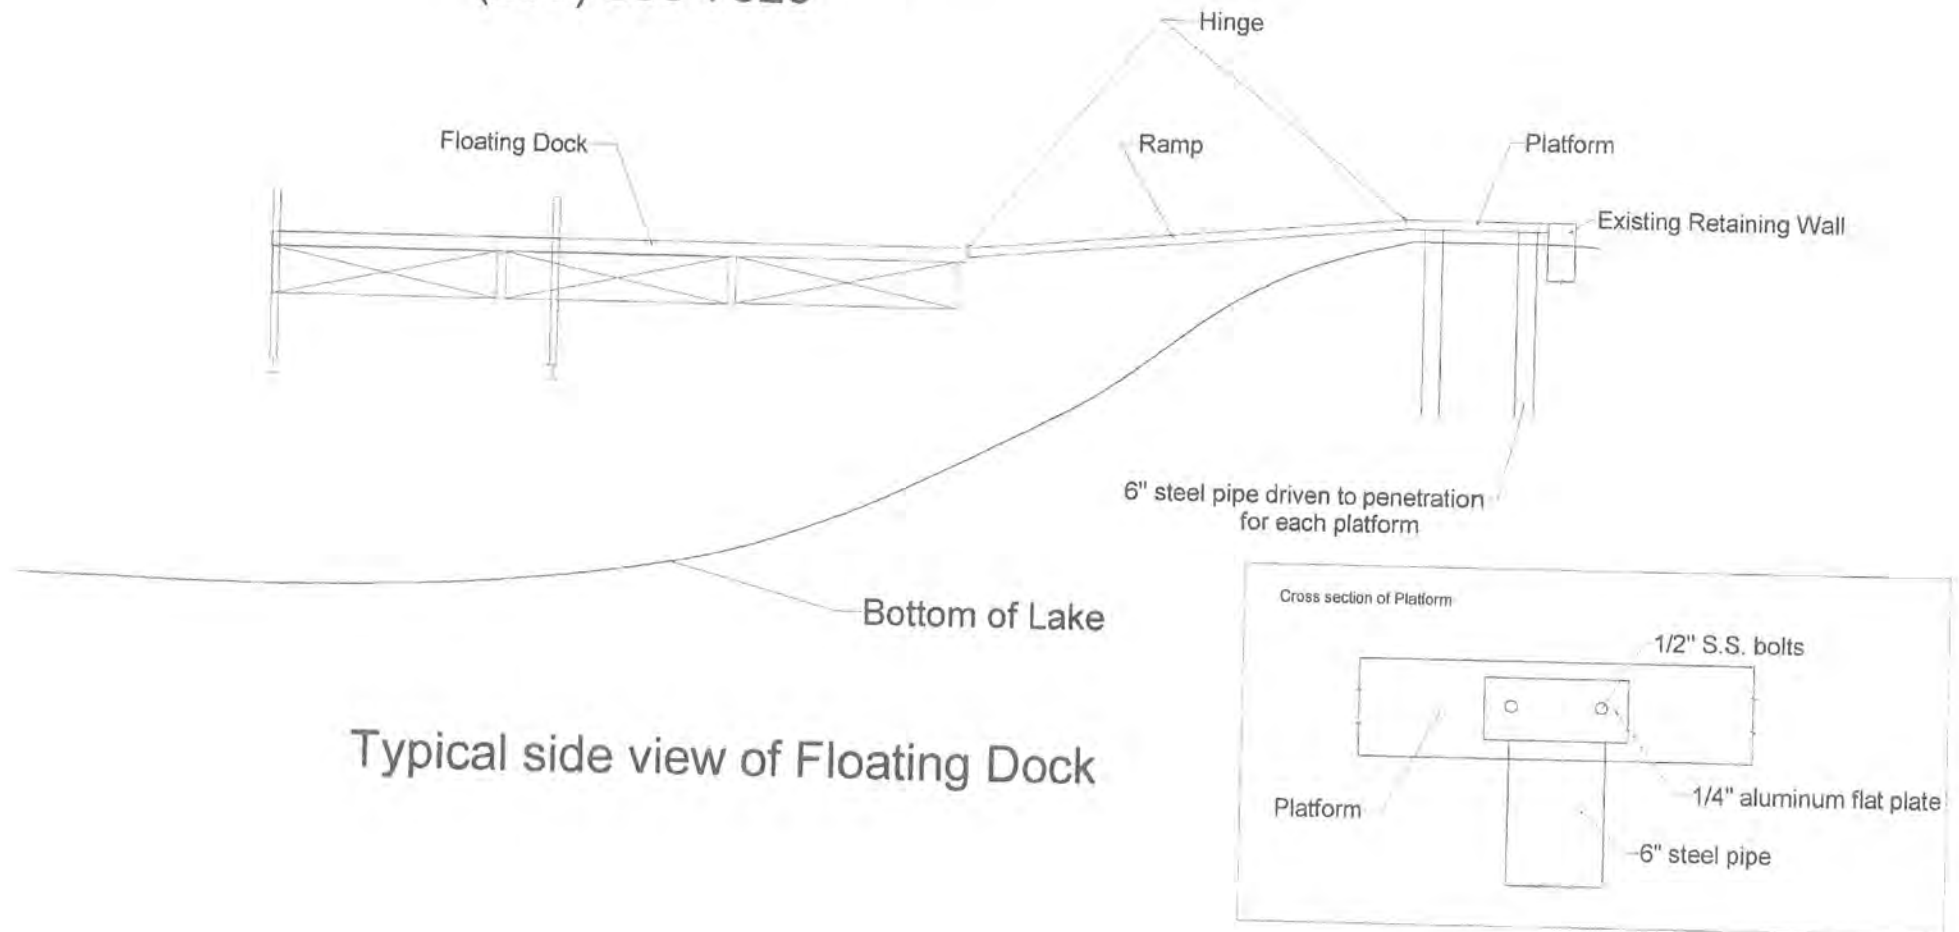

Aluminum Docks & Lifts

Typical Dock Section


Typical Dock Section

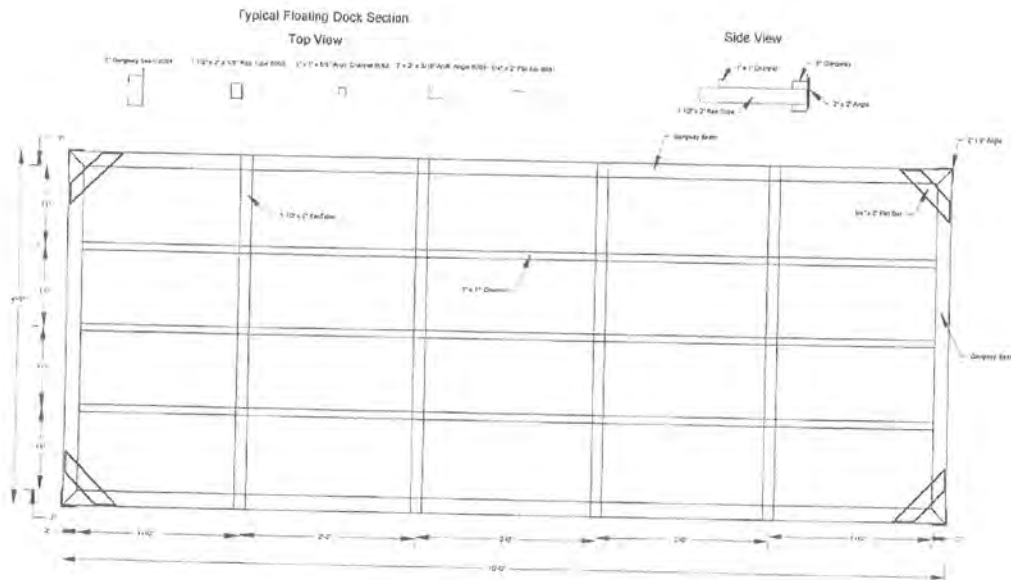


Floating dock Hardware-1/2" S.S. bolts, washers, lock washers, and nylock nuts

Decking Screws-1 1/4" S.S. phillips head screw

Floating Dock Decking- TREX/AZEK

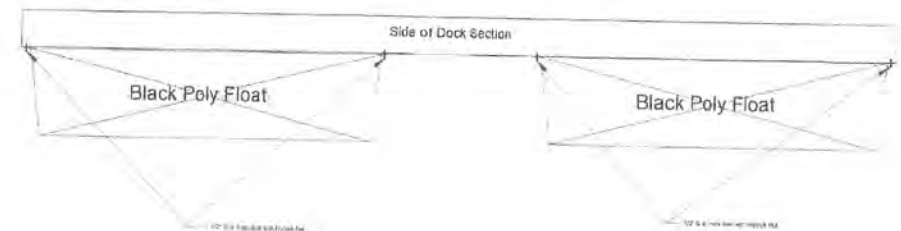

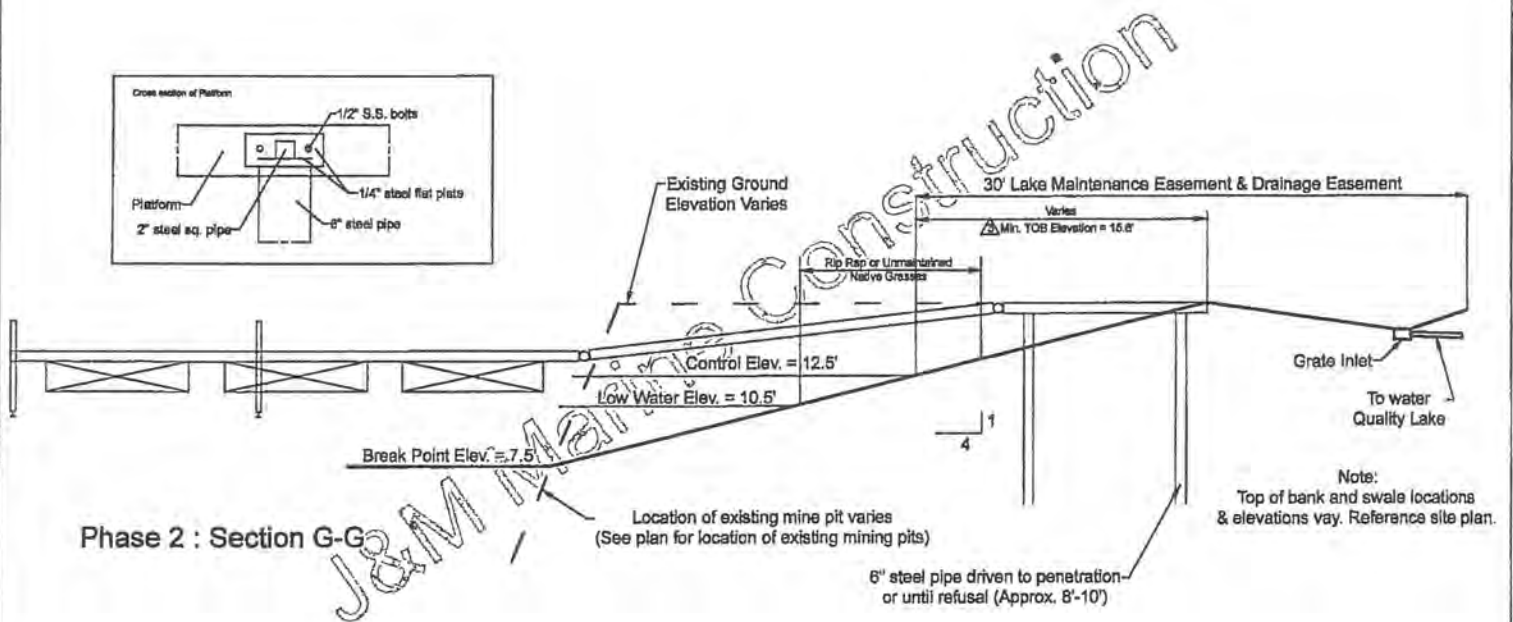

Drawing:

Cross

Craig Nikrant

5/3/23


9386 Slate Ct.

Project #642

A P P R O V A L

Signature

Date

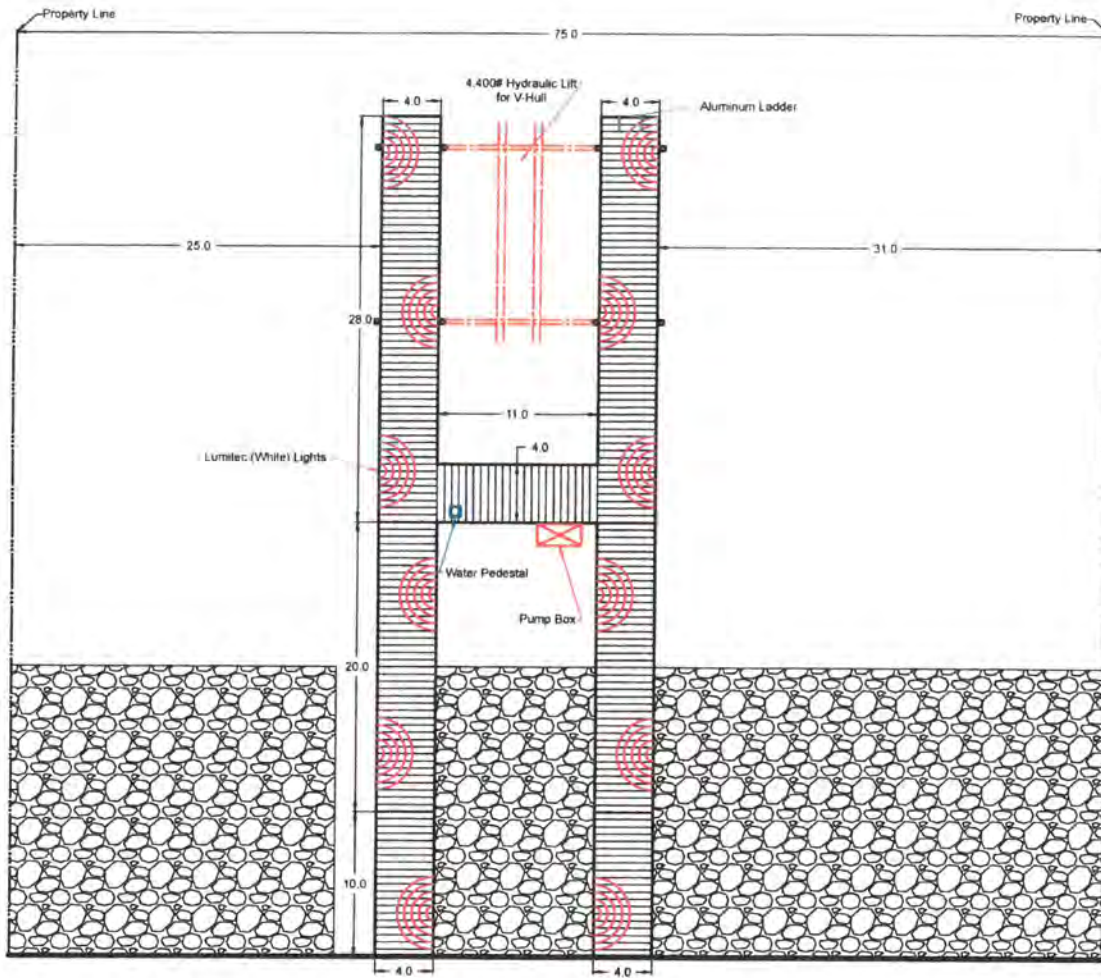

J&M





MARINE CONSTRUCTION
239-353-7326


Drawing:

2

Craig Nikrant	2/16/23	A P P R O V A L	
9388 Slate Ct.	Project #642	Signature	Date

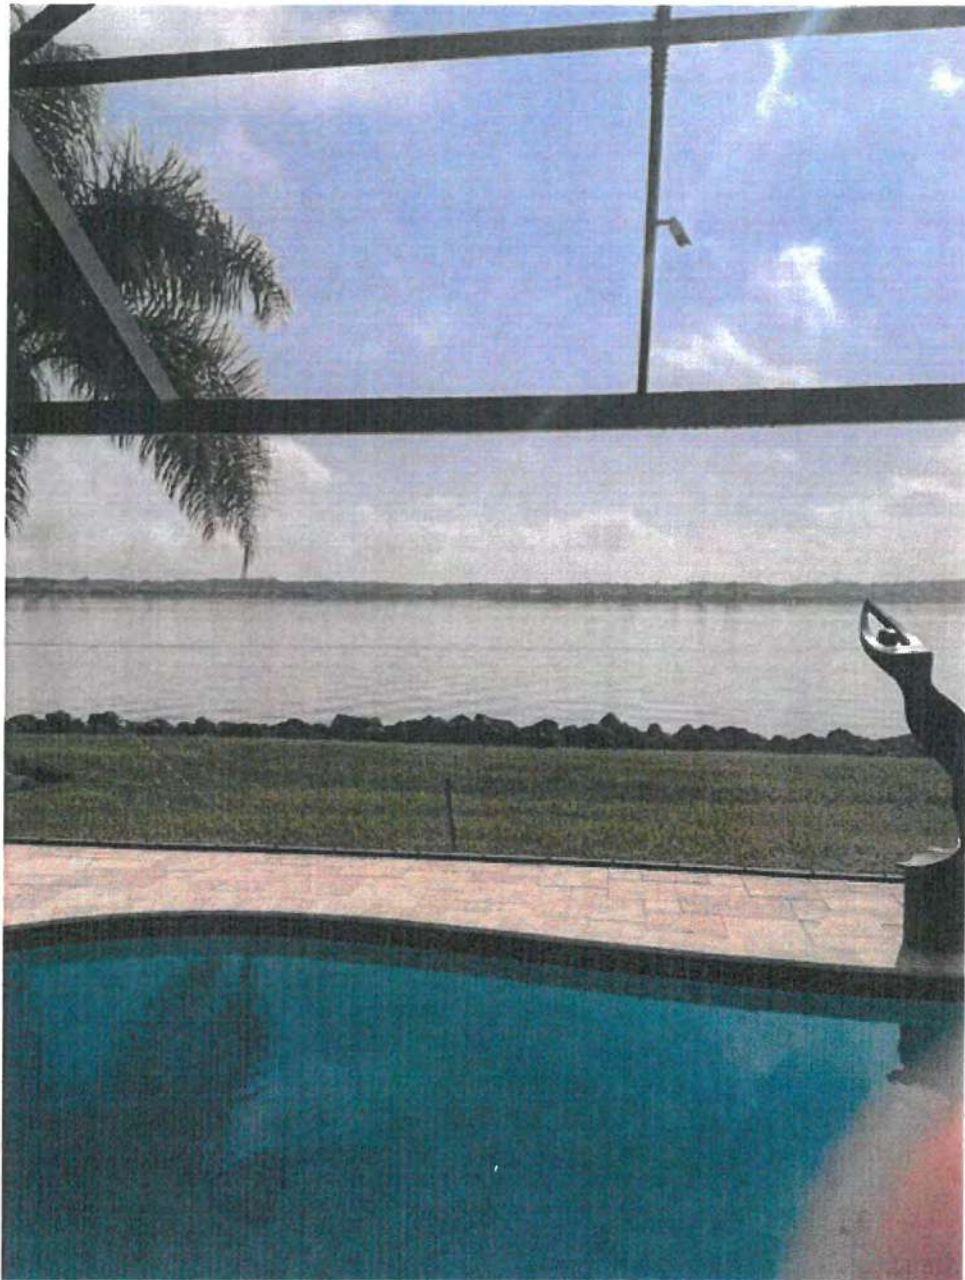

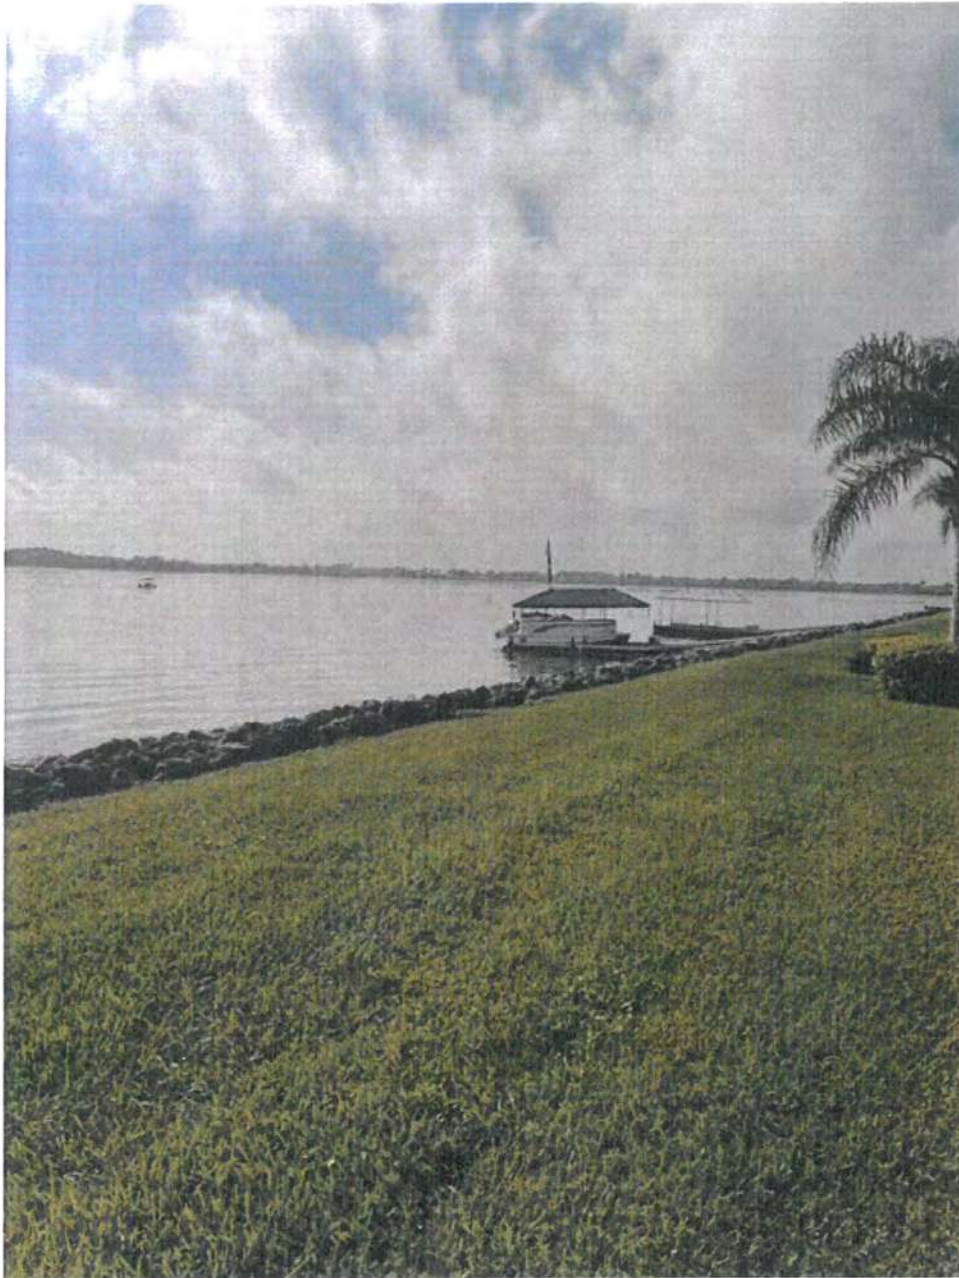

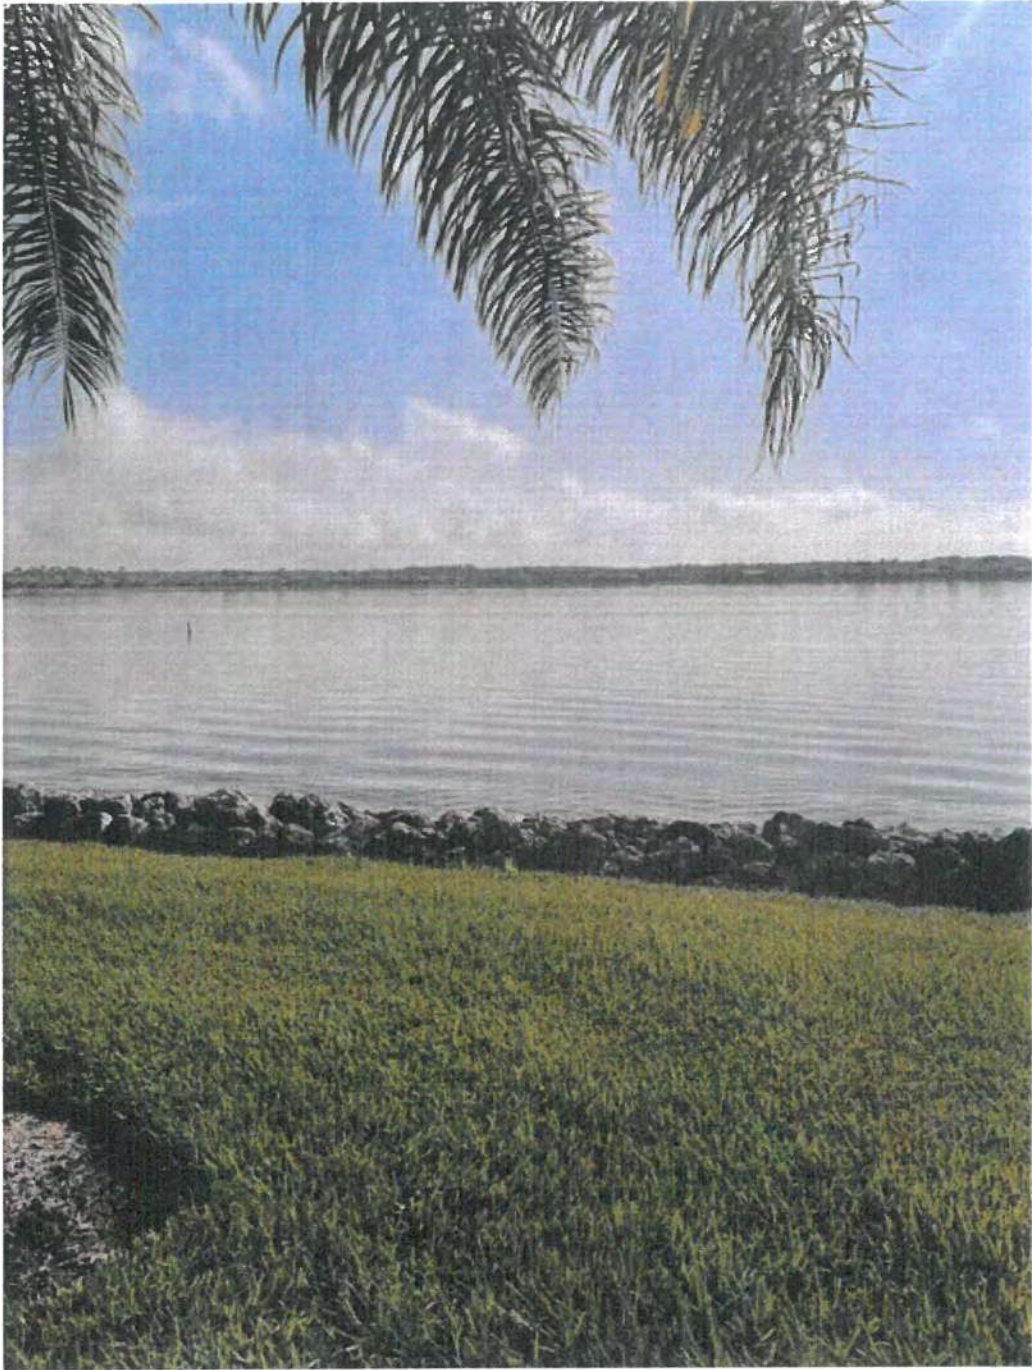



2216 Altamont Avenue
Fort Myers, Florida 33901
Phone: 239.332.5499
Fax: 239.332.2955

www.cphcorp.com

June 12, 2023


Justin Faircloth
The Quarry CDD
c/o Inframark
201 N University Dr,
Coral Springs, FL 33071.

RE: 9388 Slate Ct – Floating Dock Installation

Dear Mr. Faircloth:

CPH has reviewed the request for installation of a new floating dock improvement proposed at the above referenced address. This limited review was based on hand sketches and photos provided with the application, received on May 25, 2023, to identify any potential conflicts that may be caused by locating said improvements within the existing Quarry CDD Drainage Maintenance Easement. Based on the documentation submitted by Mr. and Mrs. Nikrant, CPH provides the following observations / recommendations:

- No work that will impede the stormwater run-off flow or alter the current drainage swale conditions will be allowed without a written authorization from the Quarry CDD Engineer of Record.
- The contractor shall use the existing drainage easements located at 9880 & 9384 Slate Court to access the property.

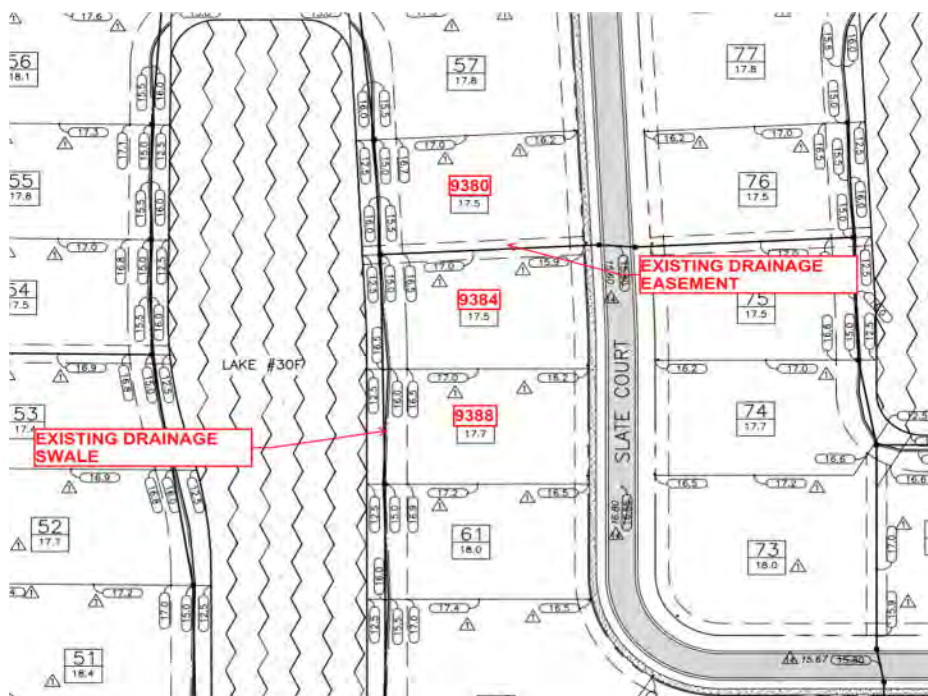

- It is the contractor's responsibility to get authorization from residents to cross any lot without a CDD drainage easement in place.

Please note that this review did not include an evaluation of the proposed design for the intended improvements, a check for compliance with Local, State, or Federal codes and/or an evaluation of the structural elements associated with the pathway / patio deck.

Please do not hesitate to contact us if there are any questions or if additional information is needed.

Sincerely,

A handwritten signature in blue ink, appearing to read 'Albert Lopez', with a stylized flourish at the end.

Albert Lopez
Office Manager

Eighth Order of Business

8A

MINUTES OF MEETING QUARRY COMMUNITY DEVELOPMENT DISTRICT

The regular meeting of the Board of Supervisors of Quarry Community Development District was held Monday May 15, 2023 at 1:00 p.m. at the Quarry Golf Club, 8950 Weathered Stone Drive, Naples, FL 34120.

Present and constituting a quorum were:

Timothy Cantwell	Chairman
Dean Britt	Vice Chairman
Mel Stuckey	Assistant Secretary
Rick Fingeret	Assistant Secretary

Also present were:

Justin Faircloth	District Manager <i>(via phone)</i>
Jacob Whitlock	Assistant District Manager
Wes Haber	District Counsel <i>(via phone)</i>
Scott Garvin	QCA
Will Elliot	CES
Residents	

The following is a summary of the discussions and actions taken.

FIRST ORDER OF BUSINESS

Call to Order

- Mr. Whitlock called the roll, and a quorum was established.

SECOND ORDER OF BUSINESS

Pledge of Allegiance

- The Pledge of Allegiance was recited.

THIRD ORDER OF BUSINESS

Approval of Agenda

- The Board added items 5C.iii Glase Golf Rip Rap 5/12/23 Email and 5.C.iv Erosion Discussion on New Construction.

On MOTION by Mr. Britt seconded by Mr. Fingeret with all in favor, the agenda was approved as amended. 4-0

FOURTH ORDER OF BUSINESS

Public Comments on Agenda Items

- None.

FIFTH ORDER OF BUSINESS**Engineer's Report****A. Fieldstone Lane Drainage Improvement Update**

On MOTION by Mr. Stuckey seconded by Mr. Britt with all in favor, the Board authorized CPH to approve rock excavation on the Fieldstone Lane Drainage Improvement Project. (4-0)

- The District will proceed with Glase Golf as approved by Mr. Britt.
- The project is tentatively set to begin in late June.

B. Seaweed Collection Discussion

- The Board tabled this discussion due to the absence of the engineer.

C. Phase I & II Shoreline Restoration Update**i. Glase Golf Lake 47/Hole 14 Repair Proposal**

On MOTION by Mr. Fingeret seconded by Mr. Cantwell with all in favor, the Board approved the Change Order for Phase I Lake 47/Hole 14 as presented by Glase Golf in the amount of \$19,325 to complete Hurricane Ian repairs. 4-0

ii. Littoral Planting Warranty Update

- The Board discussed the littoral planting warranty and Estimate 10123 from Crosscreek Environmental.
- The Board requested Mr. Faircloth notify Glase Golf that they should be responsible for the lost littorals and the expense for replanting as outlined in the contract.
- The Board requested Mr. Faircloth to have a new PO executed with Crosscreek Environmental for Phase IIB work in the amount of \$15,626.44 per Estimate 10124.

iii. Glase Golf Rip Rap 5/12/23 Email

- The Board discussed the email from Glase Golf regarding the availability of rip rap and recommendation to obtain additional material from Youngquist at an increased cost.
- No decision was made on the recommendation from Glase Golf to seek rip rap material from Youngquist. This issue will be reassessed during an on-site meeting later in the week.

iv. Erosion Discussion on New construction

- The Board discussed erosion concerns regarding the Phase II project and requested a meeting be set up between Mr. Britt or Mr. Cantwell, CPH, and Glase Golf either Thursday or Friday.

D. Variance Easement Report Update**i. 9389 Copper Canyon Court Update**

- ii. 9337 Quarry Drive Update
- iii. 9792 Nickel Ridge Update
- iv. 9332 Granite Court Update
- v. 9262 Marble Stone Drive Update
- vi. 9179 Flint Court Update
- vii. 9388 Slate Court Update

- The Board discussed the outstanding Variance Easement Application items.
- Mr. Faircloth provided an update on 9337 Quarry Drive noting approval for a walkway had been communicated to the QCA.
- Mr. Faircloth inquired if a separate variance easement should be recorded for new items if previous variance easements had been recorded. Mr. Haber agreed that new easements should be recorded if the Board wanted the variances to be read with a narrow interpretation. The Board agreed and Mr. Haber will develop revisions as necessary to the application.

On MOTION by Mr. Stuckey seconded by Mr. Fingeret with all in favor, to the extent the District's engineer approves of a variance easement application the Board authorized the Chair, and Vice Chair, in the absence of the Chair, to approve of such applications. 4-0

- The Board requested Mr. Faircloth to inquire with CPH about who may serve as the backup to Mr. Lopez when needed to ensure the business of the District continues seamlessly.
- The Board agreed that future variance easement approvals be sent to the County to be recorded only after the as built of the structure is confirmed to have been constructed as approved.

SIXTH ORDER OF BUSINESS

New Business

A. Pesticide/Herbicide Use by the CDD

- Mr. Elliott commented on spraying in the community, and informed the Board the preserve no trespassing signs should be delivered soon, and commented that the latest Illinois Pondweed cutting was late getting started.
- Mr. Elliot noted that the second quarter preserve treatment had been completed.
- Mr. Britt commented on preserve issues.

- Mr. Cantwell commented on the District's use of herbicides and noted he responded to Ms. Kathleen Anthony regarding the District's management of the lakes and preserves as well as oversight by professional staff.

SEVENTH ORDER OF BUSINESS**Old Business****A. QCA/QCDD Stormwater Rules & Guidelines Update****i. 4/26/23 Letter from Laura Severance**

On MOTION by Mr. Britt seconded by Mr. Stuckey with all in favor, changes concerning drainage application requirements and boat dock installation requirements from the May 2, 2023 email communication from Ms. Laura Severance were approved in substantial form. (4-0)

- ii. **QCDD and QCA Discussion Regarding Future Plans for Auditing, Cataloging, and Assessing Past Modifications Made and Potential Impact on QCDD Surface and Stormwater Management System**
- iii. **Update and Report Regarding Dock Installation Requirements Discussed During Team Meeting with J&M Dock Builders**
- iv. **Discuss Creation of List of Potential vendors for QCA to Provide Homeowners Requesting Voluntary Downspout Drainage Connections.**
 - Mr. Britt provided an update on efforts with J&M Dock Builders.
 - Mr. Faircloth inquired about the status of approval of the stormwater guidelines by the QCA. Ms. Severance noted the QCA should be considering the stormwater guidelines at their June meeting.
 - The Board agreed not to develop a list of vendors to provide to homeowners for drainage work.

EIGHTH ORDER OF BUSINESS**District Manager's Report****A. Approval of the April 17, 2023 Minutes**

On MOTION by Mr. Britt seconded by Mr. Cantwell with all in favor, the April 17, 2023 Minutes were approved. (4-0)

B. Acceptance of the Financial Report, and Approval of the Check Register and Invoices as of April 2023

On MOTION by Mr. Britt seconded by Mr. Fingeret with all in favor, the Financial Report was accepted, and the Check Register and Invoices as of April 2023 were approved. (4-0)

C. Consideration of Resolution 2023-03, Approving the Fiscal Year 2024 Budget and Setting a Public Hearing

On MOTION by Mr. Cantwell seconded by Mr. Britt with all in favor, Resolution 2023-03, Approving Proposed Budgets for Fiscal Year 2023/2024 and Setting a Public Hearing Thereon Pursuant to Florida Law, to be held Monday, August 14, 2023 at 1:00 p.m. at Quarry Golf Club, located at 8950 Weathered Stone Drive, Naples, Florida 34120, Addressing Transmittal, Posting and Publication Requirements; Addressing Severability; and Providing an Effective Date, was adopted. (4-0)

- Mr. Cantwell requested Board members be prepared at the June meeting to discuss the Budget so Inframark can make the necessary changes prior to the public hearing.

D. Report on Number of Registered Voters (1,143)

- Mr. Faircloth provided the information on the number of registered voters for the Board's information.

E. Follow-up Items

- Items previously covered in the meeting.

NINTH ORDER OF BUSINESS**Attorney's Report****A. HB199 – Ethics Requirement for Officers and Employees of Special Tax Districts**

- Mr. Haber covered HB199 and the impact on Supervisors regarding the upcoming need for ethics training to begin next year. Clarification should be forthcoming as the date for implementation approaches.

TENTH ORDER OF BUSINESS**Supervisor Requests**

- None.

ELEVENTH ORDER OF BUSINESS**Audience Comments**

- A resident commented on the Phase II project.
- Mr. Faircloth discussed the response received from Glase Golf regarding 9131 Crystal Court. The Board requested Mr. Faircloth to inform the homeowner of the investigation completed by the District's vendors and determine whether the homeowner had any further evidence to consider.

TWELFTH ORDER OF BUSINESS

Adjournment

On MOTION by Mr. Britt seconded by Mr. Stuckey with all in favor the meeting was adjourned at 4:17 p.m. (4-0)
--

Chairperson/Vice-Chairperson

8B

Quarry
Community Development District

Financial Report

October 1, 2022 - May 31, 2023



Table of Contents

FINANCIAL STATEMENTS

Balance Sheet - All Funds	Page 1
Statement of Revenues, Expenditures and Changes in Fund Balance	
General Fund	Pages 2 - 3
204-Series 2020 Debt Service Fund	Page 4
304-Series 2020 Capital Projects Fund	Page 5
Trend Report - General Fund	Pages 6 - 7
Notes to the Financial Statements	Page 8

SUPPORTING SCHEDULES

Special Assessments - Collection Schedule(s)	Page 9
Cash and Investment Report	Page 10
Bank Reconciliation	Page 11
Series 2020 (FEMA Project)	Pages 12 - 13
Payment Register by Bank Account	Page 14

Quarry
Community Development District

Financial Statements

(Unaudited)

October 1, 2022 - May 31, 2023

Balance Sheet
October 1, 2022 - May 31, 2023

ACCOUNT DESCRIPTION	GENERAL FUND	204 - SERIES 2020 DEBT SERVICE FUND	304 - SERIES 2020 CAPITAL PROJECTS FUND	TOTAL
<u>ASSETS</u>				
Cash - Checking Account	\$ 815,613	\$ -	\$ -	\$ 815,613
Allow -Doubtful Accounts	(8)	(27)	-	(35)
Assessments Receivable	8	27	-	35
Due From Other Gov'tl Units	250	-	-	250
Due From Other Funds	-	2,975	-	2,975
Investments:				
Money Market Account	415,473	-	-	415,473
Construction Fund	-	-	2,421,711	2,421,711
Revenue Fund	-	541,909	-	541,909
TOTAL ASSETS	\$ 1,231,336	\$ 544,884	\$ 2,421,711	\$ 4,197,931
<u>LIABILITIES</u>				
Accounts Payable	\$ 9,298	\$ -	\$ -	\$ 9,298
Accrued Expenses	17,662	-	-	17,662
Due To Other Funds	2,975	-	-	2,975
TOTAL LIABILITIES	29,935	-	-	29,935
<u>FUND BALANCES</u>				
Restricted for:				
Debt Service	-	544,884	-	544,884
Capital Projects	-	-	2,421,711	2,421,711
Assigned to:				
Operating Reserves	180,108	-	-	180,108
Reserves - Other	100,000	-	-	100,000
Unassigned:	921,293	-	-	921,293
TOTAL FUND BALANCES	\$ 1,201,401	\$ 544,884	\$ 2,421,711	\$ 4,167,996
TOTAL LIABILITIES & FUND BALANCES	\$ 1,231,336	\$ 544,884	\$ 2,421,711	\$ 4,197,931

General Fund - Operating & Maintenance Expenditures
Debt Service Fund - Series 2020 Bond
Capital Projects Fund - Construction Expenditures

Statement of Revenues, Expenditures and Changes in Fund Balances

For the Period Ending May 31, 2023

ACCOUNT DESCRIPTION	ANNUAL ADOPTED BUDGET	YEAR TO DATE ACTUAL	YTD ACTUAL AS A % OF ANNUAL ADOPTED BUD	MAY-2023 ACTUAL
<u>REVENUES</u>				
Interest - Investments	\$ 200	\$ 8,548	4274.00%	\$ 1,550
Golf Course Revenue	114,918	86,189	75.00%	-
Interest - Tax Collector	-	1,313	0.00%	-
Special Assmnts- Tax Collector	814,044	808,952	99.37%	1,630
Special Assmnts- Discounts	(32,562)	(30,437)	93.47%	49
Other Miscellaneous Revenues	-	1,500	0.00%	500
TOTAL REVENUES	896,600	876,065	97.71%	3,729
<u>EXPENDITURES</u>				
<u>Administration</u>				
P/R-Board of Supervisors	12,000	7,600	63.33%	800
FICA Taxes	918	581	63.29%	61
ProfServ-Arbitrage Rebate	600	-	0.00%	-
ProfServ-Engineering	45,000	34,878	77.51%	5,846
ProfServ-Legal Services	21,000	18,325	87.26%	1,959
ProfServ-Legal Litigation	25,000	2,813	11.25%	-
ProfServ-Mgmt Consulting	60,471	40,314	66.67%	5,039
ProfServ-Property Appraiser	34,294	5,369	15.66%	-
ProfServ-Trustee Fees	4,041	4,041	100.00%	-
Auditing Services	4,900	-	0.00%	-
Website Compliance	1,553	1,164	74.95%	-
Postage and Freight	600	609	101.50%	61
Insurance - General Liability	6,246	6,682	106.98%	-
Printing and Binding	499	537	107.62%	114
Legal Advertising	4,000	487	12.18%	-
Miscellaneous Services	2,000	201	10.05%	-
Misc-Bank Charges	500	207	41.40%	-
Misc-Special Projects	20,286	3,025	14.91%	1,225
Misc-Assessment Collection Cost	16,281	15,570	95.63%	34
Misc-Contingency	1,000	-	0.00%	-
Office Supplies	250	60	24.00%	15
Annual District Filing Fee	175	175	100.00%	-
Total Administration	261,614	142,638	54.52%	15,154

Statement of Revenues, Expenditures and Changes in Fund Balances
For the Period Ending May 31, 2023

ACCOUNT DESCRIPTION	ANNUAL ADOPTED BUDGET	YEAR TO DATE ACTUAL	YTD ACTUAL AS A % OF ANNUAL ADOPTED BUD	MAY-2023 ACTUAL
<u>Field</u>				
ProfServ-Field Management	5,150	3,433	66.66%	429
Contracts-Preserve Maintenance	103,832	51,915	50.00%	-
Contracts - Lake Maintenance	65,004	43,336	66.67%	5,417
R&M-General	70,000	1,600	2.29%	-
R&M-Lake	154,930	31,118	20.09%	-
R&M-Weed Harvesting	75,000	31,685	42.25%	-
Miscellaneous Maintenance	6,170	-	0.00%	-
Water Quality Testing	29,900	18,664	62.42%	1,493
Capital Projects	75,000	-	0.00%	-
Total Field	584,986	181,751	31.07%	7,339
<u>Reserves</u>				
Reserve - Other	50,000	-	0.00%	-
Total Reserves	50,000	-	0.00%	-
TOTAL EXPENDITURES & RESERVES	896,600	324,389	36.18%	22,493
Excess (deficiency) of revenues				
Over (under) expenditures	-	551,676	0.00%	(18,764)
Net change in fund balance	\$ -	\$ 551,676	0.00%	\$ (18,764)
FUND BALANCE, BEGINNING (OCT 1, 2022)	649,725	649,725		
FUND BALANCE, ENDING	\$ 649,725	\$ 1,201,401		

Statement of Revenues, Expenditures and Changes in Fund Balances
For the Period Ending May 31, 2023

ACCOUNT DESCRIPTION	ANNUAL ADOPTED BUDGET	YEAR TO DATE ACTUAL	YTD ACTUAL AS A % OF ANNUAL ADOPTED BUD	MAY-2023 ACTUAL
<u>REVENUES</u>				
Interest - Investments	\$ -	\$ 34	0.00%	\$ 7
Special Assmnts- Tax Collector	1,472,226	1,463,016	99.37%	2,947
Special Assmnts- Discounts	(58,889)	(55,046)	93.47%	88
TOTAL REVENUES	1,413,337	1,408,004	99.62%	3,042
<u>EXPENDITURES</u>				
<u>Administration</u>				
Misc-Assessment Collection Cost	29,445	28,159	95.63%	61
Total Administration	29,445	28,159	95.63%	61
<u>Debt Service</u>				
Principal Debt Retirement	1,086,000	1,086,000	100.00%	1,086,000
Interest Expense	285,316	285,316	100.00%	142,658
Total Debt Service	1,371,316	1,371,316	100.00%	1,228,658
TOTAL EXPENDITURES	1,400,761	1,399,475	99.91%	1,228,719
Excess (deficiency) of revenues Over (under) expenditures	12,576	8,529	67.82%	(1,225,677)
<u>OTHER FINANCING SOURCES (USES)</u>				
Contribution to (Use of) Fund Balance	12,576	-	0.00%	-
TOTAL FINANCING SOURCES (USES)	12,576	-	0.00%	-
Net change in fund balance	\$ 12,576	\$ 8,529	67.82%	\$ (1,225,677)
FUND BALANCE, BEGINNING (OCT 1, 2022)	536,355	536,355		
FUND BALANCE, ENDING	\$ 548,931	\$ 544,884		

Statement of Revenues, Expenditures and Changes in Fund Balances

For the Period Ending May 31, 2023

ACCOUNT DESCRIPTION	ANNUAL ADOPTED BUDGET	YEAR TO DATE ACTUAL	YTD ACTUAL AS A % OF ANNUAL ADOPTED BUD	MAY-2023 ACTUAL
<u>REVENUES</u>				
Interest - Investments	\$ -	\$ 5,490	0.00%	\$ 6
TOTAL REVENUES	-	5,490	0.00%	6
<u>EXPENDITURES</u>				
<u>Construction In Progress</u>				
Construction in Progress	-	170,041	0.00%	100,585
Total Construction In Progress	-	170,041	0.00%	100,585
TOTAL EXPENDITURES	-	170,041	0.00%	100,585
Excess (deficiency) of revenues				
Over (under) expenditures	-	(164,551)	0.00%	(100,579)
Net change in fund balance	\$ -	\$ (164,551)	0.00%	\$ (100,579)
FUND BALANCE, BEGINNING (OCT 1, 2022)	-	2,586,262		
FUND BALANCE, ENDING	\$ -	\$ 2,421,711		

Statement of Revenues, Expenditures and Changes in Fund Balances
For the Period Ending May 31, 2023

Account Description	Oct Actual	Nov Actual	Dec Actual	Jan Actual	Feb Actual	Mar Actual	Apr Actual	May Actual	Jun Projected	Jul Projected	Aug Projected	Sep Projected	TOTAL				
													Actual Thru 5/31/2023	Projected Next 4 Mths	FY2023 Total	Adopted Budget	% of Budget
Revenues																	
Interest - Investments	\$ 719	\$ 707	\$ 1,027	\$ 1,029	\$ 932	\$ 1,116	\$ 1,468	\$ 1,550	\$ 1,069	\$ 1,069	\$ 1,069	\$ 1,069	\$ 8,548	\$ 4,274	\$ 12,822	\$ 200	6411%
Golf Course Revenue	28,730	-	-	28,730	-	-	28,730	-	-	28,730	-	-	86,189	28,730	114,919	114,918	100%
Interest - Tax Collector	-	-	-	1,151	-	-	162	-	-	-	-	-	1,313	-	1,313	-	0%
Special Assmnts- Tax Collector	3,469	215,904	516,750	22,377	16,975	12,939	18,909	1,630	5,092	-	-	-	808,952	5,092	814,044	814,044	100%
Special Assmnts- Discounts	(182)	(8,636)	(20,502)	(671)	(365)	(129)	-	49	-	-	-	-	(30,437)	-	(30,437)	(32,562)	93%
Other Miscellaneous Revenues	-	-	-	-	500	500	-	500	-	-	-	-	1,500	-	1,500	-	0%
Total Revenues	32,736	207,975	497,275	52,616	18,042	14,426	49,269	3,729	6,161	29,798	1,069	1,069	876,065	38,096	914,161	896,600	102%
Expenditures																	
Administrative																	
P/R-Board of Supervisors	1,000	1,000	1,000	800	1,000	1,000	1,000	800	1,000	1,000	1,000	1,000	7,600	4,000	11,600	12,000	97%
FICA Taxes	77	77	77	61	77	77	77	61	76	76	76	76	581	304	885	918	96%
ProfServ-Arbitrage Rebate	-	-	-	-	-	-	-	-	-	-	-	600	-	600	600	600	100%
ProfServ-Engineering	-	900	-	3,960	15,820	-	8,351	5,846	-	-	-	20,327	34,878	20,327	55,205	45,000	123%
ProfServ-Legal Services	(2,329)	2,329	1,728	4,294	2,549	2,836	4,960	1,959	-	-	-	-	18,325	-	18,325	21,000	87%
ProfServ-Legal Litigation	-	1,688	-	500	-	625	-	-	-	-	-	-	2,813	-	2,813	25,000	11%
ProfServ-Mgmt Consulting	5,039	10,079	-	5,039	5,039	5,039	5,039	5,039	5,039	5,039	5,039	5,039	40,314	20,157	60,471	60,471	100%
ProfServ-Property Appraiser	5,369	-	-	-	-	-	-	-	-	-	-	-	5,369	-	5,369	34,294	16%
ProfServ-Trustee Fees	-	-	-	-	4,041	-	-	-	-	-	-	-	4,041	-	4,041	4,041	100%
Auditing Services	-	-	-	-	-	-	-	-	-	5,500	-	-	-	5,500	5,500	4,900	112%
Website Compliance	388	-	-	388	-	-	388	-	-	388	-	-	1,164	388	1,552	1,553	100%
Postage and Freight	44	53	3	216	104	77	50	61	-	-	-	-	609	-	609	600	102%
Insurance - General Liability	6,682	-	-	-	-	-	-	-	-	-	-	-	6,682	-	6,682	6,246	107%
Printing and Binding	93	165	(45)	72	-	82	56	114	-	-	-	-	537	-	537	499	108%
Legal Advertising	-	-	-	-	-	487	-	-	-	-	-	-	487	-	487	4,000	12%
Miscellaneous Services	2	-	219	(19)	-	-	-	-	-	-	-	-	201	-	201	2,000	10%
Misc-Bank Charges	100	78	30	-	-	-	-	-	-	-	-	-	207	-	207	500	41%
Misc-Special Projects	-	425	100	725	-	550	-	1,225	-	-	-	-	3,025	-	3,025	20,286	15%
Misc-Assessment Collection Cost	66	4,145	9,925	434	332	256	378	34	102	-	-	-	15,570	102	15,672	16,281	96%
Misc-Contingency	-	-	-	-	-	-	-	-	-	-	-	-	-	-	-	1,000	0%
Office Supplies	-	-	-	15	-	15	15	15	-	-	-	-	60	-	60	250	24%
Annual District Filing Fee	-	175	-	-	-	-	-	-	-	-	-	-	175	-	175	175	100%
Total Administrative	16,531	21,114	13,037	16,485	28,962	11,044	20,314	15,154	6,217	12,003	6,115	27,042	142,638	51,378	194,016	261,614	74%
Field																	
ProfServ-Field Management	-	425	863	429	429	429	429	429	429	429	429	429	3,433	1,717	5,150	5,150	100%

Statement of Revenues, Expenditures and Changes in Fund Balances
For the Period Ending May 31, 2023

Account Description	Oct Actual	Nov Actual	Dec Actual	Jan Actual	Feb Actual	Mar Actual	Apr Actual	May Actual	Jun Projected	Jul Projected	Aug Projected	Sep Projected	TOTAL				
													Actual Thru 5/31/2023	Projected Next 4 Mths	FY2023 Total	Adopted Budget	% of Budget
Contracts-Preserve Maintenance	-	25,958	-	25,958	-	-	-	-	25,958	-	-	25,958	51,915	51,915	103,830	103,832	100%
Contracts - Lake Maintenance	5,417	5,417	5,417	5,417	5,417	5,417	5,417	5,417	5,417	5,417	5,417	5,417	43,336	21,668	65,004	65,004	100%
R&M-General	-	1,600	-	-	-	-	-	-	-	-	-	80,000	1,600	80,000	81,600	70,000	117%
R&M-Lake	-	-	28,876	2,242	-	-	-	-	-	-	-	-	31,118	-	31,118	154,930	20%
R&M-Weed Harvesting	-	-	-	4,825	6,050	9,740	11,070	-	-	-	-	-	31,685	-	31,685	75,000	42%
Miscellaneous Maintenance	-	-	-	-	-	-	-	-	-	-	-	1,150	-	1,150	1,150	6,170	19%
Water Quality Testing	-	9,705	-	1,493	-	-	5,972	1,493	-	-	-	7,466	18,664	7,466	26,130	29,900	87%
Capital Projects	-	-	-	-	-	-	-	-	-	-	-	145,190	-	145,190	145,190	75,000	194%
Total Field	5,417	43,105	35,156	40,364	11,896	15,586	22,888	7,339	31,804	5,846	5,846	265,609	181,751	309,105	490,856	584,986	84%
Total Expenditures	21,948	64,219	48,193	56,849	40,858	26,630	43,202	22,493	38,021	17,850	11,961	292,651	324,389	360,483	684,872	846,600	81%
<u>Reserves</u>																	
Reserve - Other	-	-	-	-	-	-	-	-	-	-	-	-	-	-	-	50,000	0%
Total Reserves	-	-	-	-	-	-	-	-	-	-	-	-	-	-	-	50,000	0%
Total Expenditures & Reserves	21,948	64,219	48,193	56,849	40,858	26,630	43,202	22,493	38,021	17,850	11,961	292,651	324,389	360,483	684,872	896,600	76%
Excess (deficiency) of revenues Over (under) expenditures	10,788	143,756	449,082	(4,233)	(22,816)	(12,204)	6,067	(18,764)	(31,860)	11,948	(10,893)	(291,583)	551,676	(322,388)	229,288	-	0%
<u>Other Financing Sources (Uses)</u>																	
Contribution to (Use of) Fund Balance	-	-	-	-	-	-	-	-	(31,860)	11,948	(10,893)	(291,583)	-	(322,388)	(322,388)	-	0%
Total Financing Sources (Uses)	-	-	-	-	-	-	-	-	(31,860)	11,948	(10,893)	(291,583)	-	(322,388)	(322,388)	-	0%
Net change in fund balance	\$ 10,788	\$ 143,756	\$ 449,082	\$ (4,233)	\$ (22,816)	\$ (12,204)	\$ 6,067	\$ (18,764)	\$ (31,860)	\$ 11,948	\$ (10,893)	\$ (291,583)	\$ 551,676	\$ (322,388)	\$ 229,288	\$ -	0%
Fund Balance, Beginning (Oct 1, 2022)													649,725	-	649,725	649,725	
Fund Balance, Ending													\$ 1,201,401	\$ (322,388)	\$ 879,013	\$ 649,725	

QUARRY

Community Development District

Statement of Revenue and Expenditures - All Funds

Notes to the Financial Statements

10/1/2022 - 5/31/2023

General Fund

► Assets

- Allow - Doubtful Accounts - Collier County Tax Collector FY 2020 charge backs due to NSF checks
- Assessments Receivable - Collier County Tax Collector FY 2020 charge backs due to NSF checks

Budget target: 66.67%

Variance Analysis

Account Name	Annual Budget	YTD Actual	% of Budget	Explanation
Expenditures				
<u>Administration</u>				
ProfServ-Engineering	\$45,000	\$34,878	78%	CPH fees & water monitoring thru Apr 2023; Phase I & II plans/civil design
ProfServ-Legal Services	\$21,000	\$18,325	87%	Kutak Rock thru Mar 2023
ProfServ-Trustee Fees	\$4,040	\$4,041	100%	U.S. Bank trustee fees paid in full
Website Compliance	\$1,553	\$1,164	75%	Innersync Studio, quarterly web/compliance services
Postage and Freight	\$600	\$609	102%	IMS, FedEx, and Tax Collector Tax Roll postage \$172
Insurance - General Liability	\$6,246	\$6,682	107%	EGIS Insurance FY 2023 paid in full
Printing and Binding	\$499	\$537	108%	IMS & FedEx to-date
<u>Field</u>				
Contracts-Preserve Maintenance	\$103,832	\$51,915	50%	Peninsula Improvement, quarterly maintenance Oct 2022 thru Mar 2023

Quarry
Community Development District

Supporting Schedules

October 1, 2022 - May 31, 2023

**Non-Ad Valorem Special Assessments - Collier County Tax Collector
(Monthly Collection Distributions)
For the Fiscal Year Ending September 30, 2023**

					ALLOCATION BY FUND	
Date Received	Net Amount Received	Discount / (Penalties) Amount	Collection Cost	Gross Amount Received	General Fund	Series 2020 Debt Service Fund
Assessments Levied				\$ 2,286,270	\$ 814,044	\$ 1,472,226
Allocation %				100.00%	35.61%	64.39%
<i>Real Estate - Installment</i>						
10/27/22	\$ 9,046	\$ 511	\$ 185	\$ 9,742	\$ 3,469	\$ 6,273
12/20/22	2,612	82	53	2,747	978	1,769
01/09/23	1,982	63	40	2,085	742	1,343
04/10/23	4,736	-	97	4,832	1,721	3,112
<i>Real Estate - Current</i>						
11/09/22	34,381	1,462	702	36,544	13,012	23,533
11/14/22	144,366	6,138	2,946	153,450	54,637	98,813
11/21/22	391,730	16,655	7,994	416,379	148,255	268,124
12/05/22	961,045	40,860	19,613	1,021,519	363,720	657,799
12/12/22	332,130	14,063	6,778	352,971	125,678	227,293
12/20/22	70,069	2,574	1,430	74,073	26,374	47,699
01/09/23	57,759	1,823	1,179	60,760	21,634	39,126
02/06/23	45,717	1,025	933	47,675	16,975	30,700
03/06/23	35,258	363	720	36,341	12,939	23,401
04/10/23	47,307	-	965	48,273	17,188	31,085
05/11/23	4,620	(137)	94	4,576	1,629	2,947
TOTAL	\$ 2,142,756	\$ 85,482	\$ 43,730	\$ 2,271,968	\$ 808,952	\$ 1,463,016
% COLLECTED				99.37%	99.37%	99.37%
TOTAL OUTSTANDING				\$ 14,301	\$ 5,092	\$ 9,209

**Cash & Investment Report
October 1, 2022 - May 31, 2023**

<u>ACCOUNT NAME</u>	<u>BANK NAME</u>	<u>YIELD</u>	<u>BALANCE</u>
OPERATING FUND			
Operating - Checking Account	Hancock Whitney	0.00%	\$ 815,613
Public Funds MMA Variance Account	BankUnited	4.50%	415,473
DEBT SERVICE AND CAPITAL PROJECT FUNDS			
Series 2020 Revenue Fund	U.S. Bank	0.01%	541,909
Series 2020 Construction Fund	U.S. Bank	0.01%	373,971
U.S. Treasury Bill Purchase 6/15/23		4.71%	499,285
U.S. Treasury Bill Purchase 7/25/23		4.93%	299,478
U.S. Treasury Bill Purchase 8/10/23		5.01%	499,302
U.S. Treasury Bill Purchase 9/21/23		4.84%	499,908
U.S. Treasury Bill Purchase 10/19/23		4.91%	249,767
			<u>2,421,711</u>
		Subtotal	<u>2,963,620</u>
		Total	<u><u>\$ 4,194,705</u></u>

Quarry CDD

Bank Reconciliation

Bank Account No. 3489 Hancock & Whitney Bank General Fund
Statement No. 05-23
Statement Date 5/31/2023

G/L Balance (LCY)	815,612.67	Statement Balance	815,612.67
G/L Balance	815,612.67	Outstanding Deposits	0.00
Positive Adjustments	0.00		
		Subtotal	815,612.67
Subtotal	815,612.67	Outstanding Checks	0.00
Negative Adjustments	0.00	Differences	0.00
Ending G/L Balance	815,612.67	Ending Balance	815,612.67
Difference	0.00		

Posting Date	Document Type	Document No.	Description	Amount	Cleared Amount	Difference
--------------	---------------	--------------	-------------	--------	----------------	------------

**Series 2020 (FEMA Project)
Acquisition and Construction - General
FY 9/30/2023**

SOURCES OF FUNDS		TOTAL
10/1/2021	State of Florida	\$ 3,350,061.50
10/26/2021	State of Florida	828,145.56
10/26/2021	State of Florida	46,008.09
11/17/2021	State of Florida	94,901.34
11/17/2021	State of Florida	91,213.19
12/21/2021	State of Florida	65,276.88
12/17/2021	FEMA check sent to U.S. Bank exceeded actual checks	-
1/10/2022	State of Florida	18,585.00
1/10/2022	State of Florida	1,032.50
Total		\$ 4,495,224.06
LESS:		
11/1/2021	Debt Service - Principal Prepayment	1,351,000.00
DEPOSIT - Acquisition and Construction - General		\$ 3,144,224.06

OTHER SOURCES

11/1/2021	Transfer from Revenue Acct 4004	938.50
	Dividends FY 2022	145.89
	Dividends thru 5/31/23	5,489.46
TOTAL SOURCES OF FUNDS		\$ 6,573.85

USE OF FUNDS:

DATE	VENDOR REQUISITIONS	REQ #	PENDING	TOTAL
4/27/2022	CPH	1		4,940.00
4/27/2022	Kutak Rock LLP	2		988.00
5/24/2022	Midwest Construction Products Corp	3		475.00
5/16/2022	Midwest Construction Products Corp	4		3,000.00
5/16/2022	Midwest Construction Products Corp	5		7,900.00
5/24/2022	Kutak Rock LLP	6		1,776.45
5/24/2022	CPH	7		11,615.40
6/9/2022	Kutak Rock LLP	8		1,378.00
6/9/2022	Midwest Construction Products Corp	9		1,900.00
6/9/2022	Midwest Construction Products Corp	10		4,800.00
6/9/2022	Midwest Construction Products Corp	11		1,425.00
6/9/2022	Crosscreek Environmental LLC	12		2,997.66
8/1/2022	CPH	13		27,155.66
8/1/2022	CPH	14		1,800.00
8/1/2022	CPH	15		33,809.58
8/22/2022	Crosscreek Environmental LLC	16		4,000.13
8/22/2022	Midwest Construction Products Corp	17		6,000.00
8/22/2022	Midwest Construction Products Corp	18		1,020.00
8/22/2022	MJS Golf Services LLC	19		7,615.15
8/22/2022	MJS Golf Services LLC	20		4,157.51

**Series 2020 (FEMA Project)
Acquisition and Construction - General
FY 9/30/2023**

SOURCES OF FUNDS			TOTAL
8/22/2022	MJS Golf Services LLC	21	12,849.68
8/22/2022	MJS Golf Services LLC	22	6,568.09
8/22/2022	MJS Golf Services LLC	23	5,058.60
8/22/2022	MJS Golf Services LLC	24	16,849.00
8/22/2022	MJS Golf Services LLC	25	49,004.13
8/22/2022	MJS Golf Services LLC	26	4,346.44
8/26/2022	CPH	27	7,745.15
9/14/2022	MJS Golf Services LLC	28	7,887.77
9/14/2022	GLASE GOLF, INC	29	319,983.78
10/20/2022	Crosscreek Environmental LLC	30	5,295.80
10/20/2022	CPH	31	6,513.38
10/20/2022	Kutak Rock LLP	32	78.00
12/2/2022	CPH	33	8,866.67
12/21/2022	CPH	34	4,500.00
1/25/2023	CPH	35	5,398.75
2/17/2023	CPH	36	1,828.75
2/17/2023	CPH	37	110.00
4/17/2023	MJS Golf Services LLC	38	17,952.64
4/17/2023	MJS Golf Services LLC	39	2,844.35
4/17/2023	MJS Golf Services LLC	40	5,715.47
4/17/2023	MJS Golf Services LLC	41	10,351.76
5/2/2023	MJS Golf Services LLC	42	4,619.04
5/2/2023	MJS Golf Services LLC	43	4,014.17
5/2/2023	CPH	44	560.60
5/2/2023	MJS Golf Services LLC	45	14,377.92
5/2/2023	MJS Golf Services LLC	46	2,876.79
5/2/2023	MJS Golf Services LLC	47	5,672.47
5/2/2023	MJS Golf Services LLC	48	14,338.68
5/3/2023	MJS Golf Services LLC	49	5,153.28
5/3/2023	Midwest Construction Products Corp	50	3,302.00
5/3/2023	Midwest Construction Products Corp	51	5,248.00
5/3/2023	Midwest Construction Products Corp	52	2,637.00
5/3/2023	CPH	53	9,283.60
5/3/2023	MJS Golf Services LLC	54	8,194.20
	* MJS Golf Services LLC	55	-
	* Ewing Irrigation Products, Inc	56	-
5/30/2023	MJS Golf Services LLC	57	3,993.31
5/30/2023	MJS Golf Services LLC	58	16,314.17
Total Requisitions			729,086.98
TOTAL CONSTRUCTION ACCOUNT BALANCE @ 5/31/23			\$ 2,421,710.93

* Paid on 6/5/2023

QUARRY COMMUNITY DEVELOPMENT DISTRICT

Payment Register by Bank Account

For the Period from 5/1/23 to 5/31/23

(Sorted by Check / ACH No.)

Date	Payee Type	Payee	Invoice No.	Payment Description	Invoice / GL Description	G/L Account #	Amount Paid
<u>HANCOCK & WHITNEY BANK GENERAL FUND - (ACCT#XXXXX3489)</u>							
CHECK # 8518							
05/10/23	Vendor	INFRAMARK LLC	93675	APRIL 2023 MGMT FEES	FIELD OPS	001-531016-53901	\$429.17
05/10/23	Vendor	INFRAMARK LLC	93675	APRIL 2023 MGMT FEES	COPIES	001-551002-51301	\$15.00
05/10/23	Vendor	INFRAMARK LLC	93675	APRIL 2023 MGMT FEES	Printing and Binding	001-547001-51301	\$56.20
05/10/23	Vendor	INFRAMARK LLC	93675	APRIL 2023 MGMT FEES	POSTAGE	001-541006-51301	\$7.20
05/10/23	Vendor	INFRAMARK LLC	93675	APRIL 2023 MGMT FEES	ProfServ-Mgmt Consulting Serv	001-531027-51201	\$5,039.25
Check Total							\$5,546.82
CHECK # 8519							
05/10/23	Vendor	COLLIER COUNTY TAX COLLECTOR	041023	2022 TAX ROLL SECOND POSTAGE BILLING	Postage and Freight	001-541006-51301	\$14.20
Check Total							\$14.20
CHECK # 8520							
05/10/23	Vendor	PENINSULA IMPROVEMENT CORP.	INV009522	MAR 2023 LAKE & LITTORAL MAINT	Contracts - Lake Maintenance	001-534345-53901	\$5,417.00
Check Total							\$5,417.00
CHECK # 8521							
05/10/23	Vendor	FEDEX	8-104-25584	FEDEX TO MEL STUCKEY	Postage and Freight	001-541006-51301	\$41.14
Check Total							\$41.14
ACH #DD156							
05/17/23	Employee	TIMOTHY B. CANTWELL	PAYROLL	May 17, 2023 Payroll Posting			\$184.70
ACH Total							\$184.70
ACH #DD157							
05/17/23	Employee	DEAN A. BRITT	PAYROLL	May 17, 2023 Payroll Posting			\$184.70
ACH Total							\$184.70
ACH #DD158							
05/17/23	Employee	MARION M. STUCKEY	PAYROLL	May 17, 2023 Payroll Posting			\$184.70
ACH Total							\$184.70
Account Total							\$11,573.26

8C

QUARRY
Community Development District

Annual Operating and Debt Service Budget
Fiscal Year 2024

Modified Tentative Budget:
(Printed on 6/6/2023 at 7:15 PM)

Prepared by:



Table of Contents

	<u>Page #</u>
<u>OPERATING BUDGET</u>	
General Fund	
Summary of Revenues, Expenditures and Changes in Fund Balances	1-2
Budget Narrative	3-6
Exhibit A - Allocation of Fund Balances	7
<u>DEBT SERVICE BUDGET</u>	
Series 2020	
Summary of Revenues, Expenditures and Changes in Fund Balances	8
Amortization Schedule	9
Budget Narrative	10
<u>SUPPORTING BUDGET SCHEDULE</u>	
Comparison of Assessment Rates	11

Quarry
Community Development District

Operating Budget
Fiscal Year 2024

Summary of Revenues, Expenditures and Changes in Fund Balances
Fiscal Year 2024 Modified Tentative Budget

ACCOUNT DESCRIPTION	ACTUAL FY 2021	ACTUAL FY 2022	ADOPTED BUDGET FY 2023	ACTUAL THRU MAY-2023	PROJECTED JUNE - SEPT-2023	TOTAL PROJECTED FY 2023	ANNUAL BUDGET FY 2024
REVENUES							
Interest - Investments	\$ 564	\$ 1,492	\$ 200	\$ 8,548	\$ 4,274	\$ 12,822	\$ 4,000
Golf Course Revenue	18,000	114,918	114,918	86,189	28,729	114,918	114,945
Interest - Tax Collector	251	171	-	1,313	-	1,313	-
Special Assmnts- Tax Collector	579,501	814,044	814,044	808,952	5,092	814,044	814,044
Special Assmnts- Delinquent	821	-	-	-	-	-	-
Special Assmnts- Discounts	(21,200)	(30,440)	(32,562)	(30,437)	-	(30,437)	(32,562)
Other Miscellaneous Revenues	48,215	48,250	-	1,500	-	1,500	-
TOTAL REVENUES	626,152	948,435	896,600	876,065	38,095	914,160	900,427
EXPENDITURES							
<i>Administrative</i>							
P/R-Board of Supervisors	8,200	10,200	12,000	7,600	4,000	11,600	12,000
FICA Taxes	627	780	918	581	306	887	918
ProfServ-Arbitrage Rebate	-	-	600	-	600	600	600
ProfServ-Engineering	27,564	50,008	45,000	34,878	20,327	55,205	45,000
ProfServ-Legal Services (District)	13,835	39,166	21,000	18,325	-	18,325	21,000
ProfServ-Legal Litigation (Outside Svcs)	4,686	-	25,000	2,813	-	2,813	25,000
ProfServ-Mgmt Consulting Serv	57,000	58,710	60,471	40,314	20,157	60,471	62,285
ProfServ-Other Legal Charges	69,525	25,500	-	-	-	-	-
ProfServ-Property Appraiser	11,318	-	34,294	5,369	-	5,369	34,294
ProfServ-Trustee Fees	7,189	4,041	4,041	4,041	-	4,041	4,041
ProfServ-Consultants	11,810	-	-	-	-	-	-
Auditing Services	4,900	7,250	4,900	-	5,500	5,500	5,500
Contract-Website Hosting	362	-	-	-	-	-	-
Website Compliance	1,553	1,553	1,553	1,164	388	1,552	1,553
Postage and Freight	1,232	515	600	609	-	609	600
Insurance - General Liability	6,064	6,216	6,246	6,682	-	6,682	6,246
Printing and Binding	601	137	499	537	-	537	500
Legal Advertising	2,495	2,786	4,000	487	-	487	4,000
Miscellaneous Services	1,155	-	2,000	201	-	201	2,000
Misc-Bank Charges	443	686	500	207	-	207	500
Misc-Special Projects	19,350	9,750	20,286	3,025	-	3,025	21,547
Misc-Assessmnt Collection Cost	7,429	9,816	16,281	15,570	102	15,672	16,281
Misc-Contingency	1,591	436	1,000	-	-	-	1,000
Office Supplies	315	-	250	60	-	60	250
Annual District Filing Fee	175	175	175	175	-	175	175
Total Administrative	259,419	227,725	261,614	142,638	51,380	194,018	265,289
<i>Field</i>							
ProfServ-Field Management	-	5,295	5,150	3,433	1,717	5,150	5,304
Contracts-Preserve Maintenance	51,040	102,955	103,832	51,915	51,915	103,830	103,830
Contracts-Lake Maintenance	-	65,004	65,004	43,336	21,668	65,004	65,004
R&M-General	-	12,788	70,000	1,600	80,000	81,600	70,000
R&M-Lake	-	112,486	154,930	31,118	-	31,118	154,930
Lake & Preserve Maintenance	102,117	-	-	-	-	-	-
R&M-Fence	-	-	-	-	-	-	2,500
R&M-Weed Harvesting	-	49,345	75,000	31,685	-	31,685	75,000
Miscellaneous Maintenance	27,080	56,150	6,170	-	1,150	1,150	3,670
Water Quality Testing	-	33,633	29,900	18,664	7,466	26,130	29,900

Summary of Revenues, Expenditures and Changes in Fund Balances
Fiscal Year 2024 Modified Tentative Budget

ACCOUNT DESCRIPTION	ACTUAL FY 2021	ACTUAL FY 2022	ADOPTED BUDGET FY 2023	ACTUAL THRU MAY-2023	PROJECTED JUNE - SEPT-2023	TOTAL PROJECTED FY 2023	ANNUAL BUDGET FY 2024
Capital Projects	-	-	75,000	-	145,190	145,190	75,000
Total Field	180,237	437,656	584,986	181,751	309,106	490,857	585,138
Reserves							
Reserve - Other	-	-	50,000	-	-	-	50,000
Total Reserves	-	-	50,000	-	-	-	50,000
TOTAL EXPENDITURES & RESERVES	439,656	665,381	896,600	324,389	360,486	684,875	900,427
Excess (deficiency) of revenues Over (under) expenditures	186,496	283,054	-	551,676	(322,391)	229,285	-
OTHER FINANCING SOURCES (USES)							
Operating Transfers-Out	-	-	-	-	-	-	-
TOTAL OTHER SOURCES (USES)	-	-	-	-	-	-	-
Net change in fund balance	186,496	283,054	-	551,676	(322,391)	229,285	-
FUND BALANCE, BEGINNING	180,176	366,672	649,726	649,726	-	649,726	879,011
FUND BALANCE, ENDING	\$ 366,672	\$ 649,726	\$ 649,726	\$ 1,201,402	\$ (322,391)	\$ 879,011	\$ 879,011

Budget Narrative
Fiscal Year 2024

REVENUES

Interest-Investments

The District earns interest on the monthly average collected balance for their money market account.

Golf Course Revenue

The District receives yearly revenue from golf course.

Special Assessments-Tax Collector

The District will levy a Non-Ad Valorem assessment on all the assessable property within the District to pay for the operating expenditures during the Fiscal Year.

Special Assessments-Discounts

Per Section 197.162, Florida Statutes, discounts are allowed for early payment of assessments. The budgeted amount for the fiscal year is calculated at 4% of the anticipated Non-Ad Valorem assessments.

EXPENDITURES

Administrative

P/R-Board of Supervisors

Chapter 190 of the Florida Statutes allows for members of the Board of Supervisors to be compensated \$200 per meeting at which they are in attendance. The amount for the Fiscal Year is based upon all supervisors attending all twelve meetings.

FICA Taxes

Payroll taxes on Board of Supervisors compensation. The budgeted amount for the fiscal year is calculated at 7.65% of the total Board of Supervisor's payroll expenditures.

Professional Services-Arbitrage Rebate Calculation

The District utilizes a company who specializes in calculating the District's Arbitrage Rebate Liability on the Series of Benefit Special Assessment Bonds. The budgeted amount for the fiscal year is based on standard fees charged for this service.

Professional Services-Engineering

The District's engineer provides general engineering services to the District, i.e., attendance and preparation for monthly board meetings when requested, review of invoices, annual engineer report for compliance purpose and other specifically requested assignments. Annual engineer's report as required by the bond indenture.

Professional Services-Legal Services (District)

The District's Attorney, Kutak Rock, LLP. provides general legal services to the District, i.e., attendance and preparation for monthly Board meetings, review of contracts, review of agreements and resolutions, and other research as directed or requested by the Board of Supervisors and the District Manager.

Professional Services-Legal Litigation (Outside Services)

Allowance for outside legal services as needed.

Budget Narrative
Fiscal Year 2024

EXPENDITURES

Administrative (continued)

Professional Services-Management Consulting Services

The District receives management, accounting, and administrative services as part of a management agreement with Inframark Infrastructure Management Services. Also includes cost of Information Technology (GASB 54 Compliant Software System), transcription services, records management, and long-term offsite records storage. The budgeted amount for the fiscal year is based on the contracted fees outlined in Exhibit "A" of the management agreement.

Professional Services-Property Appraiser

Collier County Non-Ad Valorem Tax roll. 1.5% of current fiscal year total assessments less prior year excess fees and/or adjustments.

Professional Services-Trustee

The District issued this Series 2020 Special Assessment Bond that is deposited to Trustee to manage all trustee matters. The annual trustee fee is based on standard fees charged plus any out-of-pocket expenses.

Auditing Services

The District is required to conduct an annual audit of its financial records by an Independent Certified Public Accounting Firm. The budgeted amount for the fiscal year is based on contracted fees from an existing engagement letter.

Website Compliance

The District contracted with a company to operate the website ADA compliance to meet Florida statutes.

Postage and Freight

Actual postage and/or freight used for District mailings including agenda packages, vendor checks and other correspondence.

Insurance-General Liability

The District's General Liability & Public Officials Liability Insurance policy is with Florida Insurance Alliance. They specialize in providing insurance coverage to governmental agencies. The budgeted amount allows for a projected increase in the premium. A 3% increase is projected.

Printing and Binding

Copies used in the preparation of agenda packages, required mailings, and other special projects.

Legal Advertising

The District is required to advertise various notices for monthly Board meetings and other public hearings in a newspaper of general circulation.

Miscellaneous Services

The District may incur other unanticipated services. (Email migration, main renewal, and new email accounts)

Misc-Bank Charges

The District may incur unanticipated bank fees.

Misc-Special Projects

The District special projects during the year.

Budget Narrative
Fiscal Year 2024

EXPENDITURES

Administrative (continued)

Miscellaneous-Assessment Collection Costs

The District reimburses the Collier County Tax Collector for necessary administrative costs. Per the Florida Statutes, administrative costs shall include, but not be limited to, those costs associated with personnel, forms, supplies, data processing, computer equipment, postage, and programming. The District also compensates the Tax Collector for the actual cost of collection or 2% on the amount of special assessments collected and remitted, whichever is greater. The budget for collection costs was based on a maximum of 2% of the anticipated assessment collections.

Misc-Contingency

The District may incur unbudgeted expenditures.

Office Supplies

Supplies used in the preparation and binding of agenda packages, required mailings, and other special projects.

Annual District Filing Fee

The District annual fee of \$175 to the Department of Economic Opportunity.

Field

Professional Services-Field Management

The District contract for field management services.

Contracts-Preserve Maintenance

Quarterly preserve contract with Collier Environmental Services, A/K/A Peninsula Improvement Corporation.

Contracts-Lake Maintenance

Monthly service for \$5,417 for lake and littoral maintenance with Collier Environmental Services, A/K/A Peninsula Improvement Corporation.

R&M-Weed Harvesting

Lake weed works for the District.

R&M-General

General expenditures that may incur for the District.

R&M-Lake

Other lake expenditures that may incur for the District.

Miscellaneous Maintenance

District other maintenance.

Water Quality Testing

Water quality testing for the District, as needed.

Capital Projects

The District purchase of capital expenditures.

Budget Narrative
Fiscal Year 2024

EXPENDITURES

Reserves

Reserve - Other

Planned expenditures the District allocated for future projects

Exhibit "A"
Allocation of Fund Balances

AVAILABLE FUNDS

	<u>Amount</u>
Beginning Fund Balance - Fiscal Year 2024	\$ 879,011
Net Change in Fund Balance - Fiscal Year 2024	-
Reserves - Fiscal Year 2024 Additions	50,000
Total Funds Available (Estimated) - 9/30/2024	929,011

ALLOCATION OF AVAILABLE FUNDS

Assigned Fund Balance

Operating Reserve - First Quarter Operating Capital	175,439 ⁽¹⁾
Reserves - Other (Previous Years)	150,000
Reserves - Other (FY 2024)	50,000
Subtotal	<u>200,000</u>
Total Allocation of Available Funds	375,439

Total Unassigned (undesignated) Cash	<u>\$ 553,572</u>
---	--------------------------

Notes

(1) Represents approximately 3 months of operating expenditures

Quarry
Community Development District

Debt Service Budget
Fiscal Year 2024

Summary of Revenues, Expenditures and Changes in Fund Balances
Fiscal Year 2024 Modified Tentative Budget

ACCOUNT DESCRIPTION	ACTUAL FY 2021	ACTUAL FY 2022	ADOPTED BUDGET FY 2023	ACTUAL THRU MAY-2023	PROJECTED JUNE - SEPT-2023	TOTAL PROJECTED FY 2023	ANNUAL BUDGET FY 2024
REVENUES							
Interest - Investments	\$ 27	\$ 40	\$ -	\$ 34	\$ -	\$ 34	\$ -
Special Assmnts- Tax Collector	250,997	1,608,706	1,472,226	1,463,016	9,210	1,472,226	1,472,226
Special Assmnts- Delinquent	2,913	-	-	-	-	-	-
Special Assmnts- Discounts	(3,493)	(60,155)	(58,889)	(55,046)	-	(55,046)	(58,889)
TOTAL REVENUES	250,444	1,548,591	1,413,337	1,408,004	9,210	1,417,214	1,413,337
EXPENDITURES							
<i>Administrative</i>							
Misc-Assessmnt Collection Cost	(7,423)	19,399	29,445	28,159	184	28,343	29,445
Total Administrative	(7,423)	19,399	29,445	28,159	184	28,343	29,445
<i>Debt Service</i>							
Principal Debt Retirement	987,000	1,065,000	1,086,000	1,086,000	-	1,086,000	1,107,000
Interest Expense	126,871	319,082	285,316	285,316	-	285,316	264,248
Cost of Issuance	274,006	-	-	-	-	-	-
Total Debt Service	1,387,877	1,384,082	1,371,316	1,371,316	-	1,371,316	1,371,248
TOTAL EXPENDITURES	1,380,454	1,403,481	1,400,761	1,399,475	184	1,399,659	1,400,693
Excess (deficiency) of revenues Over (under) expenditures	(1,130,010)	145,110	12,576	8,529	9,026	17,555	12,644
OTHER FINANCING SOURCES (USES)							
Interfund Transfer - In	1,244,820	-	-	-	-	-	-
Proceeds of Refunding Bonds	277,373	-	-	-	-	-	-
Operating Transfers-Out	-	(939)	-	-	-	-	-
Contribution to (Use of) Fund Balance	-	-	12,576	-	-	-	-
TOTAL OTHER SOURCES (USES)	1,522,193	(939)	12,576	-	-	-	-
Net change in fund balance	392,183	144,171	12,576	8,529	9,026	17,555	-
FUND BALANCE, BEGINNING	-	392,183	536,354	536,354	-	536,354	553,909
FUND BALANCE, ENDING	\$ 392,183	\$ 536,354	\$ 548,930	\$ 544,883	\$ 9,026	\$ 553,909	\$ 553,909

BOND DEBT SERVICE

Quarry Community Development District
 Special Assessment Refunding Bonds, Series 2020
 Refunding of Special Assessment Refunding Bonds, Series 2019
 (Private Placement - Hancock Bank)

Period Ending	Par Outstanding	Principal	Extraordinary Redemption	Coupon	Interest	Debt Service	Annual Debt Service
11/1/2023	13,621,000				132,124	132,123.70	
5/1/2024	13,621,000	1,107,000		1.940%	132,124	1,239,123.70	1,371,247.40
11/1/2024	12,514,000				121,386	121,385.80	
5/1/2025	12,514,000	1,128,000		1.940%	121,386	1,249,385.80	1,370,771.60
11/1/2025	11,386,000				110,444	110,444.20	
5/1/2026	11,386,000	1,151,000		1.940%	110,444	1,261,444.20	1,371,888.40
11/1/2026	10,235,000				99,280	99,279.50	
5/1/2027	10,235,000	1,173,000		1.940%	99,280	1,272,279.50	1,371,559.00
11/1/2027	9,062,000				87,901	87,901.40	
5/1/2028	9,062,000	1,196,000		1.940%	87,901	1,283,901.40	1,371,802.80
11/1/2028	7,866,000				76,300	76,300.20	
5/1/2029	7,866,000	1,220,000		1.940%	76,300	1,296,300.20	1,372,600.40
11/1/2029	6,646,000				64,466	64,466.20	
5/1/2030	6,646,000	952,000		1.940%	64,466	1,016,466.20	1,080,932.40
11/1/2030	5,694,000				55,232	55,231.80	
5/1/2031	5,694,000	970,000		1.940%	55,232	1,025,231.80	1,080,463.60
11/1/2031	4,724,000				45,823	45,822.80	
5/1/2032	4,724,000	990,000		1.940%	45,823	1,035,822.80	1,081,645.60
11/1/2032	3,734,000				36,220	36,219.80	
5/1/2033	3,734,000	1,009,000		1.940%	36,220	1,045,219.80	1,081,439.60
11/1/2033	2,725,000				26,433	26,432.50	
5/1/2034	2,725,000	891,000		1.940%	26,433	917,432.50	943,865.00
11/1/2034	1,834,000				17,790	17,789.80	
5/1/2035	1,834,000	908,000		1.940%	17,790	925,789.80	943,579.60
11/1/2035	926,000				8,982	8,982.20	
5/1/2036	926,000	926,000		1.940%	8,982	934,982.20	943,964.40
		\$ 13,621,000			\$ 1,764,760	\$ 15,385,760	\$ 15,385,760

Budget Narrative
Fiscal Year 2024

REVENUES

Special Assessments-Tax Collector

The District will levy a Non-Ad Valorem assessment on all the assessable property within the District to pay for the debt service expenditures during the Fiscal Year.

Special Assessments-Discounts

Per Section 197.162, Florida Statutes, discounts are allowed for early payment of assessments. The budgeted amount for the fiscal year is calculated at 4% of the anticipated Non-Ad Valorem assessments.

EXPENDITURES

Administrative

Miscellaneous-Assessment Collection Cost

The District reimburses the Collier County Tax Collector for her or his necessary administrative costs. Per the Florida Statutes, administrative costs shall include, but not be limited to, those costs associated with personnel, forms, supplies, data processing, computer equipment, postage, and programming. The District also compensates the Tax Collector for the actual cost of collection or 2% on the amount of special assessments collected and remitted, whichever is greater. The budget for collection costs was based on a maximum of 2% of the anticipated assessment collections.

Principal Debt Retirement

The District pays an annual principal amount on 5/1 of each fiscal year.

Interest Expense

The District pays semi-annual interest amounts on 5/1 and 11/1 of each fiscal year.

Quarry
Community Development District

Supporting Budget Schedule
Fiscal Year 2024

**Comparison of Assessment Rates
Fiscal Year 2024 vs. Fiscal Year 2023**

Product & Phase	General Fund 001			2020-1 Debt Service			2020-2 Debt Service			2020-3 Debt Service			Total Assessments per Unit			Units
	FY 2024	FY 2023	% Change	FY 2024	FY 2023	% Change	FY 2024	FY 2023	% Change	FY 2024	FY 2023	% Change	FY 2024	FY 2023	% Change	
Coach	\$763.83	\$763.86	0.0%	\$1,225.84	\$1,225.84	0.0%	\$94.38	\$94.38	0.0%	\$198.20	\$198.20	0.0%	\$2,282.25	\$2,282.29	0.0%	26
	\$763.83	\$763.86	0.0%	\$1,265.38	\$1,265.38	0.0%	\$94.38	\$94.38	0.0%	\$198.20	\$198.20	0.0%	\$2,321.79	\$2,321.82	0.0%	19
	\$763.83	\$763.86	0.0%	\$1,463.09	\$1,463.09	0.0%	\$94.38	\$94.38	0.0%	\$198.20	\$198.20	0.0%	\$2,519.50	\$2,519.54	0.0%	3
	\$763.83	\$763.86	0.0%	\$1,660.81	\$1,660.81	0.0%	\$94.38	\$94.38	0.0%	\$198.20	\$198.20	0.0%	\$2,717.22	\$2,717.25	0.0%	37
	\$763.83	\$763.86	0.0%	\$1,700.35	\$1,700.35	0.0%	\$94.38	\$94.38	0.0%	\$198.20	\$198.20	0.0%	\$2,756.76	\$2,756.80	0.0%	1
	\$763.83	\$763.86	0.0%	\$1,858.52	\$1,858.52	0.0%	\$94.38	\$94.38	0.0%	\$198.20	\$198.20	0.0%	\$2,914.93	\$2,914.97	0.0%	30
	\$763.83	\$763.86	0.0%	\$506.15	\$506.15	0.0%	\$94.38	\$94.38	0.0%	\$198.20	\$198.20	0.0%	\$1,562.56	\$1,562.59	0.0%	96
Luxury Coach	\$856.39	\$856.40	0.0%	\$1,384.01	\$1,384.01	0.0%	\$111.88	\$111.88	0.0%	\$234.89	\$234.89	0.0%	\$2,587.16	\$2,587.17	0.0%	26
	\$856.39	\$856.40	0.0%	\$1,502.64	\$1,502.64	0.0%	\$111.88	\$111.88	0.0%	\$234.89	\$234.89	0.0%	\$2,705.79	\$2,705.80	0.0%	20
	\$856.39	\$856.40	0.0%	\$1,898.07	\$1,898.07	0.0%	\$111.88	\$111.88	0.0%	\$234.89	\$234.89	0.0%	\$3,101.22	\$3,101.23	0.0%	18
SF 55	\$767.91	\$767.95	0.0%	\$1,225.84	\$1,225.84	0.0%	\$125.69	\$125.69	0.0%	\$264.27	\$264.27	0.0%	\$2,383.72	\$2,383.75	0.0%	43
	\$767.91	\$767.95	0.0%	\$1,265.38	\$1,265.38	0.0%	\$125.69	\$125.69	0.0%	\$264.27	\$264.27	0.0%	\$2,423.26	\$2,423.29	0.0%	13
	\$767.91	\$767.95	0.0%	\$1,463.09	\$1,463.09	0.0%	\$125.69	\$125.69	0.0%	\$264.27	\$264.27	0.0%	\$2,620.97	\$2,621.00	0.0%	3
	\$767.91	\$767.95	0.0%	\$1,660.81	\$1,660.81	0.0%	\$125.69	\$125.69	0.0%	\$264.27	\$264.27	0.0%	\$2,818.69	\$2,818.72	0.0%	4
	\$767.91	\$767.95	0.0%	\$624.78	\$624.78	0.0%	\$125.69	\$125.69	0.0%	\$264.27	\$264.27	0.0%	\$1,782.66	\$1,782.69	0.0%	74
SF 67	\$876.68	\$876.68	0.0%	\$1,384.01	\$1,384.01	0.0%	\$156.99	\$156.99	0.0%	\$330.34	\$330.34	0.0%	\$2,748.01	\$2,748.02	0.0%	9
	\$876.68	\$876.68	0.0%	\$1,621.27	\$1,621.27	0.0%	\$156.99	\$156.99	0.0%	\$330.34	\$330.34	0.0%	\$2,985.28	\$2,985.29	0.0%	10
	\$876.68	\$876.68	0.0%	\$1,700.35	\$1,700.35	0.0%	\$156.99	\$156.99	0.0%	\$330.34	\$330.34	0.0%	\$3,064.36	\$3,064.37	0.0%	1
	\$876.68	\$876.68	0.0%	\$1,818.99	\$1,818.99	0.0%	\$156.99	\$156.99	0.0%	\$330.34	\$330.34	0.0%	\$3,182.99	\$3,183.00	0.0%	20
	\$876.68	\$876.68	0.0%	\$1,898.07	\$1,898.07	0.0%	\$156.99	\$156.99	0.0%	\$330.34	\$330.34	0.0%	\$3,262.08	\$3,262.08	0.0%	2
	\$876.68	\$876.68	0.0%	\$2,016.70	\$2,016.70	0.0%	\$156.99	\$156.99	0.0%	\$330.34	\$330.34	0.0%	\$3,380.71	\$3,380.72	0.0%	12
	\$876.68	\$876.68	0.0%	\$688.05	\$688.05	0.0%	\$156.99	\$156.99	0.0%	\$330.34	\$330.34	0.0%	\$2,052.06	\$2,052.06	0.0%	111
SF 75	\$1,040.35	\$1,040.32	0.0%	\$1,463.09	\$1,463.09	0.0%	\$209.48	\$209.48	0.0%	\$440.44	\$440.44	0.0%	\$3,153.37	\$3,153.33	0.0%	22
	\$1,040.35	\$1,040.32	0.0%	\$1,700.35	\$1,700.35	0.0%	\$209.48	\$209.48	0.0%	\$440.44	\$440.44	0.0%	\$3,390.63	\$3,390.59	0.0%	12
	\$1,040.35	\$1,040.32	0.0%	\$1,779.44	\$1,779.44	0.0%	\$209.48	\$209.48	0.0%	\$440.44	\$440.44	0.0%	\$3,469.71	\$3,469.67	0.0%	1
	\$1,040.35	\$1,040.32	0.0%	\$1,898.07	\$1,898.07	0.0%	\$209.48	\$209.48	0.0%	\$440.44	\$440.44	0.0%	\$3,588.34	\$3,588.31	0.0%	39
	\$1,040.35	\$1,040.32	0.0%	\$1,818.99	\$1,818.99	0.0%	\$209.48	\$209.48	0.0%	\$440.44	\$440.44	0.0%	\$3,509.26	\$3,509.23	0.0%	8
	\$1,040.35	\$1,040.32	0.0%	\$1,977.16	\$1,977.16	0.0%	\$209.48	\$209.48	0.0%	\$440.44	\$440.44	0.0%	\$3,667.43	\$3,667.40	0.0%	2
	\$1,040.35	\$1,040.32	0.0%	\$3,163.45	\$3,163.45	0.0%	\$209.48	\$209.48	0.0%	\$440.44	\$440.44	0.0%	\$4,853.72	\$4,853.69	0.0%	1
	\$1,040.35	\$1,040.32	0.0%	\$814.58	\$814.58	0.0%	\$209.48	\$209.48	0.0%	\$440.44	\$440.44	0.0%	\$2,504.85	\$2,504.82	0.0%	186
SF 90	\$1,284.58	\$1,284.49	0.0%	\$2,174.87	\$2,174.87	0.0%	\$313.07	\$313.07	0.0%	\$660.67	\$660.67	0.0%	\$4,433.19	\$4,433.10	0.0%	10
	\$1,284.58	\$1,284.49	0.0%	\$3,163.45	\$3,163.45	0.0%	\$313.07	\$313.07	0.0%	\$660.67	\$660.67	0.0%	\$5,421.77	\$5,421.67	0.0%	8
	\$1,284.58	\$1,284.49	0.0%	\$3,361.16	\$3,361.16	0.0%	\$313.07	\$313.07	0.0%	\$660.67	\$660.67	0.0%	\$5,619.48	\$5,619.39	0.0%	1
	\$1,284.58	\$1,284.49	0.0%	\$1,565.91	\$1,565.91	0.0%	\$313.07	\$313.07	0.0%	\$660.67	\$660.67	0.0%	\$3,824.22	\$3,824.13	0.0%	32
Club House	\$0.00	\$0.00	n/a	\$0.00	\$0.00	n/a	\$ 2,920.73	\$ 2,920.73	0.0%	\$6,166.17	\$6,166.17	0.0%	\$9,086.90	\$9,086.90	0.0%	
Beach Club	\$0.00	\$0.00	n/a	\$0.00	\$0.00	n/a	\$ 2,920.73	\$ 2,920.73	0.0%	\$6,166.17	\$6,166.17	0.0%	\$9,086.90	\$9,086.90	0.0%	
																900

****The Club House pertains to the Quarry Golf & Country Club and the Beach Club pertains to the Quarry Community Association**

Ninth Order of Business

9A

MEMORANDUM

TO: BOARD OF SUPERVISORS
 QUARRY COMMUNITY DEVELOPMENT DISTRICT

FROM: WESLEY HABER

DATE: JUNE 5, 2023

RE: REFRESHER ON SUNSHINE LAW AND PUBLIC RECORDS LAW

I would like to provide a short reminder on Florida's public meeting and record requirements. While many of you are familiar with these requirements, this memorandum provides a refresher to help keep them on your mind. Please take a few minutes to read this memorandum and contact me at your convenience with any questions.

Florida's Government in the Sunshine Law

Generally speaking, Florida's Sunshine Law applies to all formal or informal gatherings of two or more Board Supervisors to discuss matters that **may foreseeably come before the Board for official action**. Section 286.011, Florida Statutes, contains three requirements for such meetings: (1) the meetings must be open to the public; (2) the meetings must be noticed; and (3) minutes of the meetings must be taken. The Sunshine Law is intended to protect the public from "closed door" politics, and Courts broadly construe the law to ensure it meets this remedial and protective purpose.¹ As examples of the broad interpretation of the Sunshine Law, courts and Florida's Attorney General have opined that it extends to:

- Discussions or exchanges between two or more Board Supervisors regarding Board business via email, telephones, Facebook, blogs, and third-party intermediaries.²
- Discussions between two or more board members at a noticed public meeting, but conducted in a manner not generally audible to the public in attendance.³
- Meetings of advisory groups that have been delegated some decision-making authority (e.g., tasked with responsibility to make recommendations on some Board-related business), whether delegation is by the board or by a single board member.⁴

¹ See, e.g., *Wood v. Marston*, 442 So.2d 934, 938 (Fla. 1983).

² See, e.g., Att'y General Opinion 08-07 (blogs); Att'y General Opinion 09-19 (Facebook); *State v. Childers* No. 02-219390-MMC; 02-21940-MMB (Escambia Co. Ct., June 5, 2013) (telephones); Att'y General Opinion 74-47 (intermediaries).

³ *Rackleff v. Bishop*, No. 89-235 (Fla. 2d Cir. Ct., March 5, 1990). See also Att'y General Opinion 71-159.

⁴ *Wood v. Marston*, 442 So.2d 934 (Fla. 1983). See also Att'y General Opinion 75-41.

KUTAKROCK

Knowing violations of the Sunshine Law are a second degree misdemeanor punishable by up to sixty (60) days imprisonment and/or a fine of up to \$500.⁵ Noncriminal infractions are punishable by a fine not exceeding \$500.⁶ Significantly, attorneys' fees may be awarded to parties that bring successful suits for Sunshine Law violations, and those fees may be assessed against the individual members of the Board, except in those cases where the Board sought, and took, the advice of its attorney.⁷ The availability of attorneys' fees has created a cottage industry among lawyers that specialize in bringing suits for Sunshine Law violations and also supports law suits by newspapers and other "watch-dog" organizations.

Florida's Public Records Law

Board Supervisors are also subject to the duties contained in Chapter 119, Florida Statutes, which creates certain retention and inspection requirements for public records. The term "public record" is broadly defined in Section 119.011(11), Florida Statutes, to include "all documents, papers, letters... or other material, **regardless of the physical form**, characteristics, or means of transmission, made or received... **in connection with the transaction of official business by any agency.**" The nature of the record, rather than the form of the record, determines whether it is a public record subject to Chapter 119, Florida Statutes. Thus, the public records law may reach texts, emails, instant messages, and draft and non-final documents. For example, opinions or comments posted on social media websites or blogs by Board Supervisors regarding District matters or matters that may come before the Board are considered to be made "in connection with the transaction of office business" and are, therefore, "public records."⁸ This may be true regardless of whether the posts are made on a private social media account, a public social media page, or on a public website.⁹ In sum, the courts construe the public records law liberally in favor of openness.¹⁰

The District has addressed retention of records on its own website. However, posts on third party sites are not under the direct control of the District, but may still be subject to public records requirements. As a result, if you do post on a third-party social media page, we advise that you create a copy of that page, and submit it promptly to the District Manager's office, who will maintain the record as the District's records custodian.

Knowing violations of the public records law is a misdemeanor of the first degree punishable by up to one year in prison and/or a fine of \$1,000 in addition to possible impeachment

⁵ 286.011(3)(b), Fla. Stat.

⁶ 286.011(3)(a), Fla. Stat.

⁷ 286.011(4); (5), Fla. Stat.

⁸ Att'y General Opinion 09-19.

⁹ Att'y General Opinion 08-07.

¹⁰ *Dade Aviation Consultants v. Knight Ridder, Inc.*, 800 So.2d 302, 304 (Fla. 3rd Dist. Ct. App. 2001).

KUTAKROCK

and removal from office.¹¹ Noncriminal violations are punishable by a fine not exceeding \$500.¹² As in the Sunshine Law context, attorneys' fees may be awarded to parties that bring successful suits for public record law violations and the availability of attorneys' fees has created a cottage industry of lawyers and watch-dog organizations that specialize in bringing suits for public record law violations.¹³

Best Practices for Social Media

While social media is a powerful tool for Board communication with constituents, use of social media by Board Supervisors presents the risk of violation of both the Sunshine Law and the Public Records Law. Here are some suggestions to minimize these risks:

1. Do NOT post on a social media page in response to another Supervisor's post. Also, do NOT direct others to make such a post on your behalf.
2. If you do post on a social media page, create a copy of that page, and submit it promptly to the District Manager's office, who will maintain the record as the District's records custodian.
3. Maintain District-related email separate and apart from any personal e-mail.
4. If in doubt about the accuracy of any planned posts, please consult with staff first, or feel free to direct a constituent with a particular question to staff for follow-up.
5. If you want to set up your own Facebook or other account where District business will be discussed, please consult further with District staff first.

I hope this information is helpful to you. If you ever have questions about how to handle a Sunshine Law or public records issue, please do not hesitate to contact me or another member of the District's staff.

¹¹ 119.10, Fla. Stat.

¹² 119.10, Fla. Stat.

¹³ See, e.g., Taitt, Sarah, *Florida Public Records Law: The Battle Over Attorneys' Fees*, The Florida Bar Journal, vol. 9, no. 3 (March 2017).